

Arizona Public Service Four Corners Power Plant

Return Water Pond

Location Restrictions Demonstration Report

Prepared for :
Arizona Public Service

AECOM Job No. 60596770
March 31, 2020

Table of Contents

Certification Statement	i
1 Introduction.....	1-1
1.1 Report Purpose and Description	1-1
1.2 EPA Regulatory Requirements	1-1
1.3 Report Organization	1-1
1.4 Facility Description	1-2
2 Placement Above the Uppermost Aquifer.....	2-1
2.1 Methodology.....	2-1
2.2 Discussion and Conclusion	2-1
2.2.1 Base Elevation of the CCR Unit	2-1
2.2.2 Groundwater Elevations	2-1
2.2.3 Separation from the Uppermost Aquifer	2-3
3 Location Relative to Wetlands	3-1
3.1 Methodology.....	3-1
3.2 Discussion and Conclusion	3-1
4 Location Relative to Fault Areas	4-1
4.1 Methodology.....	4-1
4.2 Discussion and Conclusion	4-1
5 Location Relative to Seismic Impact Zones.....	5-1
5.1 Methodology.....	5-1
5.2 Discussion and Conclusion	5-1
6 Location Relative to Unstable Areas	6-1
6.1 Methodology.....	6-1
6.2 Discussion and Conclusion	6-1
6.2.1 Geologic Setting	6-1
6.2.2 Foundation Conditions.....	6-1
6.2.3 Areas Susceptible to Mass Movement	6-2
7 Conclusions	7-1
8 Limitations.....	8-1
9 References	9-1

List of Figures

Figure 1-1: Site Vicinity Map

List of Appendices

Appendix A: As-Built Drawings

Appendix B: Wetlands Map

Appendix C: Unified Hazard Tool Summary

Certification Statement

Certification Statement for Location Restrictions:

- 40 CFR § 257.60 – Placement above the uppermost aquifer
- 40 CFR § 257.61 – Wetlands
- 40 CFR § 257.62 – Fault areas
- 40 CFR § 257.63 – Seismic impact zones
- 40 CFR § 257.64 – Unstable Areas

CCR Unit: Arizona Public Service Company; Four Corners Power Plant; Return Water Pond

I, David Mickanen, being a Registered Professional Engineer in good standing in the State of New Mexico, do hereby certify, to the best of my knowledge, information, and belief that the information contained in this certification has been prepared in accordance with the accepted practice of engineering. I certify, for the above-referenced CCR unit, that the demonstration regarding the location of the CCR unit less than 1.52 meters (5 feet) above the upper limit of the uppermost aquifer, the demonstration regarding the location of the CCR unit in the wetlands, the demonstration regarding the location of the CCR unit within 60 meters (200 feet) of the outermost damage zone of a fault that has had a displacement in Holocene time, the demonstration regarding the location of the CCR unit in a seismic impact zone, and the demonstration that the location of the CCR unit is not in an unstable area, as included in the Location Restrictions Demonstration Report dated March 31, 2020 meets the requirements of 40 CFR § 257.60(a), § 257.61(a), § 257.62(a), § 257.63(a), and § 257.64(a).

David E. Mickanen, P.E.

Printed Name

March 31, 2020

Date



1 Introduction

Arizona Public Service Company (APS) contracted AECOM to assist in the location restrictions demonstrations of the Return Water Pond (RWP), a new coal combustion residual (CCR) surface impoundment facility at the Four Corners Power Plant (FCPP, the Plant) within the Navajo Nation, near Fruitland, New Mexico. The RWP consists of two cells – the Flue Gas Desulfurization (FGD) cell and the Return Water Pond cell – collectively referred to as the “RWP.” Figure 1-1 shows the location of the RWP at the FCPP. This Location Restrictions Demonstration Report documents location-specific conditions relevant to the RWP.

1.1 Report Purpose and Description

The purpose of this report is to document the location restrictions demonstration for the RWP. The RWP is a new CCR surface impoundment APS constructed in 2019. In 2015, the United States Environmental Protection Agency (EPA) finalized a rule (Rule) regulating CCRs under subtitle D of the Resource Conservation and Recovery Act (RCRA). As part of this Rule, owners and operators of new CCR surface impoundments must obtain a certification from a qualified professional engineer stating that the demonstrations for the CCR unit meet the requirements relative to the uppermost aquifer, wetlands, fault areas, seismic impact zones, and unstable areas.

1.2 EPA Regulatory Requirements

On April 17, 2015 the United States Environmental Protection Agency issued 40 CFR Part 257 Hazardous and Solid Waste Management System; Disposal of Coal Combustion Residuals from Electric Utilities; Final Rule (the Rule). Sections 257.60 through 257.64 define location restriction criteria for new CCR surface impoundments and require the owner or operator of the CCR unit to demonstrate that the unit meets minimum requirements for:

- a) Placement above the uppermost aquifer (§ 257.60);
- b) Location outside wetlands (§ 257.61);
- c) Location more than 60 meters (200 feet) from the outermost damage zone of a fault that has had displacement in Holocene time (§ 257.62);
- d) Location outside seismic impact zones (§ 257.63);
- e) Location away from unstable areas (§ 257.64).

New CCR surface impoundments, such as the RWP, are required to demonstrate compliance with the location restrictions no later than the date of initial receipt of CCR in the CCR unit. An owner or operator who fails to make the demonstration showing compliance with the requirements under 40 CFR § 257.60(a), § 257.61(a), § 257.62(a), § 257.63(a), or § 257.64(a) is prohibited from placing CCR in the CCR unit.

1.3 Report Organization

This Demonstration Report is organized into the following sections:

<u>Report Section</u>	<u>Applicable CFR 40 Part 257 Citation</u>
• Section 1 – Introduction	
• Section 2 – Placement Above the Uppermost Aquifer	§ 257.60 Placement above the uppermost aquifer
• Section 3 – Location Relative to Wetlands	§ 257.61 Wetlands
• Section 4 – Location Relative to Fault Areas	§ 257.62 Fault areas

- Section 5 – Location Relative to Seismic Impact Zones § 257.63 Seismic impact zones
- Section 6 – Location Relative to Unstable Areas § 257.64 Unstable areas
- Section 7 – Conclusions
- Section 8 – Limitations
- Section 9 – References
- Figure
- Appendix A – Original Construction Plans and Boring Logs
- Appendix B – Wetlands Map
- Appendix C – Unified Hazard Tool Summary

1.4 Facility Description

The FCPP is an electric generating station located within the Navajo Nation, near Fruitland, New Mexico. The FCPP is operated by APS and owned by a consortium of utility companies. The FCPP consists of two coal-fired electrical generating units, Units 4 and 5. Units 1, 2, and 3 ceased generation in 2013 and were then decommissioned. The two generating units are cooled by water from Morgan Lake, a man-made reservoir located immediately north of the Plant. Five existing CCR units are located at the FCPP: the Combined Waste Treatment Pond (CWTP) located immediately east of the Plant, the Lined Ash Impoundment (LAI) located approximately 1 mile west of the Plant, the Lined Decant Water Pond (LDWP) located approximately 1.5 miles west of the Plant and adjacent to the LAI, the Return Water Pond (RWP) located between the LAI and the Plant, and the Dry Fly Ash Disposal Area (DFADA), a landfill located approximately 2 miles southwest of the Plant and south of the LAI. A sixth CCR unit, the Upper Retention Sump, was decommissioned and permanently closed in 2018. Figure 1-1 shows the locations of these units.

The RWP was constructed in 2019. Inflow to the RWP is managed by four distinct pumping stations, which are manually operated by plant personnel. Outflow from the RWP is managed by a dedicated pumping station, which is manually operated by plant personnel. Water in the RWP is pumped back to the plant and used as process makeup water.

The RWP is a geosynthetic-lined dike with 3 horizontal : 1 vertical (3H:1V) upstream and downstream slopes constructed using processed weathered shale and sandstone material from the excavation footprint. The dike crest width is 20 feet and the maximum height is approximately 13 feet. The RWP liner system consists of a primary 60-mil HDPE geomembrane liner, a drainage geonet, a secondary 60-mil HDPE geomembrane liner, a geosynthetic clay liner (GCL), and a prepared subgrade (scarified, proof-rolled, and compacted). The RWP has a surface area of 5.1 acres and a storage capacity of 38.6 ac-ft (at elevation 5379 feet).

2 Placement Above the Uppermost Aquifer

40 CFR § 257.60 requires that new CCR surface impoundments must be constructed with a base that is located no less than 1.52 meters (5 feet) above the upper limit of the uppermost aquifer, unless the owner or operator demonstrates that there will not be an intermittent, recurring, or sustained hydraulic connection between any portion of the base of the CCR unit and the uppermost aquifer due to normal fluctuations in groundwater elevation (including the seasonal high water table).

Uppermost aquifer is defined by the Rule to mean the geologic formation nearest the natural ground surface that is an aquifer, as well as lower aquifers that are hydraulically interconnected with this aquifer within the facility's property boundary.

2.1 Methodology

The following information was reviewed to assess the vertical location of the RWP relative to the uppermost aquifer:

- Preconstruction topographic conditions shown on construction plans (included in Appendix A)
- As-built drawings for the RWP (APS 2020)
- CCR Monitoring Well Network Report and Certification (AECOM 2017)
- Annual Groundwater Monitoring and Corrective Action Report for 2017 (Amec Foster Wheeler 2018), 2018 (wood. 2019), and 2019 (wood. 2020)

2.2 Discussion and Conclusion

2.2.1 Base Elevation of the CCR Unit

The base elevation (EL) of the RWP is EL 5362.61 feet, the lowest elevation at the bottom of the pond and the location of the leachate collection and recovery system (LCRS). This elevation is called out on Sheet 14 of the FC45CM-C-65-WP-AP-200485 drawing set (Appendix A).

2.2.2 Groundwater Elevations

APS will install groundwater monitoring wells around the RWP prior to the initial receipt of CCR. Until the new wells are installed, the closest groundwater monitoring wells to the RWP are MW-12R1 and MW-50A based on figures presented in the 2019 Annual Groundwater Monitoring and Corrective Action Report (wood. 2020). The water elevations in wells LS-1 and LS-2 are completed in the unweathered portion of the Lewis Shale (wood. 2019) and the depth to water in these wells is not regularly measured.

Monitoring well MW-12R1 was constructed in 2018 and is screened in the weathered Lewis Shale between 22 feet (EL 5246.23 feet) and 32 feet (EL 5236.23 feet NAVD88) below ground surface (EL 5268.23 feet NAVD83) (AECOM 2017). No water was encountered during drilling. MW-12R1 was dry during the first reading event in November 2018 (wood. 2019) and dry in the subsequent reading event in November/December 2019 (wood. 2020).

Monitoring well MW-49A was constructed in 2013 and is screened in the weathered Lewis Shale between 50 feet (EL 5231.38 feet NAVD88) and 65 feet (EL 5216.38 feet NAVD88) below ground surface (EL 5281.38 feet NAVD83) (AECOM 2017). No water was encountered during drilling. The highest water elevation measured is EL 5241.73 feet (NAVD88) during the January/February 2017 reading event.

Monitoring well MW-50A was constructed in 2013 and is screened in the weathered Lewis Shale between 28 feet (EL 5305.2 feet NAVD88) and 43 feet (EL 5290.2 feet NAVD88) below ground surface (EL 5333.2 feet NAVD83) (AECOM 2017). No water was encountered during drilling. The highest water elevation measured is EL 5292.60 feet (NAVD88) during the October 2016 reading event.

Monitoring well MW-73 was constructed in 2017 and is screened in poorly graded sand with silt and clayey sand between 28.8 feet (EL 5323.10 feet NAVD88) and 43.8 feet (EL 5308.10 feet NAVD88) below ground surface (EL 5351.90 feet NAVD83) (AECOM 2017). Water was encountered at a depth of 22 feet (EL 5329.90 feet NAVD88) during drilling and was observed to be at a depth of 21.80 feet (EL 5330.10 feet NAVD88) after drilling; this is also the highest water elevation measured.

Table 1 presents well data and the water level elevations in the wells monitored near the RWP (AECOM 2017, AECOM 2018, Amec Foster Wheeler 2018, wood. 2019, and wood. 2020).

Table 1 – Well Data and Groundwater Elevations (ft)¹

	Well Name			
	MW-12R1	MW-49A	MW-50A	MW-73
Location Relative to the RWP	West	West	North	North
Surface Elevation (ft)	5268.23	5281.38	5333.2	5351.90
Bottom of Screen (ft)	5236.23	5216.38	5290.2	5308.10
Screened In	Weathered Shale	Weathered Shale	Weathered Shale	Sand
Measurement Date	MW-12R1	MW-49A	MW-50A	MW-73
11/3-11/9, 11/14/2015	NI ²	5229.25	5291.83	NI ²
4/25/2016	NI ²	5240.79	5292.44	NI ²
9/12/2016	NI ²	5240.56	5292.49	NI ²
10/19-10/20/2016	NI ²	5241.06	5292.60	NI ²
1/31-2/1/2017	NI ²	5241.73	5292.29	5329.96
5/1/2017	NI ²	5240.98	5292.43	5329.67
9/9/2017	NI ²	5240.64	5292.16	5328.63
10/11/2017	NI ²	5240.62	5292.15	5329.36
3/15/2018	NI ²	5236.73	5292.21	5330.05
5/31/2018	NM ³	5240.54	Dry	5329.09
11/2/2018	Dry	5240.67	Dry	5329.06
March/April 2019	NM ³	5239.42	5292.05	5329.61
May 2019	NM ³	5239.34	NM ³	5328.64
November/December 2019	Dry	5238.88	5292.58	5329.22
Highest Recorded Groundwater Elevation (ft)	<5236.23	5241.73	5292.60	5330.10 (after installation)

- 1) Elevations are presented in NAVD88.
- 2) NI = Not installed.
- 3) NM = The groundwater elevation was not measured on the date shown.

2.2.3 Separation from the Uppermost Aquifer

Groundwater elevations recorded in the weathered shale underlying the RWP are historically below EL 5330.10 feet (NAVD88) approximately 1,500 feet north of the pond and below EL 5241.73 feet (NAVD88) approximately 2,200 feet west of the pond. Assuming the water elevation measured in monitoring well MW-73 after installation (EL 5330.10 feet, NAVD88) is the same as the water elevation beneath the RWP, the base elevation of the RWP at EL 5362.61 feet (NAVD88) is approximately 32.5 feet higher than the highest recorded groundwater elevation at monitoring well MW-50A.

Conclusion: The base of the RWP is located greater than 1.52 meters (5 feet) above the groundwater level in the uppermost aquifer.

3 Location Relative to Wetlands

40 CFR § 257.61 requires that new CCR surface impoundments are not to be located in wetlands. Wetlands are defined in 40 CFR § 232.2 as “those areas that are inundated or saturated by surface or groundwater at a frequency and duration sufficient to support, and that under normal circumstances do support, a prevalence of vegetation typically adapted for life in saturated soil conditions. Wetlands generally include swamps, marshes, bogs, and similar areas.”

3.1 Methodology

A wetland delineation was performed in April 2012 and jurisdictional determinations of the wetlands identified have been reviewed and accepted by the U.S. Army Corps of Engineers and the Environmental Protection Agency (United States Department of the Interior, Office of Surface Mining Reclamation and Enforcement 2015). A map of wetlands identified at the FCPP in this study is presented in Appendix B.

3.2 Discussion and Conclusion

No wetlands were identified in the footprint of the RWP. One 0.07-acre wetland is located approximately 6,500 feet from the RWP. The wetland drains into a concrete-lined detention pond upstream of the Pond 3 pump house.

Conclusion: The RWP is not located in wetlands.

4 Location Relative to Fault Areas

40 CFR § 257.62 requires that new CCR surface impoundments are not to be located within 60 meters (200 feet) of the outermost damage zone of a fault that has had displacement in Holocene time (beginning 11,700 years before present (BP)) unless the owner or operator demonstrates the an alternative setback distance of less than 60 meters (200 feet) will prevent damage to the structural integrity of the CCR unit.

4.1 Methodology

AECOM reviewed the Quaternary Faults and Folds database maintained by the United States Geological Survey (USGS) as part of the Holocene fault search (USGS 2019b). The Holocene epoch is the most recent subdivision of the Quaternary period and therefore any faults that have had displacement in the Holocene would also be included in the Quaternary period database. The Quaternary Faults and Folds database is the source for the faults used in the National Seismic Hazard Maps and contains information on faults and associated folds that are believed to be sources of M > 6 earthquakes during the Quaternary Period. AECOM searched the USGS Quaternary Fault and Fold Database for Category A and Category B faults in San Juan County, New Mexico. Fault categories are defined in Table 2. Fault categories A and B relate to the Rule; fault categories C and D describe less defined or non-tectonic features.

Table 2 – Fault Categories

Category	Definition
A	Geologic evidence demonstrates the existence of a Quaternary fault of tectonic origin, whether the fault is exposed by mapping or inferred from liquefaction or other deformational features.
B	Geologic evidence demonstrates the existence of Quaternary deformation, but either (1) the fault might not extend deeply enough to be a potential source of significant earthquakes, or (2) the currently available geologic evidence is too strong to confidently assign the feature to Class C but not strong enough to assign it to Class A.
C	Geologic evidence is insufficient to demonstrate (1) the existence of tectonic faulting, or (2) Quaternary slip or deformation associated with the feature.
D	Geologic evidence demonstrates that the feature is not a tectonic fault or feature; this category includes features such as joints, landslides, erosional or fluvial scarps, or other landforms resembling scarps but of demonstrable non-tectonic origin.

4.2 Discussion and Conclusion

The USGS Quaternary Faults and Folds Database of the United States does not contain any Class A or Class B faults in San Juan County.

Conclusion: No faults with displacement in Holocene time are present within 200 feet of the RWP.

5 Location Relative to Seismic Impact Zones

40 CFR § 257.63 requires new CCR surface impoundments are not to be located in seismic impact zones unless the owner or operator demonstrates that all structural components, including liners, leachate collection and removal systems, and surface water control systems, are designed to resist the maximum horizontal acceleration in lithified earth material for the site. *Seismic impact zone* is defined by the Rule as an area having a 2 percent or greater probability that the maximum expected horizontal acceleration, expressed as a percentage of the earth's gravitational pull (g), will exceed 0.10 g in 50 years.

5.1 Methodology

The USGS maintains the Unified Hazard Tool website to provide access to the source and attenuation models for locations within the United States. AECOM utilized version 4.0.x of the 2014 Unified Hazard Tool to calculate the peak horizontal ground acceleration (PGA) with a 2 percent probability of exceedance in 50 years (USGS 2019a) for the RWP location. The Unified Hazard Tool result is presented in Appendix C.

5.2 Discussion and Conclusion

The PGA with a 2 percent probability of exceedance in 50 years for the RWP is 0.0747g. This value is less than the Rule-required maximum value of 0.10 g in 50 years.

Conclusion: The RWP is not located in a seismic impact zone.

6 Location Relative to Unstable Areas

40 CFR § 257.64 requires that new CCR surface impoundments are not to be located in an unstable area unless the owner or operator demonstrates that recognized and generally accepted good engineering practices have been incorporated into the design of the CCR unit to ensure that the integrity of the structural components of the CCR unit will not be disrupted. The following factors must be considered when determining whether the area is unstable:

- 1) On-site or local soil conditions that may result in significant differential settling;
- 2) On-site or local geologic or geomorphologic features; and
- 3) On-site or local human-made features or events (both surface and subsurface).

Structural components means liners, leachate collection and removal systems, final covers, run-on and run-off systems, inflow design flood control systems, and any other component used in the construction and operation of the CCR unit that is necessary to ensure the integrity of the unit and that the contents of the unit are not released into the environment.

Unstable area means a location that is susceptible to natural or human-induced events or forces capable of impairing the integrity, including structural components of some or all of the CCR unit that are responsible for preventing releases from such unit. Unstable areas can include poor foundation conditions, areas susceptible to mass movements, and karst terrains.

6.1 Methodology

The location of the RWP relative to unstable areas was assessed by reviewing design and construction documentation, historic geological and geotechnical investigations, and engineering analyses (safety factor calculations). Information was reviewed to assess: 1) whether poor foundation conditions may exist which could result in inadequate foundation support for structural components of the RWP, and 2) whether areas susceptible to mass movement (such as subsidence, landslides, avalanches, debris slides and flows, block sliding, or rock falls) capable of impairing the integrity of the structural components of the RWP are present.

6.2 Discussion and Conclusion

6.2.1 Geologic Setting

The FCPP is located on the western flank of the San Juan Basin, in the Colorado Plateau physiographic province in northwestern New Mexico. The San Juan Basin is a structural basin approximately 100 miles from north to south and 90 miles from east to west underlain by laterally extensive, gently dipping to flat-lying sedimentary rocks of Late Cretaceous age. The northwestern boundary of the San Juan Basin is defined by the Hogback Monocline. The Hogback Monocline is a structural monocline where the generally horizontal to gently dipping Cretaceous sedimentary rock units in the area are uplifted into a one-sided fold which dips steeply (approximately 38 degrees) to the east. The resulting bedrock ridge approximately 3 miles west of the Plant is composed of younger rock units on the eastern flank and progressively older units exposed in the central and western portions of the Hogback.

Karst terrain is not known to be present beneath the FCPP or RWP footprint based on the predominance of shale and sandstone in the area.

6.2.2 Foundation Conditions

The RWP is founded on native soil primarily consisting of hard weathered shale and sandstone. The native soils and shale underlying the RWP appear to be competent materials based on test pits excavated within the RWP footprint prior to construction, nearby well logs for LS-1, LS-2, and MW-50A (AECOM 2017), and observations

during construction. Based on knowledge of the site and available geologic information, AECOM does not believe that the presence of the RWP will cause significant differential settling across the weathered shale or sandstone underlying the site.

Conditions Associated with Unstable Areas: The Rule identifies three conditions that must be considered when determining whether the area is unstable:

1. On-site or local soil conditions that may result in significant differential settling:

The RWP was constructed by excavating the existing weathered shale and sandstone from the pond footprint and using a portion of the excavated material to construct the perimeter embankment. The maximum excavation for the RWP is approximately 12 feet in the vicinity of the LCRS risers in both cells. The maximum embankment height, measured from EL 5381 feet at the crest to EL 5368 at the toe on the north side of the impoundment, is 13 feet. This relatively short embankment height applies approximately 1,500 psf to the underlying shale and sandstone. Based on AECOM's experience at the FCPP, this additional overburden stress is not expected to cause the weathered shale and sandstone to experience significant differential settling.

2. On-site or local geologic or geomorphologic features:

There are no identified geologic or geomorphologic features that could cause the area of the RWP to become unstable.

3. On-site or local human-made features or events (both surface and subsurface):

The impounded water level in the RWP is monitored by APS personnel and APS has the ability to reduce the impounded water level if required to maintain the safe operation of the CCR unit.

6.2.3 Areas Susceptible to Mass Movement

The RWP is constructed on top of an area of relatively higher topography. Topographic and geologic conditions in the area do not indicate the potential for landslides, avalanches, debris slides, debris flows, block sliding, rock falls, or other mass movements which could impact the structural components of the RWP.

Conclusion: The RWP is not located in an unstable area.

7 Conclusions

Based on the findings and results of the location restrictions demonstrations, AECOM provides the following conclusions for the RWP:

- The base of the RWP is located greater than 1.52 meters (5 feet) above the groundwater level in the uppermost aquifer.
- The RWP is not located in wetlands.
- No faults with Holocene displacement are present within 200 feet of the RWP.
- The RWP is not located in a seismic impact zone.
- The RWP is not located in an unstable area.

8 Limitations

This report is for the sole use of APS on this project only and is not to be used for other projects. In the event that conclusions based upon the data obtained in this report are made by others, such conclusions are the responsibility of others. The Certification of Professional Opinion is limited to the information available to AECOM at the time this report was written. This report was written in accordance with current practice and the standard of care. Standard of care is defined as the ordinary diligence exercised by fellow practitioners in this area performing the same services under similar circumstances during the same period. Professional judgments presented herein are primarily based on information from previous reports that were assumed to be accurate partly based on knowledge of the site and partly based on our general experience with similar evaluations performed for similar structures. No warranty or guarantee, express or implied, is applicable to this work.

The use of the words "certification" and/or "certify" in this document shall be interpreted and construed as a Statement of Professional Opinion and is not and shall not be interpreted or construed as a guarantee, warranty, or legal opinion.

9 References

AECOM, 2017. "CCR Monitoring Well Network Report and Certification, Four Corners Power Plant, Fruitland, New Mexico." September 18.

AECOM, 2018. "MW-12R1 Well Installation Log." June.

Amec Foster Wheeler, 2018. "Annual Groundwater Monitoring and Corrective Action Report for 2017." Prepared for Arizona Public Service. January 29.

Arizona Public Service Company (APS), 2020. "FCPP Return Water Pond." Record Drawing Set Number FC45CM-C-16-WP-AP-200485. January 17.

United States Department of the Interior Office of Surface Mining Reclamation and Enforcement, 2015. "Final Environmental Impact Statement (EIS) for the Four Corners Power Plant and Navajo Mine Energy Project." May 1.



United States Geological Survey (USGS), 2019a. *Unified Hazard Tool – Conterminous U.S. 2014 (v4.0.x)*. <https://earthquake.usgs.gov/hazards/interactive/>. Accessed December 16.

United States Geological Survey (USGS), 2019b. *Quaternary Fault and Fold Database of the United States*. <https://earthquake.usgs.gov/hazards/qfaults/>. Accessed December 16.

Wood Environment & Infrastructure Solutions, Inc. (wood.), 2019. "Annual Groundwater Monitoring and Corrective Action Report for 2018." Prepared for Arizona Public Service. January 31.

Wood Environment & Infrastructure Solutions, Inc. (wood.), 2020. "Annual Groundwater Monitoring and Corrective Action Report for 2019." Submitted to Arizona Public Service. January 31.

Figure

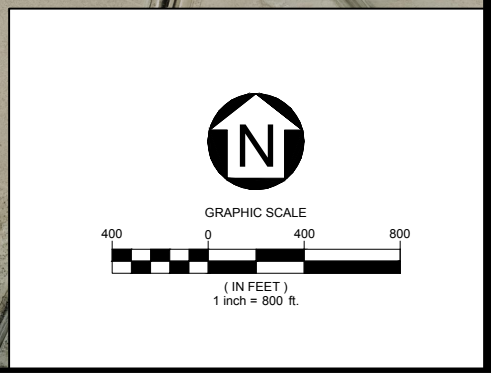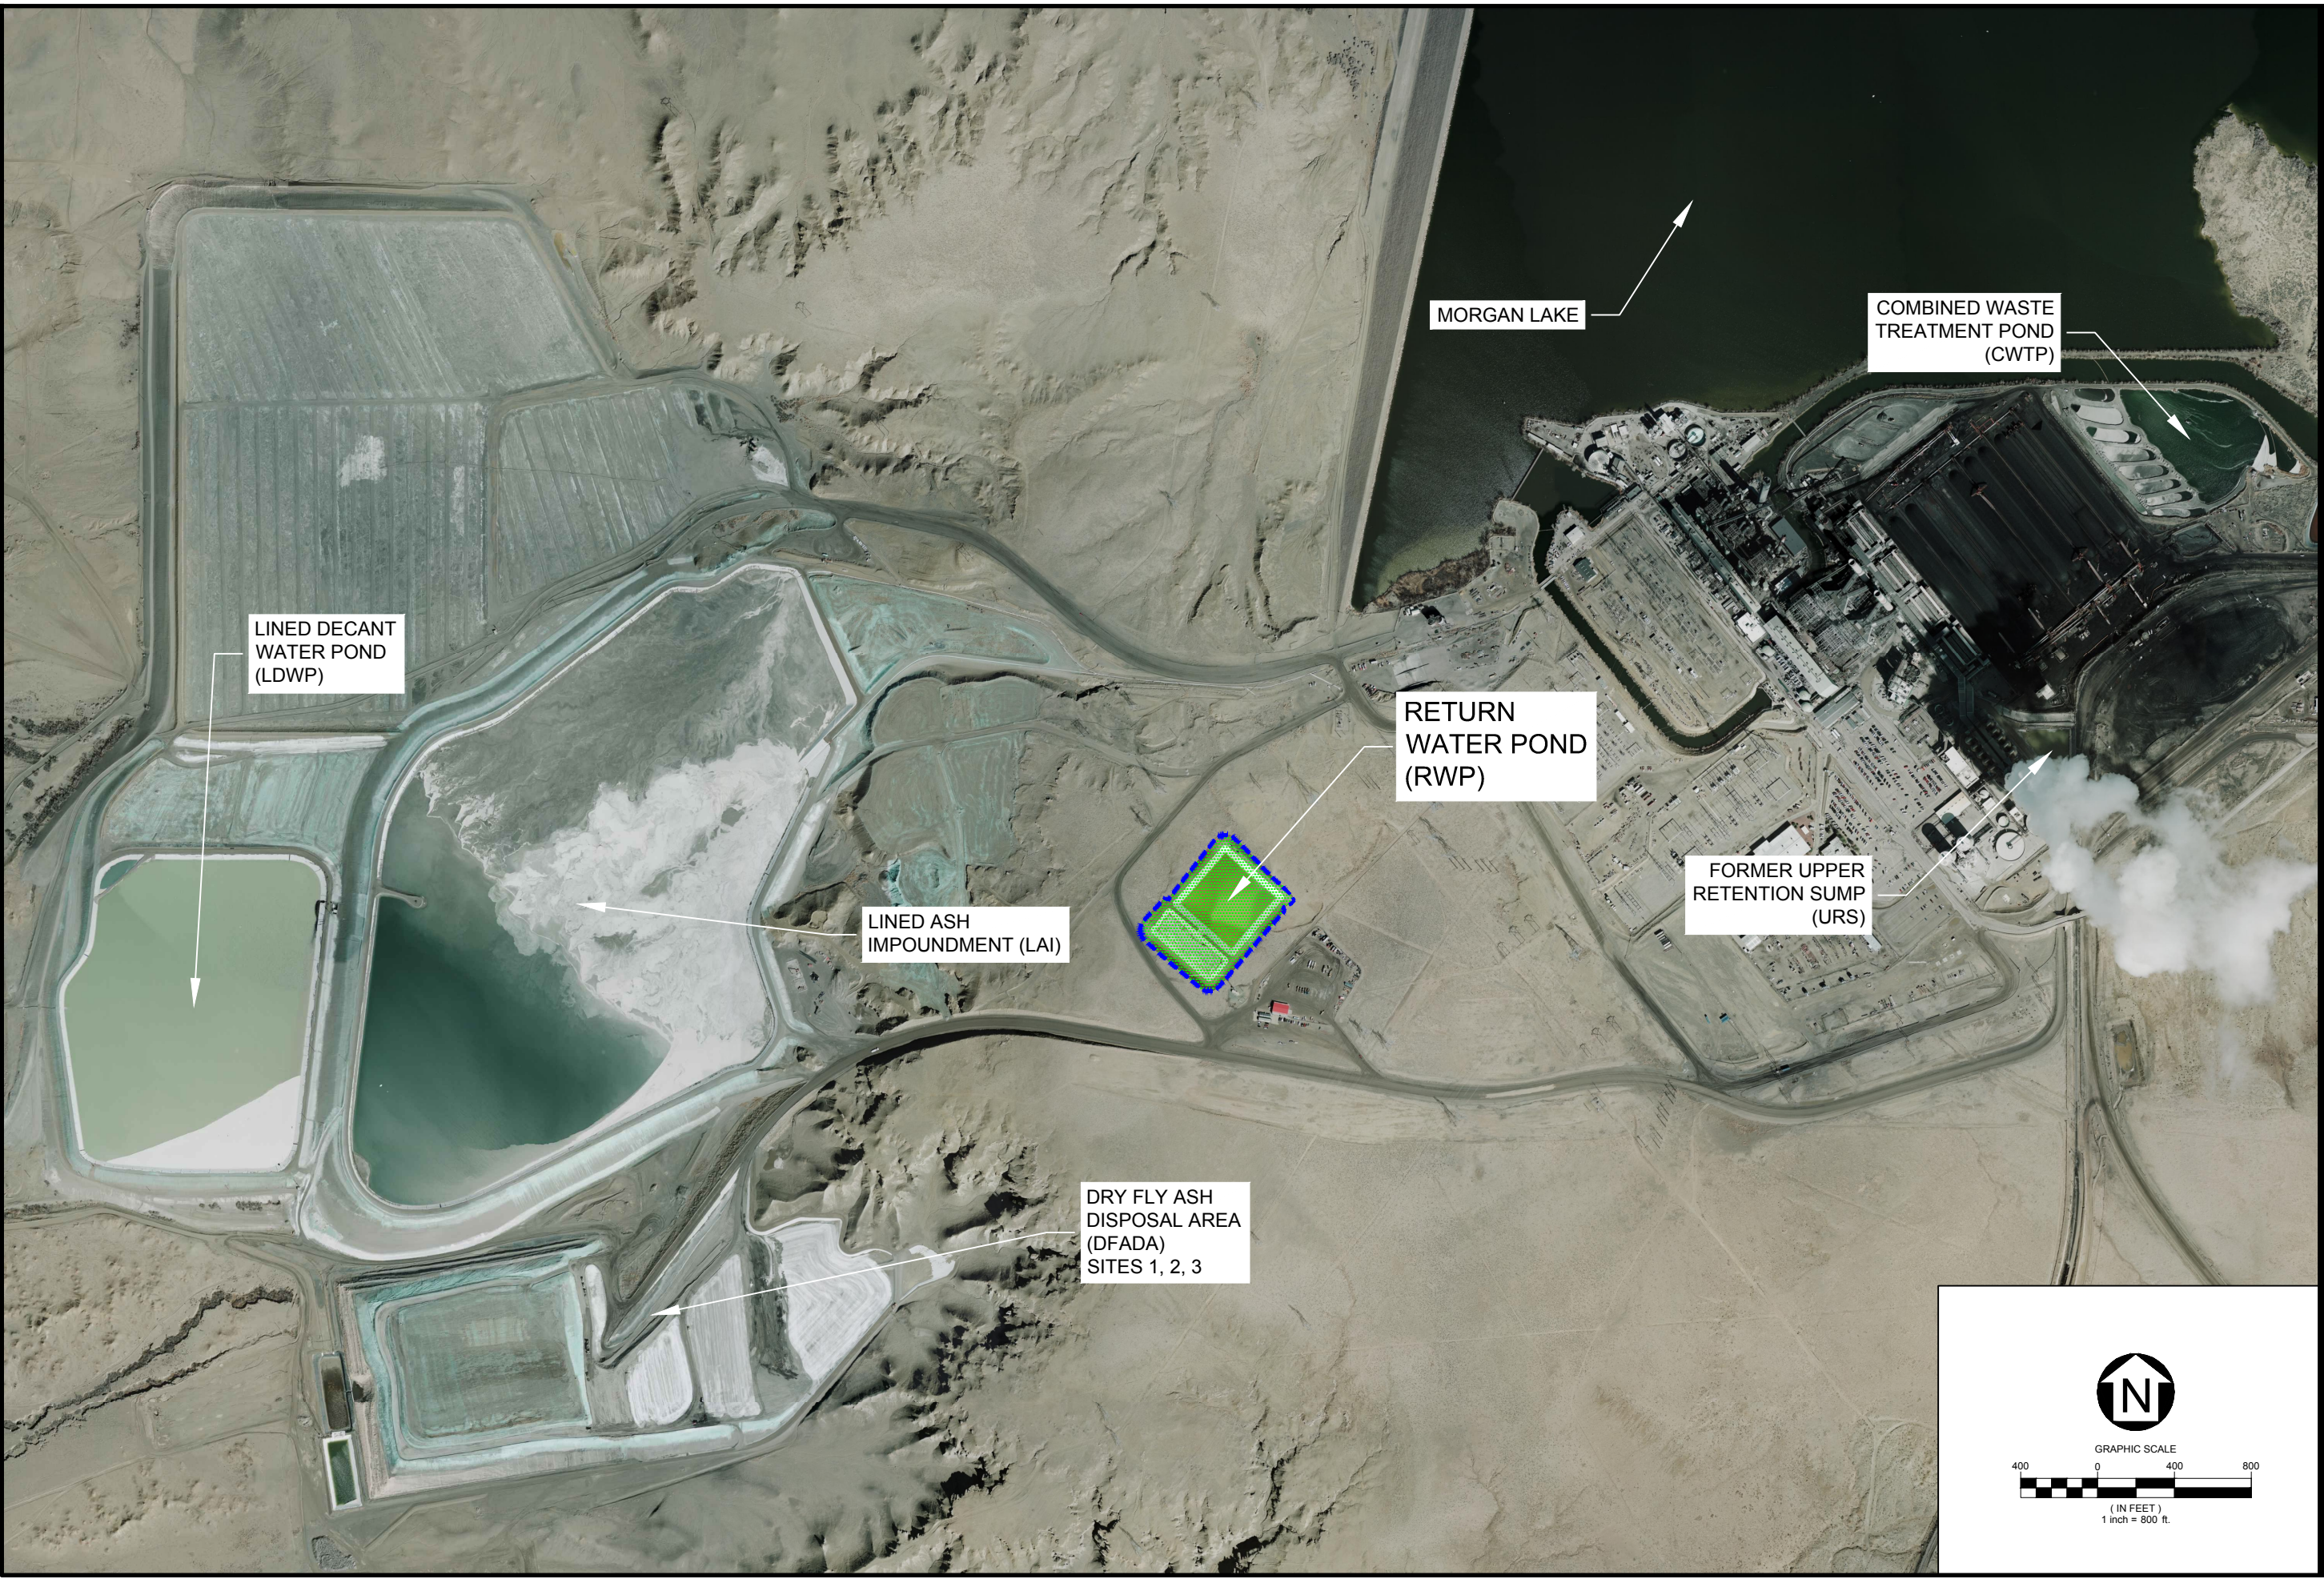


Appendix A. As-Built Drawings

DRAWING INDEX

DRAWING NUMBER	TITLE
FC45CM-X-41-WP-AP-170003-97	COVER SHEET
FC45CM-X-98-WP-AP-200485-2	GENERAL NOTES, LEGEND, AND ABBREVIATIONS
FC45CM-C-16-WP-AP-200485-3	EXISTING CONDITIONS PLAN
FC45CM-C-16-WP-AP-200485-4	GEOTECHNICAL INVESTIGATION LOCATION MAP
FC45CM-C-16-WP-AP-200485-5	KEY PLAN
FC45CM-C-16-WP-AP-200485-6	POND 3 PUMP HOUSE PLAN
FC45CM-C-16-WP-AP-200485-7	RETURN WATER PIPELINE PLAN 1
FC45CM-C-16-WP-AP-200485-8	RETURN WATER PIPELINE PLAN 2
FC45CM-C-16-WP-AP-200485-9	RETURN WATER PIPELINE PLAN 3
FC45CM-C-16-WP-AP-200485-10	RETURN WATER PIPELINE PLAN 4
FC45CM-C-16-WP-AP-200485-11	RETURN WATER POND PLAN
FC45CM-C-16-WP-AP-200485-12	GRADING AND DRAINAGE PLAN
FC45CM-C-65-WP-AP-200485-13	LINER SECTIONS AND DETAILS
FC45CM-C-65-WP-AP-200485-14	GRADING SECTIONS AND DETAILS
FC45CM-C-65-WP-AP-200485-15	RETURN WATER PIPING SECTIONS AND DETAILS
FC45CM-C-65-WP-AP-200485-16	FENCING SECTIONS AND DETAILS
FC45CM-C-65-WP-AP-200485-17	UTILITY VAULT DETAILS
FC45CM-M-05-BP-AP-156257-1	THICKENER UNDERGROUND PIPE ROUTING PLAN VIEW
FC04UN-M-02-BP-AP-82117-410B	U4 THICKENER UNDERFLOW SYSTEM PUMPS P&ID
FC04UN-M-02-BP-AP-82118-410B	U5 THICKENER UNDERFLOW SYSTEM PUMPS P&ID
FC45CM-M-02-BP-AP-82119-1	THICKENER UNDERFLOW TO LINED ASH IMPOUNDMENT P&ID
FC45CM-S-98-WP-AP-200485-24	STRUCTURAL GENERAL NOTES
FC45CM-S-47-WP-AP-200485-25	STRUCTURAL PLAN AND SECTION
FC45CM-S-65-WP-AP-200485-26	STRUCTURAL SECTIONS AND DETAILS
FC45CM-M-02-WP-AP-200485-27	RETURN WATER POND P&ID
FC00CM-M-02-HB-BR-82114-10F	ASH POND 6-CHACO WASH SEEPAGE INTERCEPT SYSTEM P&ID
FC00CM-M-02-HB-BR-82114-10G	ASH HANDLING SYSTEM LINED DECANT WATER POND P&ID
FC00CM-C-56-BP-LK-56052-5	PUMPING STATION-PIPING&GENERAL ARRANGEMENT PLANS&ELEVATIONS
FC45CM-M-16-WP-AP-200485-34	MECHANICAL RETURN WATER POND PUMPING STATION PLAN
FC45CM-P-65-WP-AP-200485-35	LCRS PUMP SECTION, SCHEDULE AND DETAILS
FC45CM-M-65-WP-AP-200485-36	MECHANICAL SEWAGE EFFLUENT PUMPING STATION PLAN
FC45CM-E-98-WP-AP-200485-37	ELECTRICAL LEGEND
FC45CM-E-16-WP-AP-200485-38	ELECTRICAL OVERALL SITE KEY PLAN
FC45CM-E-16-WP-AP-200485-39	ELECTRICAL POND 3 SITE PLAN
FC45CM-E-16-WP-AP-200485-40	ELECTRICAL RETURN WATER POND PLAN
FC45CM-E-16-WP-AP-200485-41	RWP AND SEWAGE EFFLUENT PUMPING STATION PLANS
FC45CM-E-16-WP-AP-200485-42	ELECTRICAL ASH DISPOSAL PUMPING STATION PLAN
FC45CM-E-01-WP-AP-200485-43	ELECTRICAL ONE-LINE DIAGRAMS
FC45CM-E-49-WP-AP-200485-44	ELECTRICAL DETAILS
FC00CM-E-03-HB-BR-39128-1	EVAPORATION PONDS MCC
FC00CM-E-03-HB-BR-39128-2	EVAPORATION PONDS BOM
FC00CM-E-03-HB-BR-39128-3	EVAPORATION PONDS SCHEMATICS
FC00CM-E-04-HB-BR-39129-3	EVAPORATION PONDS CONTROLS
FC45CM-E-16-WP-AP-200485-51	EXISTING PUMP SITE UPGRADE
FC45CM-E-16-WP-AP-200485-52	ASH POND PUMP STATION EXTENSION
FC45CM-E-19-WP-AP-200485-53	PAD AND CONDUIT DETAIL 1
FC45CM-E-19-WP-AP-200485-54	PAD AND CONDUIT DETAIL 2





FOUR CORNERS POWER PLANT, UNITS 4 AND 5
ARIZONA PUBLIC SERVICE COMPANY
FCPP RETURN WATER POND
WA# FCC06814

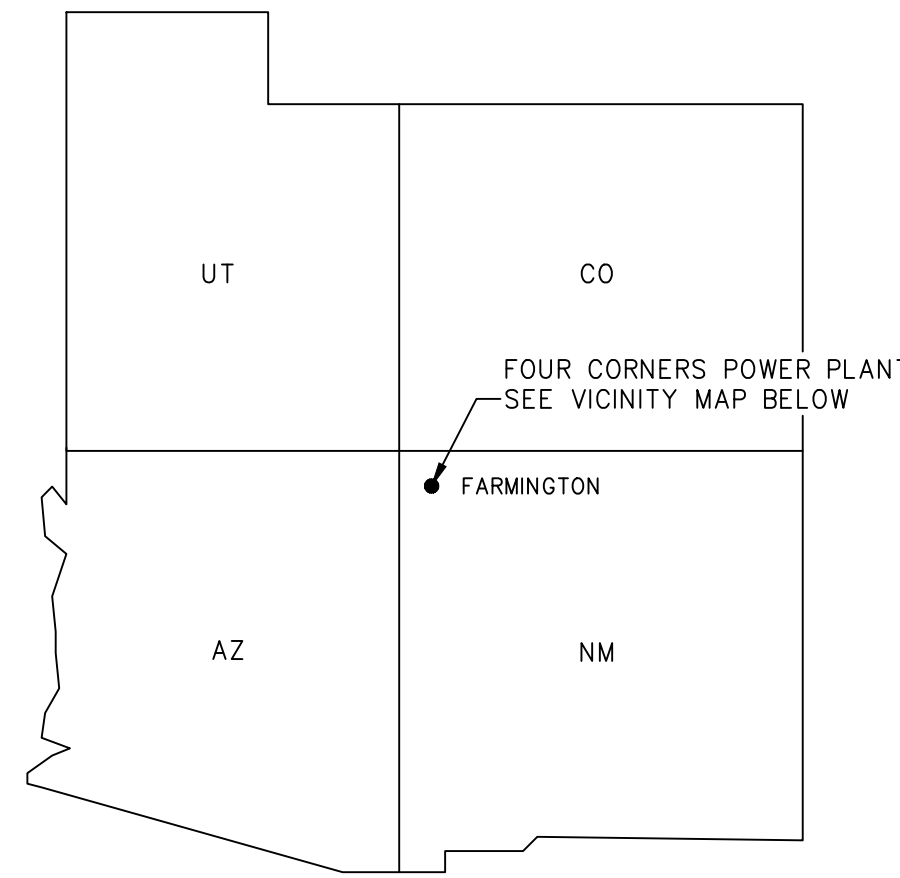


LOCATION MAP

N.T.S.

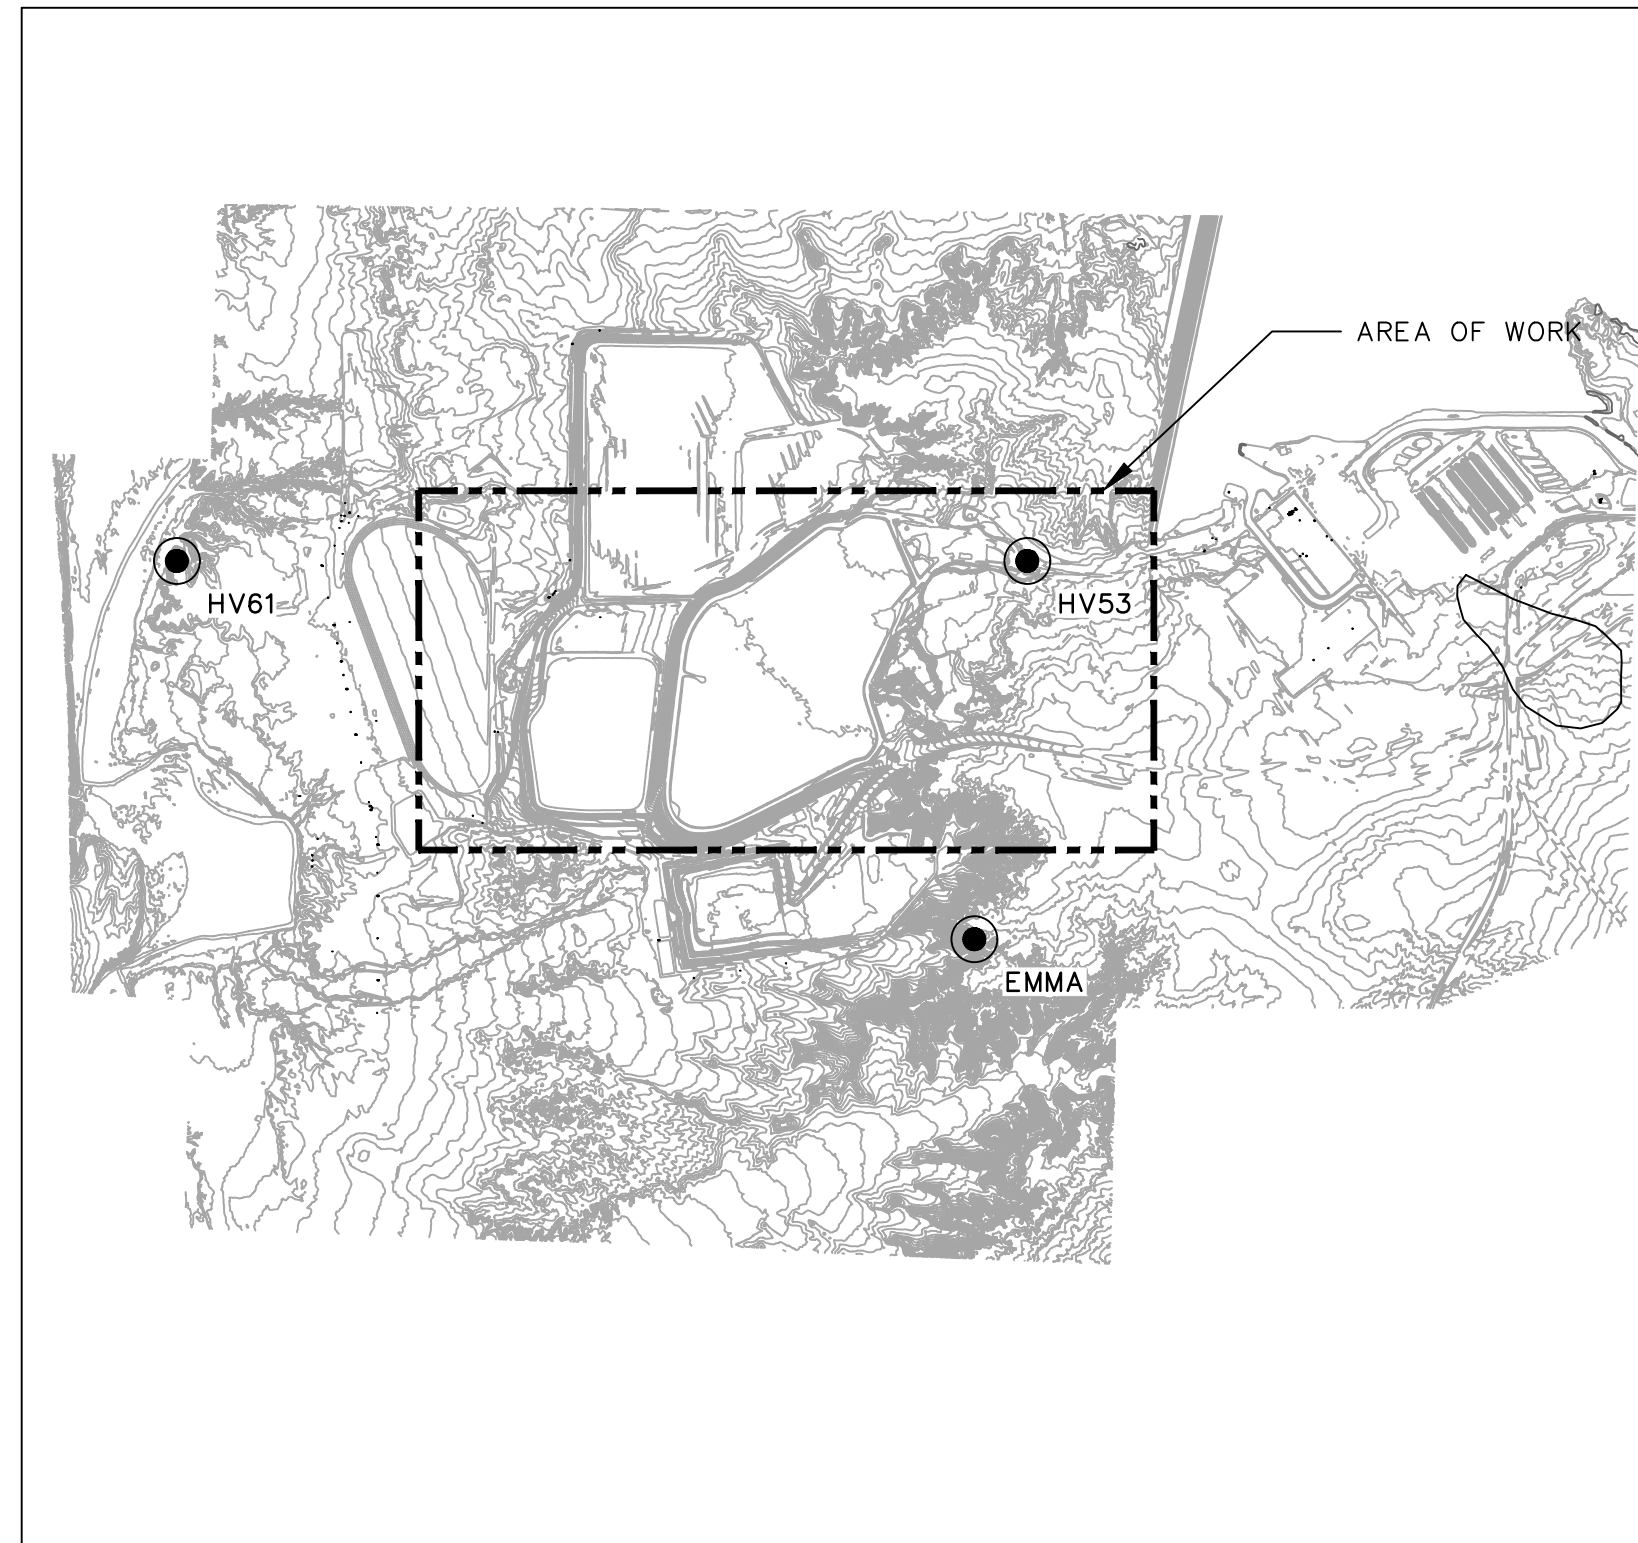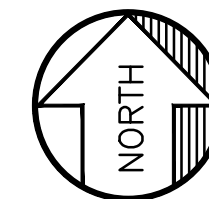

VICINITY MAP

N.T.S.

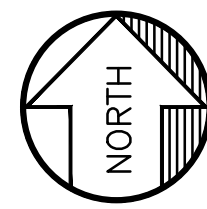

SAFETY

- WORKING SAFELY IS A CONDITION OF EMPLOYMENT AT ARIZONA PUBLIC SERVICE (APS). IT IS EXPECTED THAT ALL PERSONS ON SITE WILL FOLLOW THE APS PROCESSES, POLICIES, AND PROCEDURES.
- CONTRACTORS ARE RESPONSIBLE FOR THE SAFE AND HEALTHFUL PERFORMANCE OF WORK BY EACH OF THEIR EMPLOYEES, SUBCONTRACTORS, VENDORS OR SUPPORT PERSONNEL ENTERING THE SITE.
- MINIMUM PERSONAL PROTECTIVE EQUIPMENT (PPE) USAGE REQUIREMENTS FOR PERSONNEL AT THE SITE SHALL INCLUDE WEARING LONG PANTS AND LONG SLEEVE SHIRTS MADE FROM NON MELTING MATERIAL, HARD HATS, HEARING PROTECTION, ADVANCED SAFETY EYEWEAR (SPOGGLES), APPROPRIATE GLOVES, AND SAFETY TOE BOOTS. ADDITIONAL PPE MAY BE REQUIRED TO SAFELY PERFORM SPECIFIC TASKS.

GENERAL NOTES

- FOUR CORNERS POWER PLANT IS A COAL FIRED GENERATING PLANT ON THE NAVAJO INDIAN RESERVATION NEAR FRUITLAND, NEW MEXICO.

DATUM

- NEW MEXICO WEST ZONE (3003). STATE PLANE COORDINATE SYSTEM. US SURVEY FEET. HORIZONTAL: NORTH AMERICAN DATUM OF 1983 (NAD 83). VERTICAL: NORTH AMERICAN VERTICAL DATUM OF 1988 (NAVD 88).
- PRESERVE AND PROTECT EXISTING SURVEY MONUMENTS. ESTABLISH NORTHING, EASTING, AND ELEVATIONS OF SURVEY MONUMENTS AND REPORT COORDINATES TO ENGINEER PRIOR TO CONSTRUCTION.

CONTROL POINTS AND BENCHMARKS

POINT	NORTHING	EASTING	ELEVATION	DESCRIPTION
EMMA	N2,066,529.495	E2,528,708.477	5382.251'	ALUMINUM CAP
HV53	N2,070,581.505	E2,529,275.542	5331.214'	SCE BRASS CAP
HV61	N2,070,581.682	E2,520,166.590	5085.898'	SCE BRASS CAP

REFERENCE DATA

- THE OVERALL TOPOGRAPHIC SURVEY WAS PROVIDED BY AERIAL MAPPING COMPANY INC. ON APRIL 14, 2014
- TOPOGRAPHIC SURVEY FOR THE PROJECT SITE WAS PROVIDED BY SAKURA ENGINEERING AND SURVEYING ON APRIL 11, 2018

THESE RECORD DRAWINGS DATED 01/17/20 AND TITLED "FOR RECORD" HAVE BEEN DEVELOPED FROM AS-BUILT MARKUPS AND MAY NOT REPRESENT THE FINAL PROJECT, AS CONSTRUCTED, IN EVERY DETAIL. THESE RECORD DRAWINGS HAVE BEEN PREPARED BASED ON INFORMATION SUPPLIED BY OTHERS AND THE ENGINEER HAS NOT VERIFIED THE ACCURACY OR COMPLETENESS OF THE INFORMATION.

REFERENCE DRAWINGS

DRAWING NUMBER	TITLE
FC45CM-M-05-BAP-AP-156257-3	THICKENER SYSTEM - UTILITY VAULT / ISO VIEWS & DETAILS

CONTACTS

OWNER: ARIZONA PUBLIC SERVICE COMPANY
 GENERATION ENGINEERING
 P.O. BOX 53933 M.S. 3190
 PHOENIX AZ, 85072-3933

A.P.S. CONSTRUCTION COORDINATOR:
 THOMAS BUCHHOLZ
 FOUR CORNERS POWER PLANT
 COUNTY ROAD 6675
 FRUITLAND, NM 87416
 PHONE: 505-598-8735
 THOMAS.BUCHHOLZ@APS.COM

A.P.S. PROJECT MANAGER:
 BYRON CONRAD, PE
 400 N. 5TH ST.
 PHOENIX, AZ 85004
 PHONE: 602-250-5455
 BYRON.CONRAD@APS.COM

AECOM PROJECT ENGINEER:
 DAVID MICKANEN, PE
 7720 N. 16TH ST., STE. 100
 PHOENIX, AZ 85020
 PHONE: 602-371-1100
 FAX: 602-371-1615
 DAVID.MICKANEN@AECOM.COM

FOUR CORNERS POWER PLANT STREET ADDRESS:
 COUNTY ROAD 6675
 FRUITLAND, NM 87416

IN CASE OF EMERGENCY AT FOUR CORNERS
 POWER PLANT CALL 505-598-8311 OR 3911
 ON A PLANT TELEPHONE

1 01-17-20 FOR RECORD		AWF	DEM			FCC06814
NO.	DATE	REVISION	DWN	CHD	EXD	RWVD
FOUR CORNERS POWER PLANT RETURN WATER POND COVER SHEET						
AECOM		aps				
7720 N. 16th Street Suite 100 Phoenix, Arizona 85020 (602) 371-1100		SCALE AS NOTED		DATE 10/04/19		
WORK SAFELY TODAY		APPROVED		W A		
THIS DRAWING IS CONFIDENTIAL AND SHALL NOT BE USED OR REPRODUCED IN ANY PART WITHOUT WRITTEN CONSENT OF PINNACLE WEST CAPITAL CORPORATION.		DAVID E. MICKANEN DRAWING APPROVED BY		FCC06814		
UNIT	DISC	TYPE	SYS	SUBSYS	NUMBER	SHEET
FC45CM	X	41	WP	AP	200485	97



GENERAL NOTES:

- ALL WORK SHALL BE PERFORMED IN A WORKMANLIKE MANNER TO THE ENTIRE SATISFACTION OF THE OWNER AND ENGINEER AND IN ACCORDANCE WITH THE BEST RECOGNIZED TRADE PRACTICES.
- ALL WORK SHALL COMPLY WITH APPLICABLE STATE, FEDERAL, AND LOCAL CODES AND THE PROJECT SPECIFICATIONS. ALL NECESSARY LICENSES AND/OR PERMITS SHALL BE OBTAINED BY THE CONTRACTOR AT HIS EXPENSE.
- ENGINEER SHALL BE NOTIFIED A MINIMUM OF FORTY-EIGHT (48) HOURS IN ADVANCE OF SITE INSPECTIONS, TESTING VERIFICATIONS, AND FOR ANY OTHER PORTION OF THE WORK REQUIRING ENGINEERS SERVICES AT THE JOB SITE.
- CONTRACTOR SHALL NOTIFY ENGINEER NOT LESS THAN SEVEN (7) DAYS PRIOR TO STARTING WORK IN ORDER THAT ENGINEER MAY TAKE NECESSARY MEASURES TO INSURE PRESERVATION OF SURVEY MONUMENTS. CONTRACTOR SHALL NOT DISTURB PERMANENT SURVEY MONUMENTS WITHOUT THE CONSENT OF ENGINEER AND SHALL NOTIFY ENGINEER AND BEAR EXPENSE OF REPLACING ANY THAT MAY BE DISTURBED WITHOUT PERMISSION. REPLACEMENT SHALL BE DONE ONLY BY A NEW MEXICO REGISTERED PROFESSIONAL SURVEYOR. WHEN A CHANGE IS MADE IN THE FINISHED ELEVATION OF THE PAVEMENT OF ANY ROADWAY IN WHICH A PERMANENT SURVEY MONUMENT IS LOCATED, CONTRACTOR SHALL, AT HIS OWN EXPENSE, ADJUST THE MONUMENT COVER TO THE NEW GRADE UNLESS OTHERWISE SPECIFIED.
- CONTRACTOR SHALL READ AND MAKE CAREFUL EXAMINATION OF THE PLANS, SPECIFICATIONS, QUANTITIES, AND MATERIALS AND SHALL VISIT THE SITE OF THE PROPOSED CONSTRUCTION TO BECOME FAMILIAR WITH SITE CONDITIONS AND LIMITATIONS BEFORE MAKING A PROPOSAL. CONTRACTOR SHALL MAKE ANY INVESTIGATIONS NECESSARY TO DETERMINE THE EXTENT OF THE WORK REQUIRED TO CONSTRUCT THE PROJECT. CONTRACTOR SHALL BE RESPONSIBLE FOR ANY AND ALL ERRORS RESULTING FROM FAILURE TO MAKE SUCH AN EXAMINATION. ANY INFORMATION DERIVED FROM THE MAPS, PLANS, SPECIFICATIONS, PROFILES, DRAWINGS OR FROM ENGINEER, WILL NOT RELIEVE CONTRACTOR FROM ANY RISK OR FROM FULFILLING THE TERMS OF THE CONTRACT.
- ANY EXISTING OR NEW SITE FEATURES OR OTHER IMPROVEMENTS DAMAGED BY CONTRACTOR DURING CONSTRUCTION SHALL BE REPAIRED BY CONTRACTOR TO EQUAL OR BETTER CONDITION AT NO ADDITIONAL COST TO THE OWNER.
- CONTRACTOR SHALL NOT INSTALL ITEMS AS SHOWN ON THE PLANS WHEN IT IS OBVIOUS THAT FIELD CONDITIONS ARE DIFFERENT THAN SHOWN IN THE DESIGN. SUCH CONDITIONS SHOULD BE BROUGHT TO THE ATTENTION OF THE PROJECT MANAGER. IN THE EVENT CONTRACTOR DOES NOT NOTIFY PROJECT MANAGER, CONTRACTOR ASSUMES FULL RESPONSIBILITY AND EXPENSE FOR ANY REVISIONS NECESSARY.
- NEITHER THE OWNER, CONSTRUCTION MANAGER, NOR THE ENGINEER OF RECORD WILL ENFORCE ANY SAFETY MEASURE OR REGULATION. CONTRACTOR SHALL DESIGN, CONSTRUCT AND MAINTAIN ALL SAFETY DEVICES, INCLUDING TRAFFIC CONTROL AND SHORING, AND SHALL BE SOLELY RESPONSIBLE FOR CONFORMING TO ALL LOCAL, STATE, AND FEDERAL SAFETY AND HEALTH STANDARDS, LAWS AND REGULATIONS. IF ANYONE IN AN AUTHORITY OR SUPERVISORY POSITION SEES ANYTHING WRONG OR A SERIOUS LIFE THREATENING SITUATION CAUSED BY CONTRACTOR, THAT PERSON SHALL HAVE THE RIGHT TO STOP THE JOB UNTIL SITUATION IS CORRECTED.
- CONTRACTOR WILL BE RESPONSIBLE FOR ANY MONUMENTATION AND/OR BENCHMARKS THAT WILL BE DISTURBED OR DESTROYED BY CONSTRUCTION.
- CONTRACTOR SHALL ASSUME SOLE AND COMPLETE RESPONSIBILITY FOR JOB SITE CONDITIONS DURING THE COURSE OF CONSTRUCTION OF THIS PROJECT, INCLUDING SAFETY OF ALL PERSONS AND PROPERTY; THAT THIS REQUIREMENT SHALL APPLY 24 HOURS A DAY AND NOT BE LIMITED TO NORMAL WORKING HOURS; AND THAT CONTRACTOR SHALL DEFEND, INDEMNIFY, AND HOLD OWNER AND ENGINEER HARMLESS OF ANY AND ALL LIABILITY, REAL OR ALLEGED, IN CONNECTION WITH THE PERFORMANCE OF WORK ON THE PROJECT, EXCEPTING LIABILITY ARISING FROM THE SOLE NEGLIGENCE OF OWNER OR ENGINEER.
- CONTRACTOR IS RESPONSIBLE FOR THE PROTECTION OF HIS WORK FROM RAINFALL, STORM DRAINAGE, OR FLOOD SO THAT IT DOES NOT DELAY CONSTRUCTION OR DAMAGE COMPLETED WORK OR DOWNSTREAM PROPERTIES THROUGHOUT CONSTRUCTION.
- QUANTITIES SHOWN ARE FOR ESTIMATING PURPOSES ONLY AND TO COMPARE AND CANVAS BIDS. ACTUAL PAY QUANTITIES WILL BE DETERMINED IN THE FIELD FOR AUTHORIZED CHANGES THAT AFFECT THE QUANTITIES.
- CONTRACTOR SHALL BE RESPONSIBLE FOR GENERAL SAFETY DURING CONSTRUCTION. ALL CONSTRUCTION PRACTICES AND PROCEDURES SHALL COMPLY WITH THE PERTINENT PROVISIONS OF THE OCCUPATIONAL SAFETY AND HEALTH ADMINISTRATION (OSHA) STANDARDS (TITLE 29, CODE OF FEDERAL REGULATIONS).
- CONTRACTOR SHALL MAINTAIN A DEBRIS FREE WORK SITE. PROVIDE TRASH RECEPTACLES FOR ALL WASTE MATERIAL INCLUDING PERSONAL WASTE SUCH AS LUNCH BAGS.
- CONTRACTOR SHALL BE RESPONSIBLE FOR MAINTAINING THE SITE IN A NEAT AND ORDERLY MANNER THROUGHOUT THE CONSTRUCTION PROCESS. ALL MATERIALS SHALL BE STORED WITHIN APPROVED CONSTRUCTION AREAS.
- ALL WORK SHALL BE IN ACCORDANCE WITH THE CONTRACT DOCUMENTS, WHICH INCLUDES THESE DRAWINGS, THE PROJECT SPECIFICATIONS, AND ANY ADDITIONS AND SUPPLEMENTS.
- CONSTRUCTION ACCESS TO BE AT DESIGNATED LOCATIONS ONLY. CONTACT OWNER'S REP. FOR SPECIFIC INSTRUCTIONS.
- DISPOSAL OF UNSUITABLE MATERIAL AND ITEMS DESIGNED FOR REMOVAL WITHOUT SALVAGE SHALL BE IN ACCORDANCE WITH LANDFILL (DISPOSAL) SITE REQUIREMENTS.
- CONTRACTOR SHALL PERFORM HIS OWN SURVEY TO ESTABLISH HORIZONTAL AND VERTICAL CONTROL FOR THE PROJECT.
- WHERE NOTED ON PLANS OR DRAWINGS, COMPLY WITH THE 2014 EDITION OF THE NEW MEXICO STATE DEPARTMENT OF TRANSPORTATION (NMDOT) STANDARD SPECIFICATIONS FOR HIGHWAY AND BRIDGE CONSTRUCTION (STANDARD SPECS).
- ANY DISCREPANCIES BETWEEN DRAWINGS AND SPECIFICATIONS SHALL BE BROUGHT TO ENGINEERS ATTENTION FOR RESOLUTION.
- CONTRACTOR SHALL KEEP ON SITE WITHIN THE PROJECT AREA THE PROJECT SAFETY PLAN. ALL WORKERS SHALL HAVE ACCESS TO THE SAFETY PLAN AT ALL TIMES.

UTILITY NOTES:

- CONTRACTOR TO USE EXTREME CAUTION NOT TO DISTURB OR DAMAGE EXISTING STORM DRAIN, PIPELINES, SITE EQUIPMENT, VALVES, MANHOLES AND ALL SUBSURFACE UTILITIES THROUGHOUT CONSTRUCTION. CONTRACTOR SHALL LOCATE ALL SURFACE UTILITY FEATURES PRIOR TO CONSTRUCTION AND SHALL PLACE VISIBLE MARKERS TO MARK UTILITY FEATURES NOT TO BE DISTURBED. IF DAMAGED THEN REPAIR AT CONTRACTOR'S EXPENSE.
- CONTRACTOR SHALL NOTIFY ALL APPLICABLE UTILITY COMPANIES AND COORDINATE UTILITY LINE SPOTS AT LEAST SEVEN (7) WORKING DAYS PRIOR TO ANY DIGGING OR EXCAVATION.
- TWO (2) WORKING DAYS PRIOR TO ANY CONSTRUCTION, CONTRACTOR MUST CONTACT LINE LOCATING SERVICES NMOC: TOLL FREE AT 1-800-321-2537 FOR LOCATION OF EXISTING UTILITIES.

UTILITY NOTES CONT.:

- CONTRACTOR SHALL FIELD VERIFY ALL EXISTING UTILITY LOCATIONS AND SHALL NOTIFY THE ENGINEER IMMEDIATELY OF ANY DISCREPANCIES. ALL ELECTRICAL, TELEPHONE, CABLE TV, GAS AND OTHER UTILITY LINES, CABLES AND APPURTENANCES ENCOUNTERED DURING CONSTRUCTION THAT REQUIRE RELOCATION SHALL BE COORDINATED WITH THAT UTILITY, BE IT PRIVATE OR CITY OWNED. CONTRACTOR SHALL BE RESPONSIBLE FOR COORDINATION OF ALL NECESSARY UTILITY ADJUSTMENTS. CONTRACTOR MAY BE REQUIRED TO RESCHEDULE HIS ACTIVITIES TO ALLOW UTILITY CREWS TO PERFORM THEIR REQUIRED WORK.
- ALL UNDERGROUND UTILITIES SHOWN ON THESE DRAWINGS SHOULD BE CONSIDERED APPROXIMATE ONLY.
- THE INFORMATION SHOWN ON THESE DRAWINGS CONCERNING TYPE AND LOCATION OF UNDERGROUND AND OTHER UTILITIES IS NOT GUARANTEED TO BE ACCURATE OR ALL-INCLUSIVE. CONTRACTOR IS RESPONSIBLE FOR MAKING HIS OWN DETERMINATIONS AS TO THE TYPE AND LOCATION OF UNDERGROUND AND OTHER UTILITIES AS MAY BE NECESSARY TO AVOID DAMAGE THERETO. CONTRACTOR SHALL USE EXTREME CARE WHEN PERFORMING ANY DEMOLITION OR GRADING OPERATIONS IN THE PROXIMITY OF THESE EXISTING UTILITIES. ANY DAMAGE TO EXISTING UTILITIES WILL BE REPAIRED AT THE CONTRACTOR'S EXPENSE. NOTIFY OWNER WHEN ANY UNIDENTIFIED UTILITIES ARE DISCOVERED.
- OBTAIN WRITTEN AUTHORIZATION FROM THE OWNER'S REPRESENTATIVE AND FROM THE UTILITY OWNERS PRIOR TO INTERRUPTING ANY EXISTING UTILITY (IE: WATER, SEWER, GAS, ELECTRICAL, OR TELEPHONE).
- CONSTRUCTION SHALL COMPLY WITH GOVERNING CODES AND REQUIREMENTS. CONTRACTOR SHALL CONDUCT ALL REQUIRED TESTS TO THE SATISFACTION OF THE UTILITY COMPANY'S AND OWNER'S INSPECTING AUTHORITIES.
- CONTRACTOR SHALL COMPLY TO THE FULLEST EXTENT WITH THE LATEST STANDARDS OF OSHA DIRECTIVES, INCLUDING 29 CFR PART 1926 SUBPART P, OR ANY OTHER AGENCY HAVING JURISDICTION FOR EXCAVATION AND TRENCHING PROCEDURE. CONTRACTOR SHALL USE SUPPORT SYSTEMS, SLOPING, BENCHING AND OTHER MEANS OF PROTECTION. THIS IS TO INCLUDE, BUT NOT LIMITED FOR ACCESS AND EGRESS FROM ALL EXCAVATION AND TRENCHING.
- HYDRO-EXCAVATE TO A MINIMUM DEPTH OF 6 FEET TO FIELD VERIFY ALL EXISTING UNDERGROUND FACILITIES AND/OR UTILITIES.

GRADING AND DRAINAGE NOTES:

- CONTRACTOR'S SOILS ENGINEER SHALL CERTIFY THAT THE REQUIRED INSPECTIONS AND TESTS HAVE BEEN PERFORMED AND THAT SUCH TESTS COMPLY WITH CODE.
- EXERCISE SUFFICIENT SUPERVISORY CONTROL DURING GRADING AND CONSTRUCTION TO ENSURE COMPLIANCE WITH THE APPROVED PLANS AND SPECIFICATIONS.
- SUBGRADE PREPARATION SHALL BE IN ACCORDANCE WITH PROJECT SPECIFICATION SECTION 312300.
- FILLS SHALL BE COMPACTED THROUGHOUT TO AT LEAST 95% OF THE MAXIMUM DRY DENSITY AS DETERMINED BY ASTM D698, "STANDARD TEST METHOD FOR LABORATORY COMPACTION CHARACTERISTICS OF SOIL USING STANDARD EFFORT."
- FILL AREAS SHALL BE CLEARED OF ALL VEGETATION AND DEBRIS, PROOFROLLED AND SCARIFIED, HAVE SUBDRAINS INSTALLED (IF ANY) AND APPROVED BY THE GRADING INSPECTOR AND SOILS ENGINEER PRIOR TO THE PLACING OF FILL.
- NO ROCK OR SIMILAR MATERIAL GREATER THAN 6 INCHES IN DIAMETER SHALL BE PLACED IN THE FILL UNLESS APPROVED BY THE ENGINEER.
- DEGREE OF COMPACTION OR RELATIVE COMPACTION SHALL BE DETERMINED BY ASTM D698, "STANDARD TEST METHOD FOR LABORATORY COMPACTION CHARACTERISTICS OF SOIL USING STANDARD EFFORT".
- HAUL PERMITS, WHEN REQUIRED, MUST BE OBTAINED BY CONTRACTOR PRIOR TO WORK.

GEOSYNTHETICS NOTES:

- HDPE GEOMEMBRANE SHALL CONFORM TO GEOSYNTHETIC RESEARCH INSTITUTE (GRI) TEST METHOD GM13(A), "STANDARD SPECIFICATION FOR TEST METHODS, TEST PROPERTIES, AND TESTING FREQUENCY FOR HIGH DENSITY POLYETHYLENE (HDPE) SMOOTH AND TEXTURED GEOMEMBRANES."
- GEOMEMBRANE SHALL HAVE A 60-MIL MINIMUM AVERAGE THICKNESS.
- GEOSYNTHETIC CLAY LINER (GCL) SHALL CONFORM TO GRI TEST METHOD GCL3, "STANDARD SPECIFICATIONS FOR TEST METHODS, REQUIRED PROPERTIES, AND TESTING FREQUENCIES OF GEOSYNTHETIC CLAY LINERS (GCL)".

ABBREVIATIONS

AASHTO	AMERICAN ASSOCIATION OF STATE HIGHWAY AND TRANSPORTATION OFFICIALS
ABC	AGGREGATE BASE COURSE
AC	ACRE
APPROX	APPROXIMATE
APS	ARIZONA PUBLIC SERVICE COMPANY
ASTM	AMERICAN SOCIETY FOR TESTING AND MATERIALS
BP	BURIED PIPE
BMP	BEST MANAGEMENT PRACTICES
C	CIVIL
CCR	COAL COMBUSTION RESIDUALS
CL	CENTERLINE
CLR	CLEAR
CLSM	CONTROLLED LOW STRENGTH MATERIAL
COR	CORNER
CTR	CENTER
DEMO	DEMOLITION
DFADA	DRY FLY ASH DISPOSAL AREA
DIA	DIAMETER
DIP	DUCTILE IRON PIPE
DWG	DRAWING
DR	DIMENSION RATIO
E	EASTING
EL	ELEVATION
EMBED	EMBEDMENT
EP	END POINT
EXIST	EXISTING
FDG	FLUE GAS DESULPHURIZATION
FG	FINISH GRADE
FLG	FLANGE
FNC	FENCE
FT	FEET/FOOT
GA	GAUGE
GCL	GEOSYNTHETIC CLAY LINER
GD	GRAVITY DRAIN
GPM	GALLONS PER MINUTE
GRI	GEOSYNTHETIC RESEARCH INSTITUTE
GSKT	GASKET
HDPE	HIGH DENSITY POLYETHYLENE
HORZ	HORIZONTAL
HP	HIGH POINT
LAI	LINED ASH IMPOUNDMENT
LCRS	LEAK COLLECTION AND RECOVERY SYSTEM
LDWP	LINED DECANT WATER POND
LF	LINEAR FOOT
MAX	MAXIMUM
MUTCD	MANUAL ON UNIFORM TRAFFIC CONTROL DEVICES
MIN	MINIMUM
MW	MONITORING WELL
NMOC	NEW MEXICO DEPARTMENT OF TRANSPORTATION
N	NEW MEXICO ONE CALL
NAD	NORTH AMERICAN DATUM
NAVD	NORTH AMERICAN VERTICAL DATUM
NTS	NOT TO SCALE
O.C.	ON CENTER
OD	OUTSIDE DIAMETER
OHE	OVERHEAD ELECTRIC POWER
OSHA	OCCUPATIONAL SAFETY & HEALTH ADMINISTRATION
OS&Y	OUTSIDE SCREW AND YOKE
OZ	OUNCE
P	PIPE
PC	POINT OF CURVATURE
P&ID	PROCESS AND INSTRUMENTATION DIAGRAM
PI	POINT OF INTERSECTION
PLCS	PLACES
PSI	POUNDS PER SQUARE INCH
PT	POINT OF TANGENCY
PVI	POINT OF VERTICAL INTERSECTION
R	RADIUS
REQ'D	REQUIRED
RWI	RETURN WATER INLET
RWP	RETURN WATER POND
S	BAR SPACING
SCHED	SCHEDULE
SEC	SECTION
SPEC.	SPECIFICATION
SS	STAINLESS STEEL
STA	STATION
STD	STANDARD
SY	SQUARE YARD
THRU	THROUGH
TP	TIE POINT
TYP	TYPICAL
UON	UNLESS OTHERWISE NOTED
YD	YARD
W/	WITH

LEGEND

	EXISTING 1' CONTOURS
	EXISTING 5' CONTOURS
	PROPOSED 1' CONTOURS
	PROPOSED 5' CONTOURS
	EXISTING GRADE
	LIMITS OF DISTURBANCE
	EXISTING DIRT ROAD
	EXISTING FENCE
	EXISTING FENCE
	PROPOSED FENCE
	OVERHEAD POWERLINE
	EXISTING OVERHEAD POWERLINE
	EXISTING UNDERGROUND ELECTRIC
	EXISTING PIPE
	TEMPORARY STAGING AREA
	FINISHED GRADE
	MAX WATER LEVEL
	PROPOSED ABOVE GROUND PIPE
	EXISTING ABOVE GROUND PRESSURE PIPE
	EXISTING BURIED PIPE
	BURIED PIPE ALIGNMENT
	RETURN WATER INLET PIPE
	GRAVITY DRAIN
	SANITARY SEWER
	GEOMEMBRANE
	GCL
	GEONET

LEGEND

	FREE DRAINING GRAVEL
	C33 SAND AND NUMBER 6 STONE
	CONCRETE
	STRUCTURAL FILL
	COMPACTED SUBGRADE
	GRAVEL SURFACING / PAVEMENT
	GENERAL FILL
	SAND
	GROUT
	NATURAL GROUND / EXISTING GROUND SURFACE
	CONTROLLED LOW STRENGTH MATERIAL
	DEMOLITION
	STOCKPILE / LAYDOWN AREA
	REVEGETATION

LEGEND SYMBOLS

	DIRECTION OF FLOW
	FINAL GRADE CONTROL POINT
	SECTION LETTER AND PAGE NUMBER
	DETAIL NUMBER AND PAGE NUMBER
	EXISTING POINT ELEVATIONS
	EXISTING MONITORING WELL
	RWP TEST PITS (2018)
	EXISTING MONITORING WELL
	EXISTING MONITORING WELL
	DIAMETER
	EXISTING POWER TOWER
	CENTER LINE
	POWER POLE

LEGEND MONUMENTS

	BENCHMARK
	FOUND BRASS OR ALUMINUM CAP AS NOTED
	EXISTING SURFACE MONUMENT
	SITE TEMPORARY BENCHMARK (TBM)

THESE RECORD DRAWINGS DATED 01/17/20 AND TITLED "FOR RECORD" HAVE BEEN DEVELOPED FROM AS-BUILT MARKUPS AND MAY NOT REPRESENT THE FINAL PROJECT, AS CONSTRUCTED, IN EVERY DETAIL. THESE RECORD DRAWINGS HAVE BEEN PREPARED BASED ON INFORMATION SUPPLIED BY OTHERS AND THE ENGINEER HAS NOT VERIFIED THE ACCURACY OR COMPLETENESS OF THE INFORMATION.

1	01-17-20	FOR RECORD	AWF	DEM				FCC06814
NO.	DATE	REVISION	DWN	CHD	EXD	RWWD	APVD	W.A.

FOUR CORNERS POWER PLANT
RETURN WATER POND
GENERAL NOTES, LEGEND, AND ABBREVIATIONS



SCALE: NONE DATE: 10/04/19

DWN	AWF	EXD	---	APPROVED	W A
CHD	DEM	RWWD	---	DAVID E. MICKANEN	FCC06814
				DRAWING APPROVED BY	

UNIT	DISC	TYPE	SYS	SUBSYS	NUMBER	SHEET
FC45CM	X	98	WP	AP	200485	2




7720 N. 16th Street Suite 100
Phoenix, Arizona 85020
(602) 371-1100




WORK SAFELY TODAY

THIS DRAWING IS CONFIDENTIAL AND SHALL NOT BE USED OR REPRODUCED IN ANY PART WITHOUT WRITTEN CONSENT OF PINNACLE WEST CAPITAL CORPORATION.

CONSTRUCTION NOTES:
 1. SITE TOPOGRAPHIC CONTOURS FROM "RETURN WATER PROJECT TOPOGRAPHIC SURVEY" BY SAKURA ENGINEERING, INC. DATED APRIL 11, 2018. HORIZONTAL DATUM NAD 83, VERTICAL DATUM NAVD 88, NEW MEXICO STATE PLAN TRANSVERSE MERCATOR-WEST.

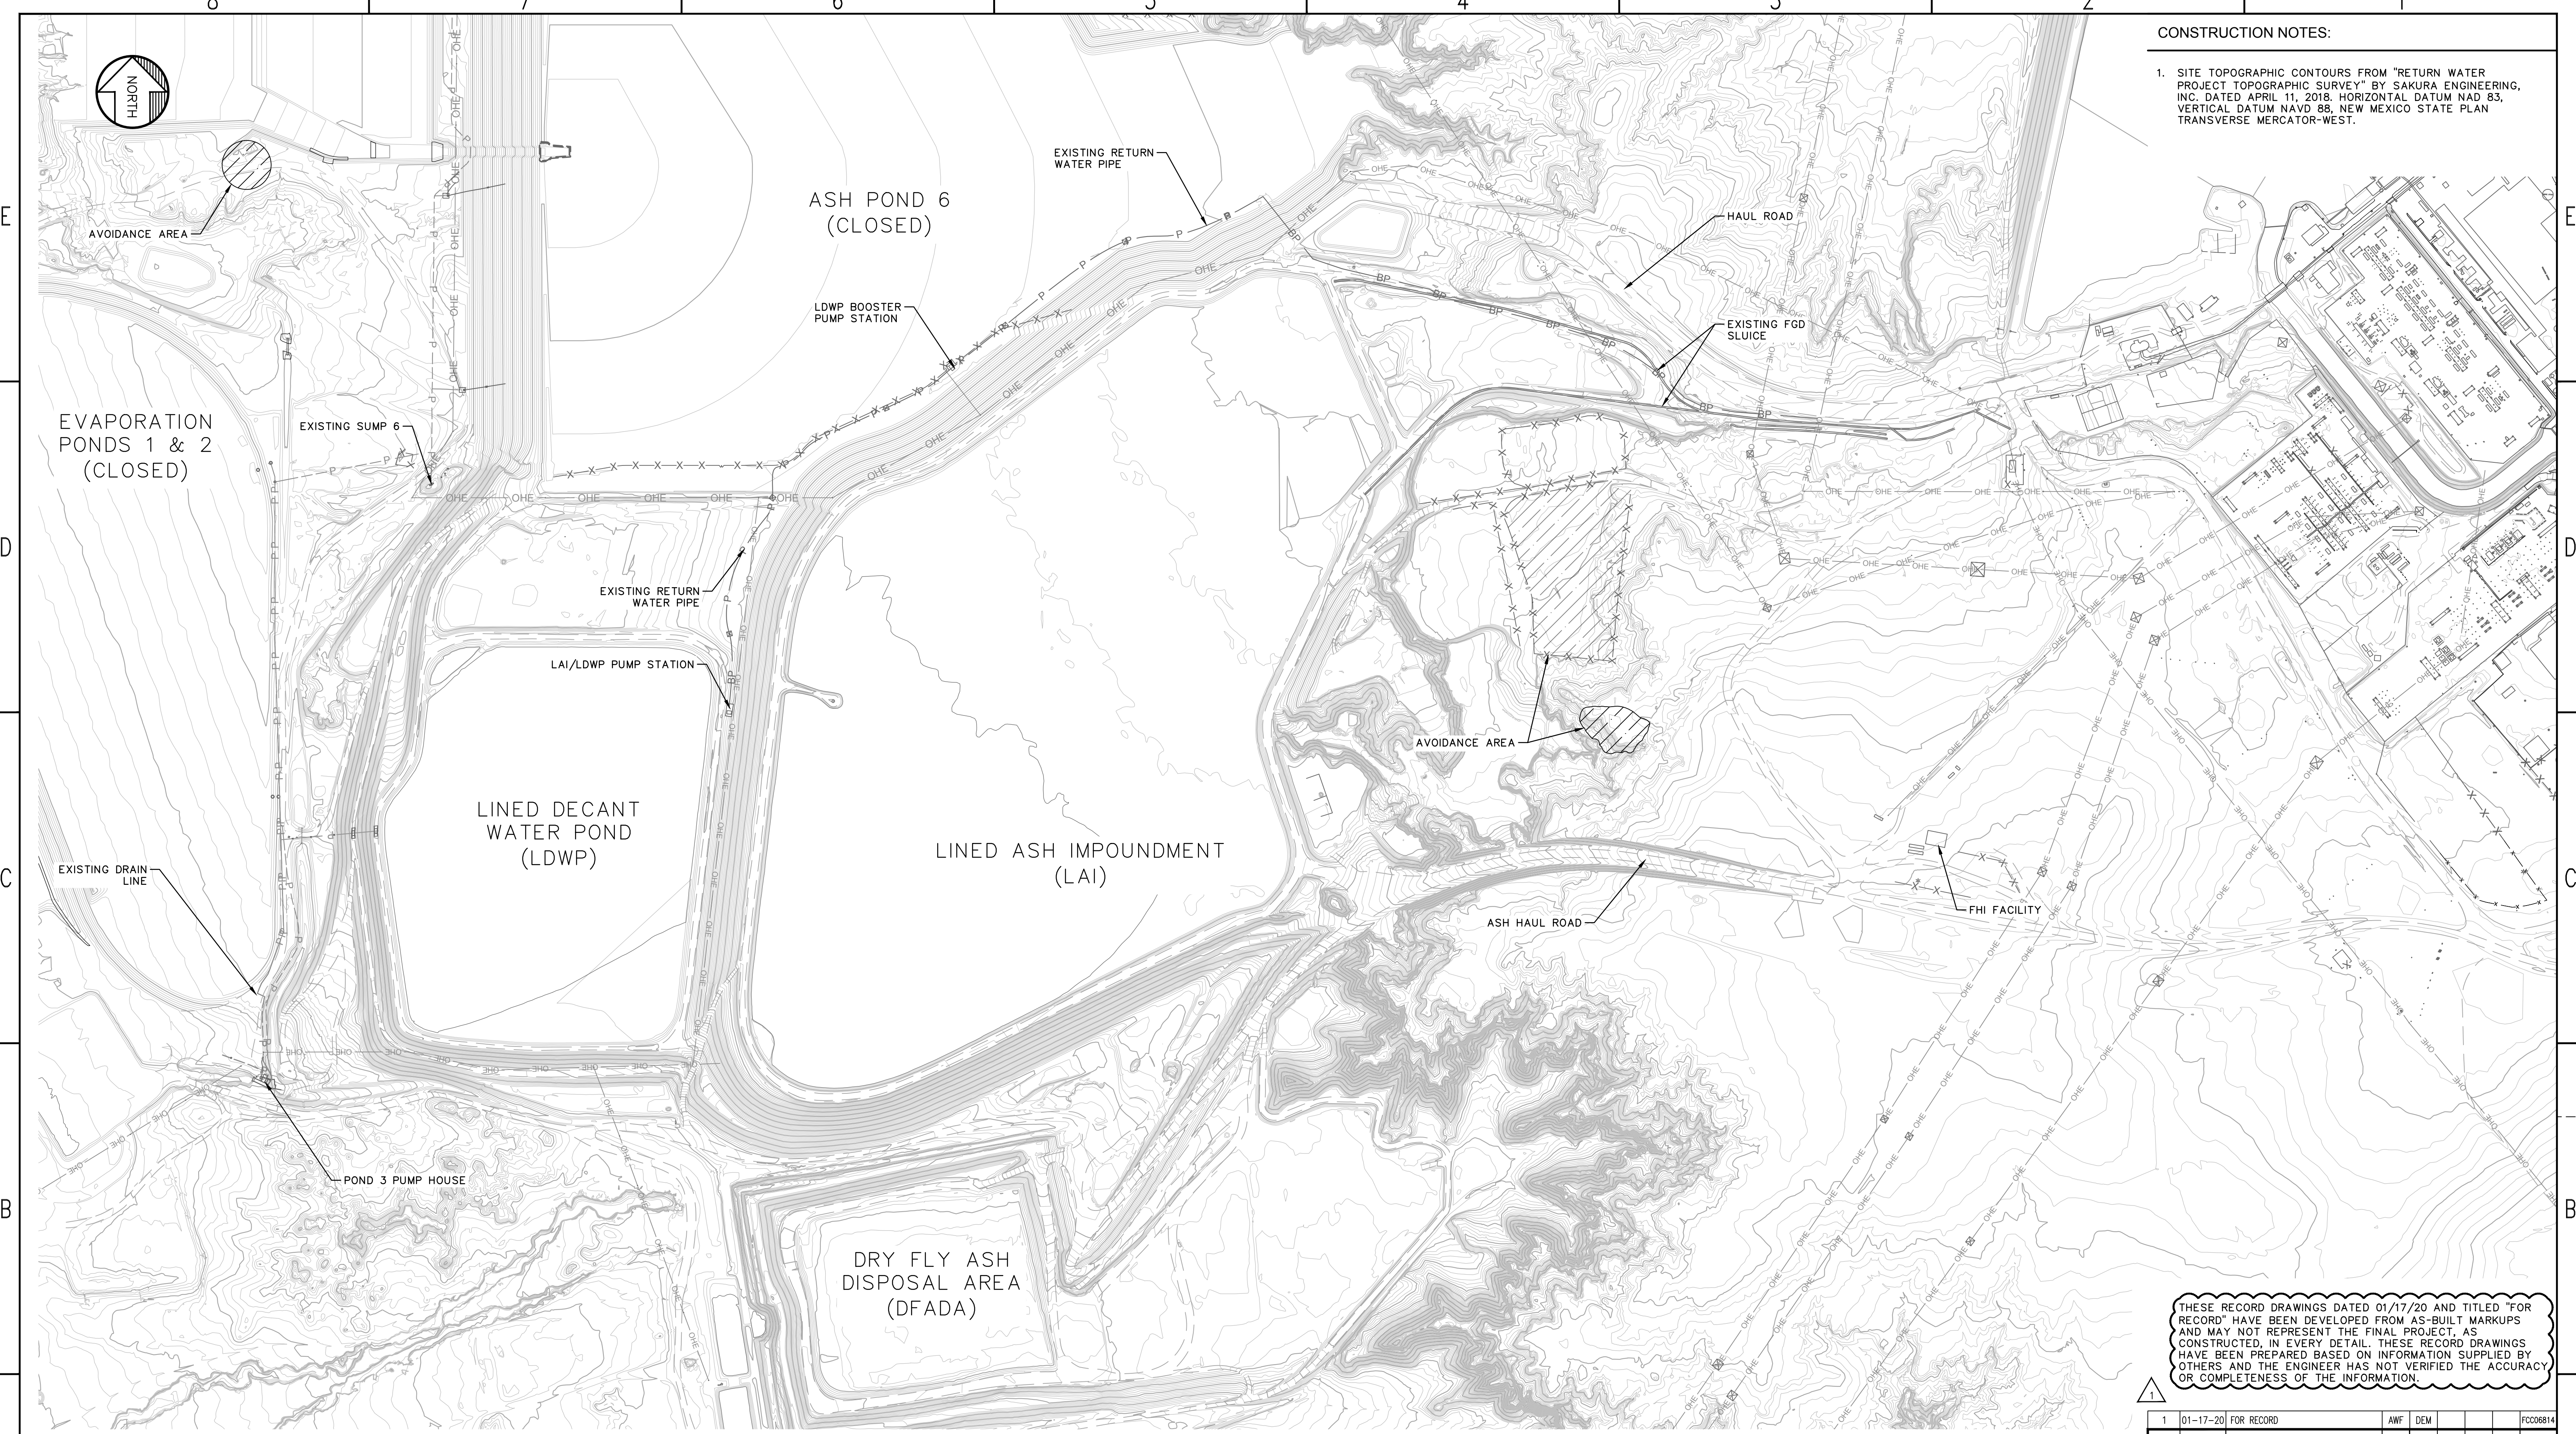

EXISTING CONDITIONS PLAN
 SCALE: 1"=300' (FULL SIZE)

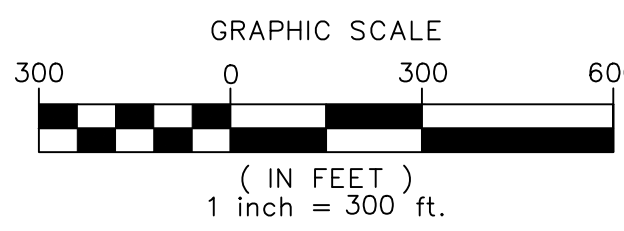

THESE RECORD DRAWINGS DATED 01/17/20 AND TITLED "FOR RECORD" HAVE BEEN DEVELOPED FROM AS-BUILT MARKUPS AND MAY NOT REPRESENT THE FINAL PROJECT, AS CONSTRUCTED. IN EVERY DETAIL THESE RECORD DRAWINGS HAVE BEEN PREPARED BASED ON INFORMATION SUPPLIED BY OTHERS AND THE ENGINEER HAS NOT VERIFIED THE ACCURACY OR COMPLETENESS OF THE INFORMATION.

1	01-17-20	FOR RECORD	AWF	DEM			FCC06814
NO.	DATE	REVISION	DWN	CHD	EXD	RWVD	APVD

FOUR CORNERS POWER PLANT
 RETURN WATER POND
 EXISTING CONDITIONS PLAN

SCALE: 1" = 300' DATE: 10/04/19


DWN	AWF	EXD	---	APPROVED	W A	
CHD	DEM	RWVD	---	DAVID E. MICKANEN DRAWING APPROVED BY	FCC06814	
UNIT	DISC	TYPE	SYS	SUBSYS	NUMBER	SHEET
FC45CM	C	41	WP	AP	200485	3

7720 N. 16th Street Suite 100
 Phoenix, Arizona 85020
 (602) 371-1100

WORK SAFELY TODAY

THIS DRAWING IS CONFIDENTIAL AND SHALL NOT BE USED OR REPRODUCED IN ANY PART WITHOUT WRITTEN CONSENT OF PINNACLE WEST CAPITAL CORPORATION.


Dial 8-1-1 or 1-800-321-2537

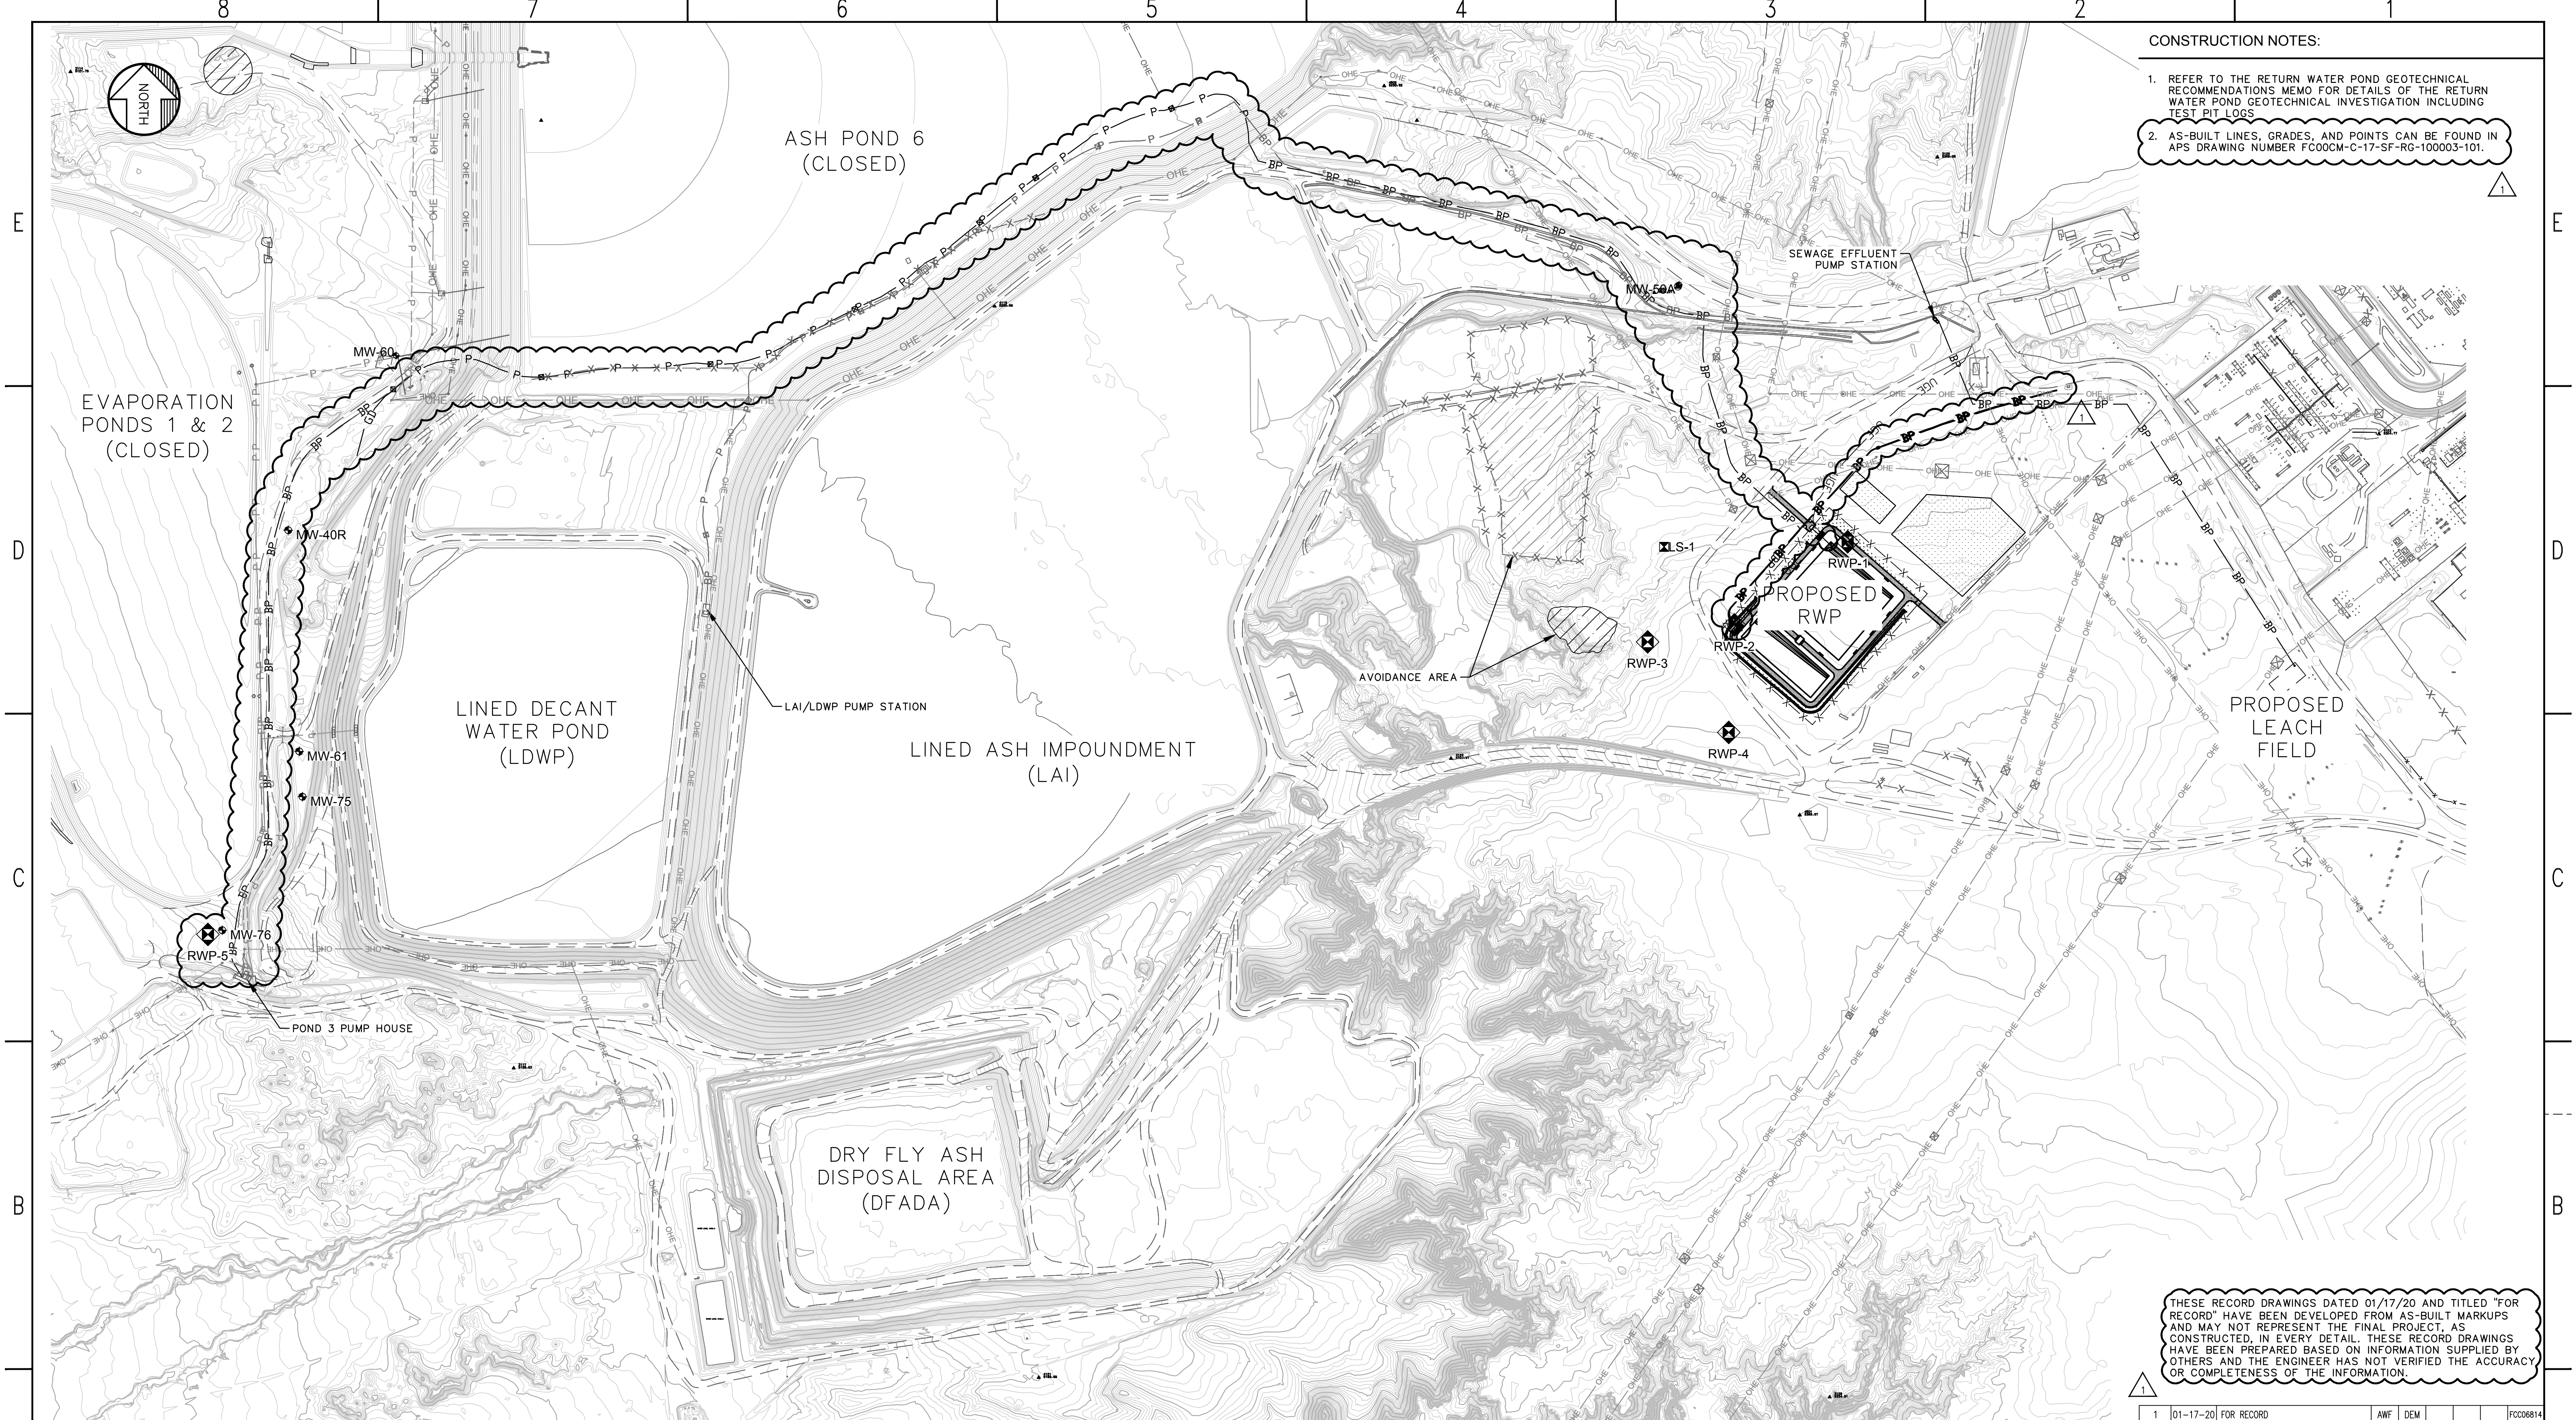

- CONSTRUCTION NOTES:**
- REFER TO THE RETURN WATER POND GEOTECHNICAL RECOMMENDATIONS MEMO FOR DETAILS OF THE RETURN WATER POND GEOTECHNICAL INVESTIGATION INCLUDING TEST PIT LOGS
 - AS-BUILT LINES, GRADES, AND POINTS CAN BE FOUND IN APS DRAWING NUMBER FC00CM-C-17-SF-RG-100003-101.

THESE RECORD DRAWINGS DATED 01/17/20 AND TITLED "FOR RECORD" HAVE BEEN DEVELOPED FROM AS-BUILT MARKUPS AND MAY NOT REPRESENT THE FINAL PROJECT, AS CONSTRUCTED, IN EVERY DETAIL. THESE RECORD DRAWINGS HAVE BEEN PREPARED BASED ON INFORMATION SUPPLIED BY OTHERS AND THE ENGINEER HAS NOT VERIFIED THE ACCURACY OR COMPLETENESS OF THE INFORMATION.

GEOTECHNICAL INVESTIGATION LOCATION MAP
SCALE: 1"=300' (FULL SIZE)

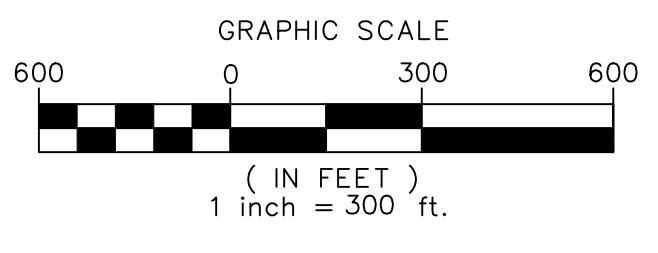

1	01-17-20	FOR RECORD	AWF	DEM			FC006814
NO.	DATE	REVISION	DWN	CHD	EXD	RWVD	APVD

FOUR CORNERS POWER PLANT
RETURN WATER POND
GEOTECHNICAL INVESTIGATION LOCATION MAP



SCALE: 1"=300' DATE: 10/04/19

DWN	AWF	EXD	---	APPROVED	W A
CHD	DEM	RWVD	---	DAVID E. MICKANEN	FCC06814
				DRAWING APPROVED BY	


UNIT	DISC	TYPE	SYS	SUBSYS	NUMBER	SHEET
FC45CM	C	16	WP	AP	200485	4

AECOM
7720 N. 16th Street Suite 100
Phoenix, Arizona 85020
(602) 371-1100




WORK SAFELY TODAY

THIS DRAWING IS CONFIDENTIAL AND SHALL NOT BE USED OR REPRODUCED IN ANY PART WITHOUT WRITTEN CONSENT OF PINNACLE WEST CAPITAL CORPORATION.

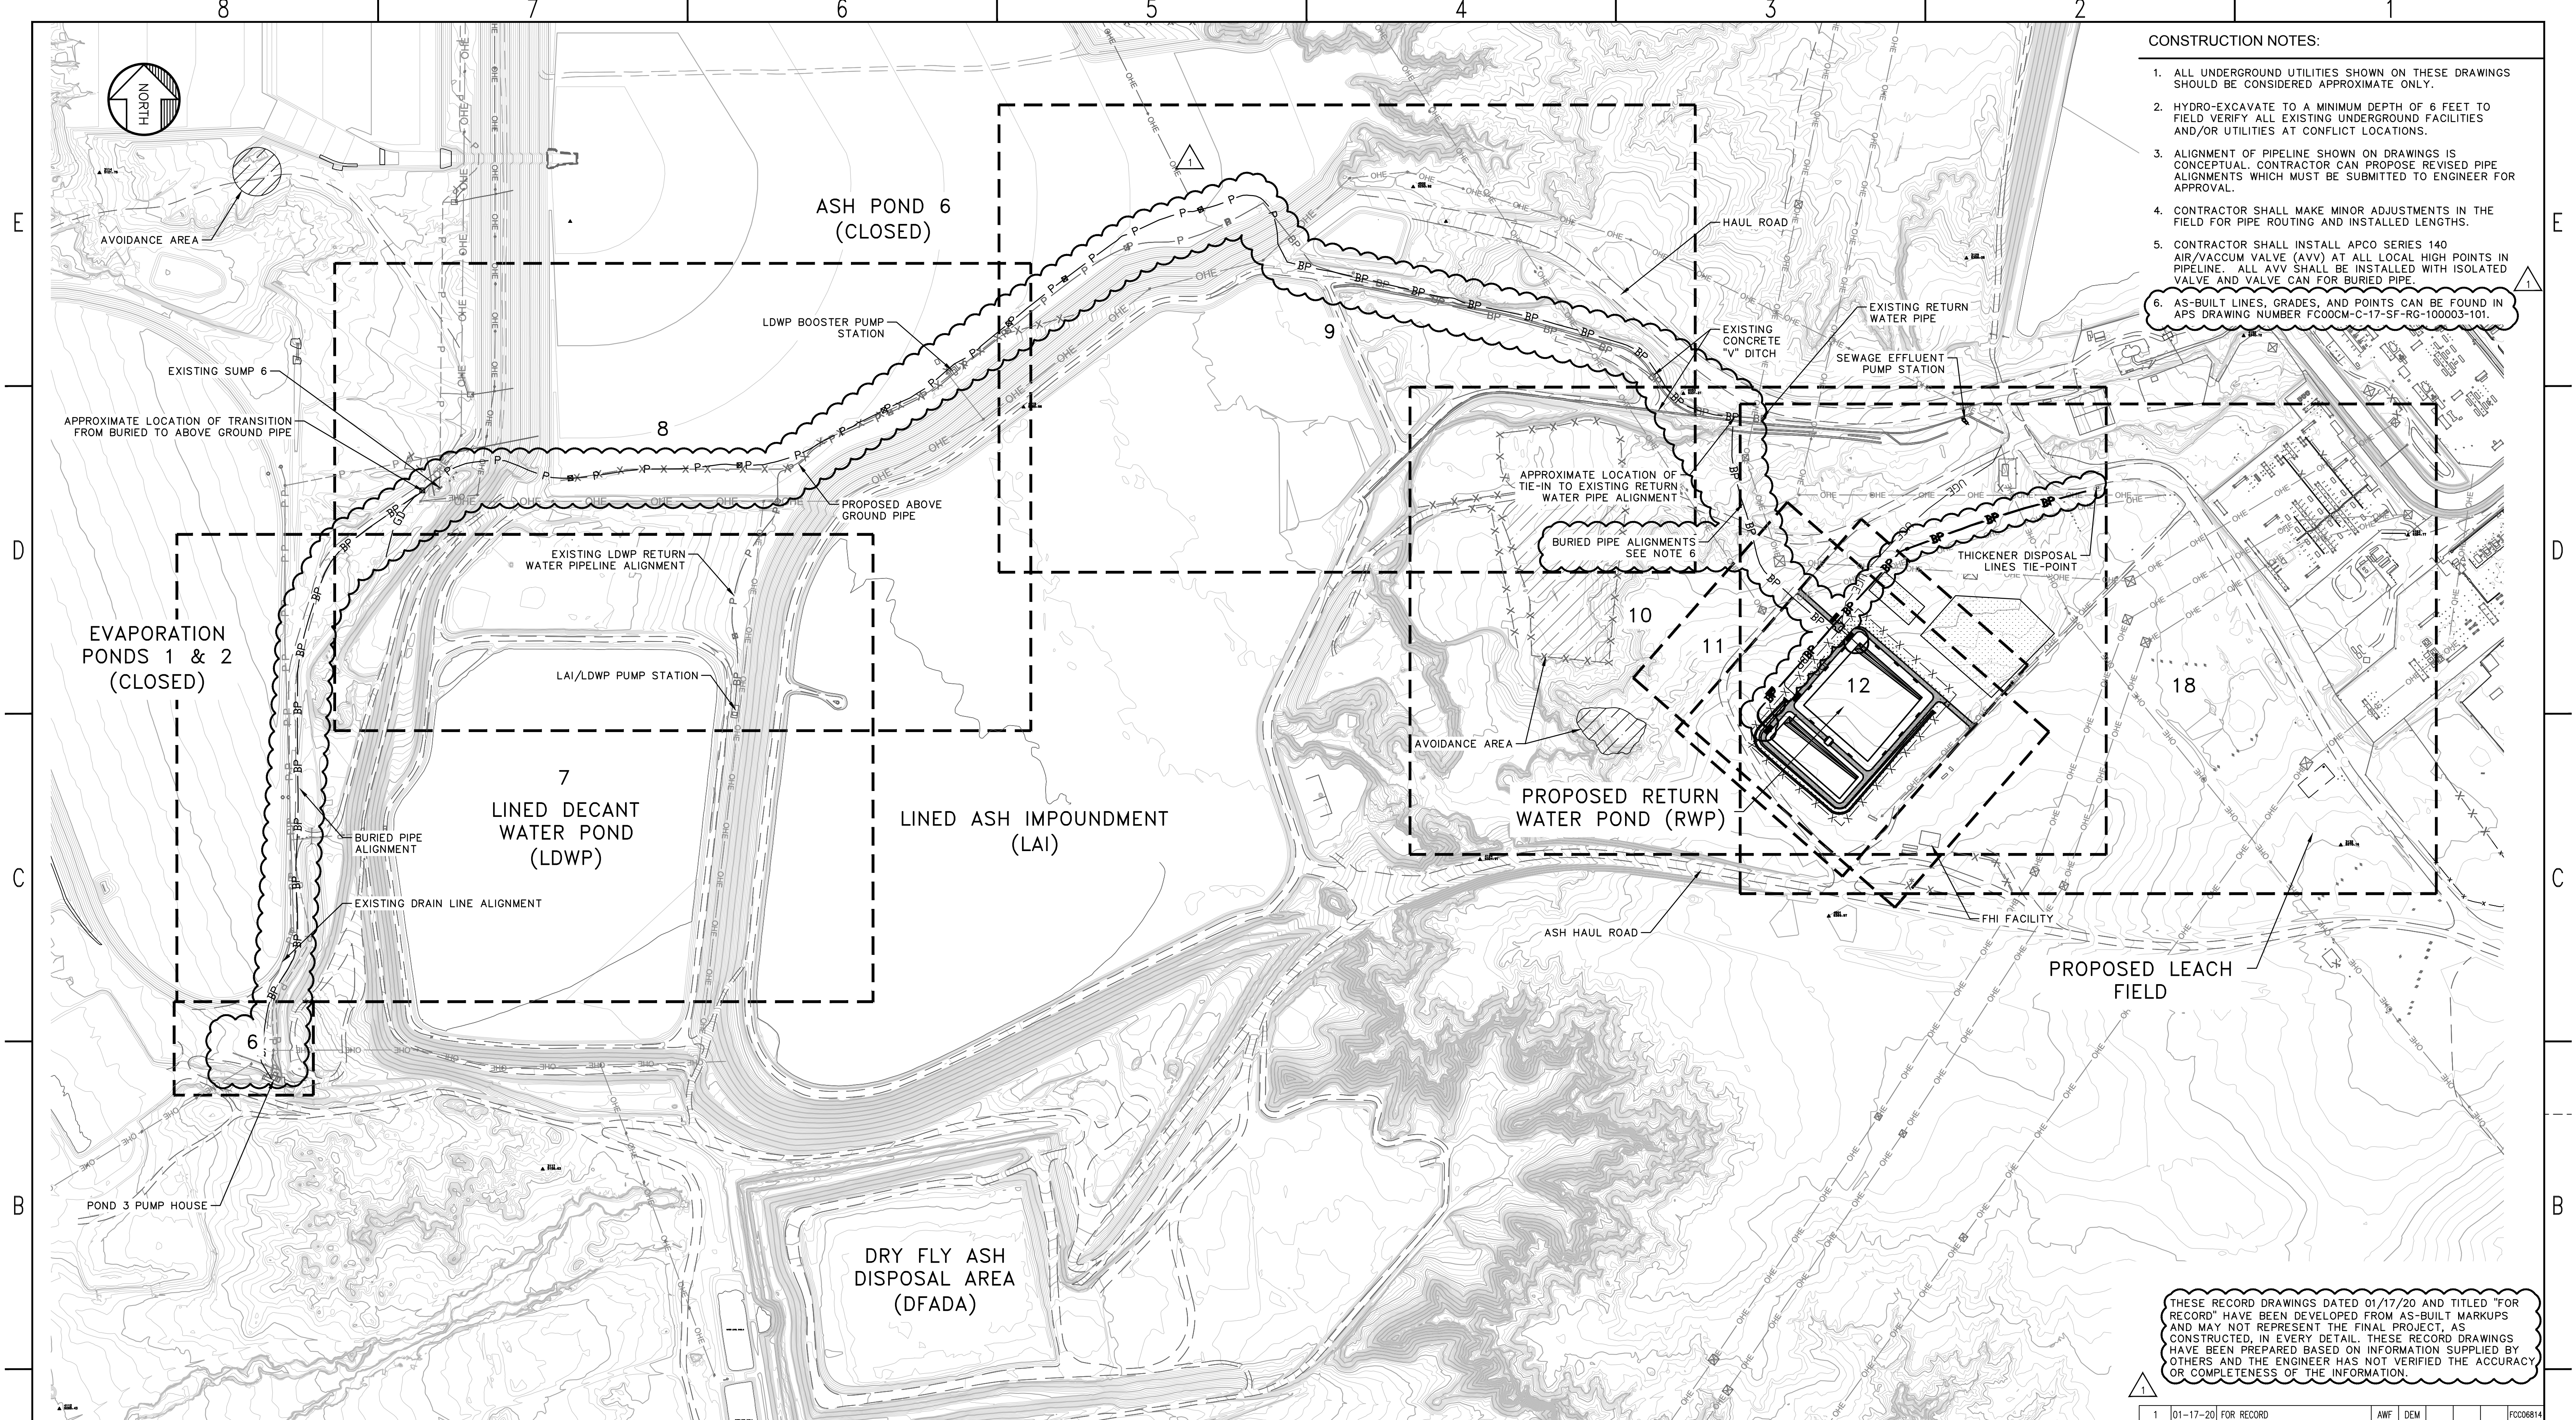

- CONSTRUCTION NOTES:**
1. ALL UNDERGROUND UTILITIES SHOWN ON THESE DRAWINGS SHOULD BE CONSIDERED APPROXIMATE ONLY.
 2. HYDRO-EXCAVATE TO A MINIMUM DEPTH OF 6 FEET TO FIELD VERIFY ALL EXISTING UNDERGROUND FACILITIES AND/OR UTILITIES AT CONFLICT LOCATIONS.
 3. ALIGNMENT OF PIPELINE SHOWN ON DRAWINGS IS CONCEPTUAL. CONTRACTOR CAN PROPOSE REVISED PIPE ALIGNMENTS WHICH MUST BE SUBMITTED TO ENGINEER FOR APPROVAL.
 4. CONTRACTOR SHALL MAKE MINOR ADJUSTMENTS IN THE FIELD FOR PIPE ROUTING AND INSTALLED LENGTHS.
 5. CONTRACTOR SHALL INSTALL APCO SERIES 140 AIR/VACUUM VALVE (AVV) AT ALL LOCAL HIGH POINTS IN PIPELINE. ALL AVV SHALL BE INSTALLED WITH ISOLATED VALVE AND VALVE CAN FOR BURIED PIPE.
 6. AS-BUILT LINES, GRADES, AND POINTS CAN BE FOUND IN APS DRAWING NUMBER FC00CM-C-17-SF-RG-100003-101.

KEY PLAN
SCALE: 1"=300' (FULL SIZE)

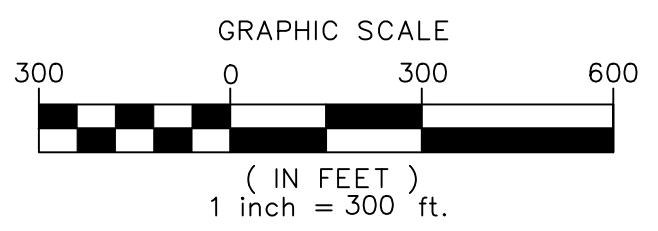


THESE RECORD DRAWINGS DATED 01/17/20 AND TITLED "FOR RECORD" HAVE BEEN DEVELOPED FROM AS-BUILT MARKUPS AND MAY NOT REPRESENT THE FINAL PROJECT, AS CONSTRUCTED. IN EVERY DETAIL, THESE RECORD DRAWINGS HAVE BEEN PREPARED BASED ON INFORMATION SUPPLIED BY OTHERS AND THE ENGINEER HAS NOT VERIFIED THE ACCURACY OR COMPLETENESS OF THE INFORMATION.


1	01-17-20	FOR RECORD	AWF	DEM			FC006814
NO.	DATE	REVISION	DWN	CHD	EXD	RWVD	APVD

 7720 N. 16th Street Suite 100 Phoenix, Arizona 85020 (602) 371-1100				FOUR CORNERS POWER PLANT RETURN WATER POND	
				KEY PLAN	
SCALE: 1"=300'		DATE: 10/04/19		APPROVED: DAVID E. MICKANEN DRAWING APPROVED BY:	
WORK SAFELY TODAY		THIS DRAWING IS CONFIDENTIAL AND SHALL NOT BE USED OR REPRODUCED IN ANY PART WITHOUT WRITTEN CONSENT OF PINNACLE WEST CAPITAL CORPORATION.		UNIT: FC45CM DISC: C TYPE: 16 SYS: WP SUBSYS: AP NUMBER: 200485 SHEET: 5	



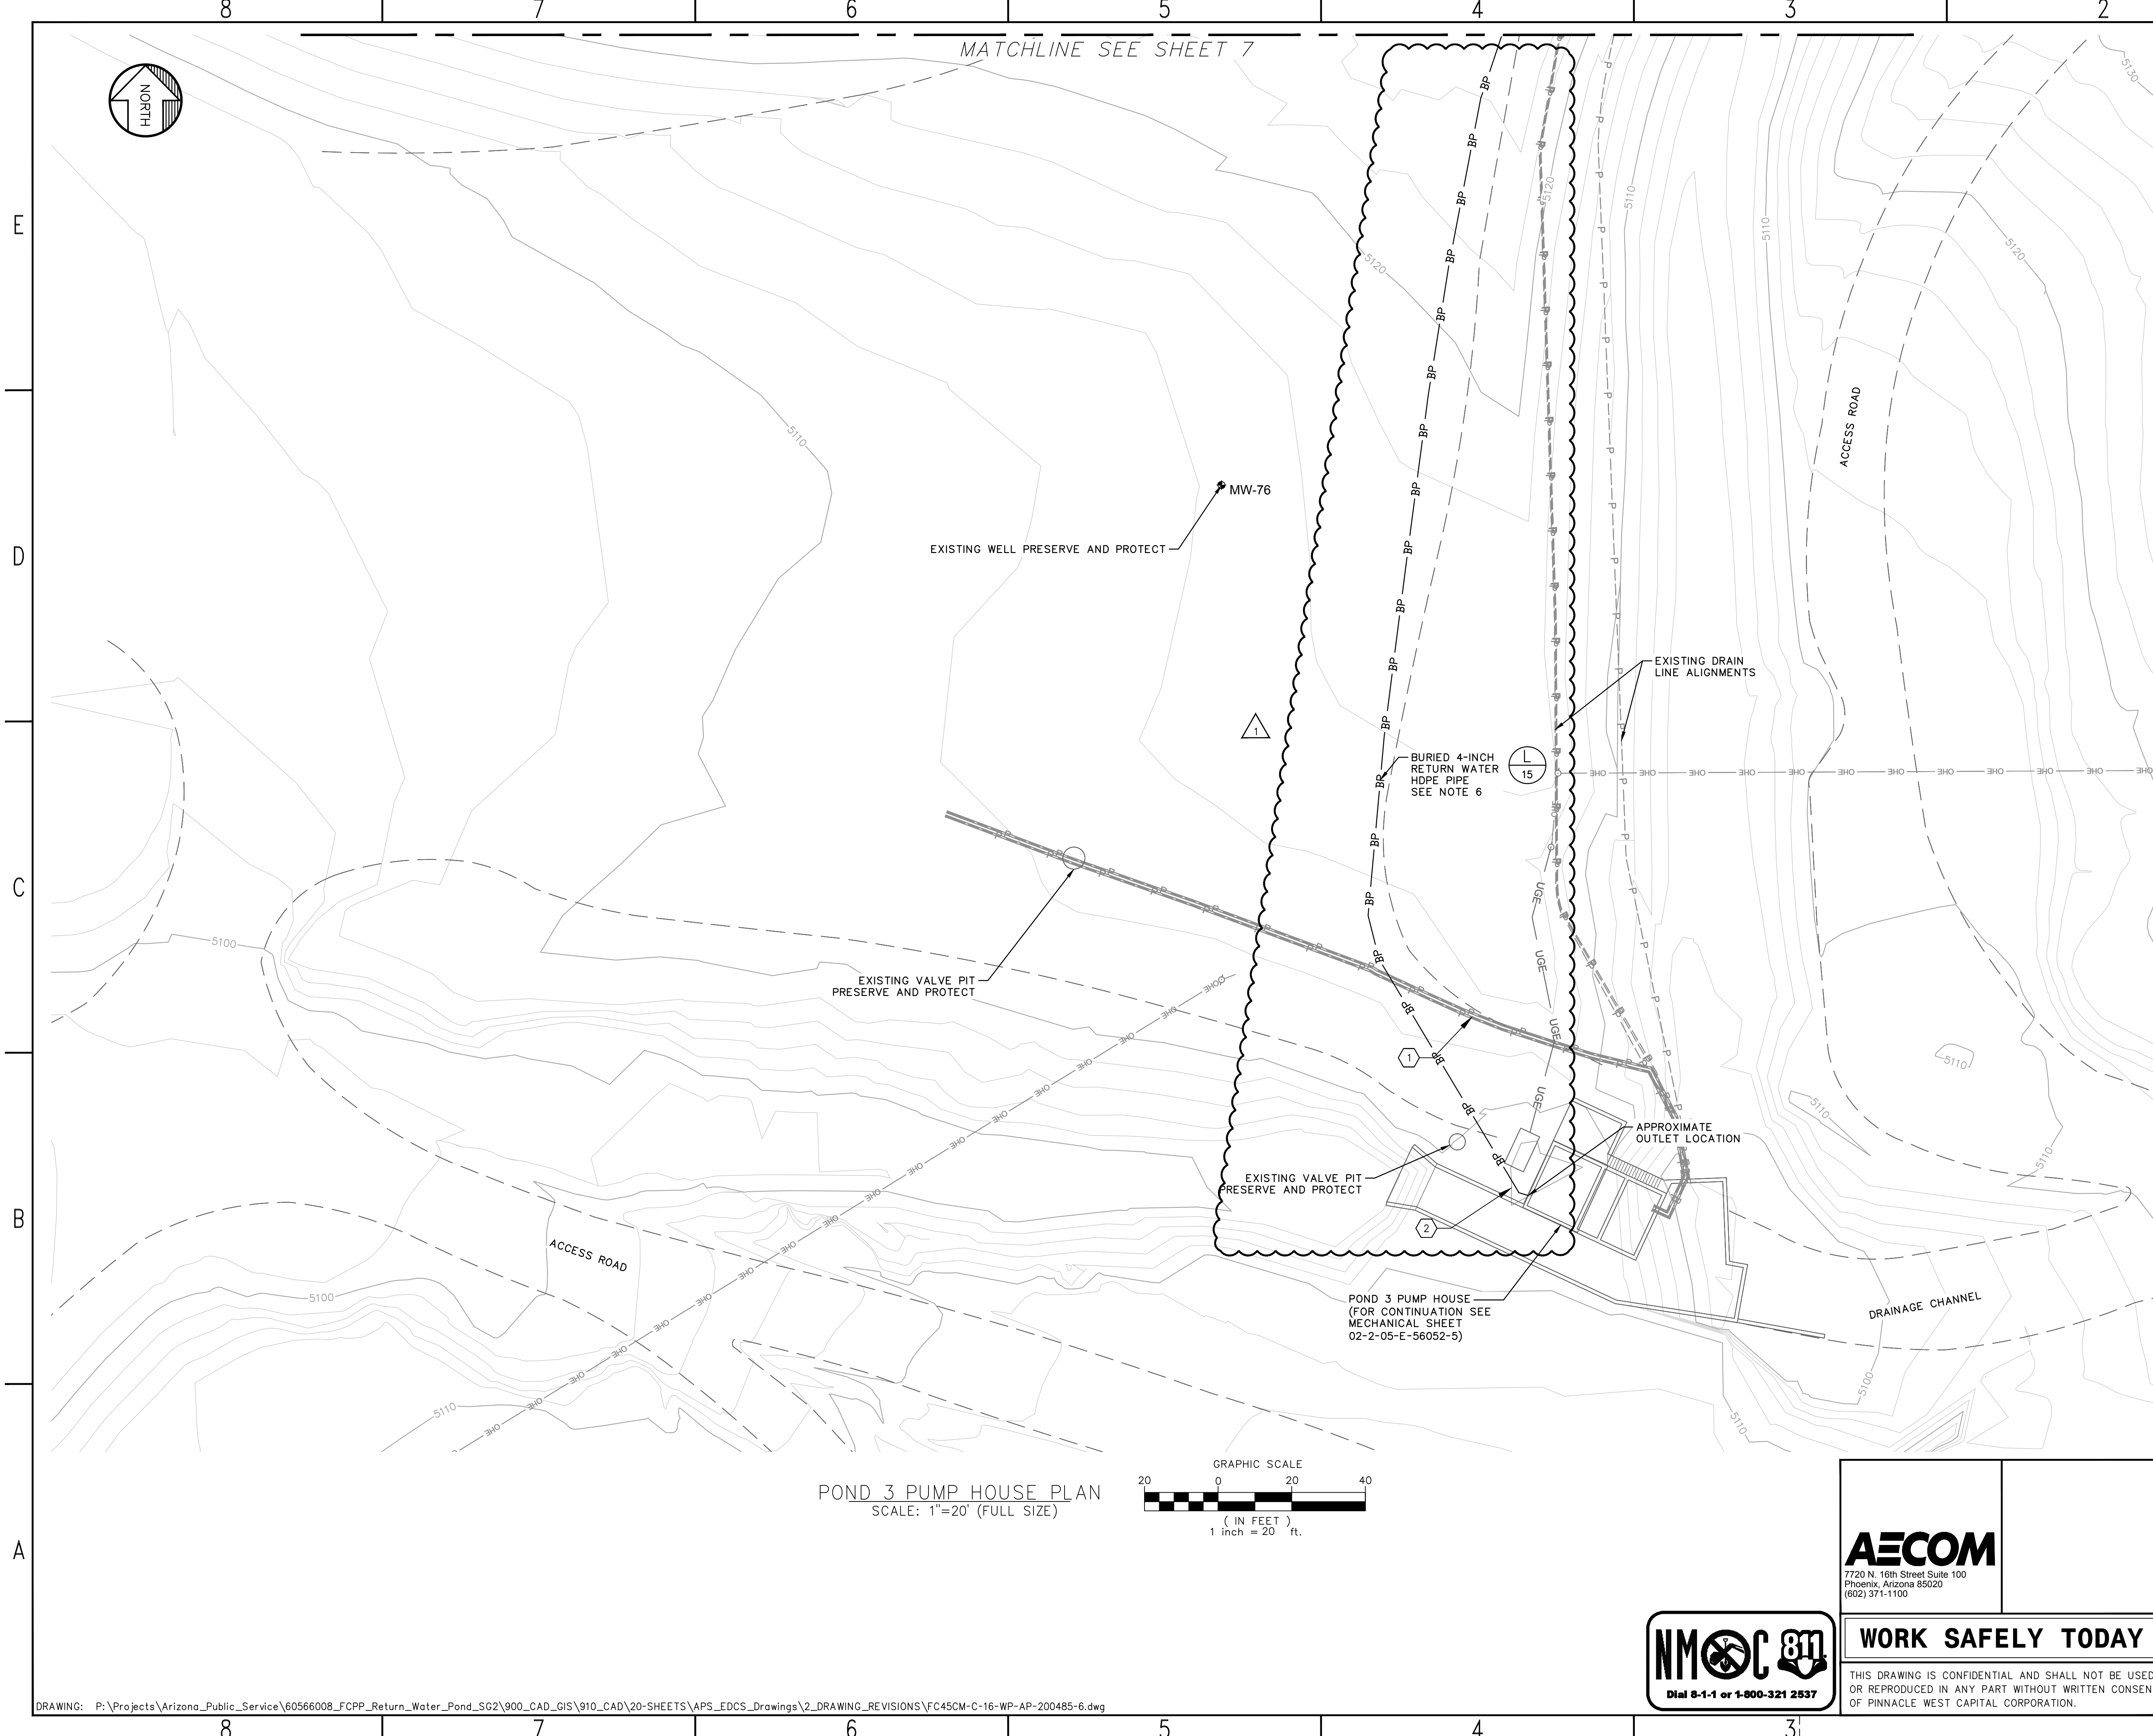

POND 3 PUMP HOUSE PLAN
SCALE: 1"=20' (FULL SIZE)

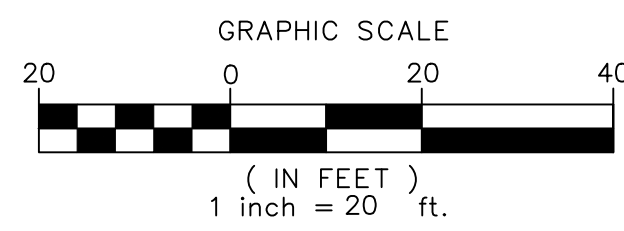

- CONSTRUCTION NOTES:**
1. ALL UNDERGROUND UTILITIES SHOWN ON THESE DRAWINGS SHOULD BE CONSIDERED APPROXIMATE ONLY.
 2. HYDRO-EXCAVATE TO A MINIMUM DEPTH OF 6 FEET TO FIELD VERIFY ALL EXISTING UNDERGROUND FACILITIES AND/OR UTILITIES AT CONFLICT LOCATIONS.
 3. ALIGNMENT OF PIPELINE SHOWN ON DRAWINGS IS CONCEPTUAL. CONTRACTOR CAN PROPOSE REVISED PIPE ALIGNMENTS WHICH MUST BE SUBMITTED TO ENGINEER FOR APPROVAL.
 4. CONTRACTOR SHALL MAKE MINOR ADJUSTMENTS IN THE FIELD FOR PIPE ROUTING AND INSTALLED LENGTHS.
 5. CONTRACTOR SHALL INSTALL APCO SERIES 140 AIR/ACCUM VALVE (AVV) AT ALL LOCAL HIGH POINTS IN PIPELINE. ALL AVV SHALL BE INSTALLED WITH ISOLATED VALVE AND VALVE CAN FOR BURIED PIPE.
 6. AS-BUILT LINES, GRADES, AND POINTS CAN BE FOUND IN APS DRAWING NUMBER FC00CM-C-17-SF-RG-100003-101.

- KEY NOTES:**
- ① CROSSING PIPES. SEE NOTE 1.
 - ② BUILDING TIE POINT. SEE SHEET FC00CM-C-56-BP-LK-56052-5 FOR CONTINUATION.

THESE RECORD DRAWINGS DATED 01/17/20 AND TITLED "FOR RECORD" HAVE BEEN DEVELOPED FROM AS-BUILT MARKUPS AND MAY NOT REPRESENT THE FINAL PROJECT, AS CONSTRUCTED, IN EVERY DETAIL. THESE RECORD DRAWINGS HAVE BEEN PREPARED BASED ON INFORMATION SUPPLIED BY OTHERS AND THE ENGINEER HAS NOT VERIFIED THE ACCURACY OR COMPLETENESS OF THE INFORMATION.

1	01-17-20	FOR RECORD	AWF	DEM			FC006814	
NO.	DATE	REVISION	DWN	CHD	EXD	RWVD	APVD	W.A.

FOUR CORNERS POWER PLANT
RETURN WATER POND
POND 3 PUMP HOUSE PLAN



SCALE 1"=20' DATE 10/04/19

DWN	AWF	EXD	---	APPROVED	W A
CHD	DEM	RWVD	---	DAVID E. MICKANEN DRAWING APPROVED BY	FC006814


UNIT	DISC	TYPE	SYS	SUBSYS	NUMBER	SHEET
FC45CM	C	16	WP	AP	200485	6



WORK SAFELY TODAY

THIS DRAWING IS CONFIDENTIAL AND SHALL NOT BE USED OR REPRODUCED IN ANY PART WITHOUT WRITTEN CONSENT OF PINNACLE WEST CAPITAL CORPORATION.



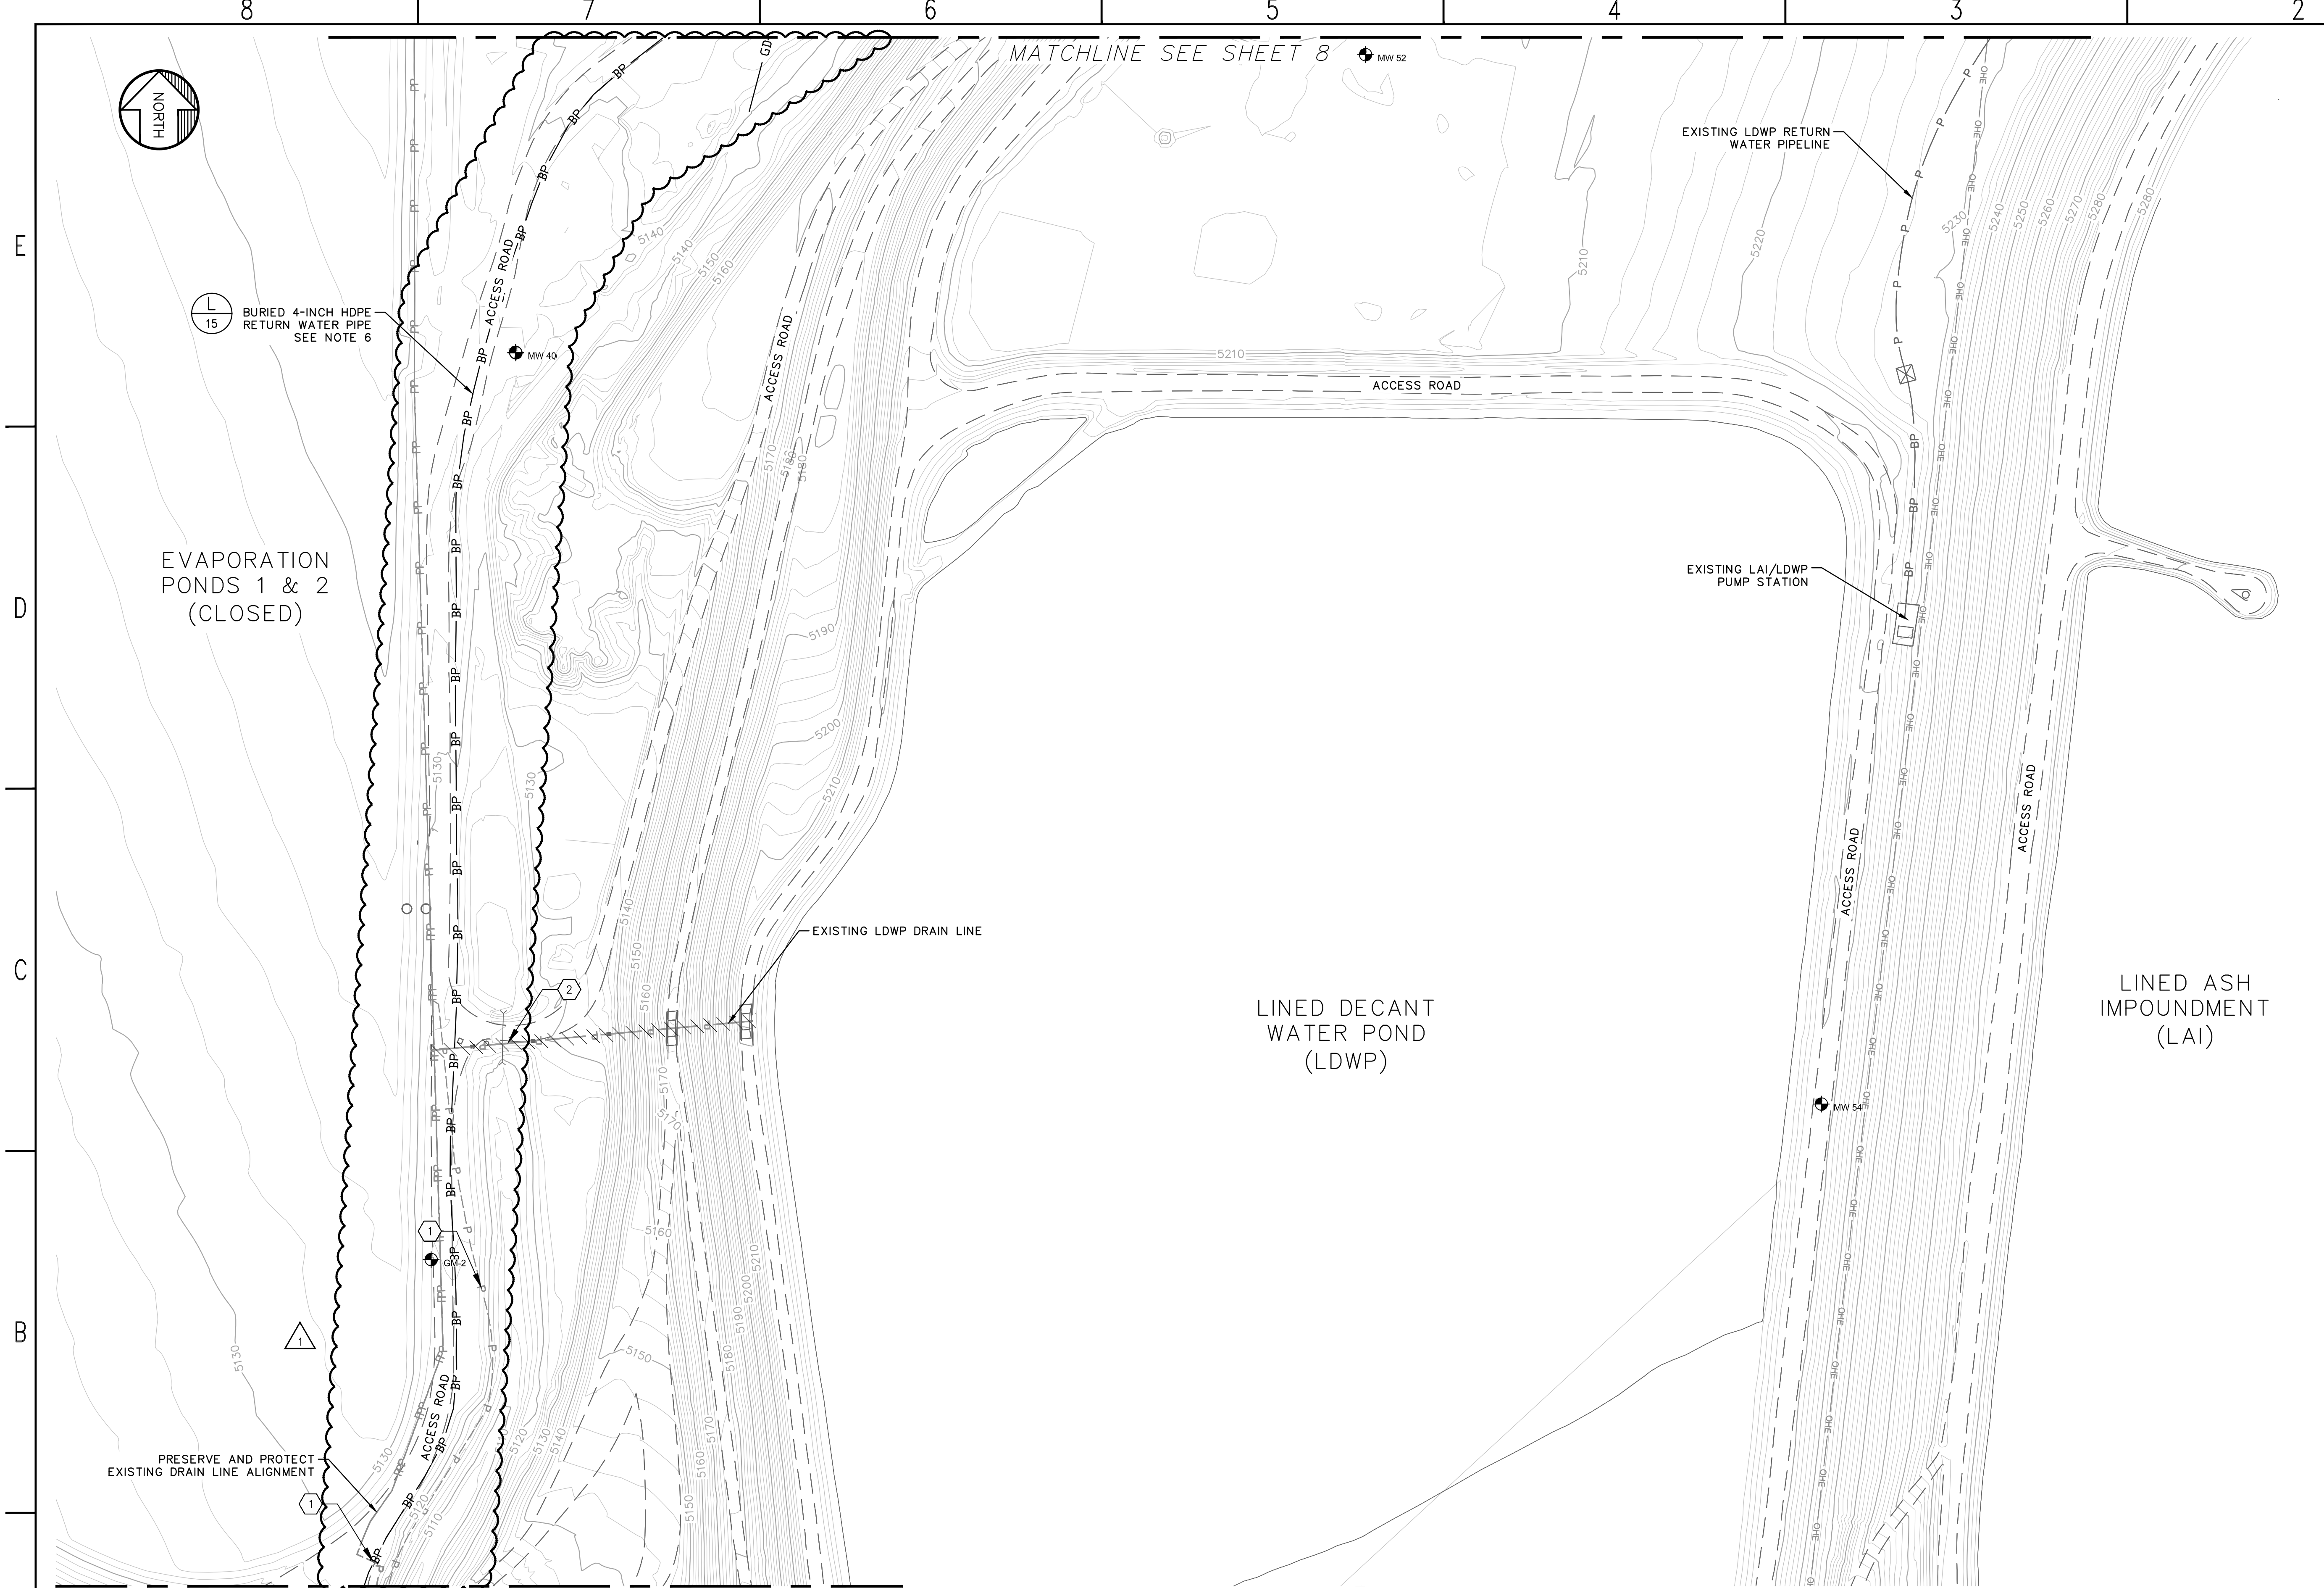


- CONSTRUCTION NOTES:**
- ALL UNDERGROUND UTILITIES SHOWN ON THESE DRAWINGS SHOULD BE CONSIDERED APPROXIMATE ONLY.
 - HYDRO-EXCAVATE TO A MINIMUM DEPTH OF 6 FEET TO FIELD VERIFY ALL EXISTING UNDERGROUND FACILITIES AND/OR UTILITIES AT CONFLICT LOCATIONS.
 - ALIGNMENT OF PIPELINE SHOWN ON DRAWINGS IS CONCEPTUAL. CONTRACTOR CAN PROPOSE REVISED PIPE ALIGNMENTS WHICH MUST BE SUBMITTED TO ENGINEER FOR APPROVAL.
 - CONTRACTOR SHALL MAKE MINOR ADJUSTMENTS IN THE FIELD FOR PIPE ROUTING AND INSTALLED LENGTHS.
 - CONTRACTOR SHALL INSTALL APCO SERIES 140 AIR/ACCUM VALVE (AVV) AT ALL LOCAL HIGH POINTS IN PIPELINE. ALL AVV SHALL BE INSTALLED WITH ISOLATED VALVE AND VALVE CAN FOR BURIED PIPE.
 - AS-BUILT LINES, GRADES, AND POINTS CAN BE FOUND IN APS DRAWING NUMBER FC00CM-C-17-SF-RG-100003-101.

- KEY NOTES:**
- CROSSING PIPES. SEE NOTE 1.
 - ABANDON IN PLACE.

THESE RECORD DRAWINGS DATED 01/17/20 AND TITLED "FOR RECORD" HAVE BEEN DEVELOPED FROM AS-BUILT MARKUPS AND MAY NOT REPRESENT THE FINAL PROJECT, AS CONSTRUCTED, IN EVERY DETAIL. THESE RECORD DRAWINGS HAVE BEEN PREPARED BASED ON INFORMATION SUPPLIED BY OTHERS AND THE ENGINEER HAS NOT VERIFIED THE ACCURACY OR COMPLETENESS OF THE INFORMATION.

RETURN WATER PIPELINE PLAN 1
SCALE: 1"=100' (FULL SIZE)

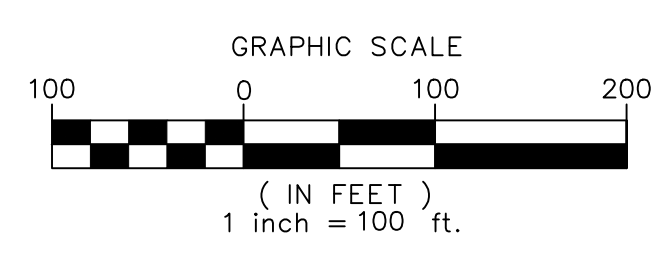

WORK SAFELY TODAY


THIS DRAWING IS CONFIDENTIAL AND SHALL NOT BE USED OR REPRODUCED IN ANY PART WITHOUT WRITTEN CONSENT OF PINNACLE WEST CAPITAL CORPORATION.

FOUR CORNERS POWER PLANT
RETURN WATER POND
RETURN WATER PIPELINE PLAN 1



SCALE: 1"=100' DATE: 10/04/19

DWN	AWF	EXD	---	APPROVED	W A
CHD	DEM	RWVD	---	DAVID E. MICKANEN DRAWING APPROVED BY	FCC06814
UNIT	DISC	TYPE	SYS	SUBSYS	NUMBER
FC45CM	C	16	WP	AP	200485
					SHEET
					7

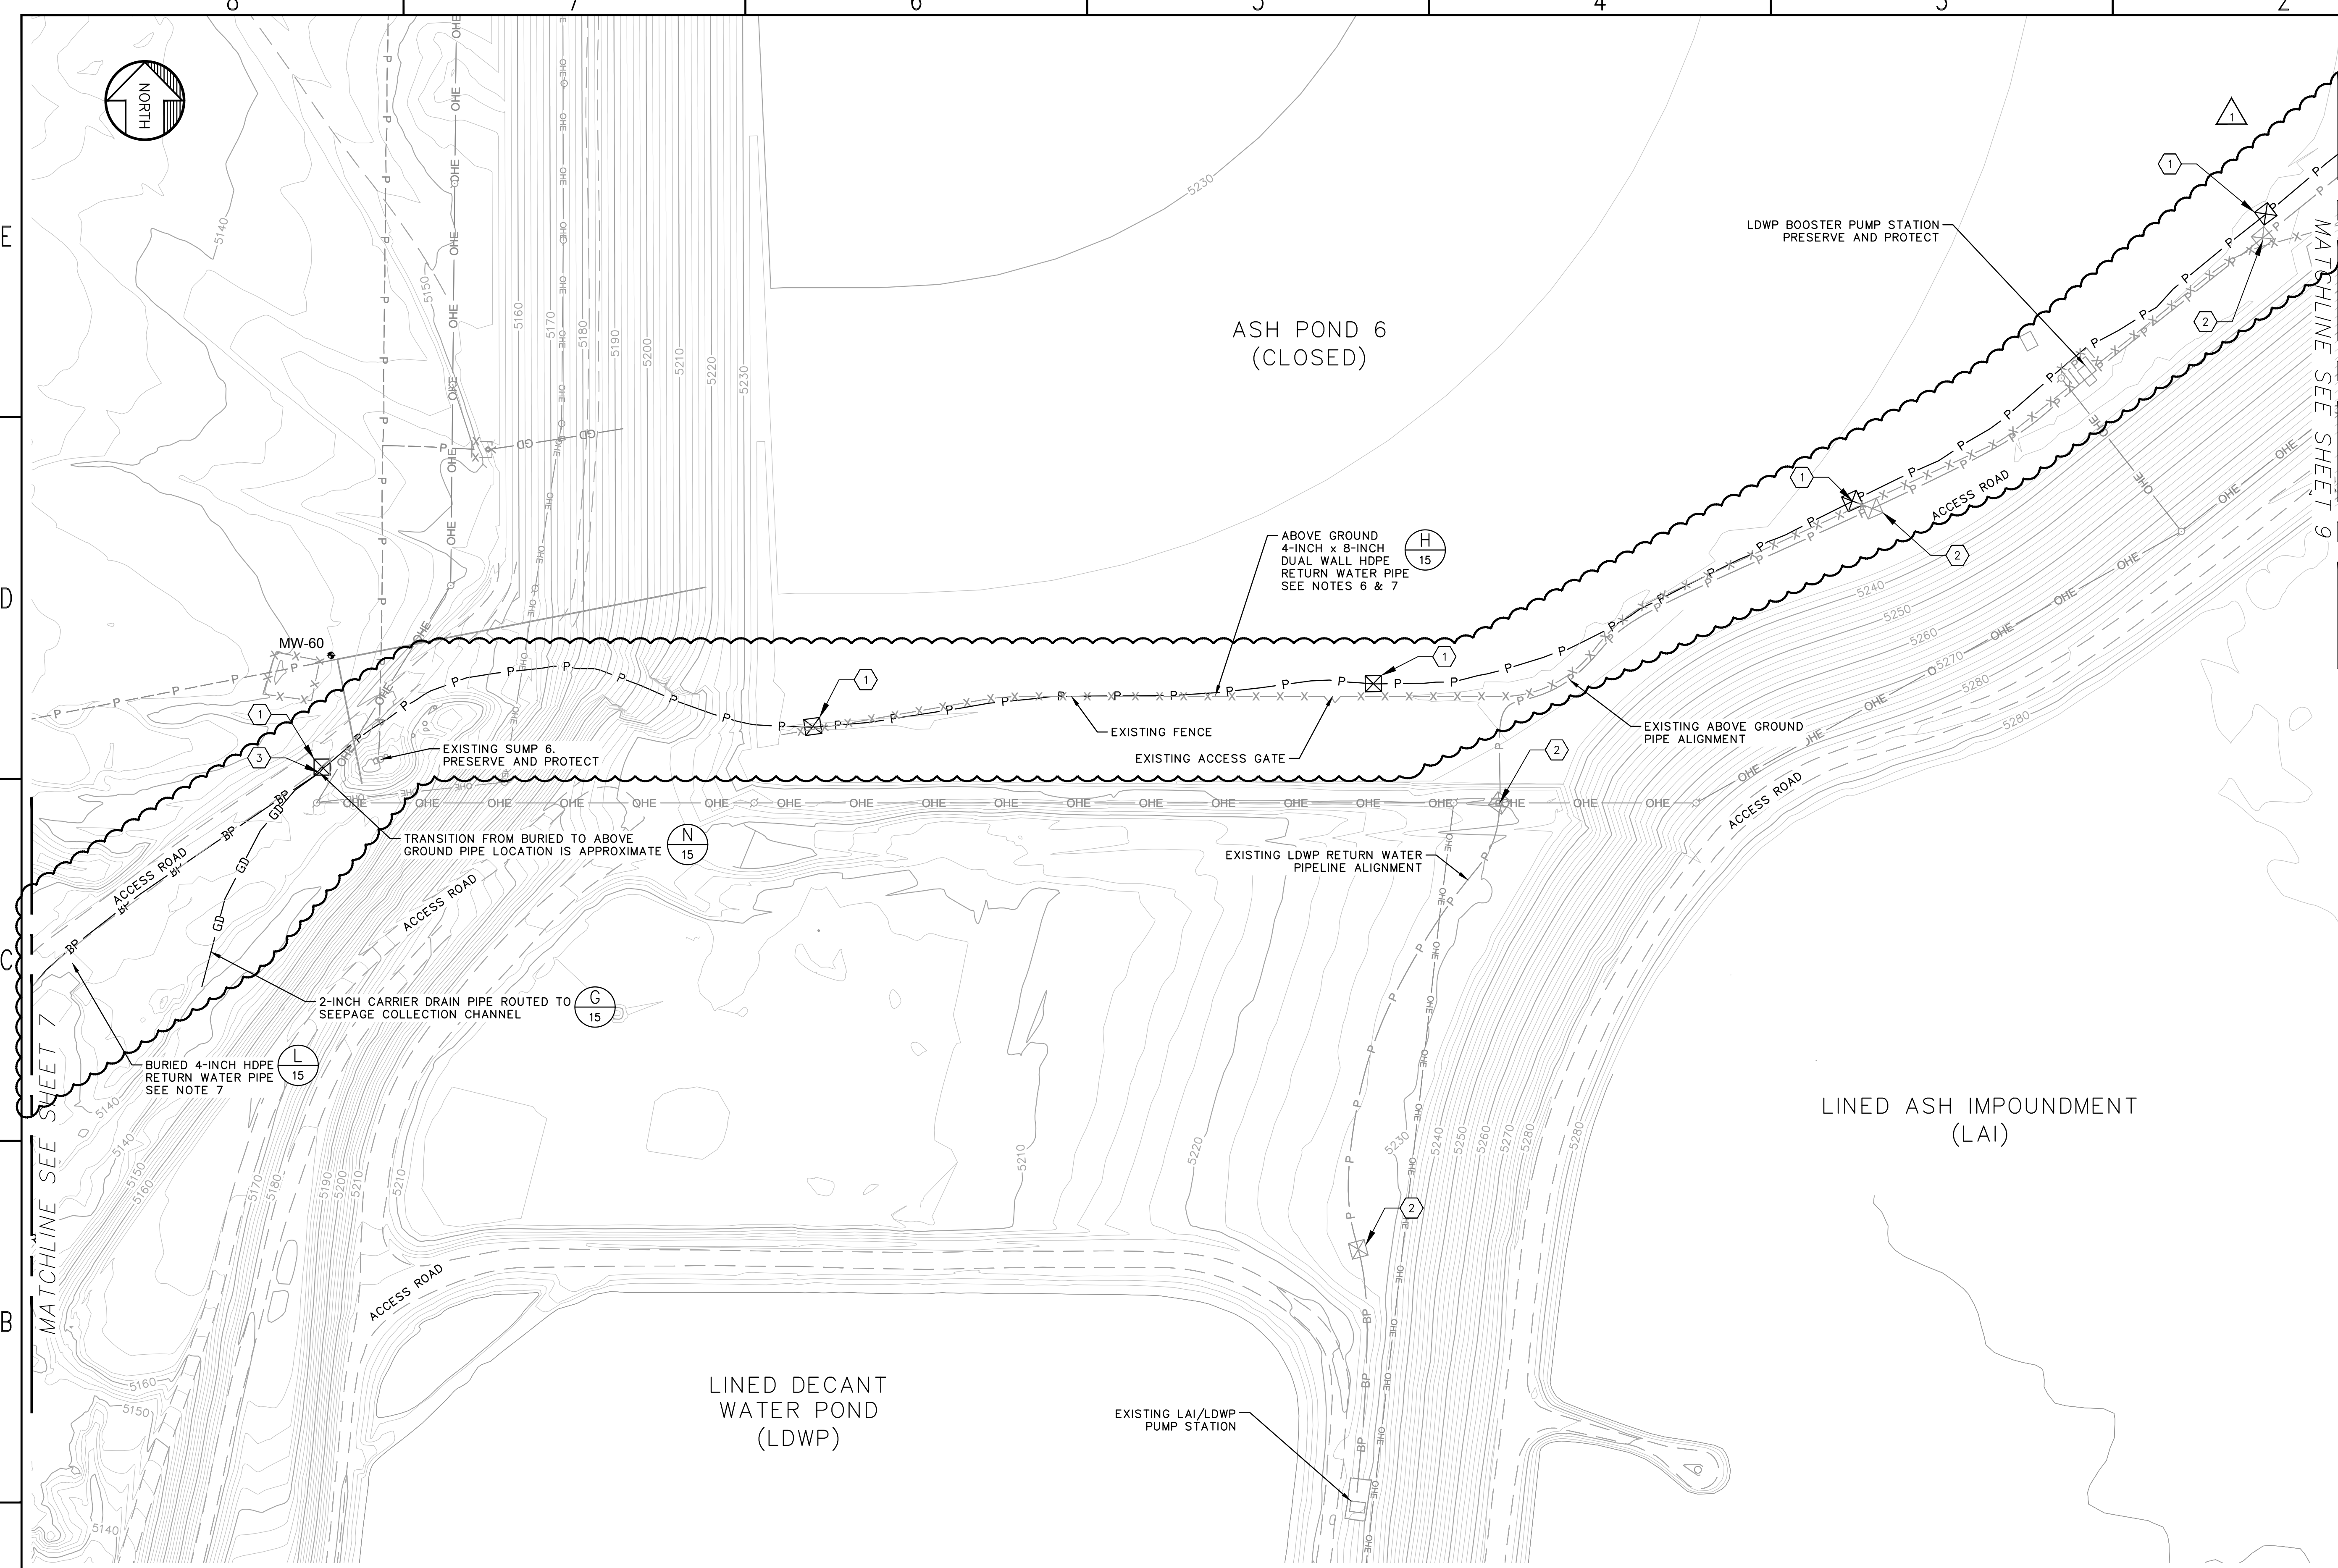


- CONSTRUCTION NOTES:**
1. ALL UNDERGROUND UTILITIES SHOWN ON THESE DRAWINGS SHOULD BE CONSIDERED APPROXIMATE ONLY.
 2. HYDRO-EXCAVATE TO A MINIMUM DEPTH OF 6 FEET TO FIELD VERIFY ALL EXISTING UNDERGROUND FACILITIES AND/OR UTILITIES AT CONFLICTS.
 3. ALIGNMENT OF PIPELINE SHOWN ON DRAWINGS IS CONCEPTUAL. CONTRACTOR CAN PROPOSE REVISED PIPE ALIGNMENTS WHICH MUST BE SUBMITTED TO ENGINEER FOR APPROVAL.
 4. CONTRACTOR SHALL MAKE MINOR ADJUSTMENTS IN THE FIELD FOR PIPE ROUTING AND INSTALLED LENGTHS.
 5. CONTRACTOR SHALL INSTALL APCO SERIES 140 AIR/VACUUM VALVE (AVV) AT ALL LOCAL HIGH POINTS IN PIPELINE. ALL AVV SHALL BE INSTALLED WITH ISOLATED VALVE AND VALVE CAN FOR BURIED PIPE.
 6. HDPE DUAL WALL PIPING SHALL BE ISCO DUAL CONTAINMENT PIPING OR EQUAL AND SHALL BE INSTALLED AND TESTED IN ACCORDANCE WITH MANUFACTURERS RECOMMENDATIONS.
 7. AS-BUILT LINES, GRADES, AND POINTS CAN BE FOUND IN APS DRAWING NUMBER FCC06M-C-17-SF-RG-100003-101.

- KEY NOTES:**
- 1 CONTRACTOR SHALL INSTALL CLSM BALLAST AT A SPACING OF APPROXIMATELY 600 FT ON CENTER. LOCATION OF BALLAST SHOWN ON DRAWING IS APPROXIMATE. SEE DETAIL 5 ON SHEET 15.
 - 2 EXISTING PIPE BALLAST. PRESERVE AND PROTECT.
 - 3 PIPE END TERMINATION. SEE DETAIL 3 ON SHEET 15.

THESE RECORD DRAWINGS DATED 01/17/20 AND TITLED "FOR RECORD" HAVE BEEN DEVELOPED FROM AS-BUILT MARKUPS AND MAY NOT REPRESENT THE FINAL PROJECT, AS CONSTRUCTED, IN EVERY DETAIL. THESE RECORD DRAWINGS HAVE BEEN PREPARED BASED ON INFORMATION SUPPLIED BY OTHERS AND THE ENGINEER HAS NOT VERIFIED THE ACCURACY OR COMPLETENESS OF THE INFORMATION.

RETURN WATER PIPELINE PLAN 2
SCALE: 1"=100' (FULL SIZE)

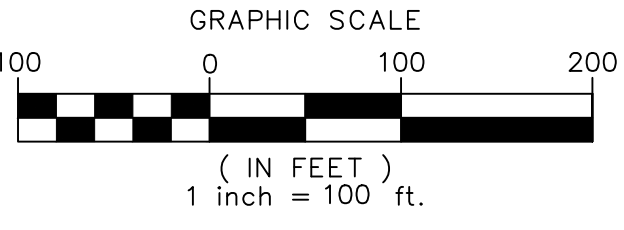

AECOM
7720 N. 16th Street Suite 100
Phoenix, Arizona 85020
(602) 371-1100



WORK SAFELY TODAY


THIS DRAWING IS CONFIDENTIAL AND SHALL NOT BE USED OR REPRODUCED IN ANY PART WITHOUT WRITTEN CONSENT OF PINNACLE WEST CAPITAL CORPORATION.

NO.	DATE	REVISION	DWN	CHD	EXD	RWVD	APVD	W.A.
1	01-17-20	FOR RECORD						FCC06814

FOUR CORNERS POWER PLANT
RETURN WATER POND
RETURN WATER PIPELINE PLAN 2



SCALE: 1"=100'		DATE: 10/04/19	
DWN	AWF	EXD	---
CHD	DEM	RWVD	---
APPROVED		W A	
DAVID E. MICKANEN		FCC06814	
DRAWING APPROVED BY			
UNIT	DISC	TYPE	SYS
FC45CM	C	16	WP
SUBSYS	NUMBER	SHEET	
AP	200485	8	

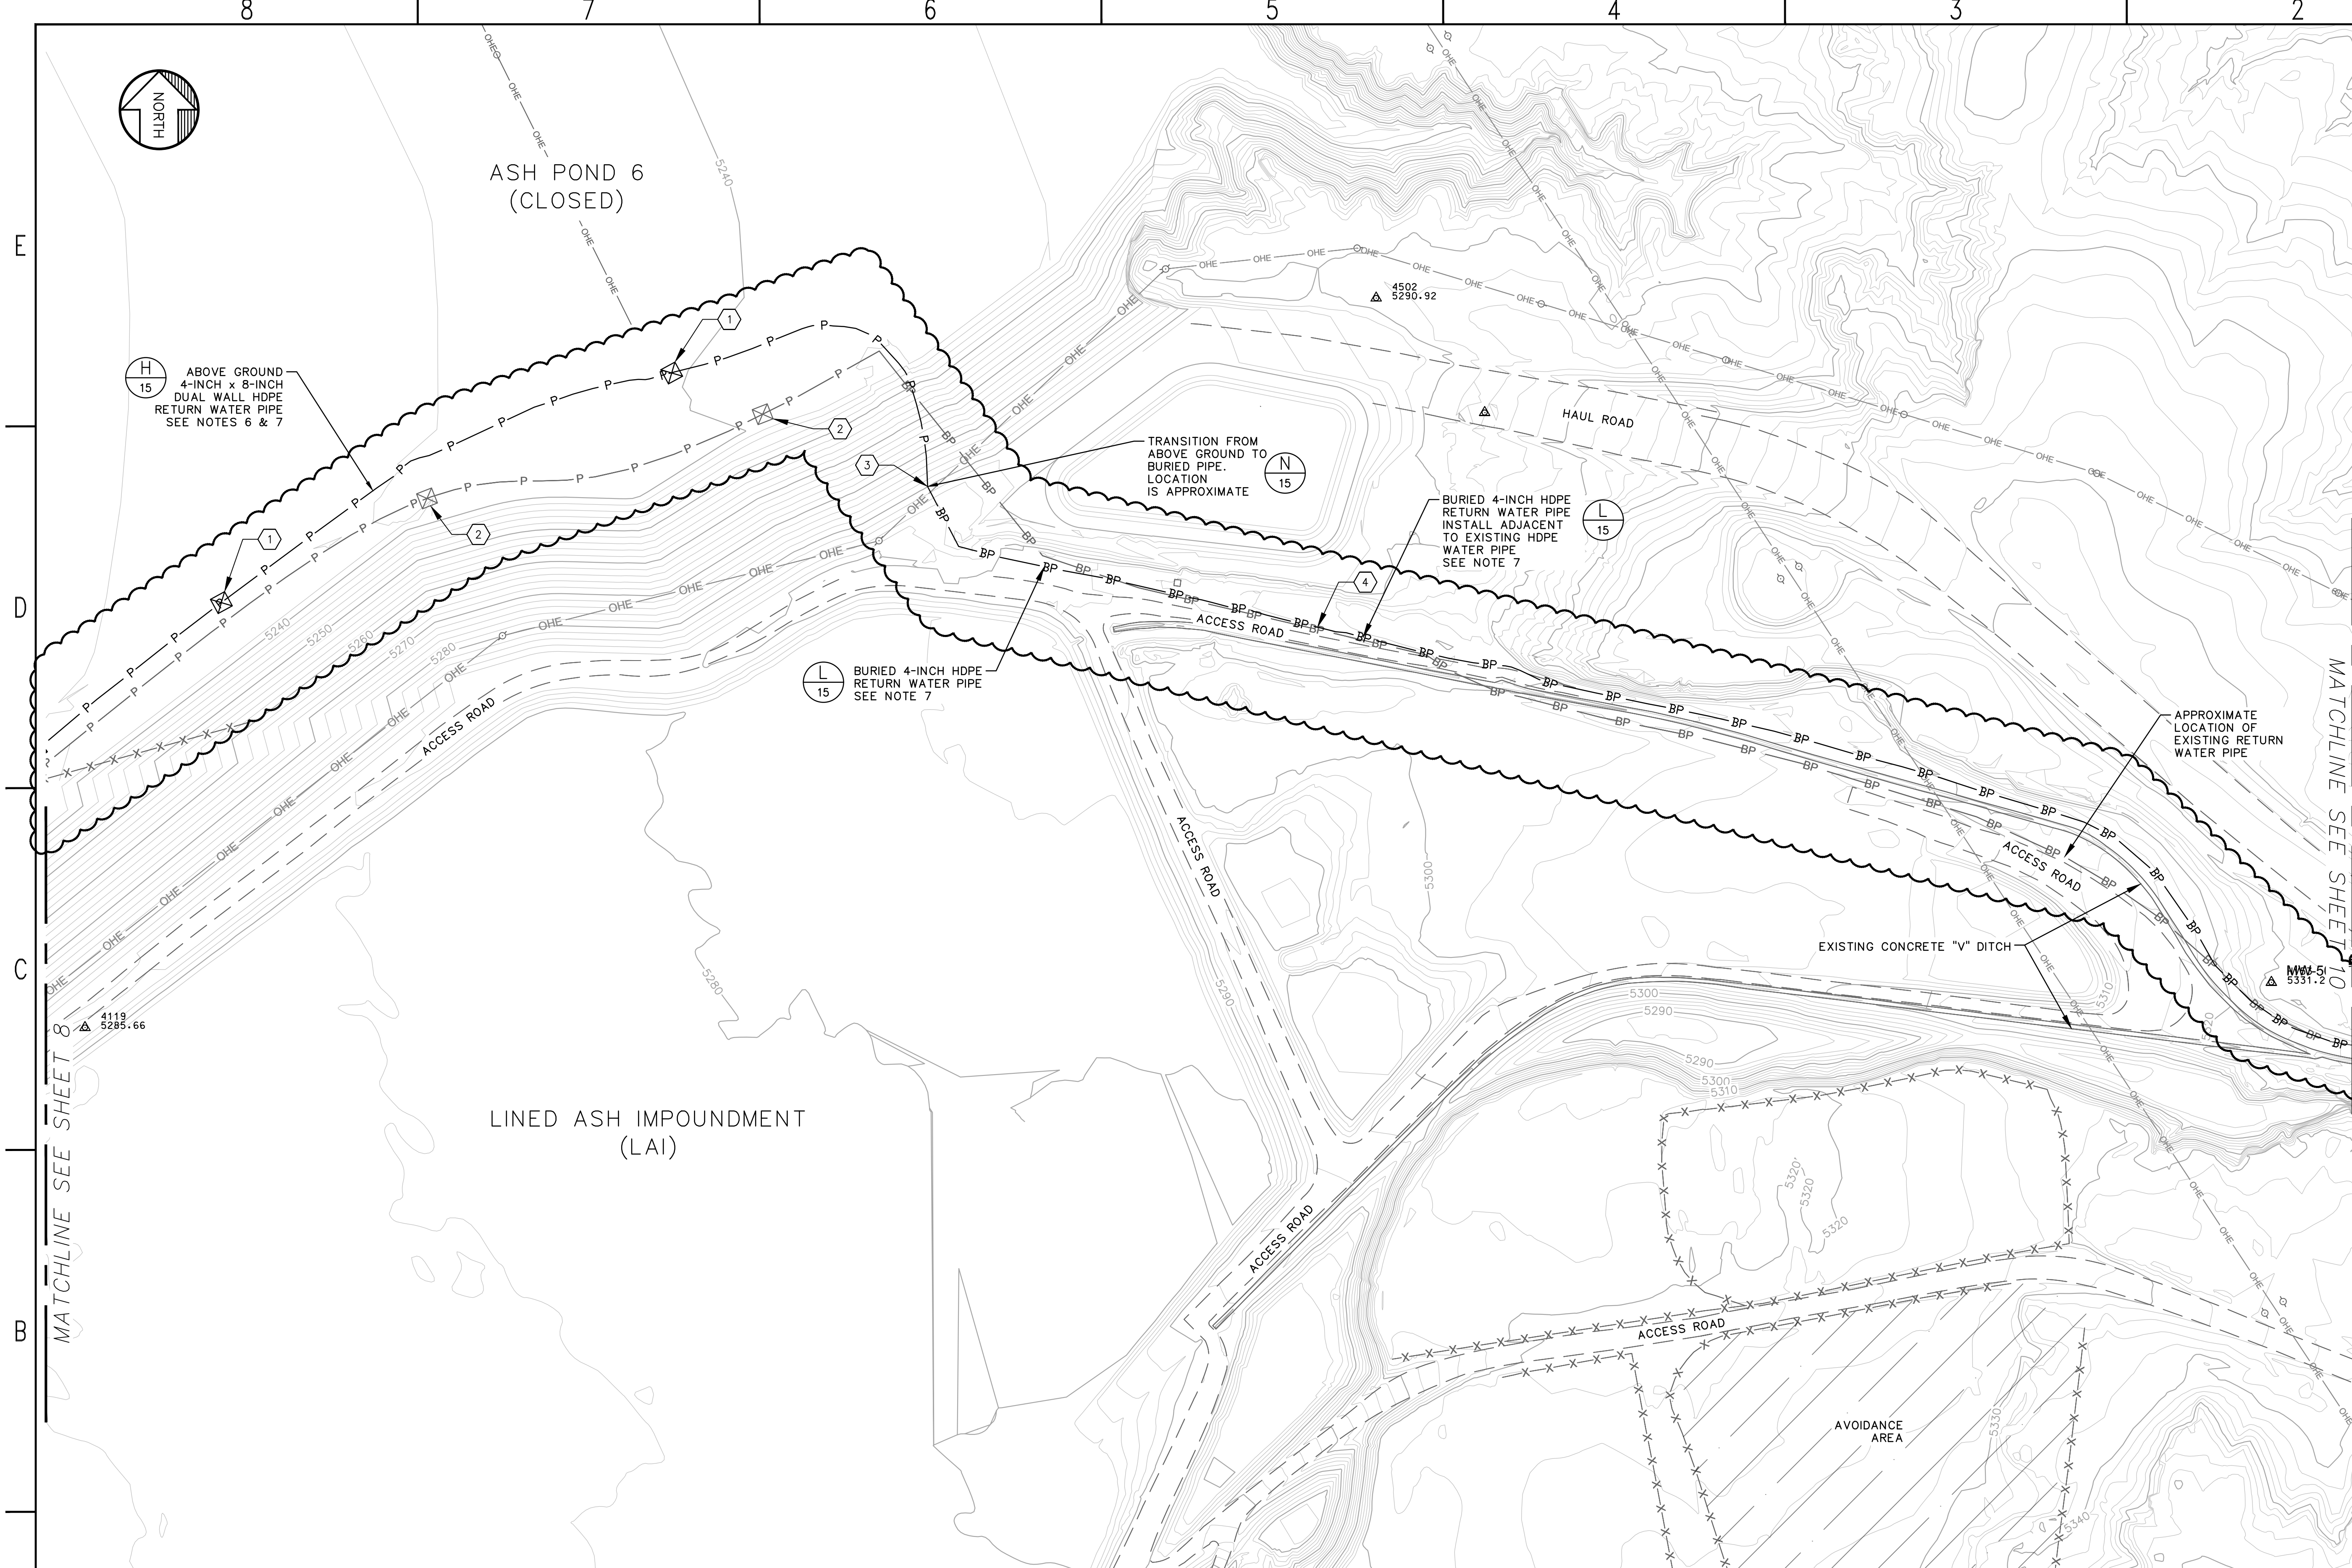


- CONSTRUCTION NOTES:**
1. ALL UNDERGROUND UTILITIES SHOWN ON THESE DRAWINGS SHOULD BE CONSIDERED APPROXIMATE ONLY.
 2. HYDRO-EXCAVATE TO A MINIMUM DEPTH OF 6 FEET TO FIELD VERIFY ALL EXISTING UNDERGROUND FACILITIES AND/OR UTILITIES AT CONFLICTS.
 3. ALIGNMENT OF PIPELINE SHOWN ON DRAWINGS IS CONCEPTUAL. CONTRACTOR CAN PROPOSE REVISED PIPE ALIGNMENTS WHICH MUST BE SUBMITTED TO ENGINEER FOR APPROVAL.
 4. CONTRACTOR SHALL MAKE MINOR ADJUSTMENTS IN THE FIELD FOR PIPE ROUTING AND INSTALLED LENGTHS.
 5. CONTRACTOR SHALL INSTALL APCO SERIES 140 AIR/VACUUM VALVE (AVV) AT ALL LOCAL HIGH POINTS IN PIPELINE. ALL AVV SHALL BE INSTALLED WITH ISOLATED VALVE AND VALVE CAN FOR BURIED PIPE.
 6. HDPE DUAL WALL PIPING SHALL BE ISCO DUAL CONTAINMENT PIPING OR EQUAL AND SHALL BE INSTALLED AND TESTED IN ACCORDANCE WITH MANUFACTURERS RECOMMENDATIONS.
 7. AS-BUILT LINES, GRADES, AND POINTS CAN BE FOUND IN APS DRAWING NUMBER FCC06M-C-17-SF-RG-100003-101.

- KEY NOTES:**
- 1 CONTRACTOR SHALL INSTALL CLSM BALLAST AT A SPACING OF APPROXIMATELY 600 FT ON CENTER. LOCATION OF BALLAST SHOWN ON DRAWING IS APPROXIMATE. SEE DETAIL 5 ON SHEET 15.
 - 2 EXISTING PIPE BALLAST. PRESERVE AND PROTECT.
 - 3 PIPE END TERMINATION, SEE DETAIL 4 ON SHEET 15.
 - 4 BURIED 4-INCH HDPE PIPE. FOLLOW EXISTING HDPE PIPE ALIGNMENT. SEE SECTIONS L AND K ON SHEET 15.

THESE RECORD DRAWINGS DATED 01/17/20 AND TITLED "FOR RECORD" HAVE BEEN DEVELOPED FROM AS-BUILT MARKUPS AND MAY NOT REPRESENT THE FINAL PROJECT, AS CONSTRUCTED, IN EVERY DETAIL. THESE RECORD DRAWINGS HAVE BEEN PREPARED BASED ON INFORMATION SUPPLIED BY OTHERS AND THE ENGINEER HAS NOT VERIFIED THE ACCURACY OR COMPLETENESS OF THE INFORMATION.

2	01-17-20	FOR RECORD	AWF	DEM			FCC06814	
1	12-14-18	REVISED PIPELINE TRANSITION LOCATION	AWF	DEM			FCC06814	
NO.	DATE	REVISION	DWN	CHD	EXD	RWVD	APVD	W.A.

RETURN WATER PIPELINE PLAN 3
SCALE: 1"=100' (FULL SIZE)

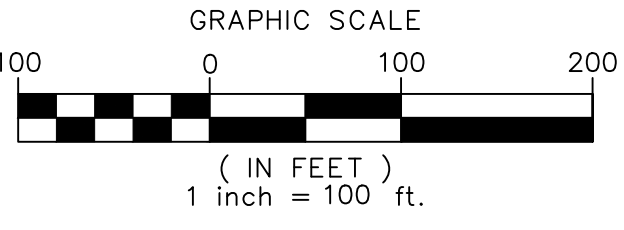

AECOM
7720 N. 16th Street Suite 100
Phoenix, Arizona 85020
(602) 371-1100

NMOC 811
Dial 8-1-1 or 1-800-321-2537

WORK SAFELY TODAY


THIS DRAWING IS CONFIDENTIAL AND SHALL NOT BE USED OR REPRODUCED IN ANY PART WITHOUT WRITTEN CONSENT OF PINNACLE WEST CAPITAL CORPORATION.

FOUR CORNERS POWER PLANT
RETURN WATER POND
RETURN WATER PIPELINE PLAN 3

aps

SCALE: 1"=100' DATE: 10/04/19

DWN	AWF	EXD	---	APPROVED	W A	
CHD	DEM	RWVD	---	DAVID E. MICKANEN DRAWING APPROVED BY	FCC06814	
UNIT	DISC	TYPE	SYS	SUBSYS	NUMBER	SHEET
FC45CM	C	16	WP	AP	200485	9

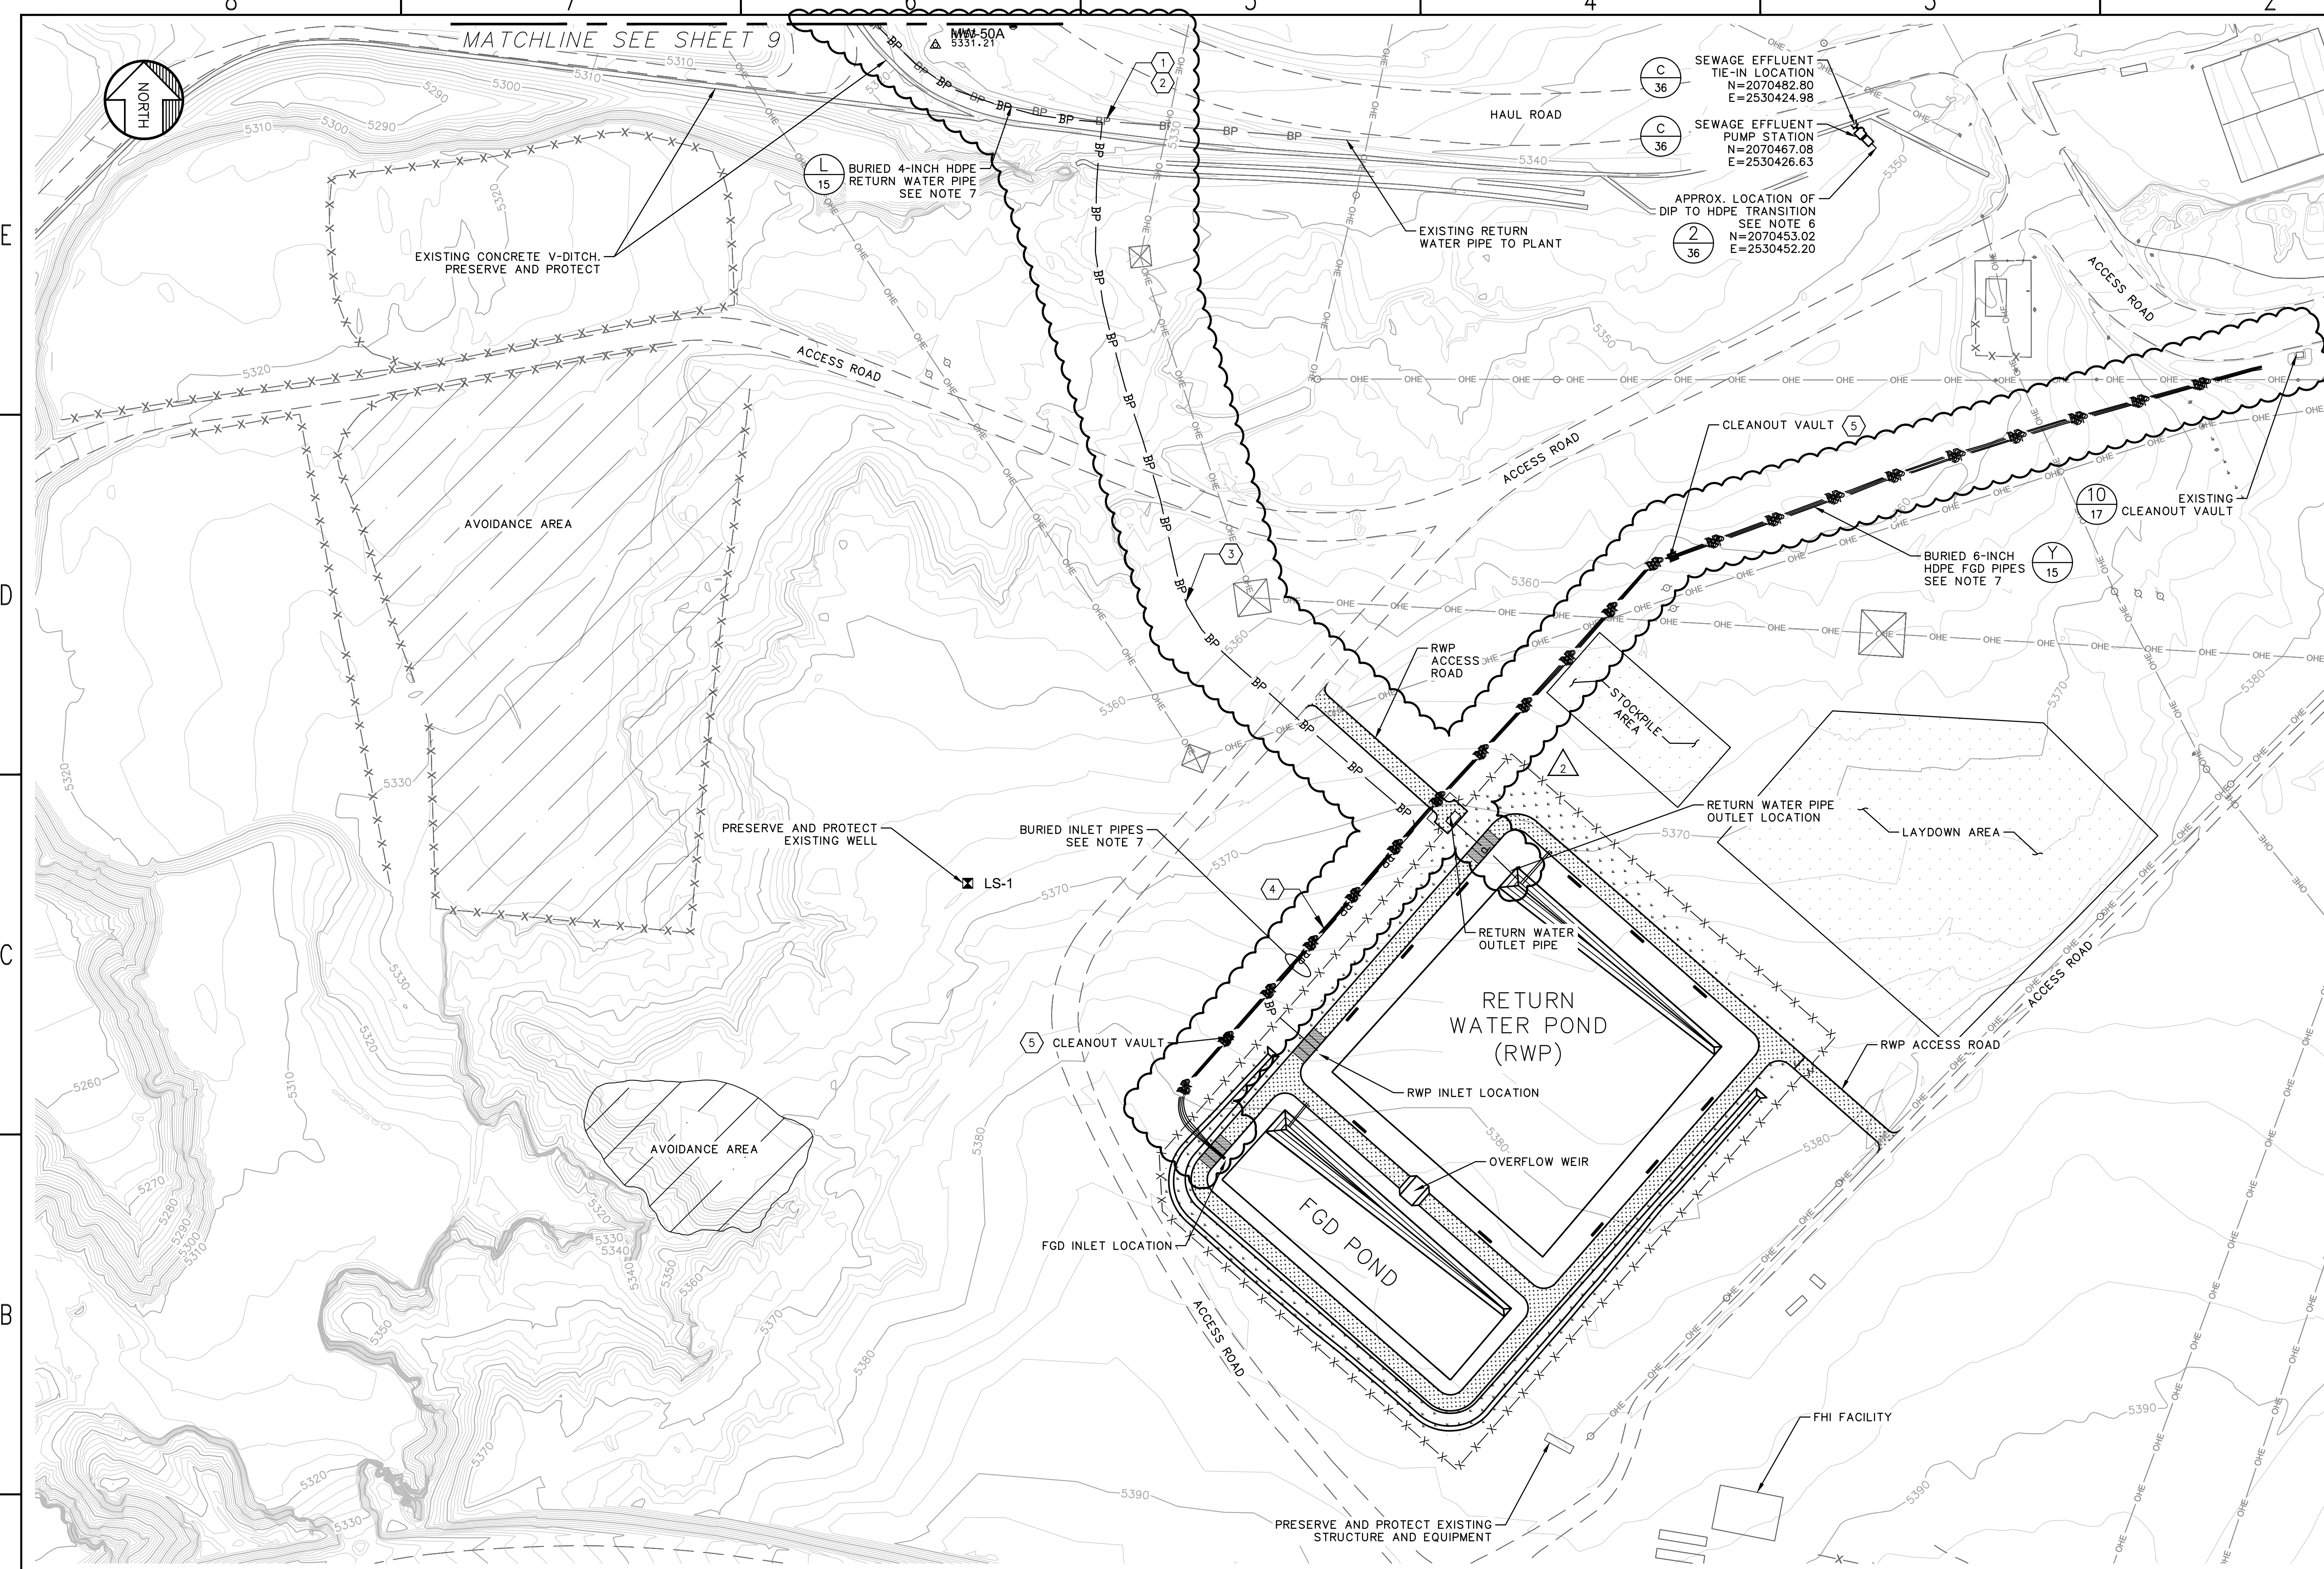


- CONSTRUCTION NOTES:**
- ALL UNDERGROUND UTILITIES SHOWN ON THESE DRAWINGS SHOULD BE CONSIDERED APPROXIMATE ONLY.
 - HYDRO-EXCAVATE TO A MINIMUM DEPTH OF 6 FEET TO FIELD VERIFY ALL EXISTING UNDERGROUND FACILITIES AND/OR UTILITIES.
 - ALIGNMENT OF PIPELINE SHOWN ON DRAWINGS IS CONCEPTUAL. CONTRACTOR CAN PROPOSE REVISED PIPE ALIGNMENTS WHICH MUST BE SUBMITTED TO ENGINEER FOR APPROVAL.
 - CONTRACTOR SHALL MAKE MINOR ADJUSTMENTS IN THE FIELD FOR PIPE ROUTING AND INSTALLED LENGTHS.
 - CONTRACTOR SHALL INSTALL APCO SERIES 140 AIR/VACCUUM VALVE (AVV) AT ALL LOCAL HIGH POINTS IN PIPELINE. ALL AVV SHALL BE INSTALLED WITH ISOLATED VALVE AND VALVE CAN FOR BURIED PIPE.
 - CONTRACTOR TO INSTALL 150# BLIND FLANGE.
 - AS-BUILT LINES, GRADES, AND POINTS CAN BE FOUND IN APS DRAWING NUMBER FCC06814-17-SF-RG-100003-101.

- KEY NOTES:**
- APPROXIMATE LOCATION OF TIE-IN TO EXISTING RETURN WATER PIPE ALIGNMENT AT EXISTING FLANGE. CONTRACTOR TO INSTALL 2 STAINLESS STEEL TAPPING SLEEVES SPACED 5-FT APART. ROMAC SST-H OR APPROVED EQUAL.
 - AMERICAN FLOW CONTROL 2500-1 RESILIENT WEDGE GATE VALVE, OS&Y.
 - MULTI-PIPE TRENCH. SEE SECTION P ON SHEET 15.
 - MULTI-PIPE TRENCH. SEE SECTION X ON SHEET 15.
 - NEW CLEANOUT VAULT. SEE DETAIL 1 ON APS DRAWING NUMBER 156257 SHEET 3.
 - NEW LEACH FIELD PIPELINE. SEE SHEET 18.

THESE RECORD DRAWINGS DATED 01/17/20 AND TITLED "FOR RECORD" HAVE BEEN DEVELOPED FROM AS-BUILT MARKUPS AND MAY NOT REPRESENT THE FINAL PROJECT, AS CONSTRUCTED, IN EVERY DETAIL. THESE RECORD DRAWINGS HAVE BEEN PREPARED BASED ON INFORMATION SUPPLIED BY OTHERS AND THE ENGINEER HAS NOT VERIFIED THE ACCURACY OR COMPLETENESS OF THE INFORMATION.

2	01-17-20	FOR RECORD	AWF	DEM			FCC06814	
1	7-17-19	SEWERLINE DELETED	AWF	DEM			FCC06814	
NO.	DATE	REVISION	DWN	CHD	EXD	RWWD	APVD	W.A.

RETURN WATER PIPELINE PLAN 4
SCALE: 1"=100' (FULL SIZE)

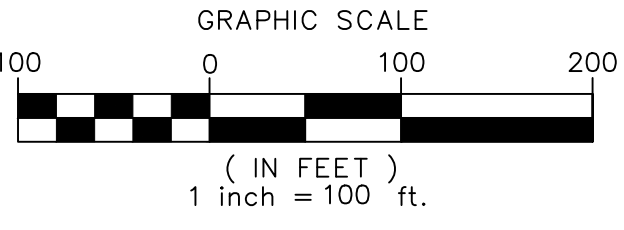


WORK SAFELY TODAY

THIS DRAWING IS CONFIDENTIAL AND SHALL NOT BE USED OR REPRODUCED IN ANY PART WITHOUT WRITTEN CONSENT OF PINNACLE WEST CAPITAL CORPORATION.

FOUR CORNERS POWER PLANT
RETURN WATER POND
RETURN WATER PIPELINE PLAN 4


SCALE: 1"=100' DATE: 10/04/19

DWN	AWF	EXD	---	APPROVED	W A	
CHD	DEM	RWWD	---	DAVID E. MICKANEN DRAWING APPROVED BY	FCC06814	
UNIT	DISC	TYPE	SYS	SUBSYS	NUMBER	SHEET
FC45CM	C	16	WP	AP	200485	10

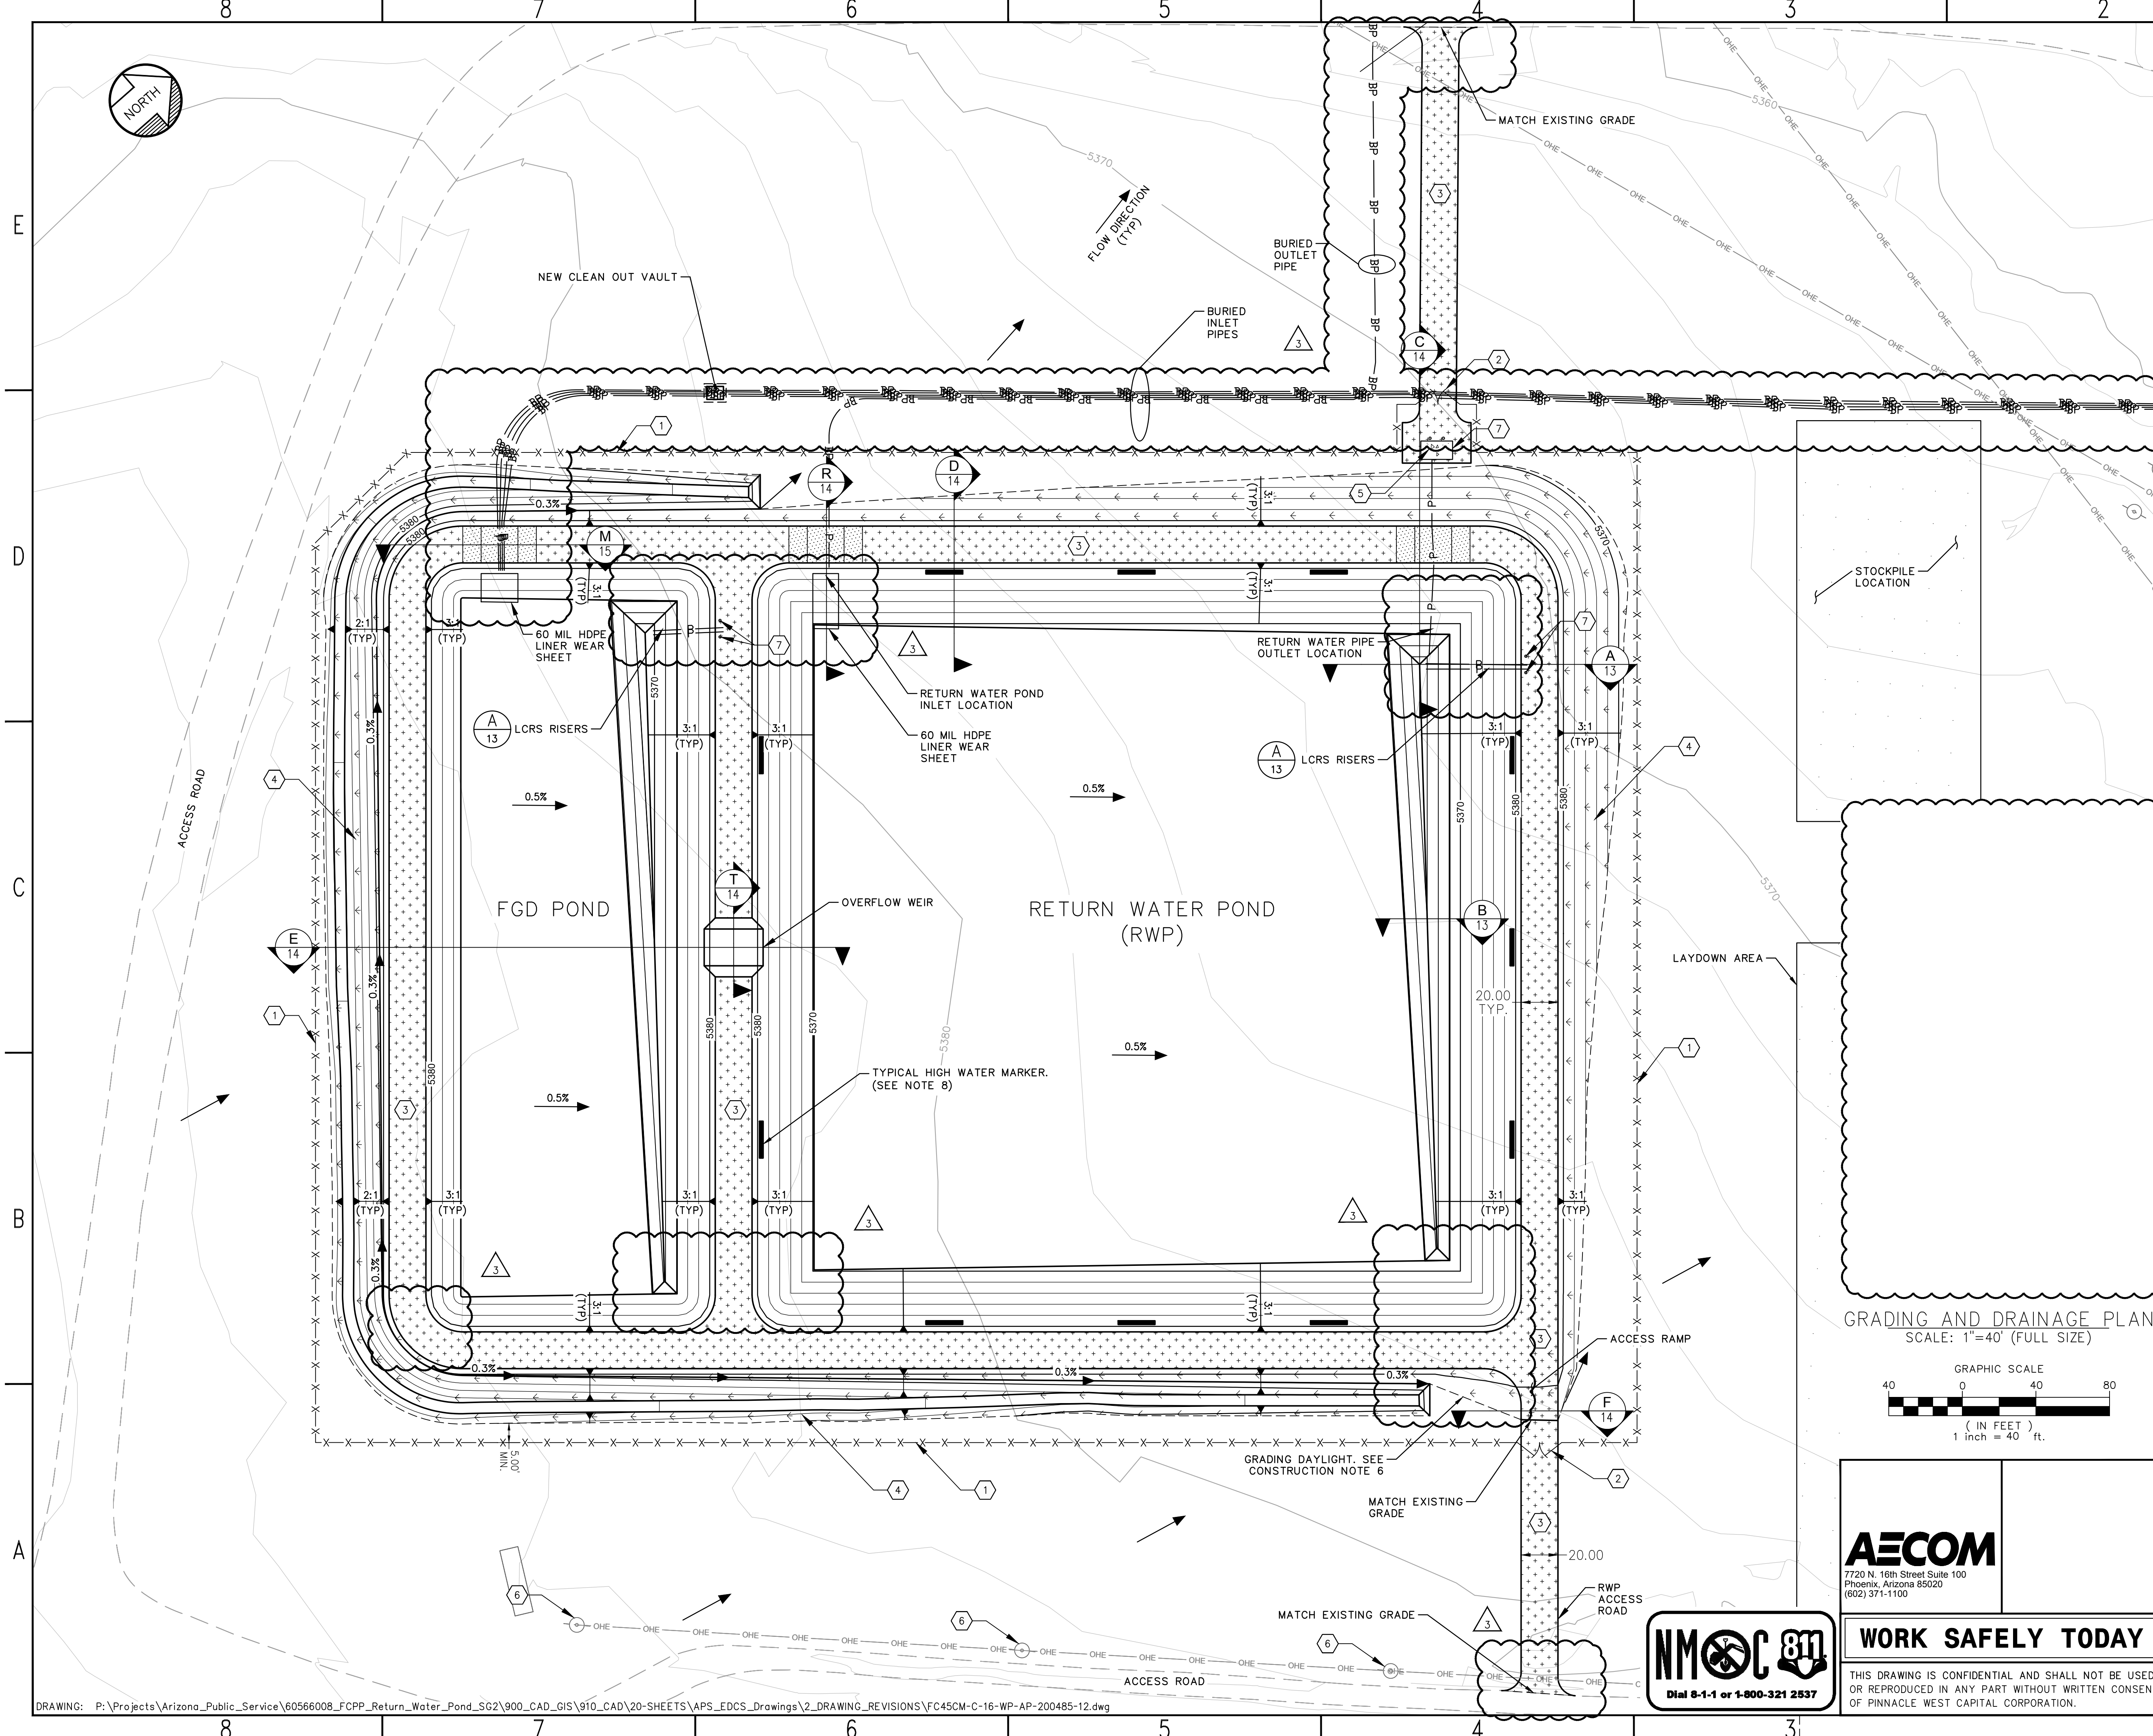

- CONSTRUCTION NOTES:**
1. ALL UNDERGROUND UTILITIES SHOWN ON THESE DRAWINGS SHOULD BE CONSIDERED APPROXIMATE ONLY.
 2. HYDRO-EXCAVATE TO A MINIMUM DEPTH OF 6 FEET TO FIELD VERIFY ALL EXISTING UNDERGROUND FACILITIES AND/OR UTILITIES AT CONFLICT LOCATIONS.
 3. ALIGNMENT OF PIPELINE SHOWN ON DRAWINGS IS CONCEPTUAL. CONTRACTOR CAN PROPOSE REVISED PIPE ALIGNMENTS WHICH MUST BE SUBMITTED TO ENGINEER FOR APPROVAL.
 4. CONTRACTOR SHALL MAKE MINOR ADJUSTMENTS IN THE FIELD FOR PIPE ROUTING AND INSTALLED LENGTHS.
 5. CONTRACTOR SHALL INSTALL APOC SERIES 140 AIR/VACUUM VALVE (AVV) AT HIGH POINTS IN PIPELINE.
 6. BACKFILL TO PROVIDE POSITIVE DRAINAGE AROUND ACCESS RAMP.
 7. GRAVEL PAVEMENT SHALL CONSIST OF 6 INCHES OF TYPE II ABC COMPACTED AS PER SPEC SECTION 31 23 00 AND NMDOT SPEC SECTION 303.
 8. HIGH WATER MARKER SHALL CONSIST OF RED HDPE LINER AND SHALL BE 2 FEET WIDE BY 20 FEET LONG AND SHALL BE EVENLY SPACED. MARKER SHALL BE EXTRUSION WELDED TO THE PRIMARY LINER AT ELEVATION 5,379 FEET.
 9. AS-BUILT LINES, GRADES, AND POINTS CAN BE FOUND IN APS DRAWING NUMBER FC00CM-C-17-SF-RG-100003-101.
- KEY NOTES:**
- 1 NEW 4-FT HIGH FENCE. SEE DETAILS 6 AND 9 ON SHEET 16.
 - 2 DOUBLE SWING GATE. SEE DETAIL 8 ON SHEET 16.
 - 3 6" GRAVEL PAVEMENT. SEE NOTE 7.
 - 4 REVEGETATE NON-LINED BERMS WITH NATIVE GRASSES.
 - 5 PUMP SLAB. SEE SHEET 26 AND 31.
 - 6 EXISTING POWER POLE. PRESERVE AND PROTECT.
 - 7 GUARD POSTS. SEE DETAIL 7 ON SHEET 16

GRADING AND DRAINAGE PLAN
SCALE: 1"=40' (FULL SIZE)

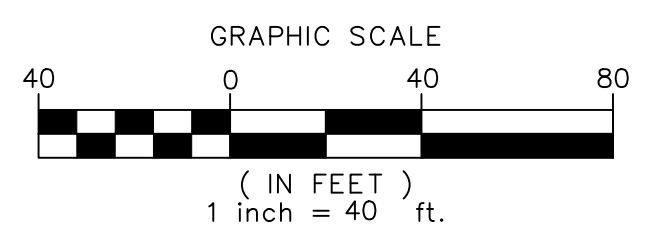

THESE RECORD DRAWINGS DATED 01/17/20 AND TITLED "FOR RECORD" HAVE BEEN DEVELOPED FROM AS-BUILT MARKUPS AND MAY NOT REPRESENT THE FINAL PROJECT, AS CONSTRUCTED, IN EVERY DETAIL. THESE RECORD DRAWINGS HAVE BEEN PREPARED BASED ON INFORMATION SUPPLIED BY OTHERS AND THE ENGINEER HAS NOT VERIFIED THE ACCURACY OR COMPLETENESS OF THE INFORMATION.

NO.	DATE	REVISION	DWN	CHD	EXD	RWVD	APVD	W.A.
3	01-17-20	FOR RECORD	AWF	DEM				FC006814
2	7-17-19	SEWERLINE DELETED	AWF	DEM				FC006341
1	05-16-19	UPDATED POINT ELEVATIONS	AWF	DEM				FC006341

**FOUR CORNERS POWER PLANT
RETURN WATER POND
GRADING AND DRAINAGE PLAN**



SCALE: 1"=40' DATE: 10/04/19

DWN	AWF	EXD	APPROVED	W.A.
CHD	AWF	---	DAVID E. MICKANEN DRAWING APPROVED BY	FC006814

UNIT	DISC	TYPE	SYS	SUBSYS	NUMBER	SHEET
FC45CM	C	16	WP	AP	200485	12










7720 N. 16th Street Suite 100
Phoenix, Arizona 85020
(602) 371-1100

WORK SAFELY TODAY

THIS DRAWING IS CONFIDENTIAL AND SHALL NOT BE USED OR REPRODUCED IN ANY PART WITHOUT WRITTEN CONSENT OF PINNACLE WEST CAPITAL CORPORATION.



- CONSTRUCTION NOTES:
1. ANCHOR TRENCH INTENDED TO PULL OUT. MODIFICATION TO ANCHOR TRENCH DETAIL MUST BE APPROVED BY ENGINEER.
 2. ADS (OR EQUAL) SINGLE WALL HIGH DENSITY CORRUGATED POLYETHYLENE HEAVY DUTY PERFORATED PIPE MEETING ASTM F667 WITH TYPE B SLOT PATTERN.
 3. CLSM TO BE 1 FOOT THICK EXCEPT AT ANCHOR TRENCH.
 4. HDPE LINER SHALL BE ATTACHED TO PIPE BY EXTRUSION WELDING LINER TO PIPE OR ANOTHER METHOD WITH ENGINEER APPROVAL.
 5. FOR LCRS RISER PUMPS AND APPURTENANCES SEE SHEET 35. ADD CAP TO PIPE WITHOUT PUMP INSTALLED.
 6. AS-BUILT LINES, GRADES, AND POINTS CAN BE FOUND IN APS DRAWING NUMBER FC00CM-C-17-SF-RG-100003-101.

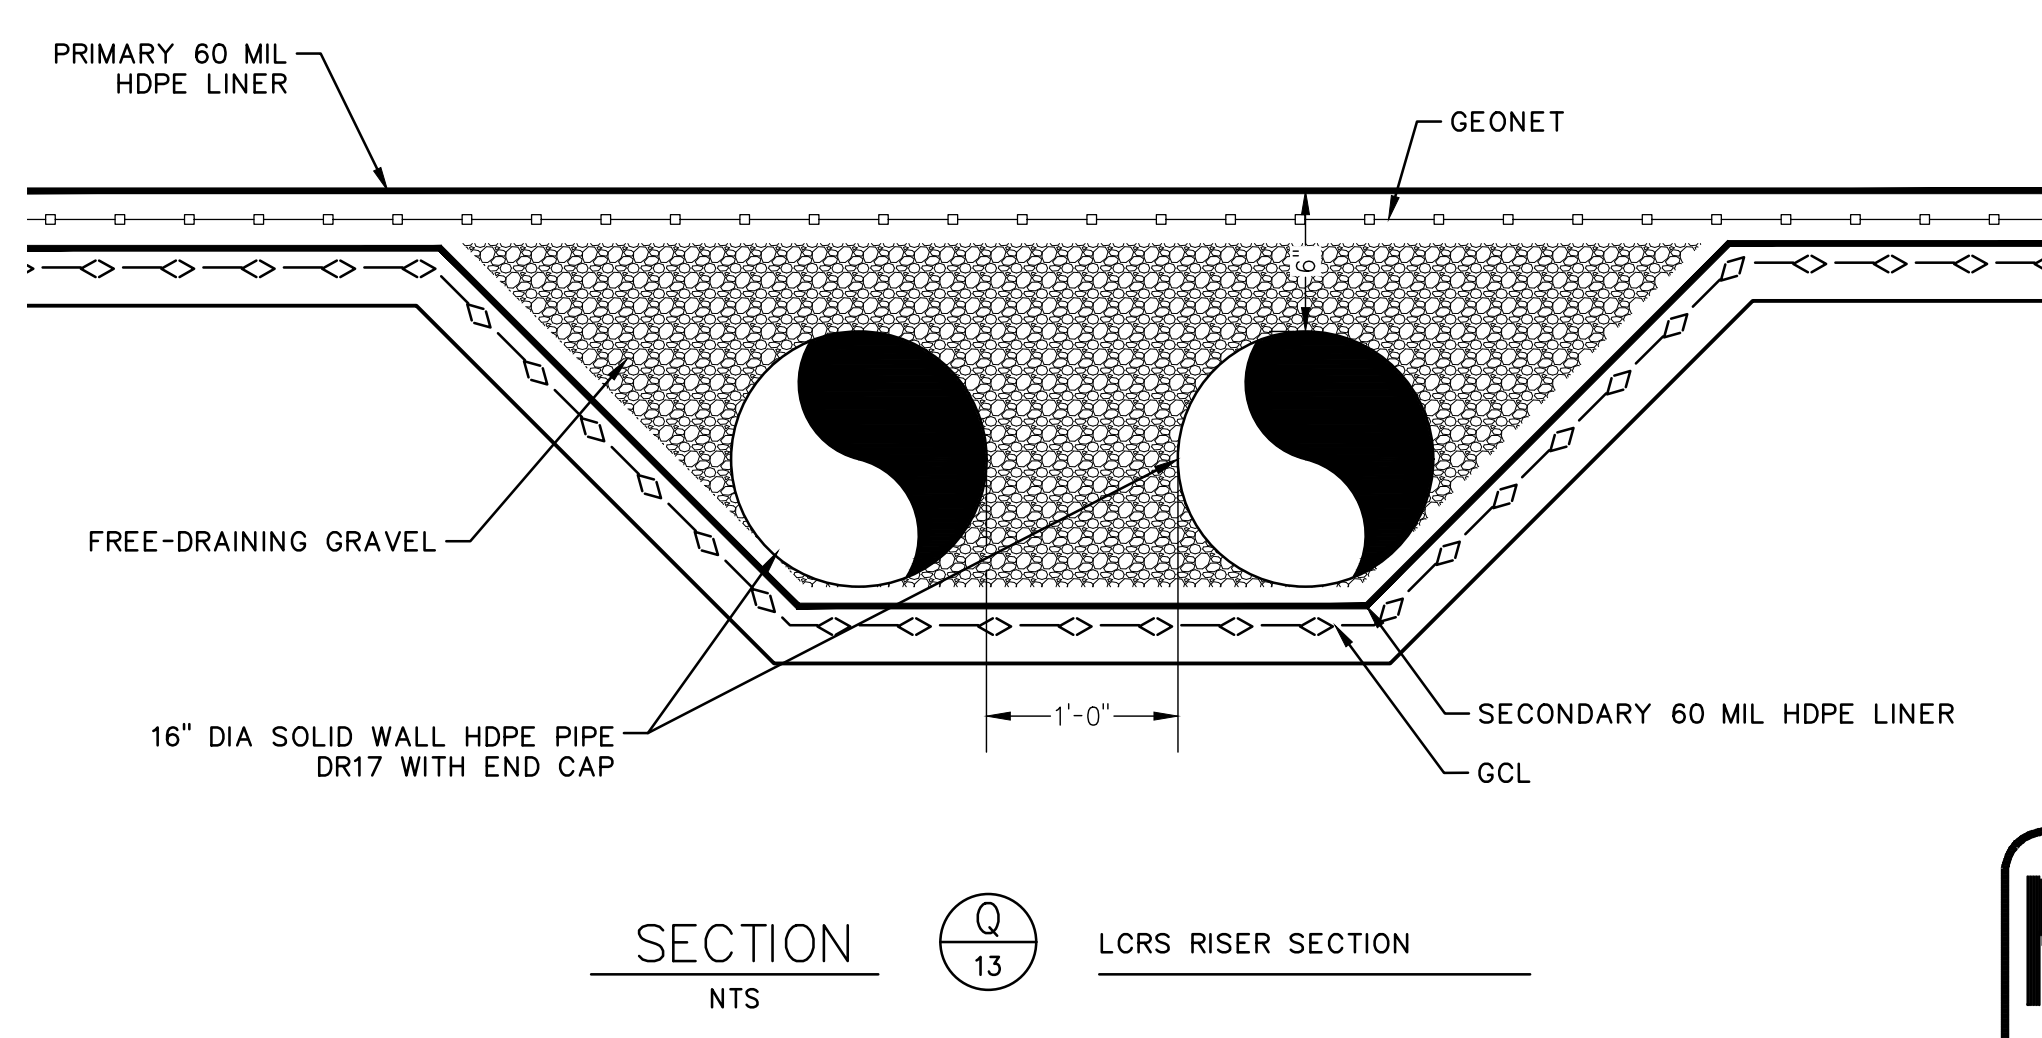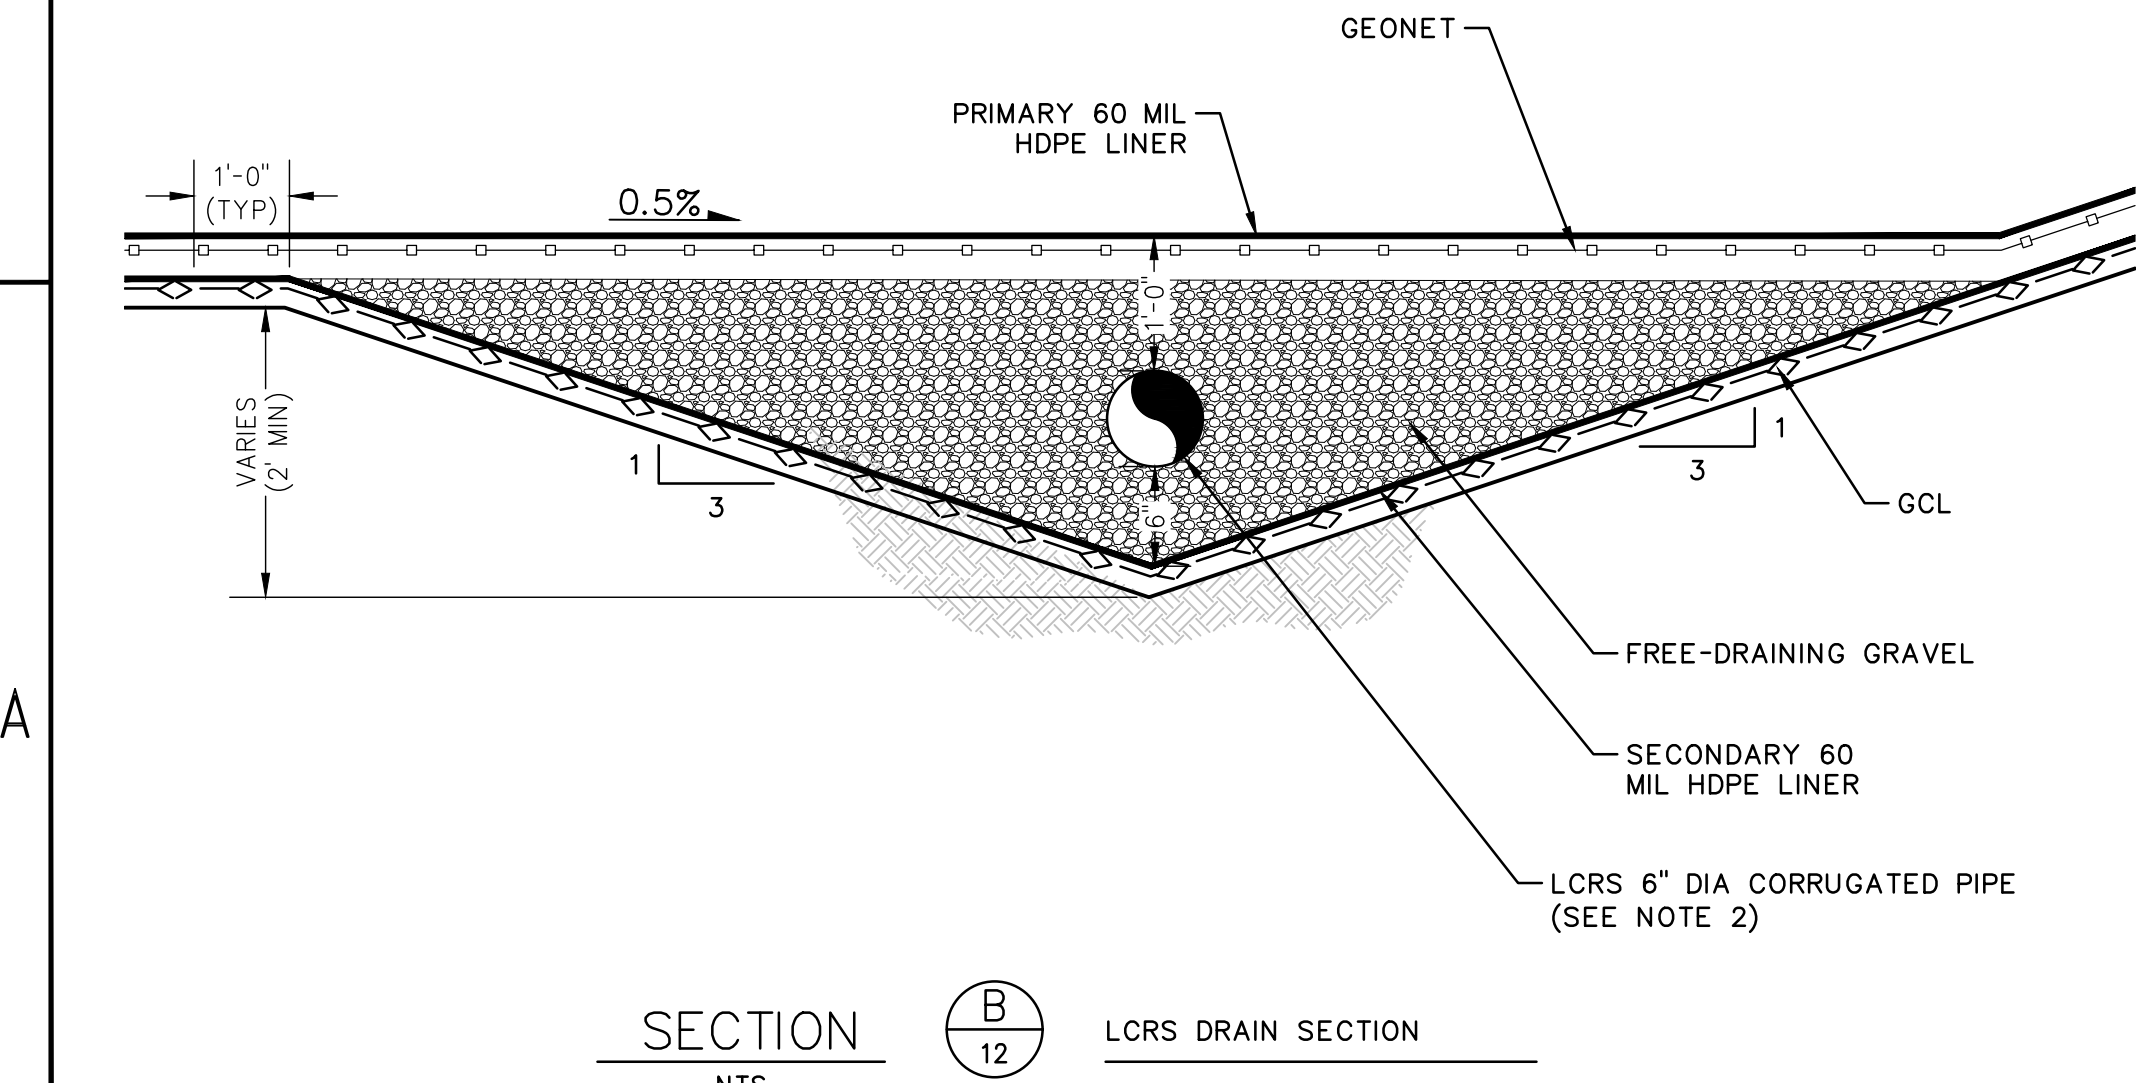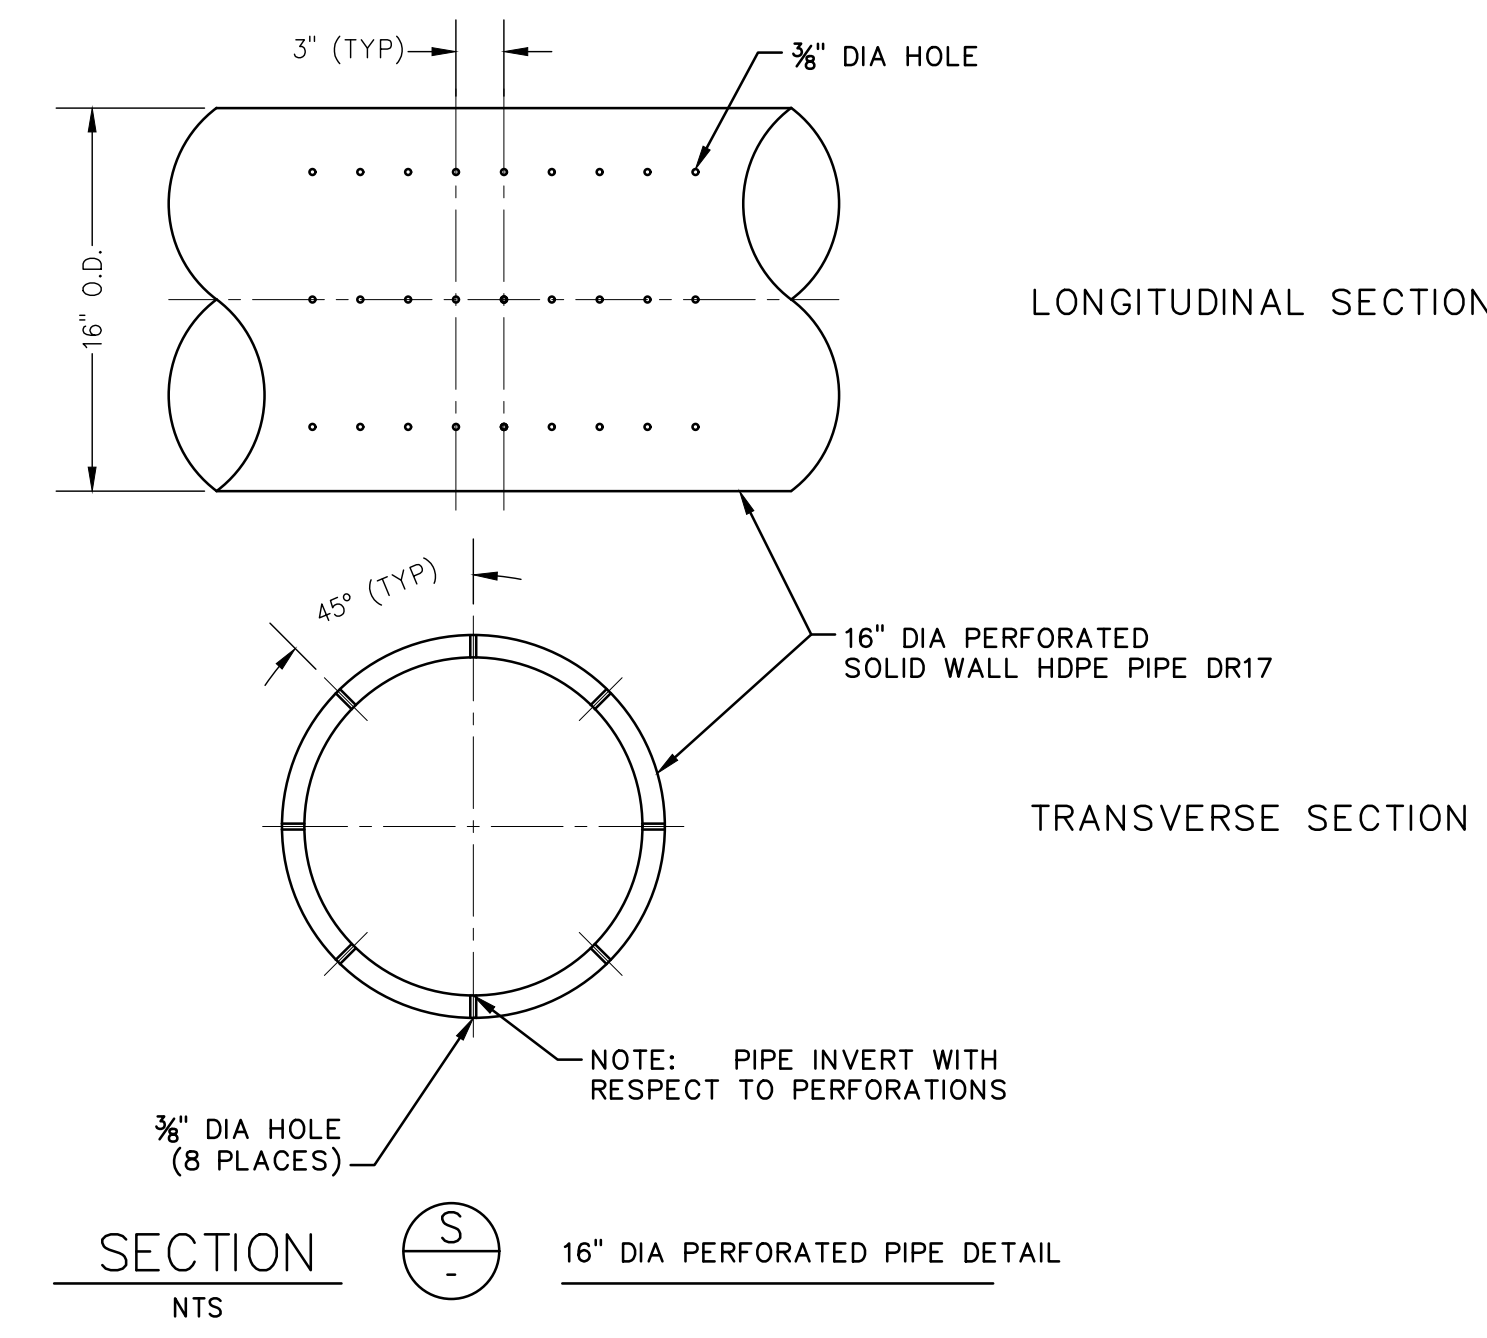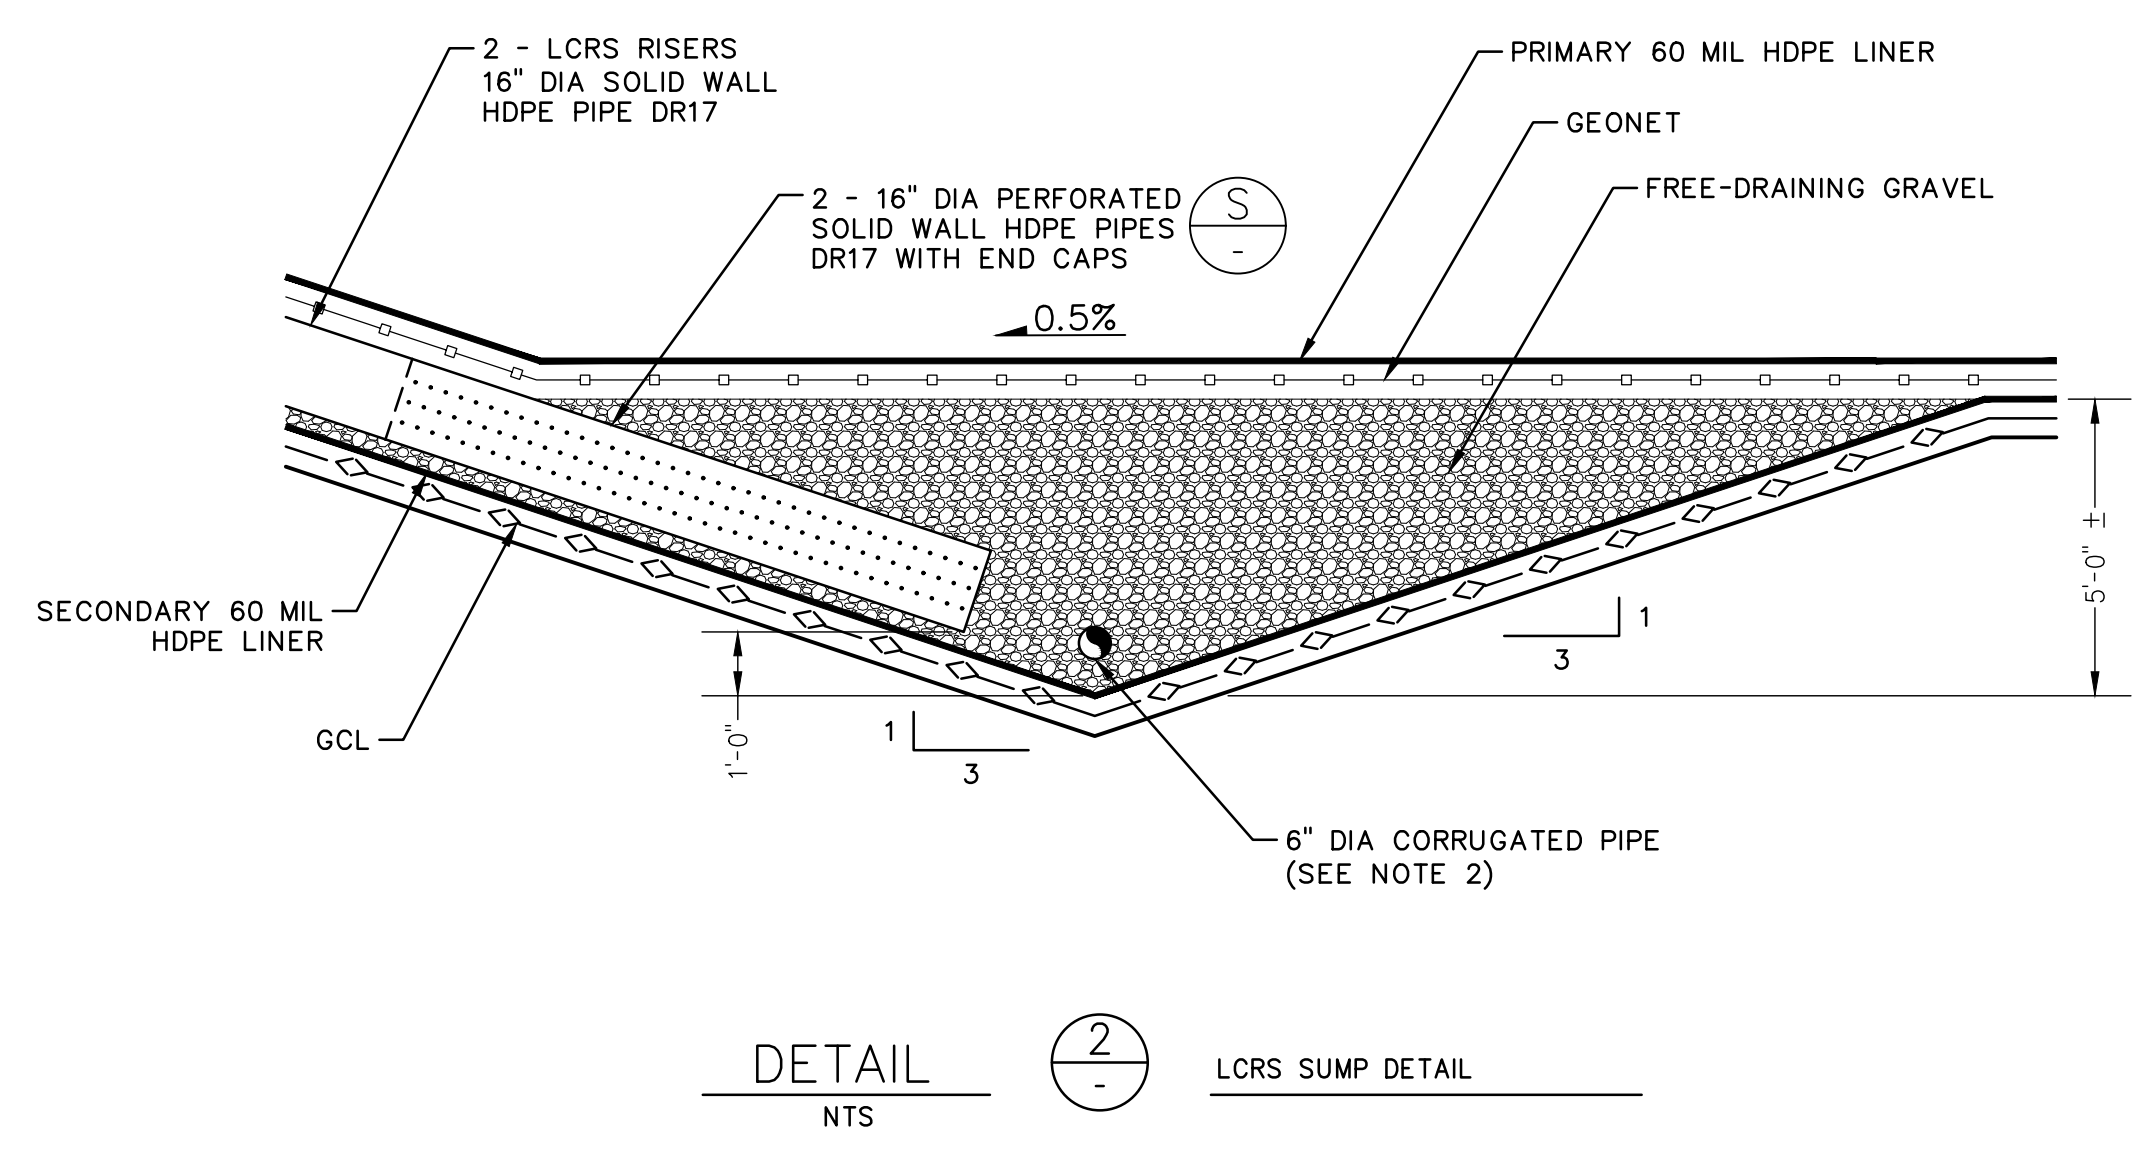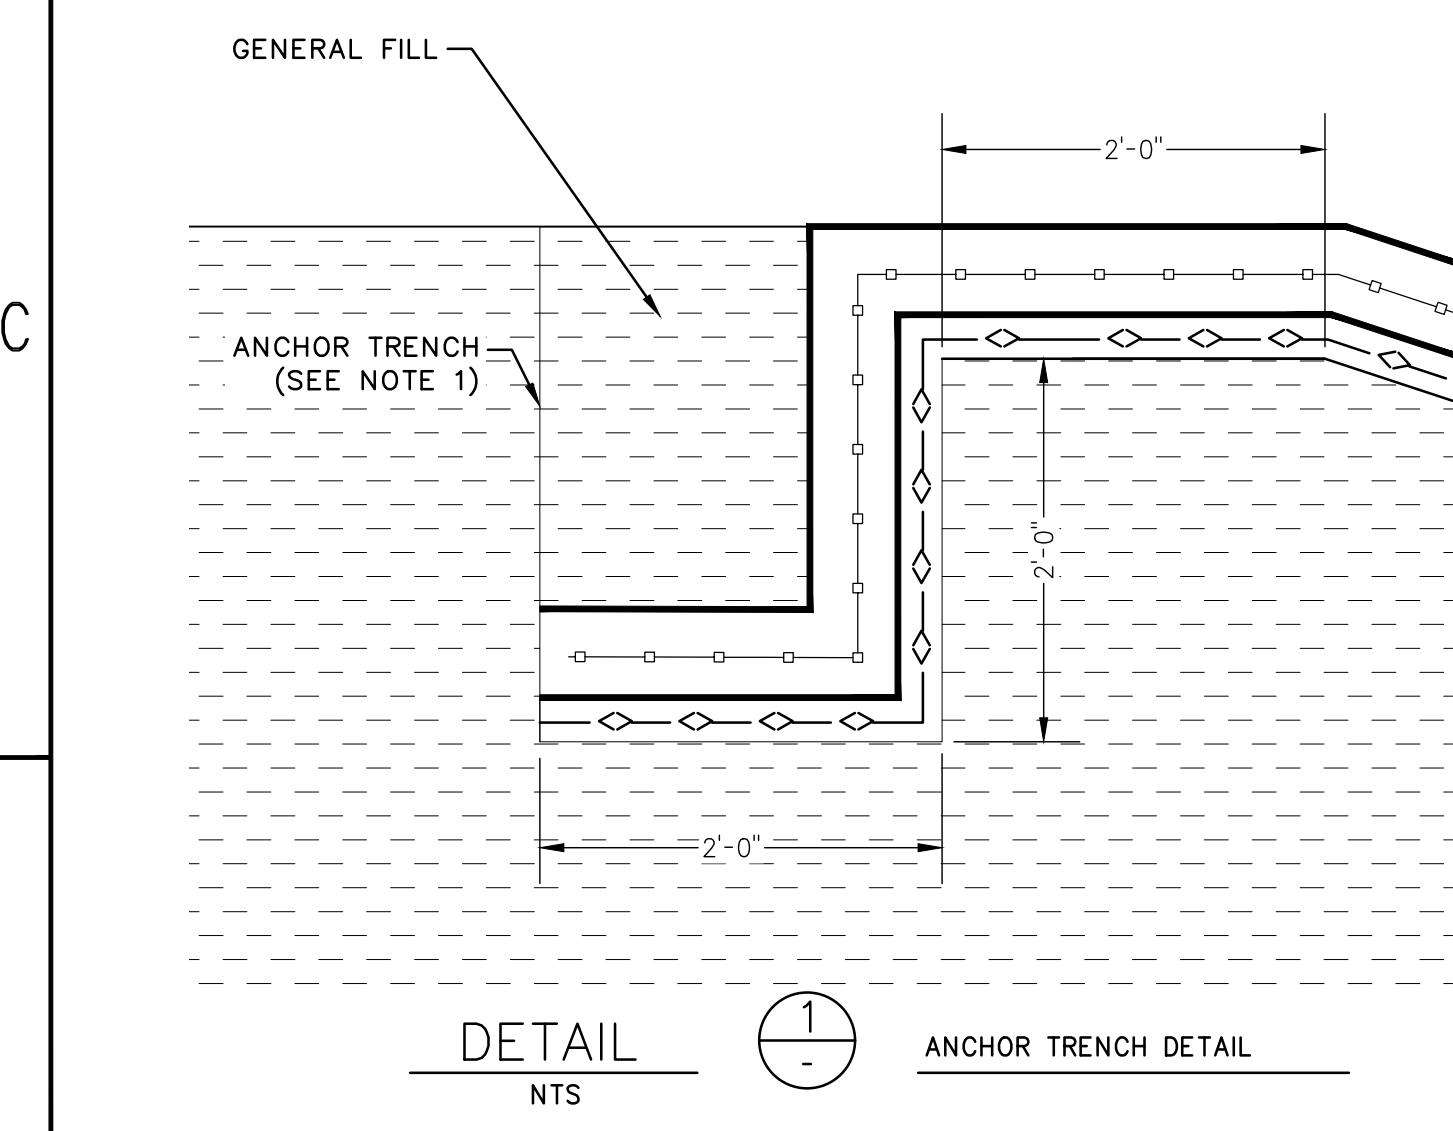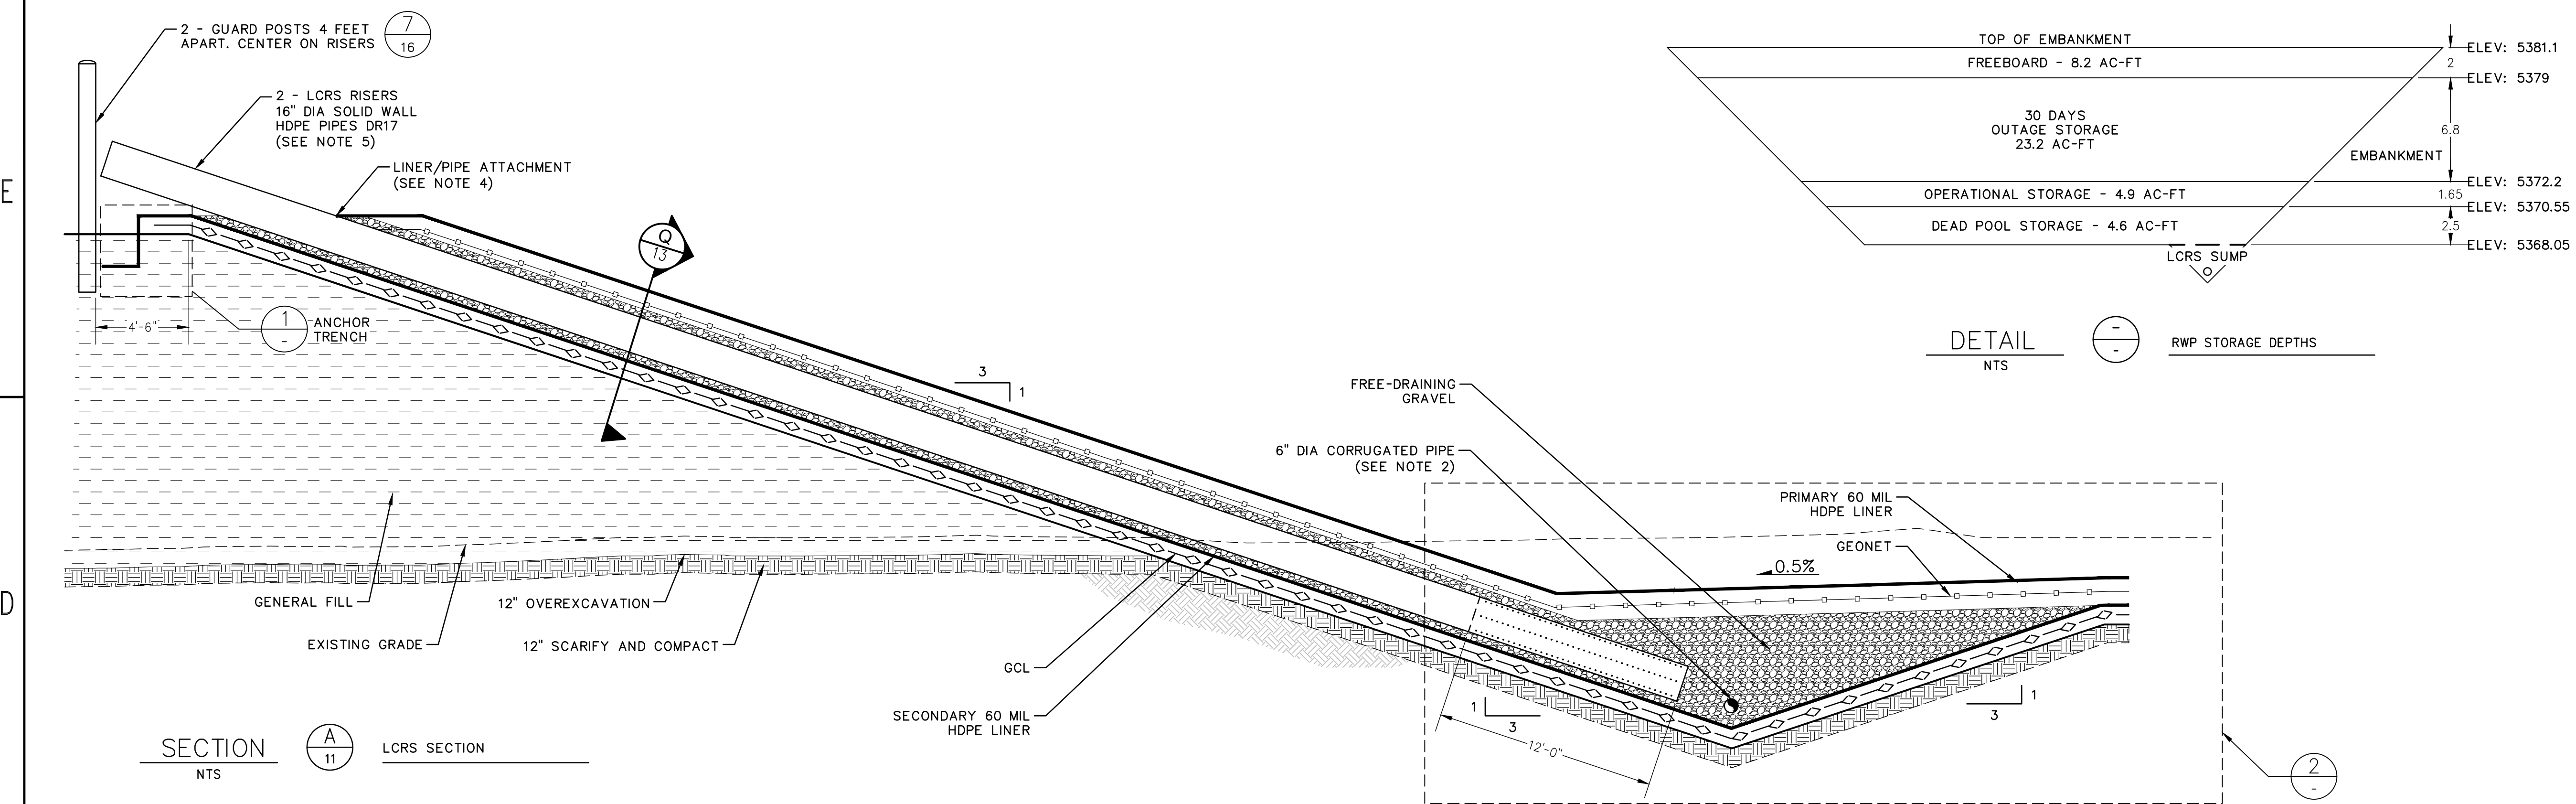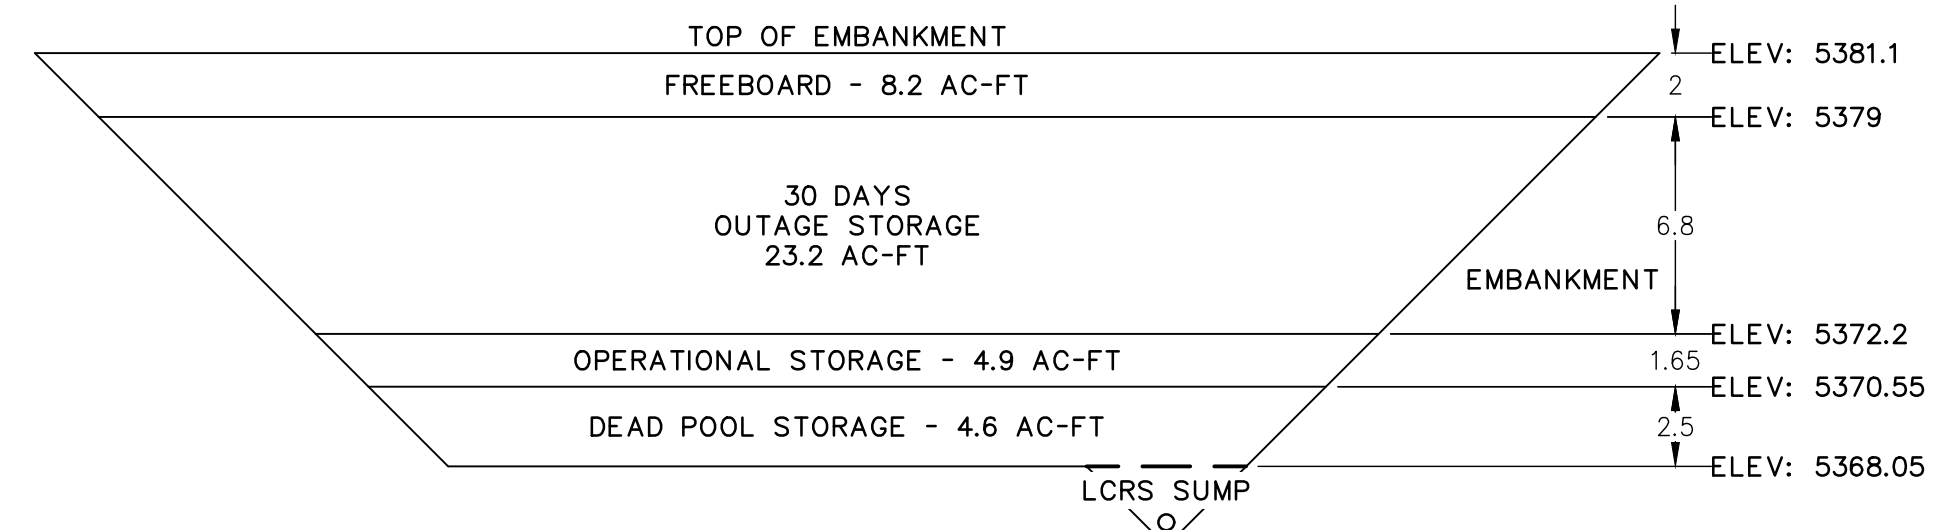

THESE RECORD DRAWINGS DATED 01/17/20 AND TITLED "FOR RECORD" HAVE BEEN DEVELOPED FROM AS-BUILT MARKUPS AND MAY NOT REPRESENT THE FINAL PROJECT, AS CONSTRUCTED, IN EVERY DETAIL. THESE RECORD DRAWINGS HAVE BEEN PREPARED BASED ON INFORMATION SUPPLIED BY OTHERS AND THE ENGINEER HAS NOT VERIFIED THE ACCURACY OR COMPLETENESS OF THE INFORMATION.

NO.	DATE	REVISION	DWN	CHD	EXD	RWVD	APVD	W.A.
1	01-17-20	FOR RECORD						FC006814

FOUR CORNERS POWER PLANT
RETURN WATER POND
LINER SECTIONS AND DETAILS



SCALE AS NOTED DATE 10/04/19

APPROVED BY DAVID E. MICKANEN
DRAWING APPROVED BY FC006814

UNIT	DISC	TYPE	SYS	SUBSYS	NUMBER	SHEET
FC45CM	C	65	WP	AP	200485	13



WORK SAFELY TODAY

THIS DRAWING IS CONFIDENTIAL AND SHALL NOT BE USED OR REPRODUCED IN ANY PART WITHOUT WRITTEN CONSENT OF PINNACLE WEST CAPITAL CORPORATION.




CONSTRUCTION NOTES:

- GRAVEL PAVEMENT SHALL CONSIST OF 6 INCHES OF TYPE II ABC COMPACTED AS PER SPEC SECTION 31 23 00 AND NMDOT SPEC SECTION 303.
- AS-BUILT LINES, GRADES, AND POINTS CAN BE FOUND IN APS DRAWING NUMBER FC00CM-C-17-SF-RG-100003-101.

KEY NOTES:

- RETURN WATER PIPE. SEE MECHANICAL SHEETS FOR CONNECTION DETAILS.

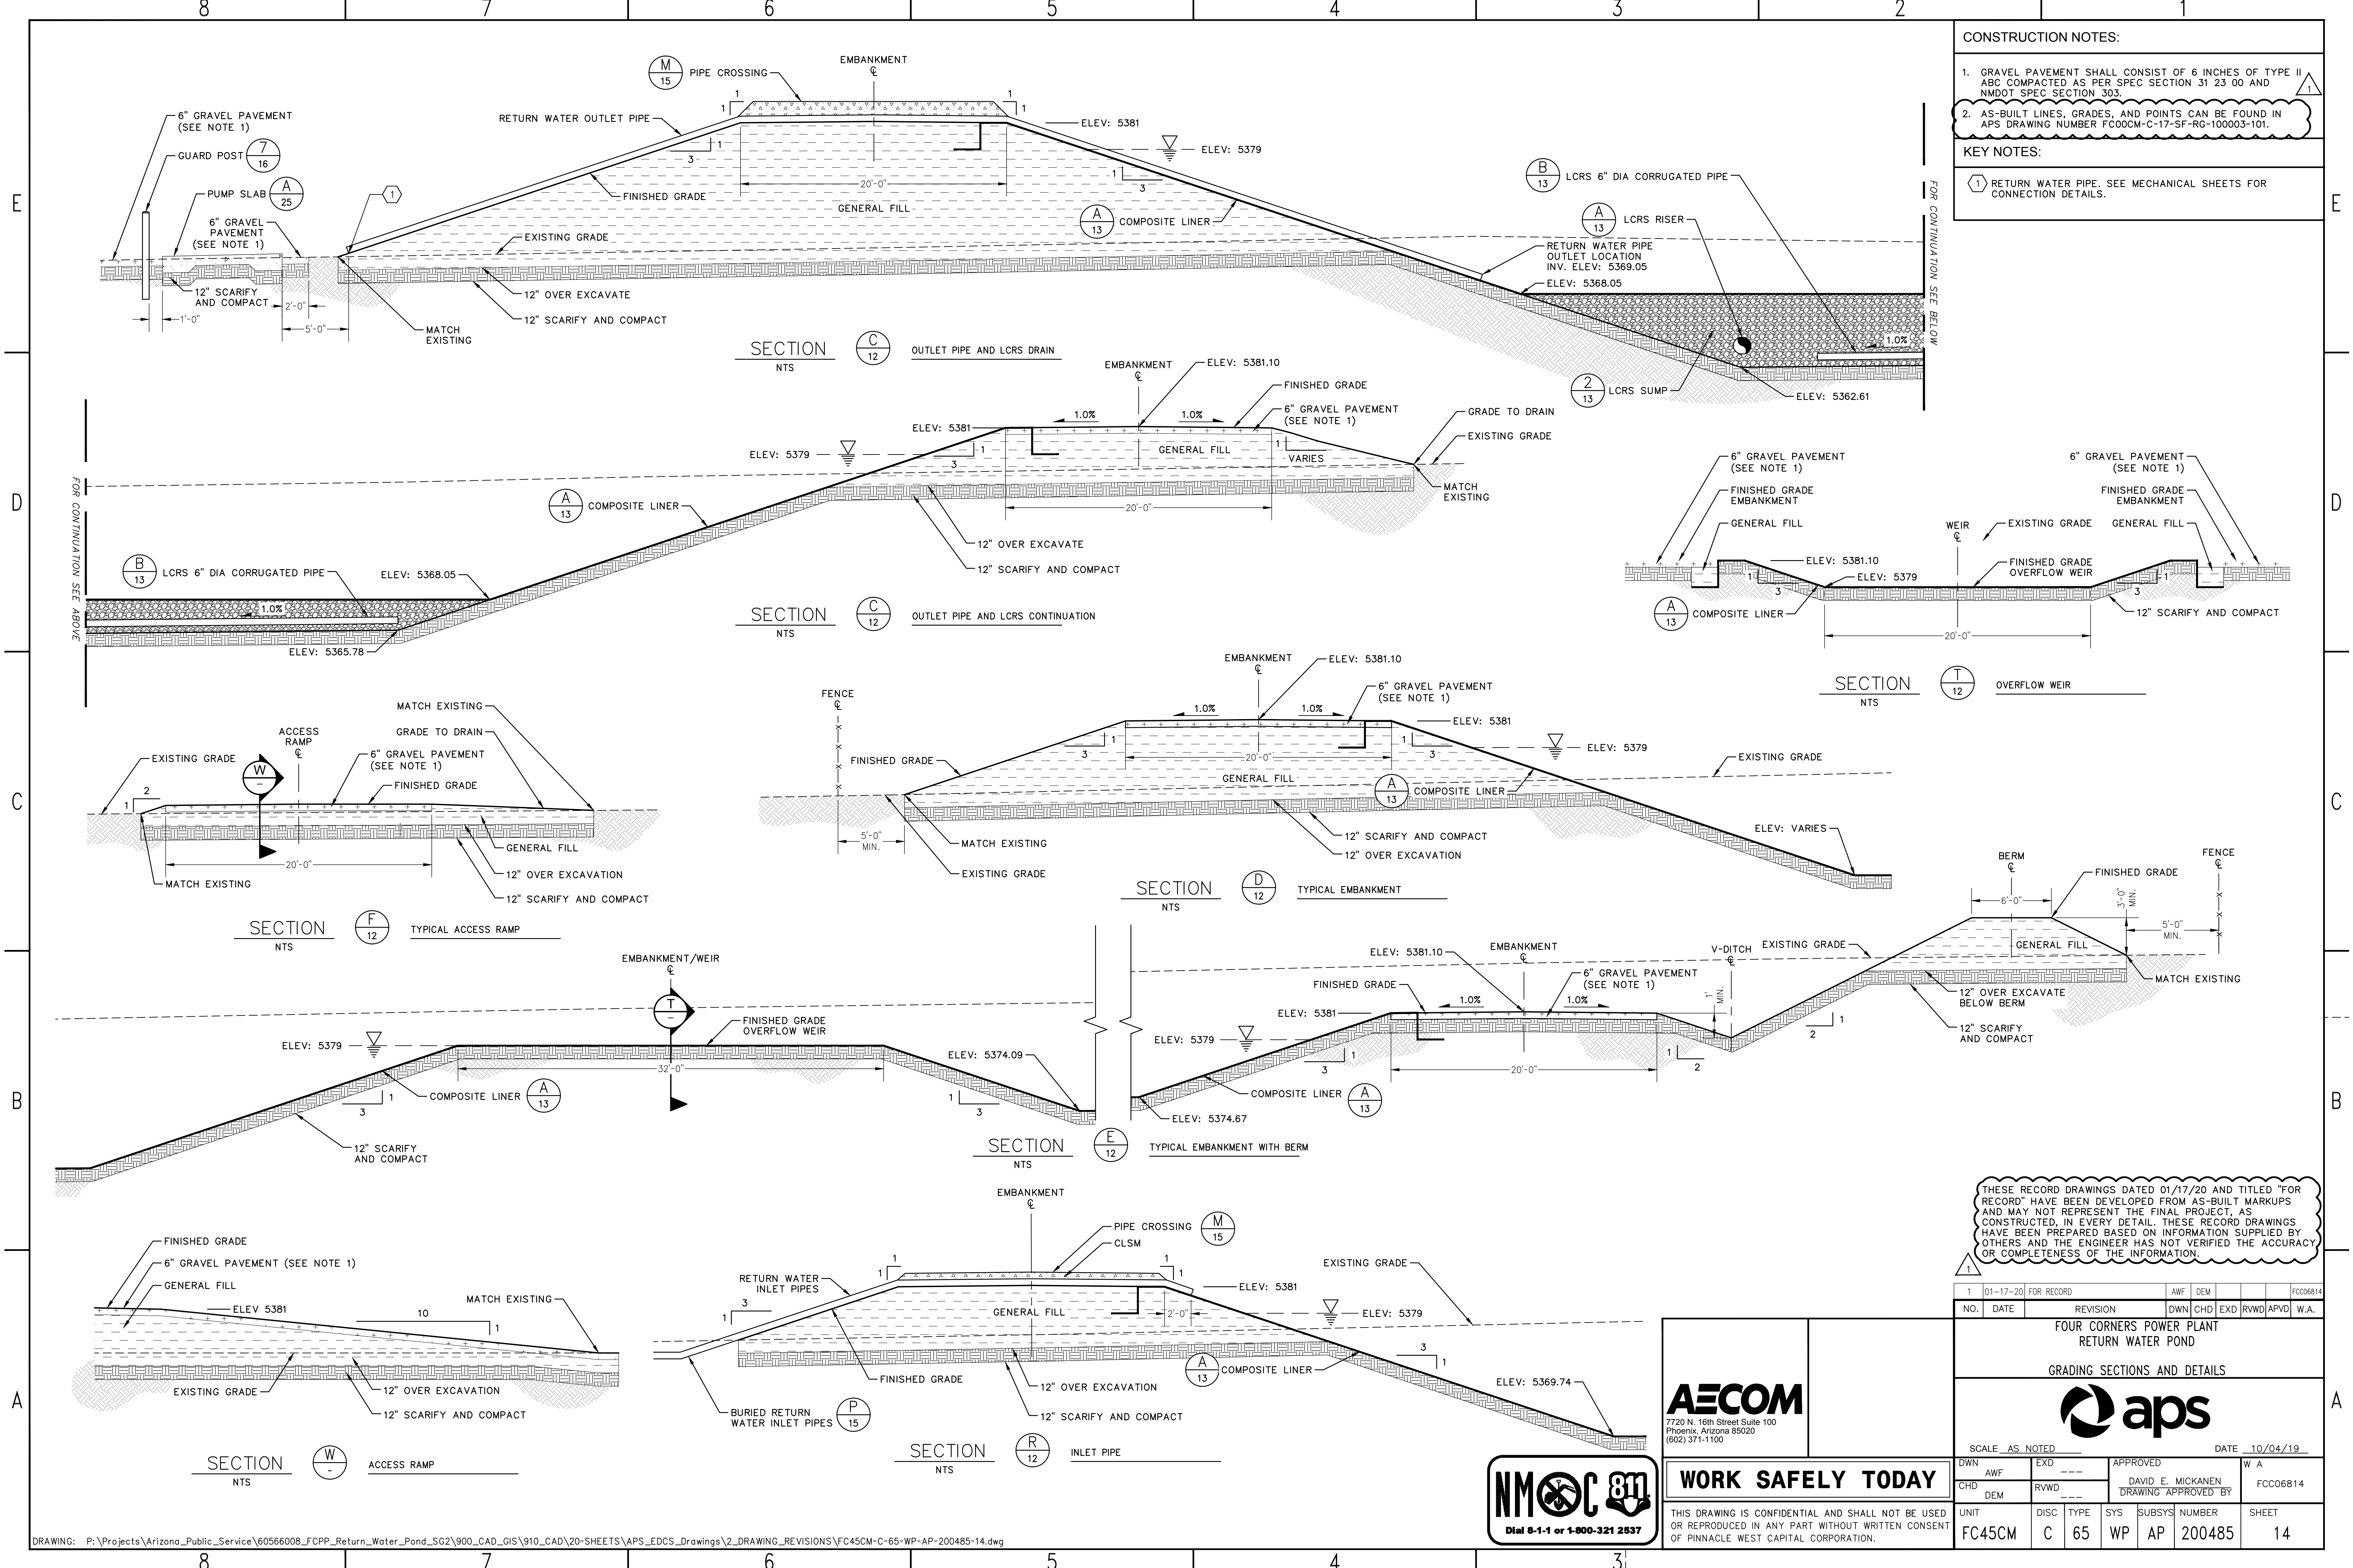

THESE RECORD DRAWINGS DATED 01/17/20 AND TITLED "FOR RECORD" HAVE BEEN DEVELOPED FROM AS-BUILT MARKUPS AND MAY NOT REPRESENT THE FINAL PROJECT, AS CONSTRUCTED, IN EVERY DETAIL. THESE RECORD DRAWINGS HAVE BEEN PREPARED BASED ON INFORMATION SUPPLIED BY OTHERS AND THE ENGINEER HAS NOT VERIFIED THE ACCURACY OR COMPLETENESS OF THE INFORMATION.

NO.	DATE	REVISION	DWN	CHD	EXD	RWVD	APVD	W.A.
1	01-17-20	FOR RECORD						FC006814

FOUR CORNERS POWER PLANT
RETURN WATER POND
GRADING SECTIONS AND DETAILS
















SCALE AS NOTED		DATE 10/04/19	
DWN	AWF	EXD	---
CHD	DEM	RWVD	---
APPROVED		W.A.	
DAVID E. MICKANEN		FCC06814	
DRAWING APPROVED BY			
UNIT	DISC	TYPE	SYS
FC45CM	C	65	WP
SUBSYS	NUMBER	SHEET	
AP	200485	14	

AECOM
7720 N. 16th Street Suite 100
Phoenix, Arizona 85020
(602) 371-1100

WORK SAFELY TODAY

THIS DRAWING IS CONFIDENTIAL AND SHALL NOT BE USED OR REPRODUCED IN ANY PART WITHOUT WRITTEN CONSENT OF PINNACLE WEST CAPITAL CORPORATION.



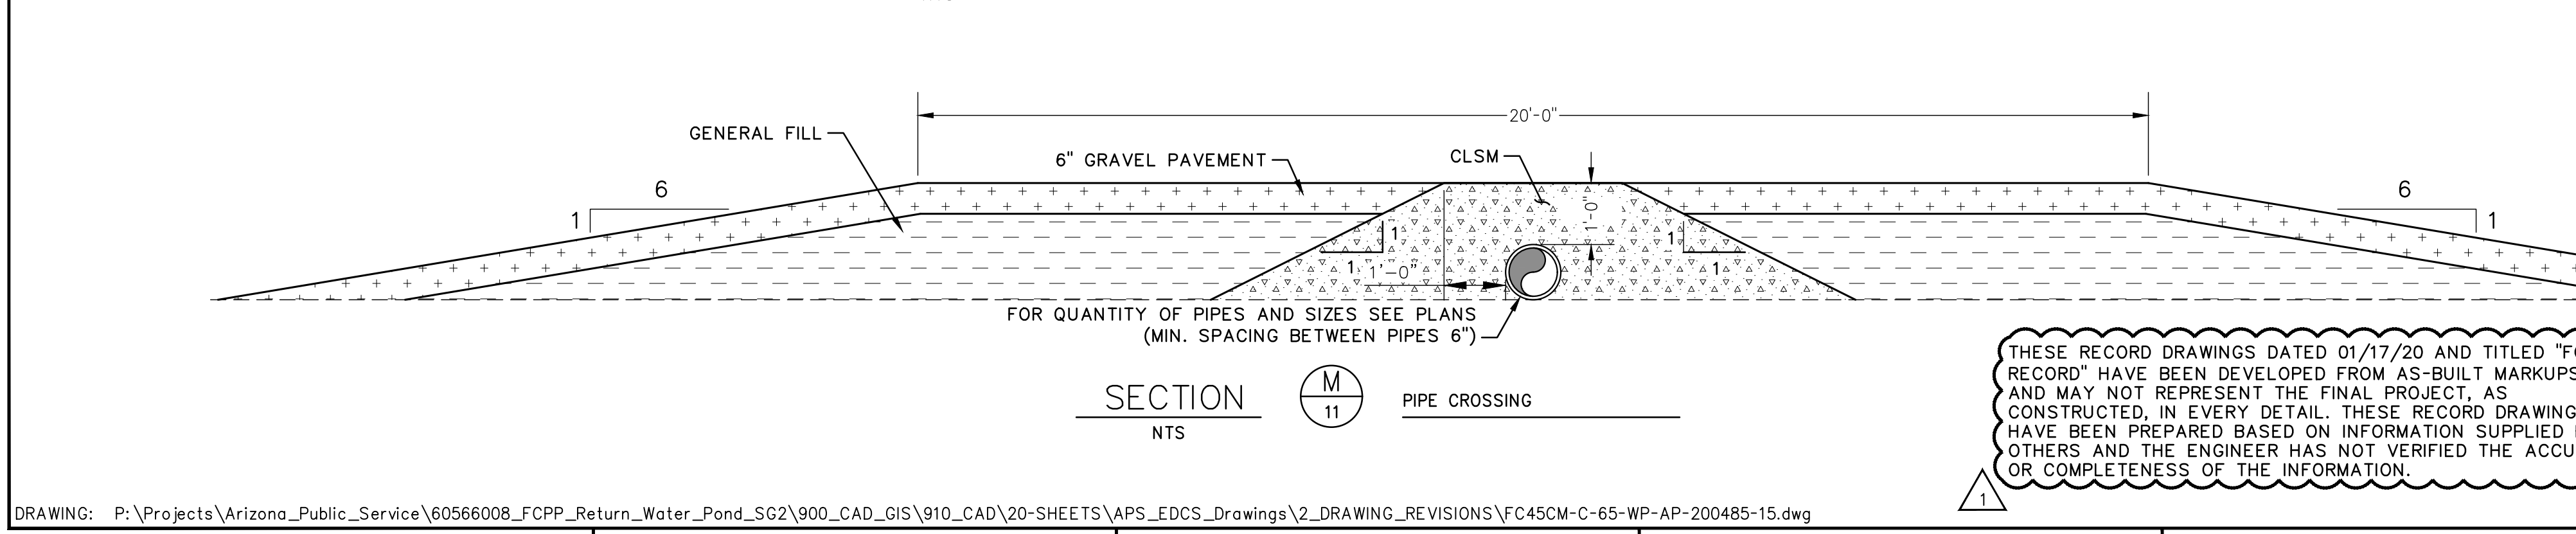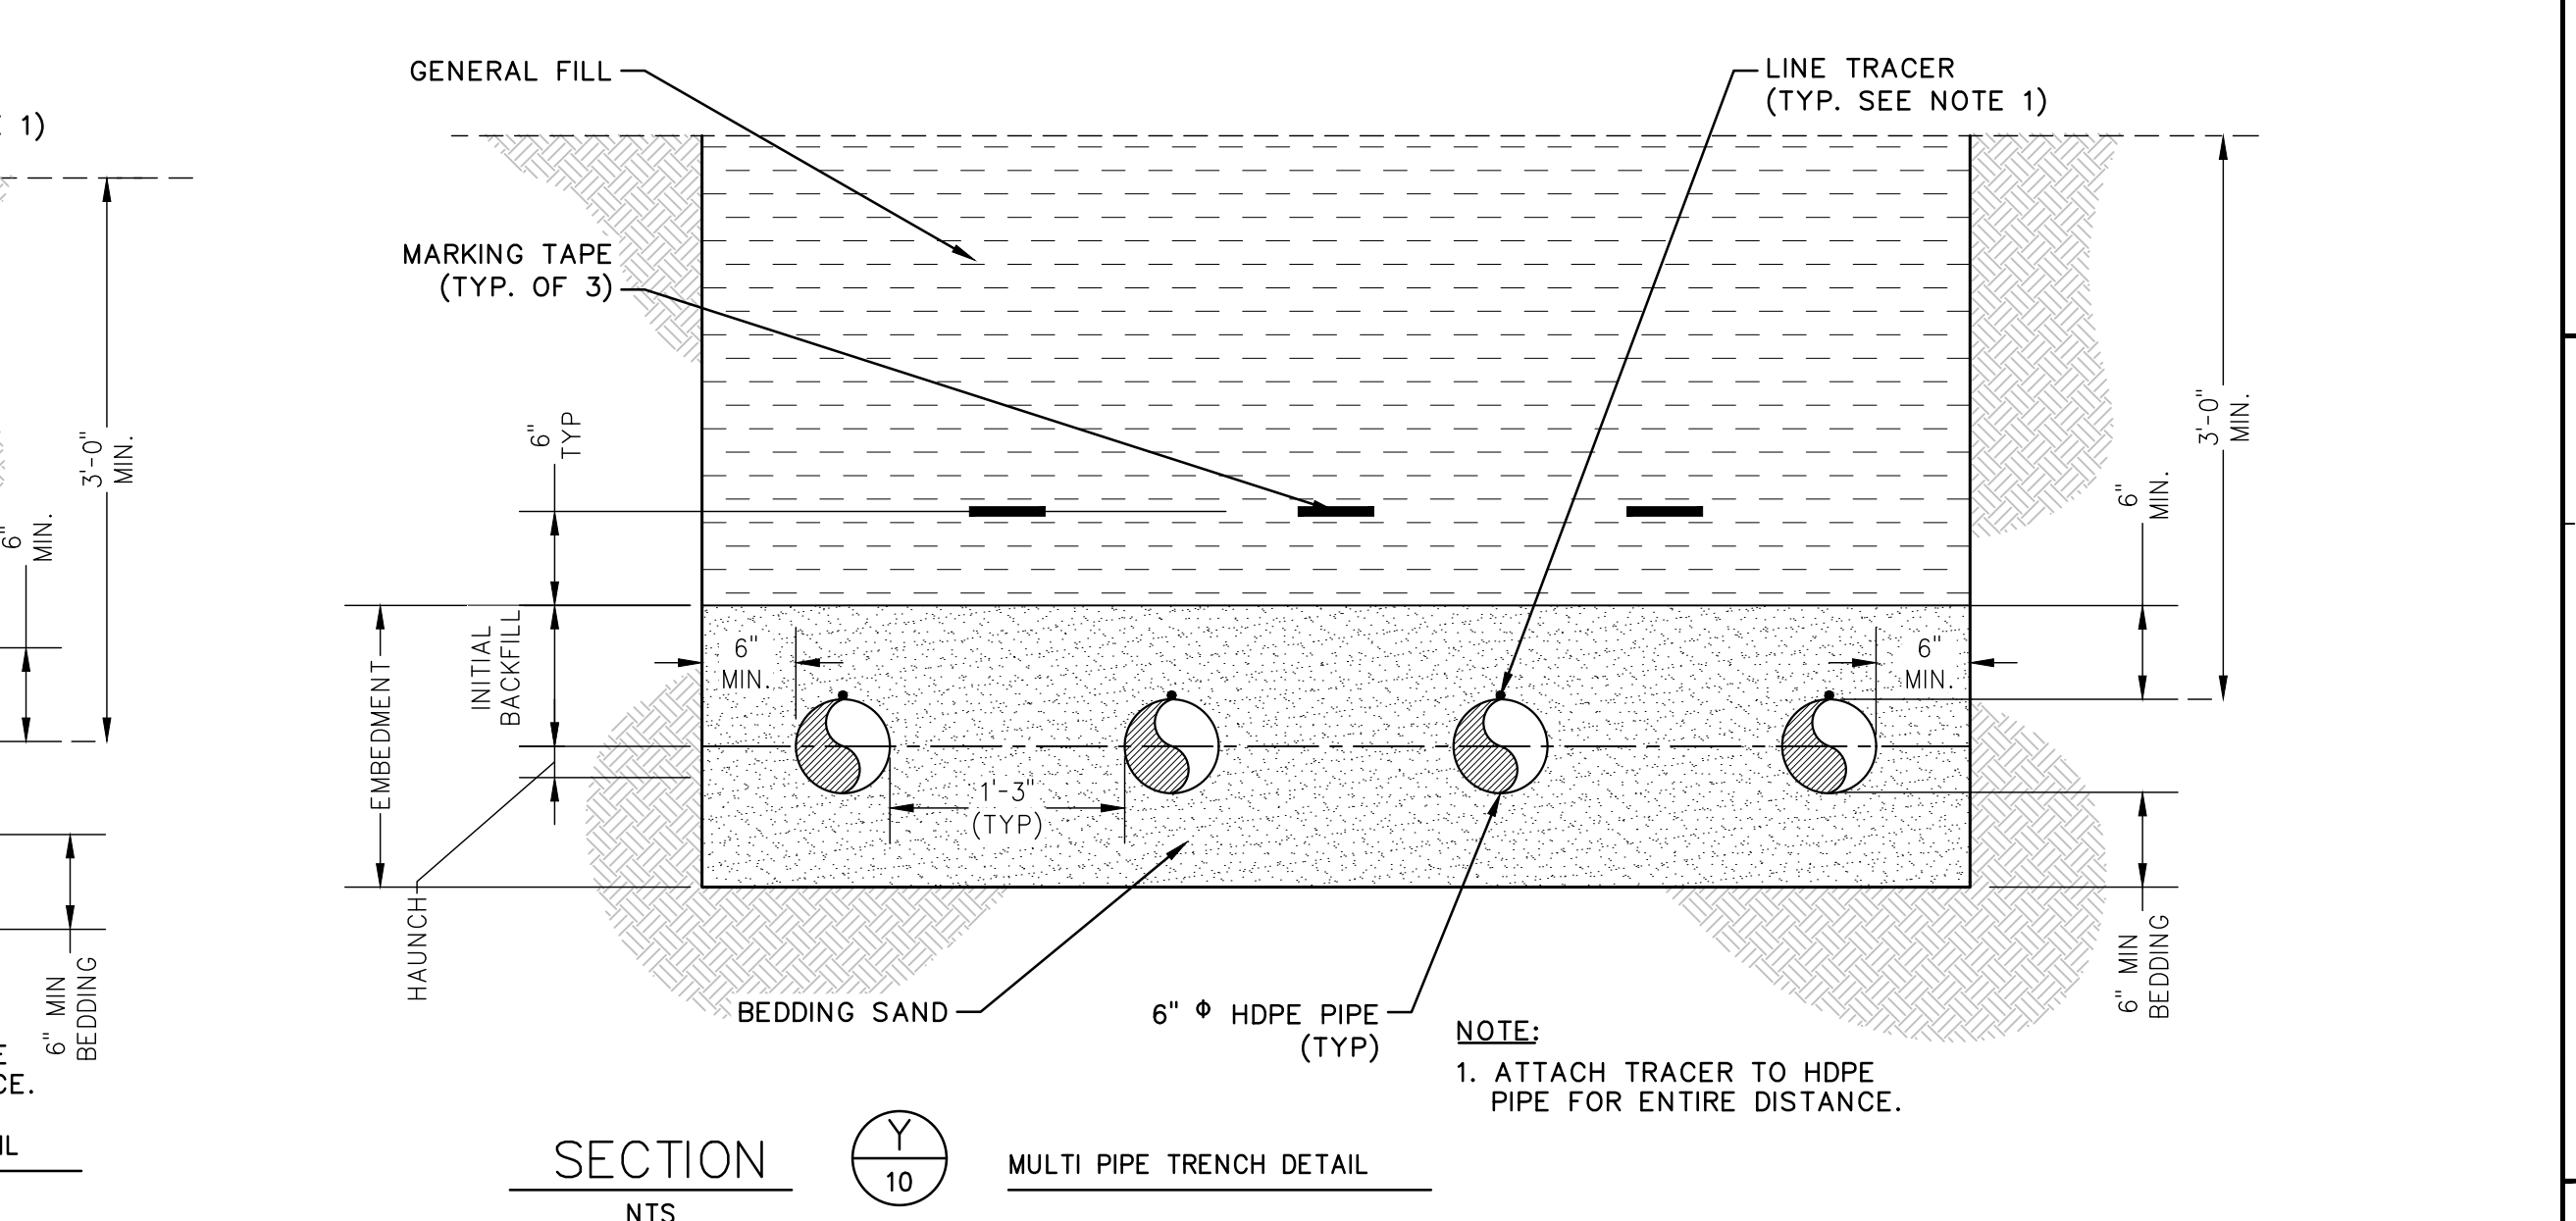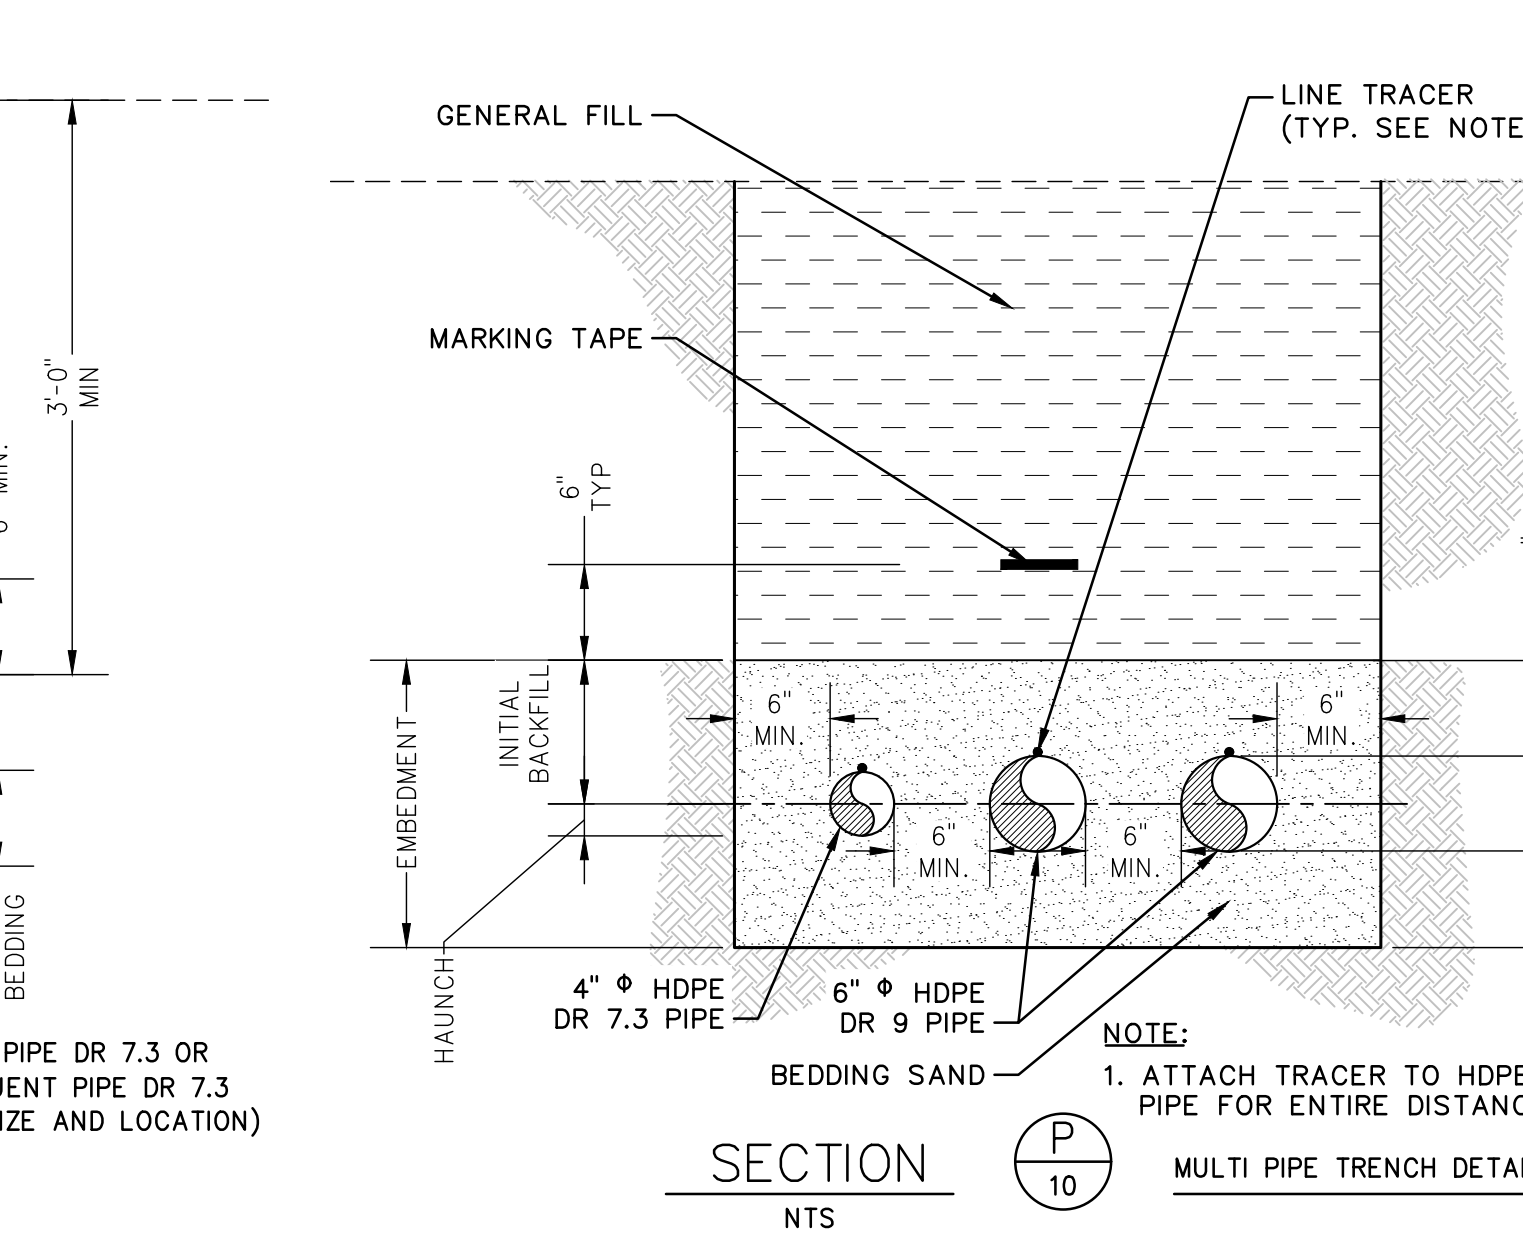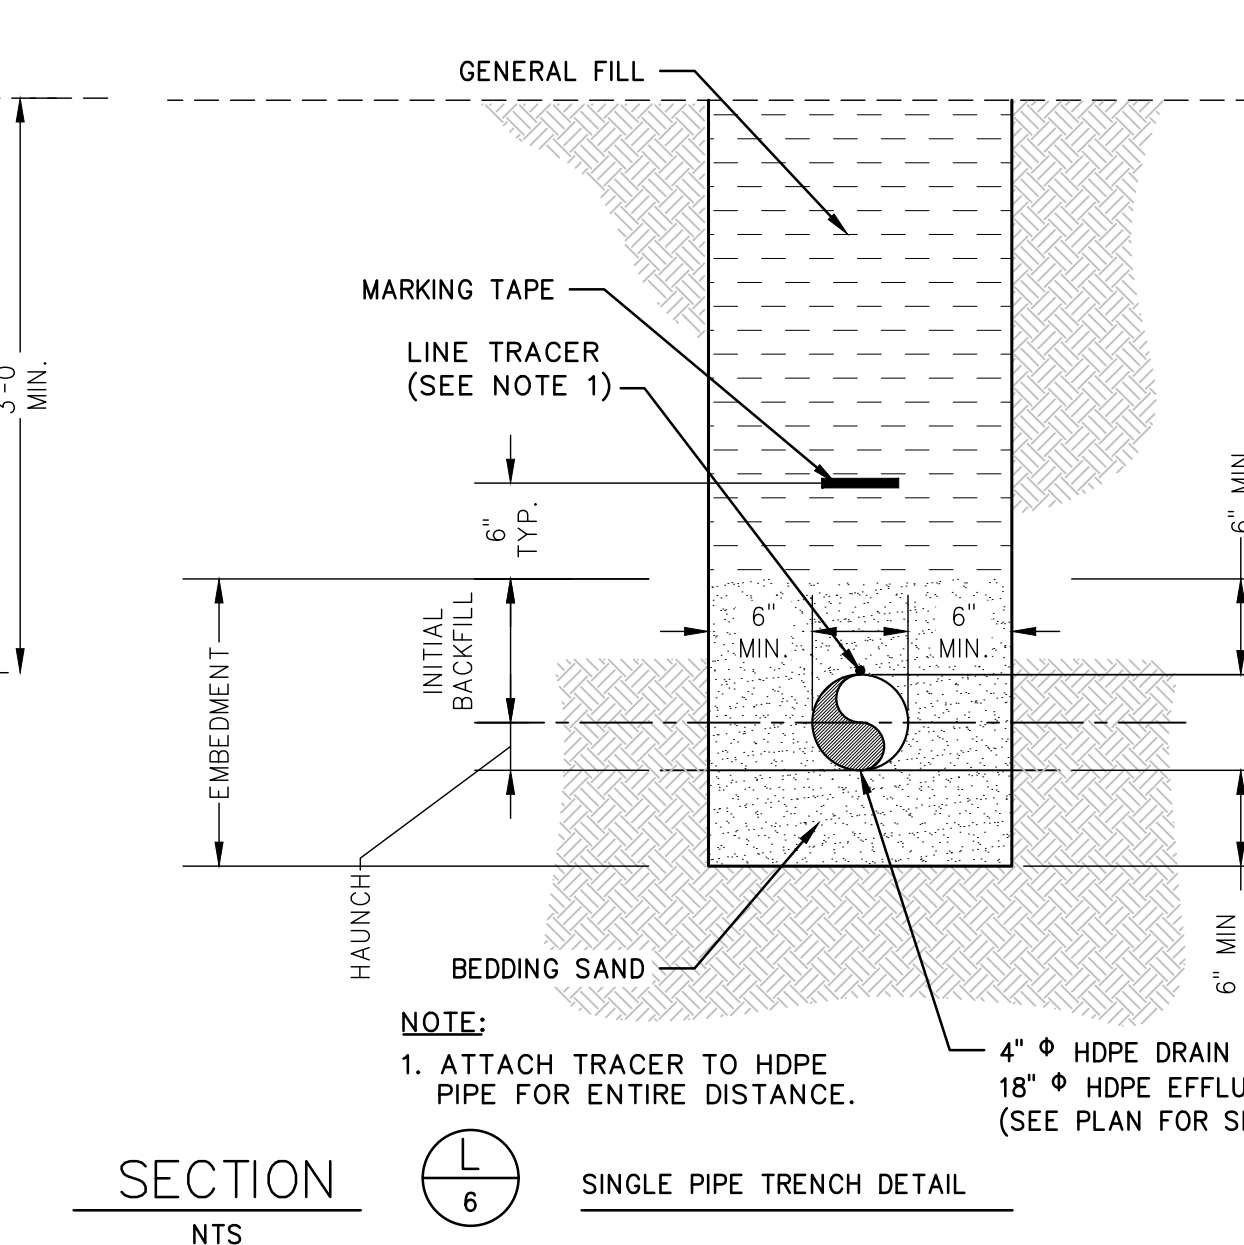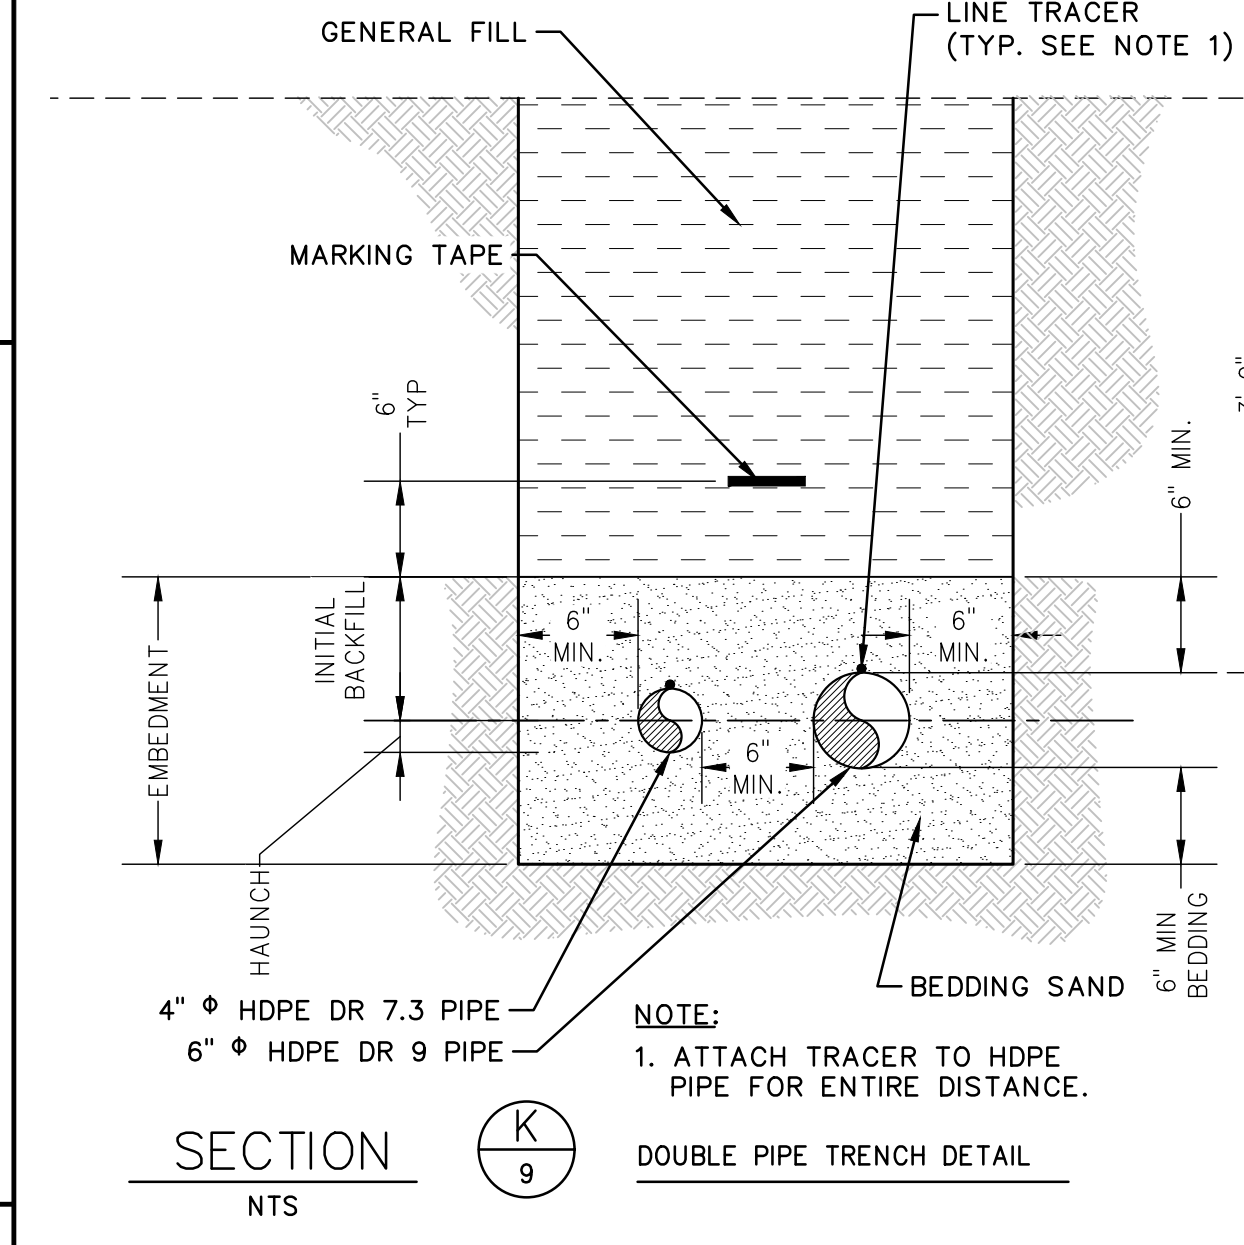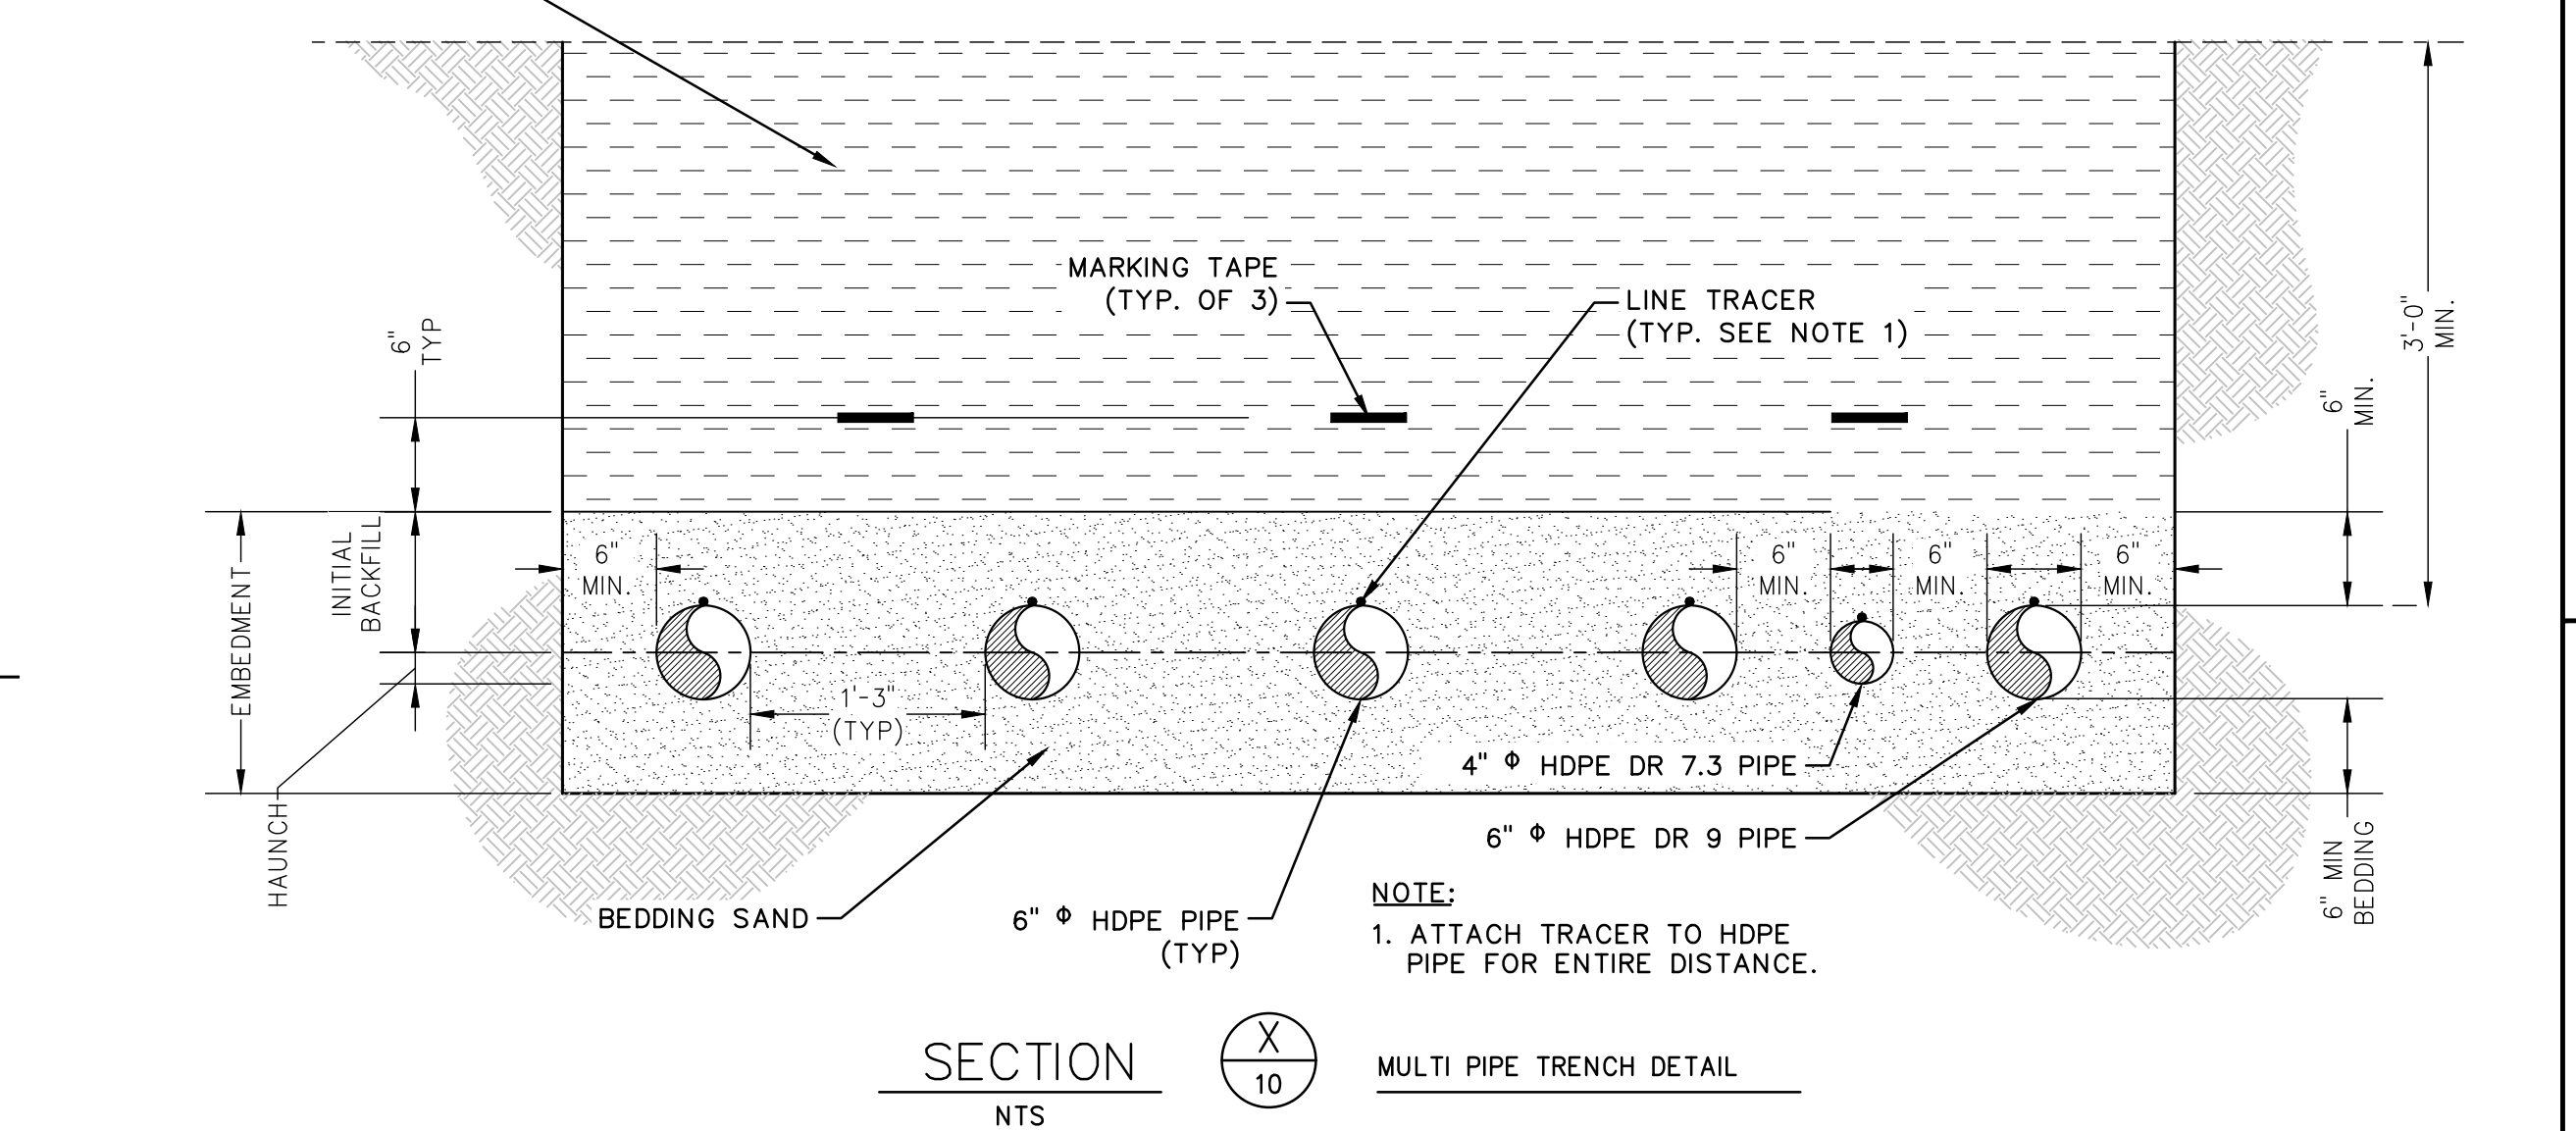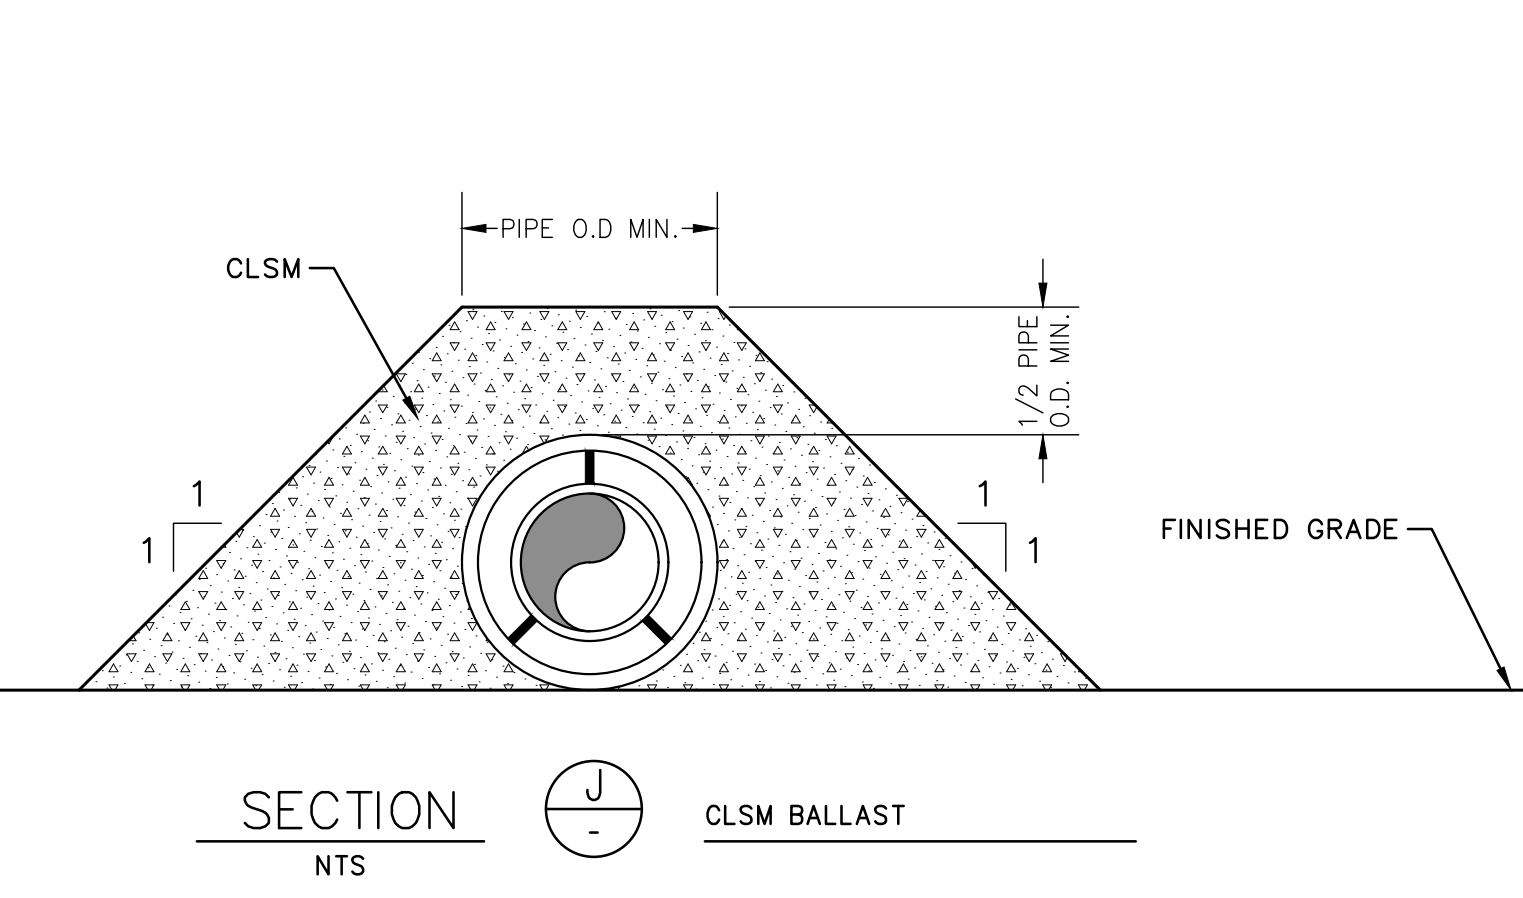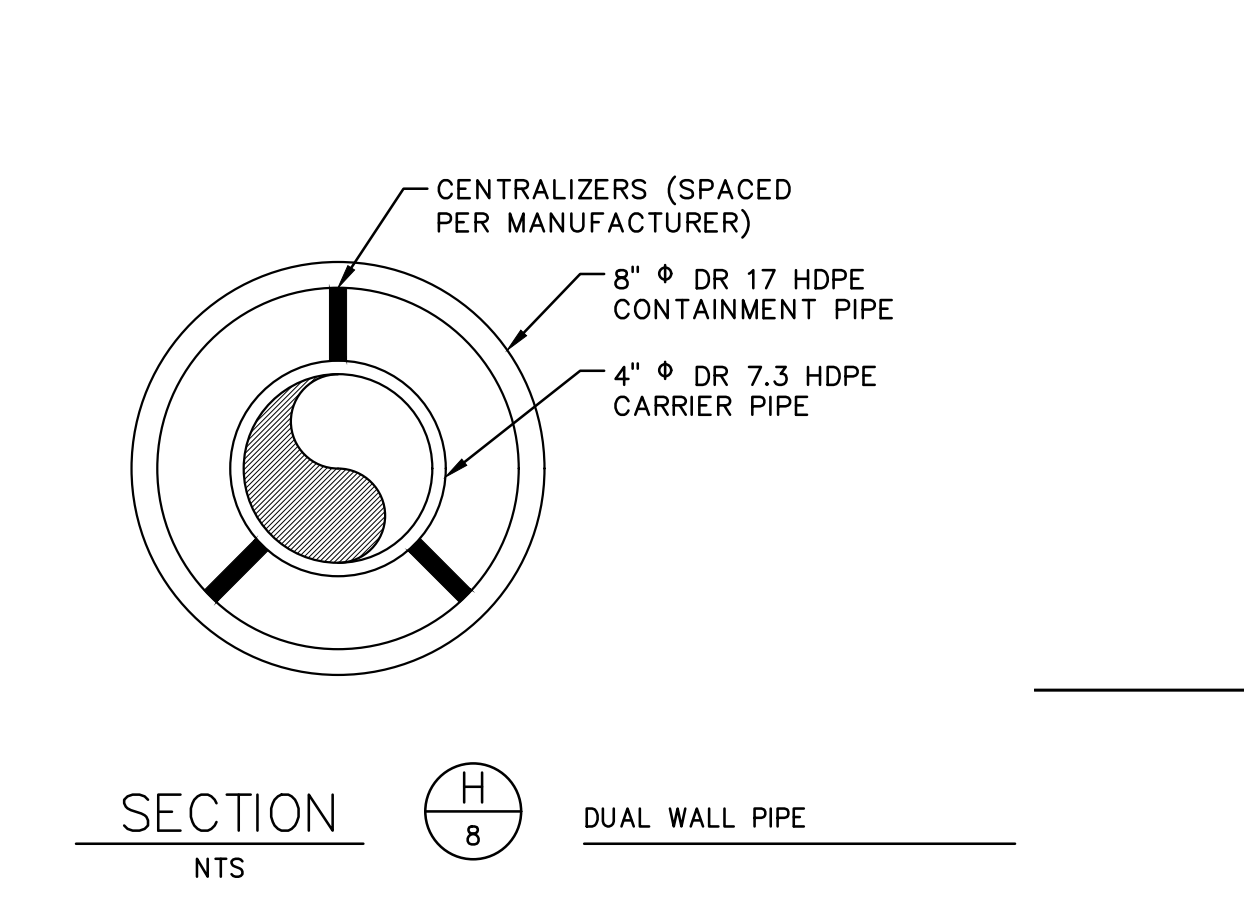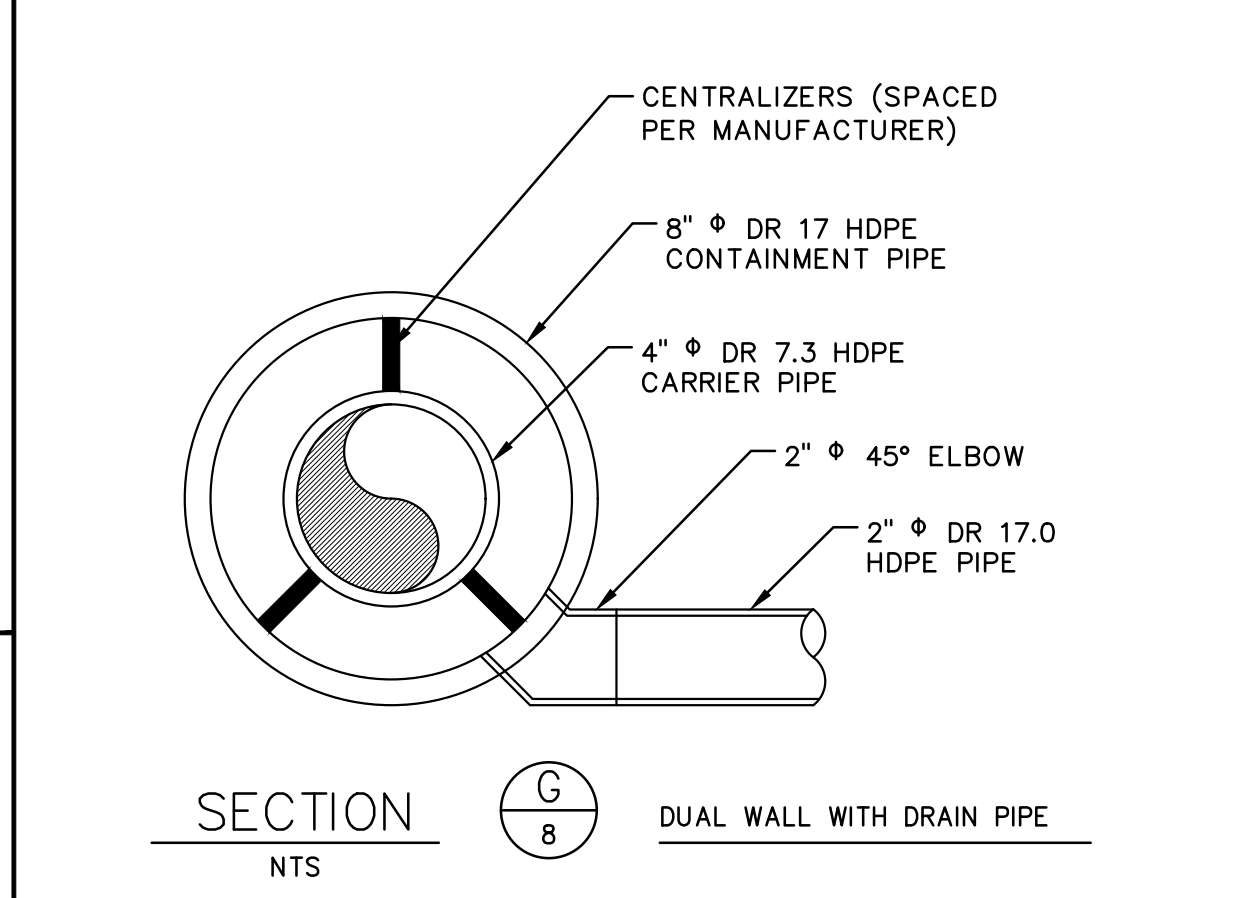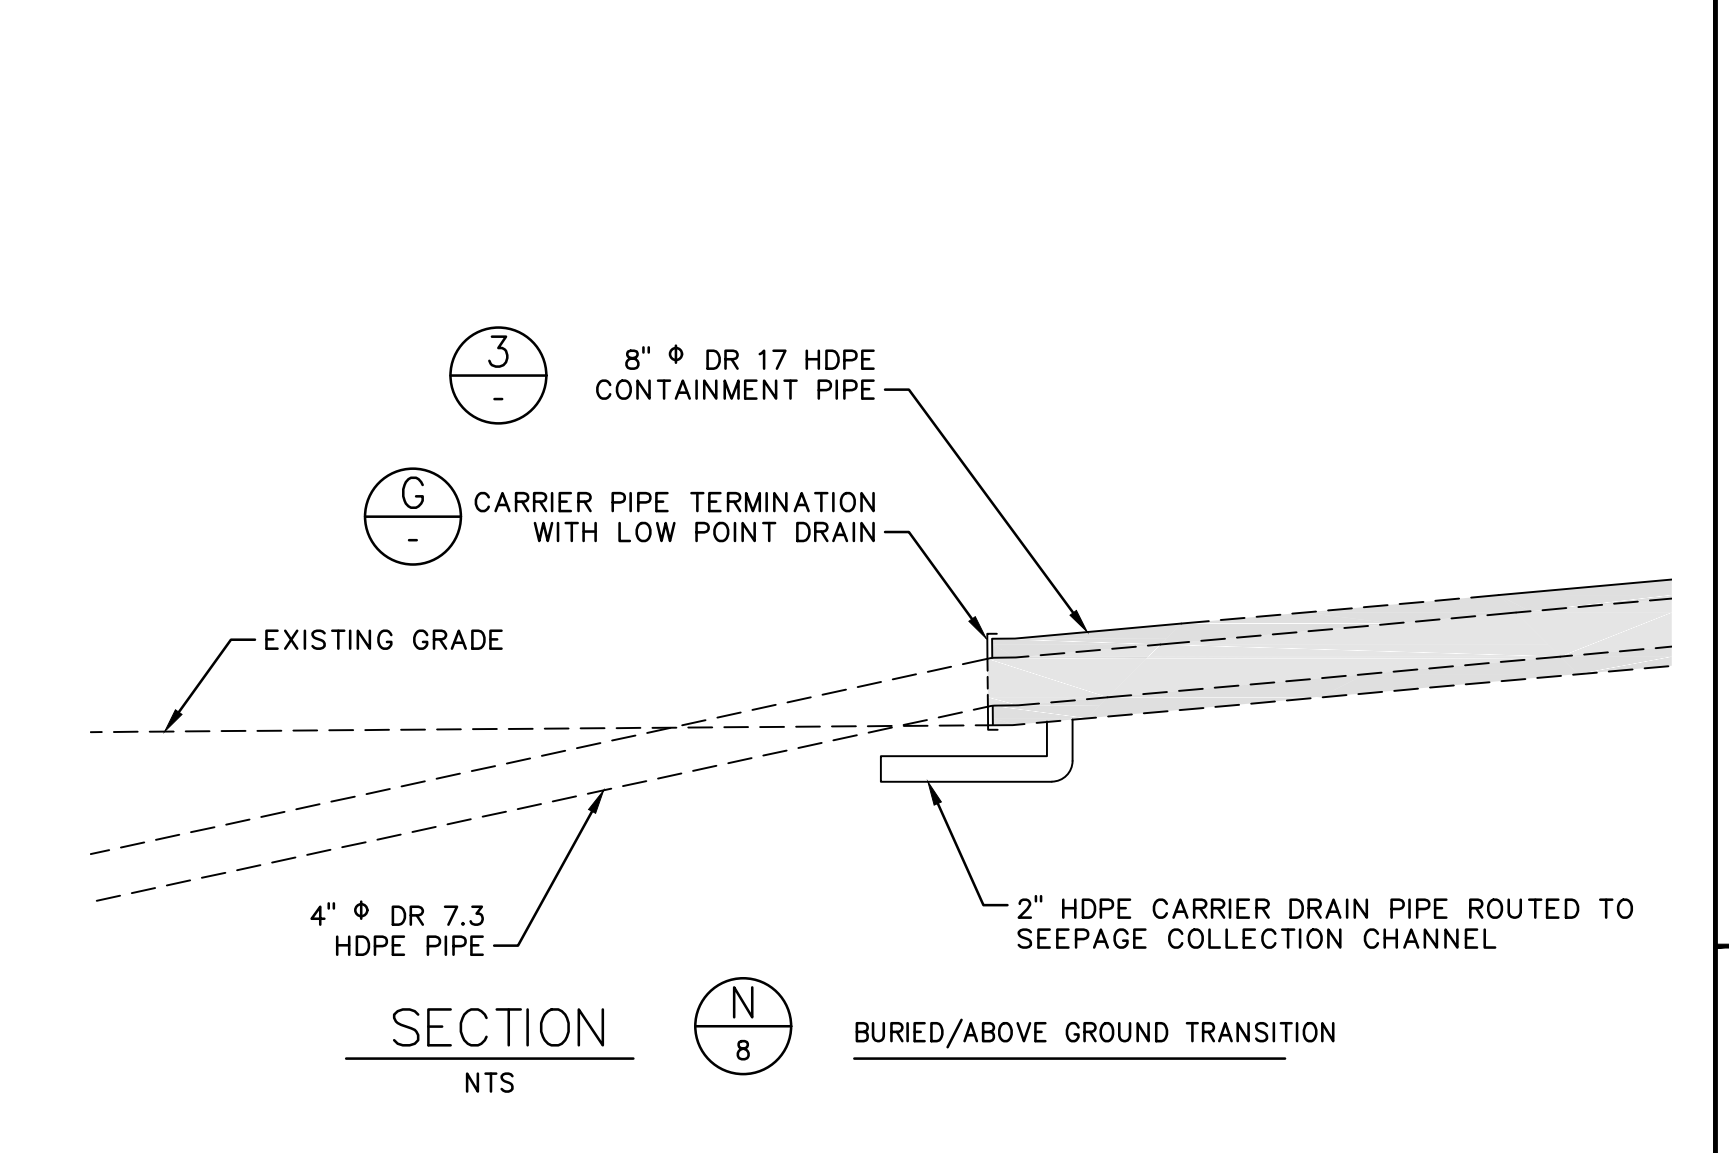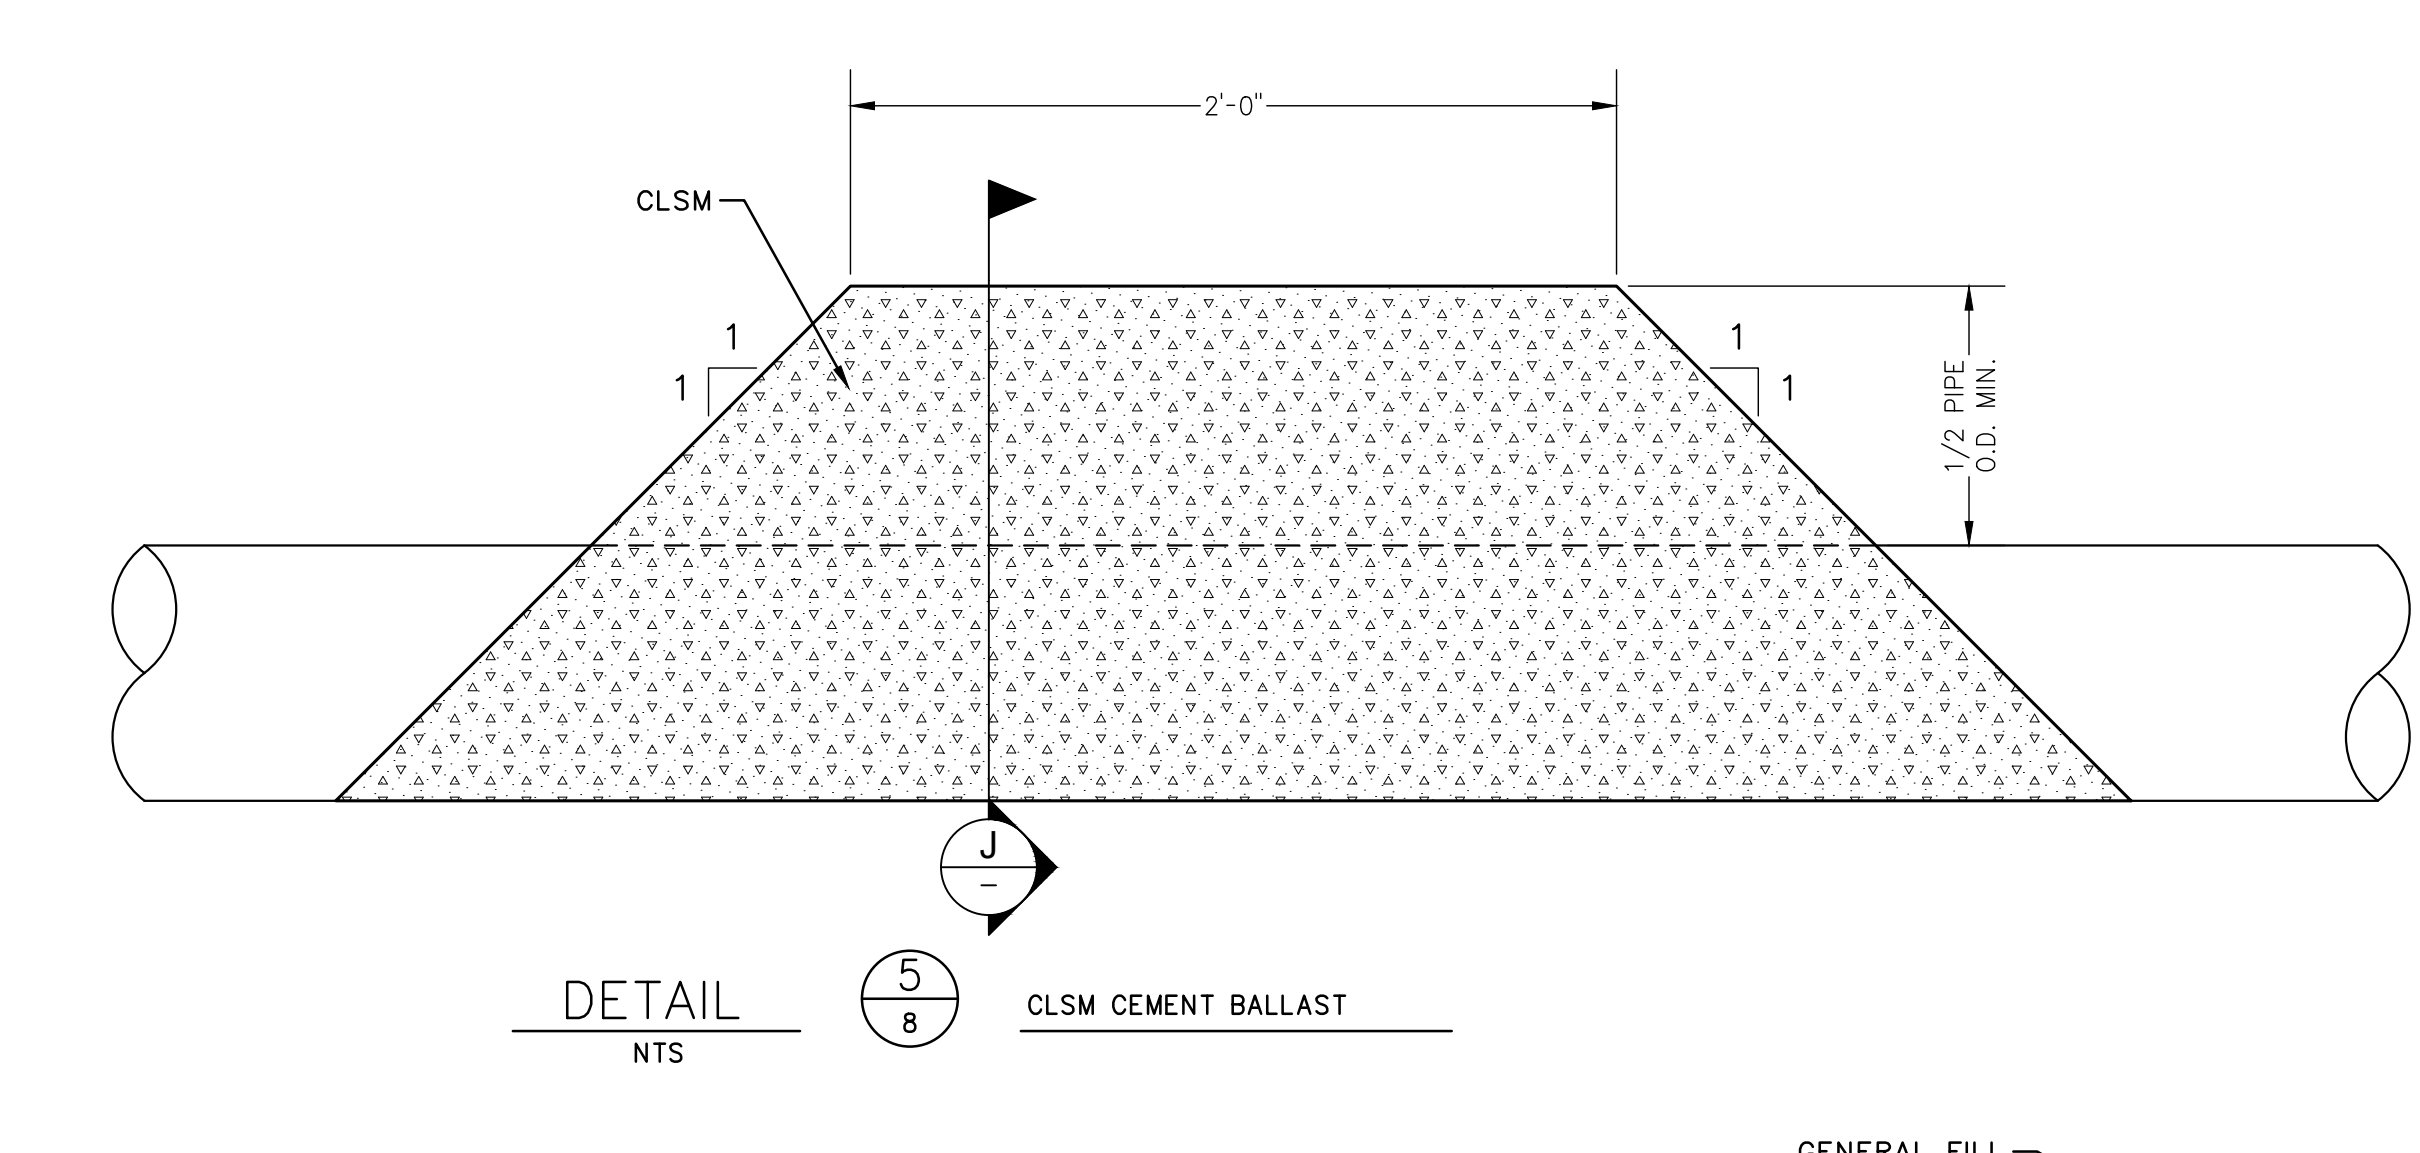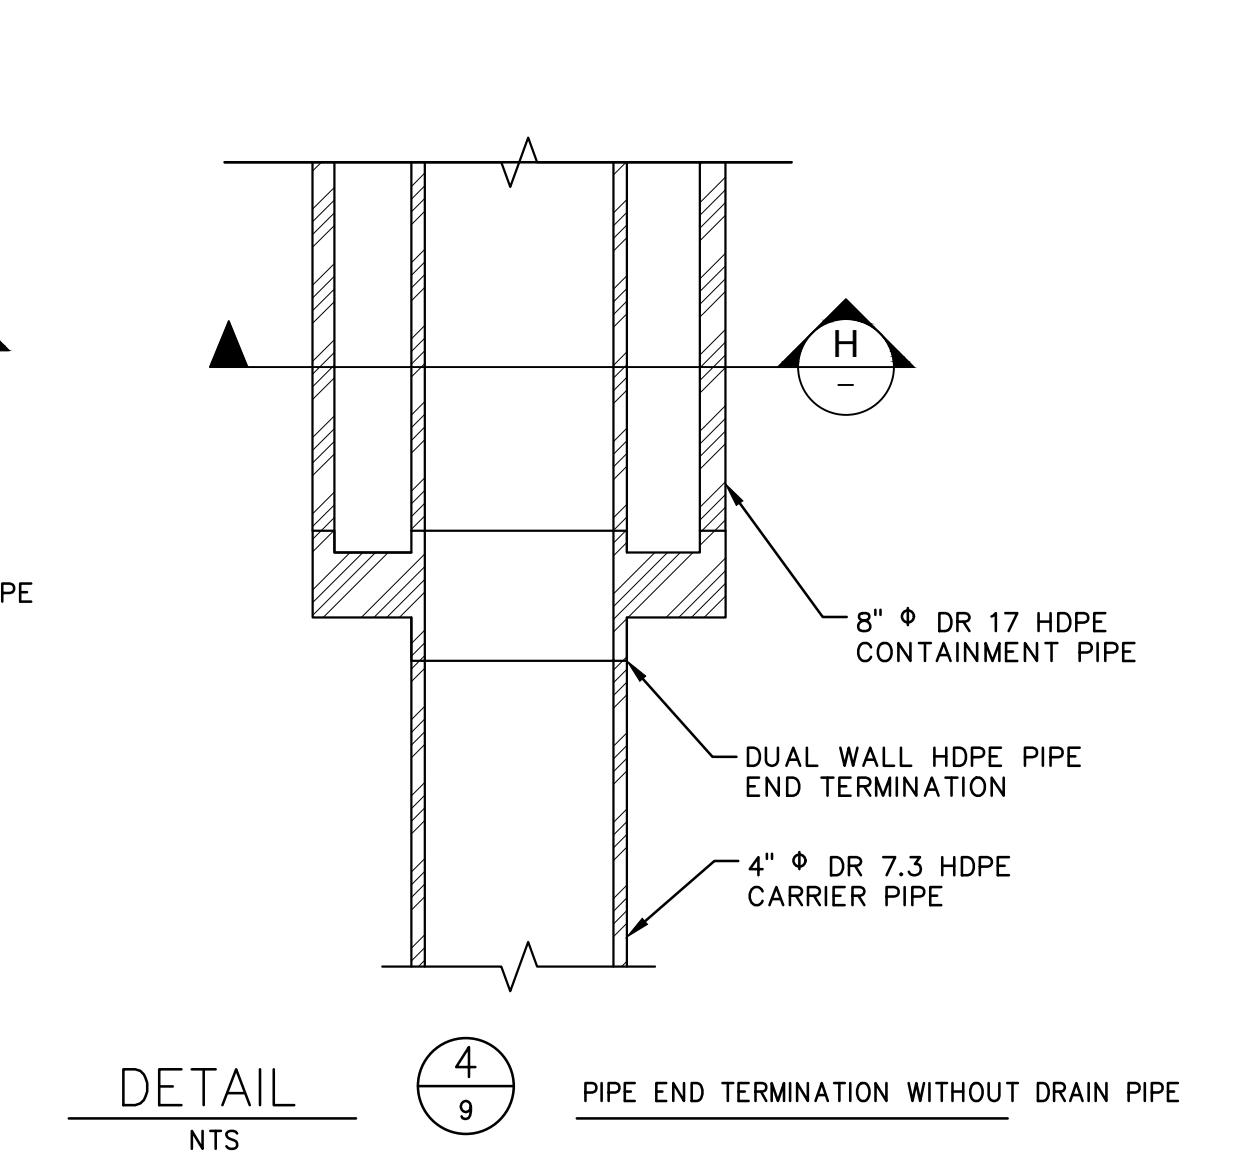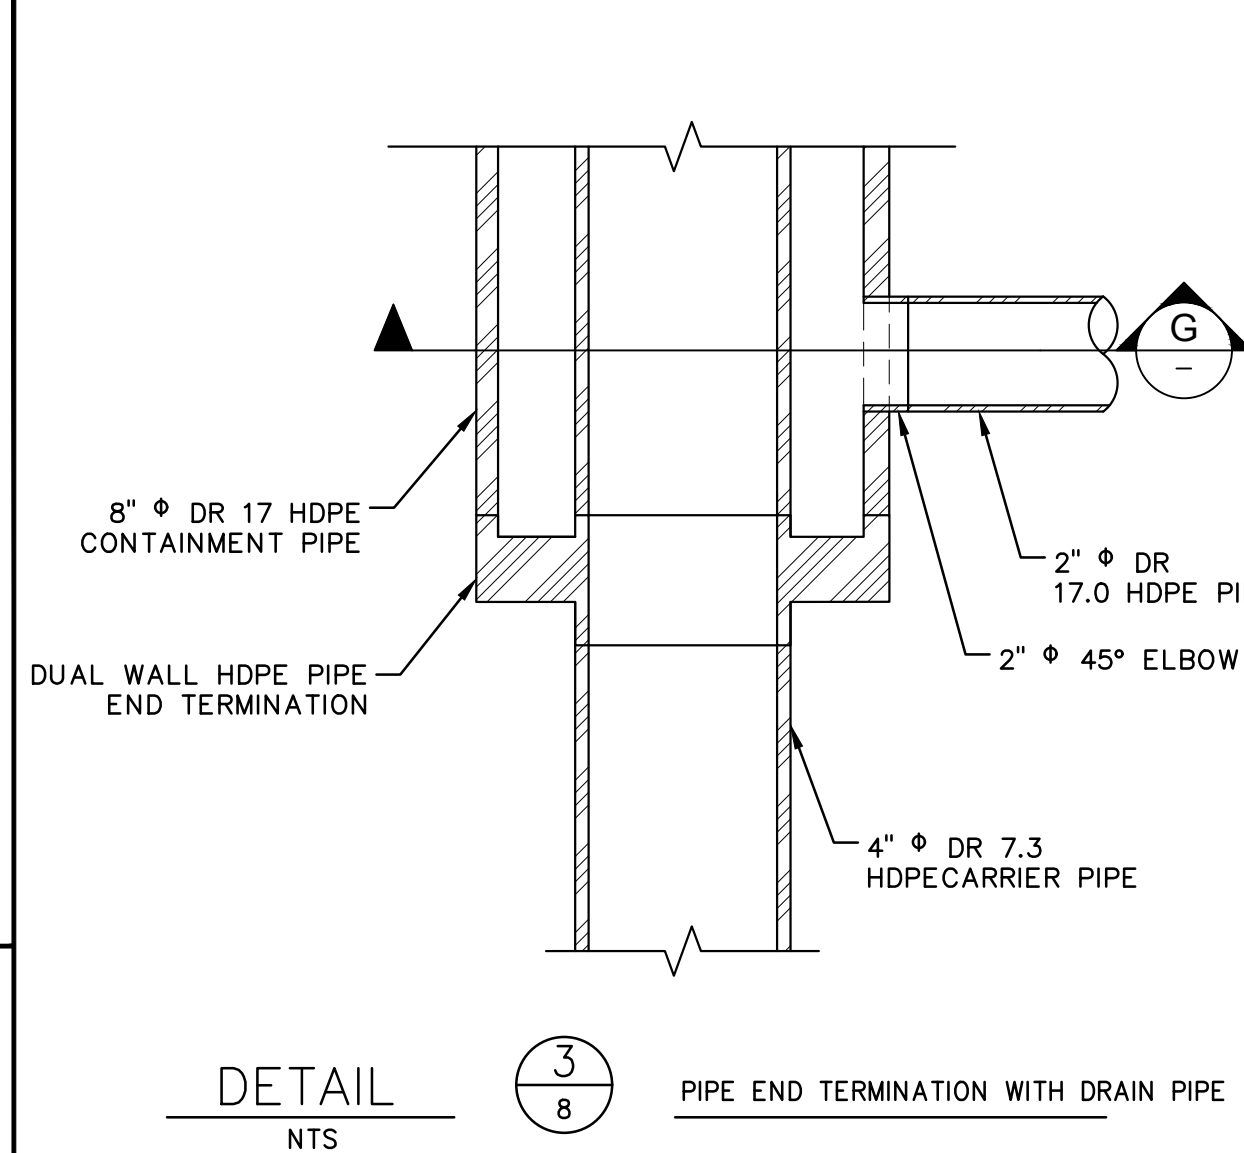

THESE RECORD DRAWINGS DATED 01/17/20 AND TITLED "FOR RECORD" HAVE BEEN DEVELOPED FROM AS-BUILT MARKUPS AND MAY NOT REPRESENT THE FINAL PROJECT, AS CONSTRUCTED, IN EVERY DETAIL. THESE RECORD DRAWINGS HAVE BEEN PREPARED BASED ON INFORMATION SUPPLIED BY OTHERS AND THE ENGINEER HAS NOT VERIFIED THE ACCURACY OR COMPLETENESS OF THE INFORMATION.



WORK SAFELY TODAY


THIS DRAWING IS CONFIDENTIAL AND SHALL NOT BE USED OR REPRODUCED IN ANY PART WITHOUT WRITTEN CONSENT OF PINNACLE WEST CAPITAL CORPORATION.

1	01-17-20	FOR RECORD	AWF	DEM			FCC06814
NO.	DATE	REVISION	DWN	CHD	EXD	RWVD	APVD

FOUR CORNERS POWER PLANT
RETURN WATER POND
RETURN WATER PIPING SECTIONS AND DETAILS



SCALE AS NOTED		DATE 10/04/19	
DWN	AWF	EXD	---
CHD	DEM	RWVD	---
APPROVED		W A	
DAVID E. MICKANEN		FCC06814	
DRAWING APPROVED BY			
UNIT	DISC	TYPE	SYS
FC45CM	C	65	WP
SUBSYS	NUMBER	SHEET	
AP	200485	15	

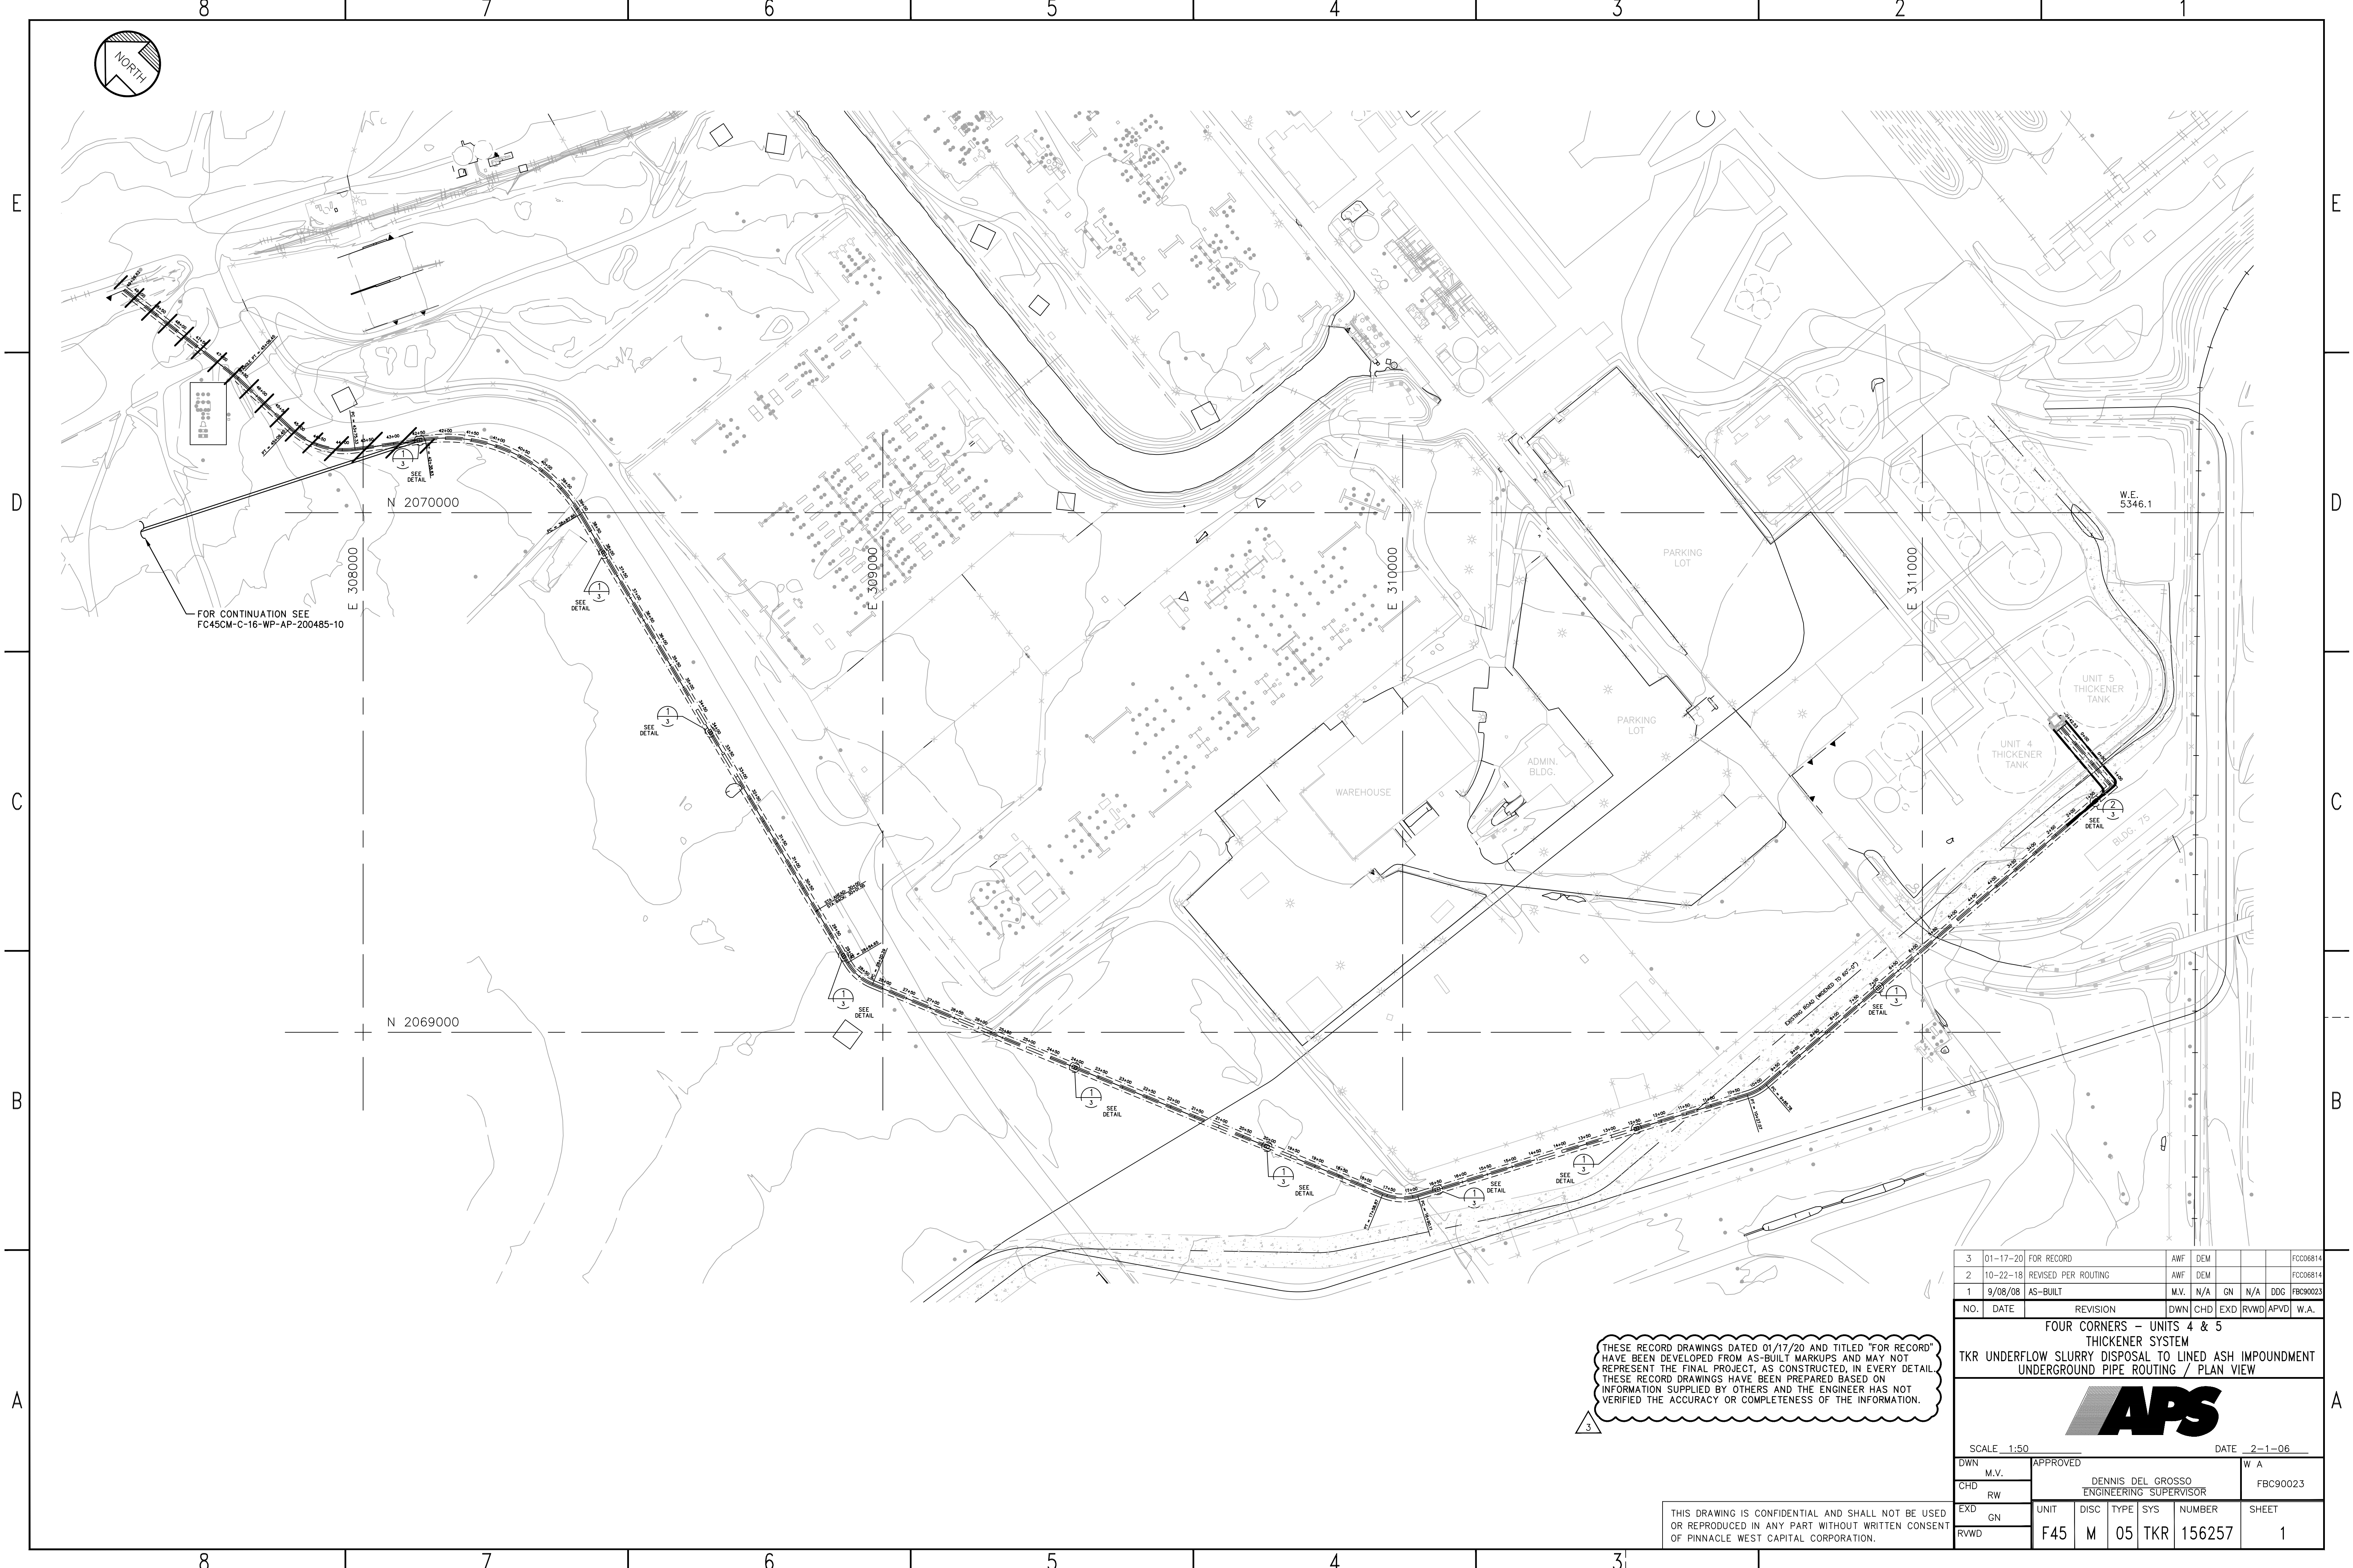

FOR CONTINUATION SEE
FC45CM-C-16-WP-AP-200485-10

THESE RECORD DRAWINGS DATED 01/17/20 AND TITLED "FOR RECORD"
HAVE BEEN DEVELOPED FROM AS-BUILT MARKUPS AND MAY NOT
REPRESENT THE FINAL PROJECT, AS CONSTRUCTED, IN EVERY DETAIL.
THESE RECORD DRAWINGS HAVE BEEN PREPARED BASED ON
INFORMATION SUPPLIED BY OTHERS AND THE ENGINEER HAS NOT
VERIFIED THE ACCURACY OR COMPLETENESS OF THE INFORMATION.


3	01-17-20	FOR RECORD	AWF	DEM				FC006814
2	10-22-18	REVISED PER ROUTING	AWF	DEM				FC006814
1	9/08/08	AS-BUILT	M.V.	N/A	GN	N/A	DDG	FBC90023
NO.	DATE	REVISION	DWN	CHD	EXD	RWVD	APVD	W.A.

FOUR CORNERS - UNITS 4 & 5
THICKENER SYSTEM
TKR UNDERFLOW SLURRY DISPOSAL TO LINED ASH IMPOUNDMENT
UNDERGROUND PIPE ROUTING / PLAN VIEW




SCALE: 1:50			DATE: 2-1-06			
DWN	M.V.	APPROVED				W A
CHD	RW	DENNIS DEL GROSSO ENGINEERING SUPERVISOR				FBC90023
EXD	GN	UNIT	DISC	TYPE	SYS	NUMBER
RWVD		F45	M	05	TKR	156257
						SHEET
						1

THIS DRAWING IS CONFIDENTIAL AND SHALL NOT BE USED
OR REPRODUCED IN ANY PART WITHOUT WRITTEN CONSENT
OF PINNACLE WEST CAPITAL CORPORATION.

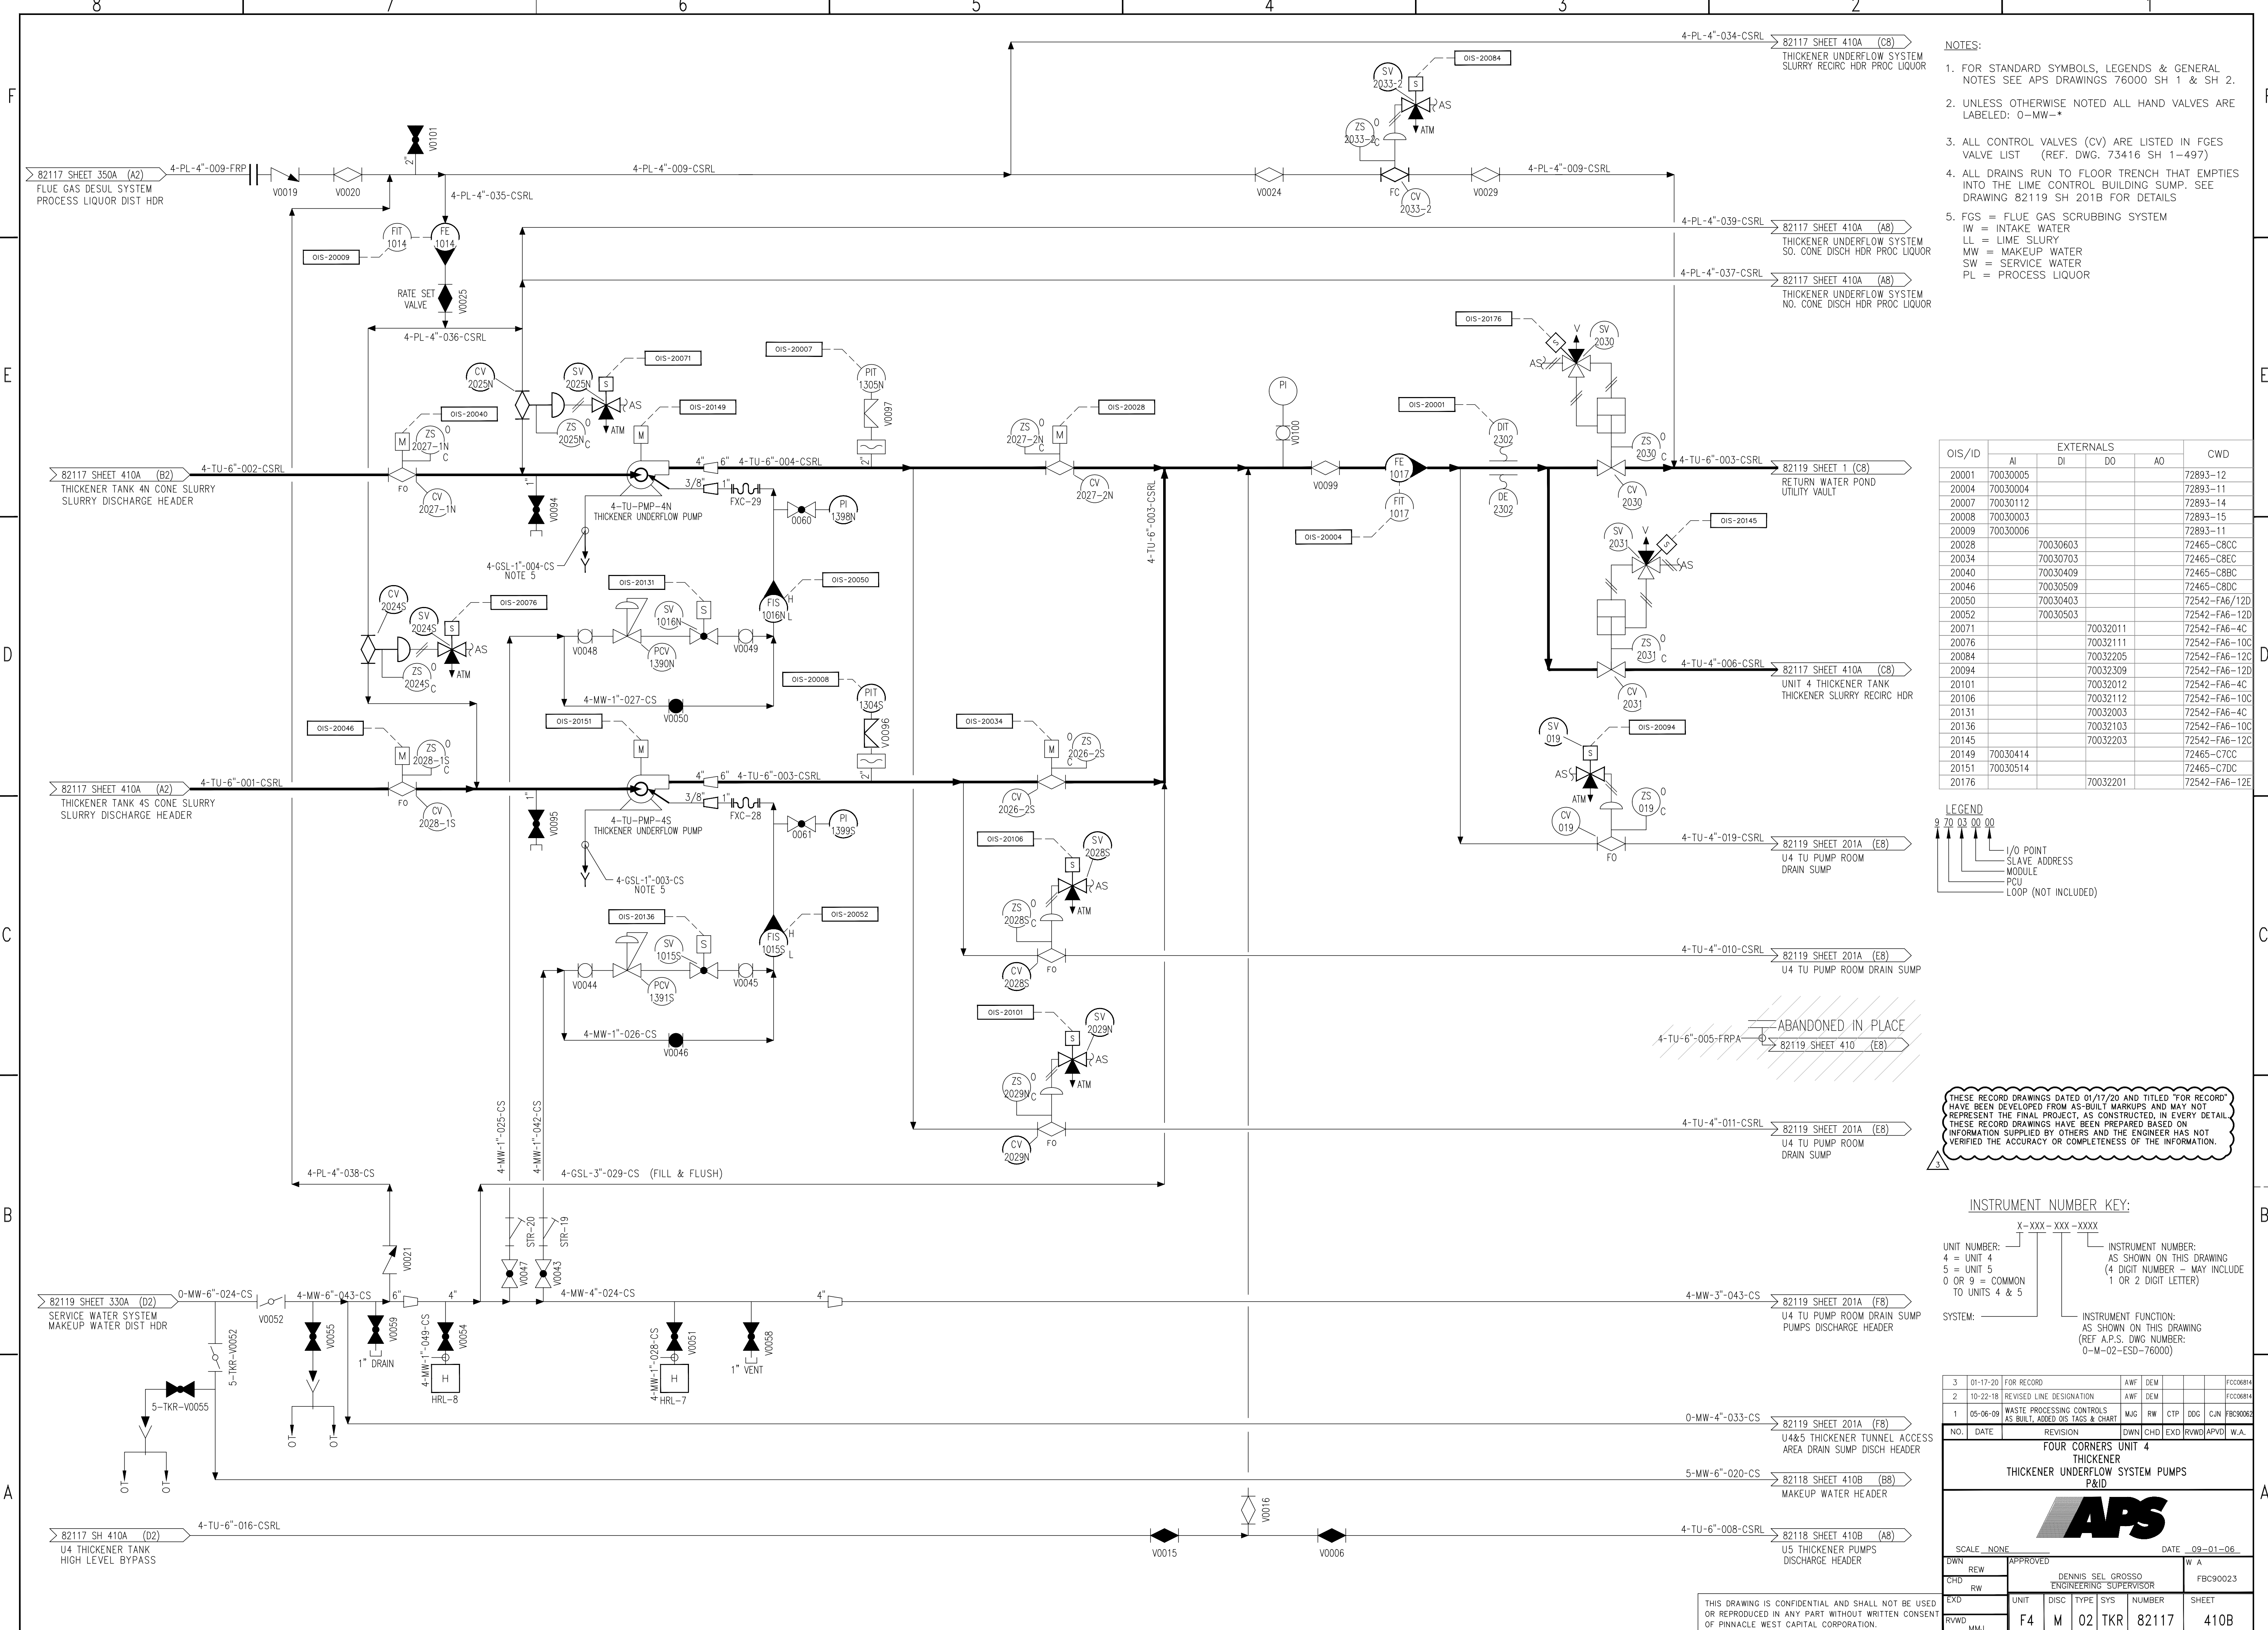

- NOTES:
- FOR STANDARD SYMBOLS, LEGENDS & GENERAL NOTES SEE APS DRAWINGS 76000 SH 1 & SH 2.
 - UNLESS OTHERWISE NOTED ALL HAND VALVES ARE LABELED: 0-MW-*
 - ALL CONTROL VALVES (CV) ARE LISTED IN FGES VALVE LIST (REF. DWG. 73416 SH 1-497)
 - ALL DRAINS RUN TO FLOOR TRENCH THAT EMPTIES INTO THE LIME CONTROL BUILDING SUMP. SEE DRAWING 82119 SH 201B FOR DETAILS
 - FGS = FLUE GAS SCRUBBING SYSTEM
IW = INTAKE WATER
LL = LIME SLURRY
MW = MAKEUP WATER
SW = SERVICE WATER
PL = PROCESS LIQUOR

OIS/ID	EXTERNALS				CWD
	AI	DI	DO	A0	
20001	70030005				72893-12
20004	70030004				72893-11
20007	70030112				72893-14
20008	70030003				72893-15
20009	70030006				72893-11
20028		70030603			72465-C8CC
20034		70030703			72465-C8EC
20040		70030409			72465-C8BC
20046		70030509			72465-C8DC
20050		70030403			72542-FA6/12D
20052		70030503			72542-FA6-12D
20071			70032011		72542-FA6-4C
20076			70032111		72542-FA6-10C
20084			70032205		72542-FA6-12C
20094			70032309		72542-FA6-12D
20101			70032012		72542-FA6-4C
20106			70032112		72542-FA6-10C
20131			70032003		72542-FA6-4C
20136			70032103		72542-FA6-10C
20145			70032203		72542-FA6-12C
20149	70030414				72465-C7CC
20151	70030514				72465-C7DC
20176			70032201		72542-FA6-12E

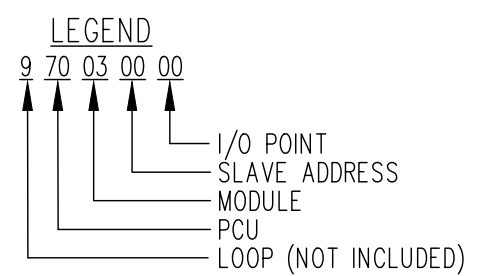

THESE RECORD DRAWINGS DATED 01/17/20 AND TITLED "FOR RECORD" HAVE BEEN DEVELOPED FROM AS-BUILT MARKUPS AND MAY NOT REPRESENT THE FINAL PROJECT AS CONSTRUCTED. IN EVERY DETAIL THESE RECORD DRAWINGS HAVE BEEN PREPARED BASED ON INFORMATION SUPPLIED BY OTHERS AND THE ENGINEER HAS NOT VERIFIED THE ACCURACY OR COMPLETENESS OF THE INFORMATION.

INSTRUMENT NUMBER KEY:

UNIT NUMBER: X-XXX-XXX-XXXX
 4 = UNIT 4
 5 = UNIT 5
 0 OR 9 = COMMON TO UNITS 4 & 5

INSTRUMENT NUMBER: AS SHOWN ON THIS DRAWING
 (4 DIGIT NUMBER - MAY INCLUDE 1 OR 2 DIGIT LETTER)


SYSTEM: INSTRUMENT FUNCTION: AS SHOWN ON THIS DRAWING (REF A.P.S. DWG NUMBER: 0-M-02-ESD-76000)

NO.	DATE	REVISION	DWN	CHD	EXD	RWD	APV	W.A.
3	01-17-20	FOR RECORD	AWF	DEM				FC00684
2	10-22-18	REVISED LINE DESIGNATION	AWF	DEM				FC00684
1	05-06-09	WASTE PROCESSING CONTROLS AS BUILT, ADDED OIS TAGS & CHART	MJG	RW	CTP	DDG	CJN	FBC9000

FOUR CORNERS UNIT 4 THICKENER UNDERFLOW SYSTEM PUMPS P&ID


SCALE: NONE DATE: 09-01-06

DWN	REV	APPROVED	W A
CHD	RW	DENNIS SEL GROSSO ENGINEERING SUPERVISOR	FBC90023
EXD	UNIT	DISC	TYPE
RWD	MMJ	F4	M 02 TKR
			NUMBER
			82117
			SHEET
			410B

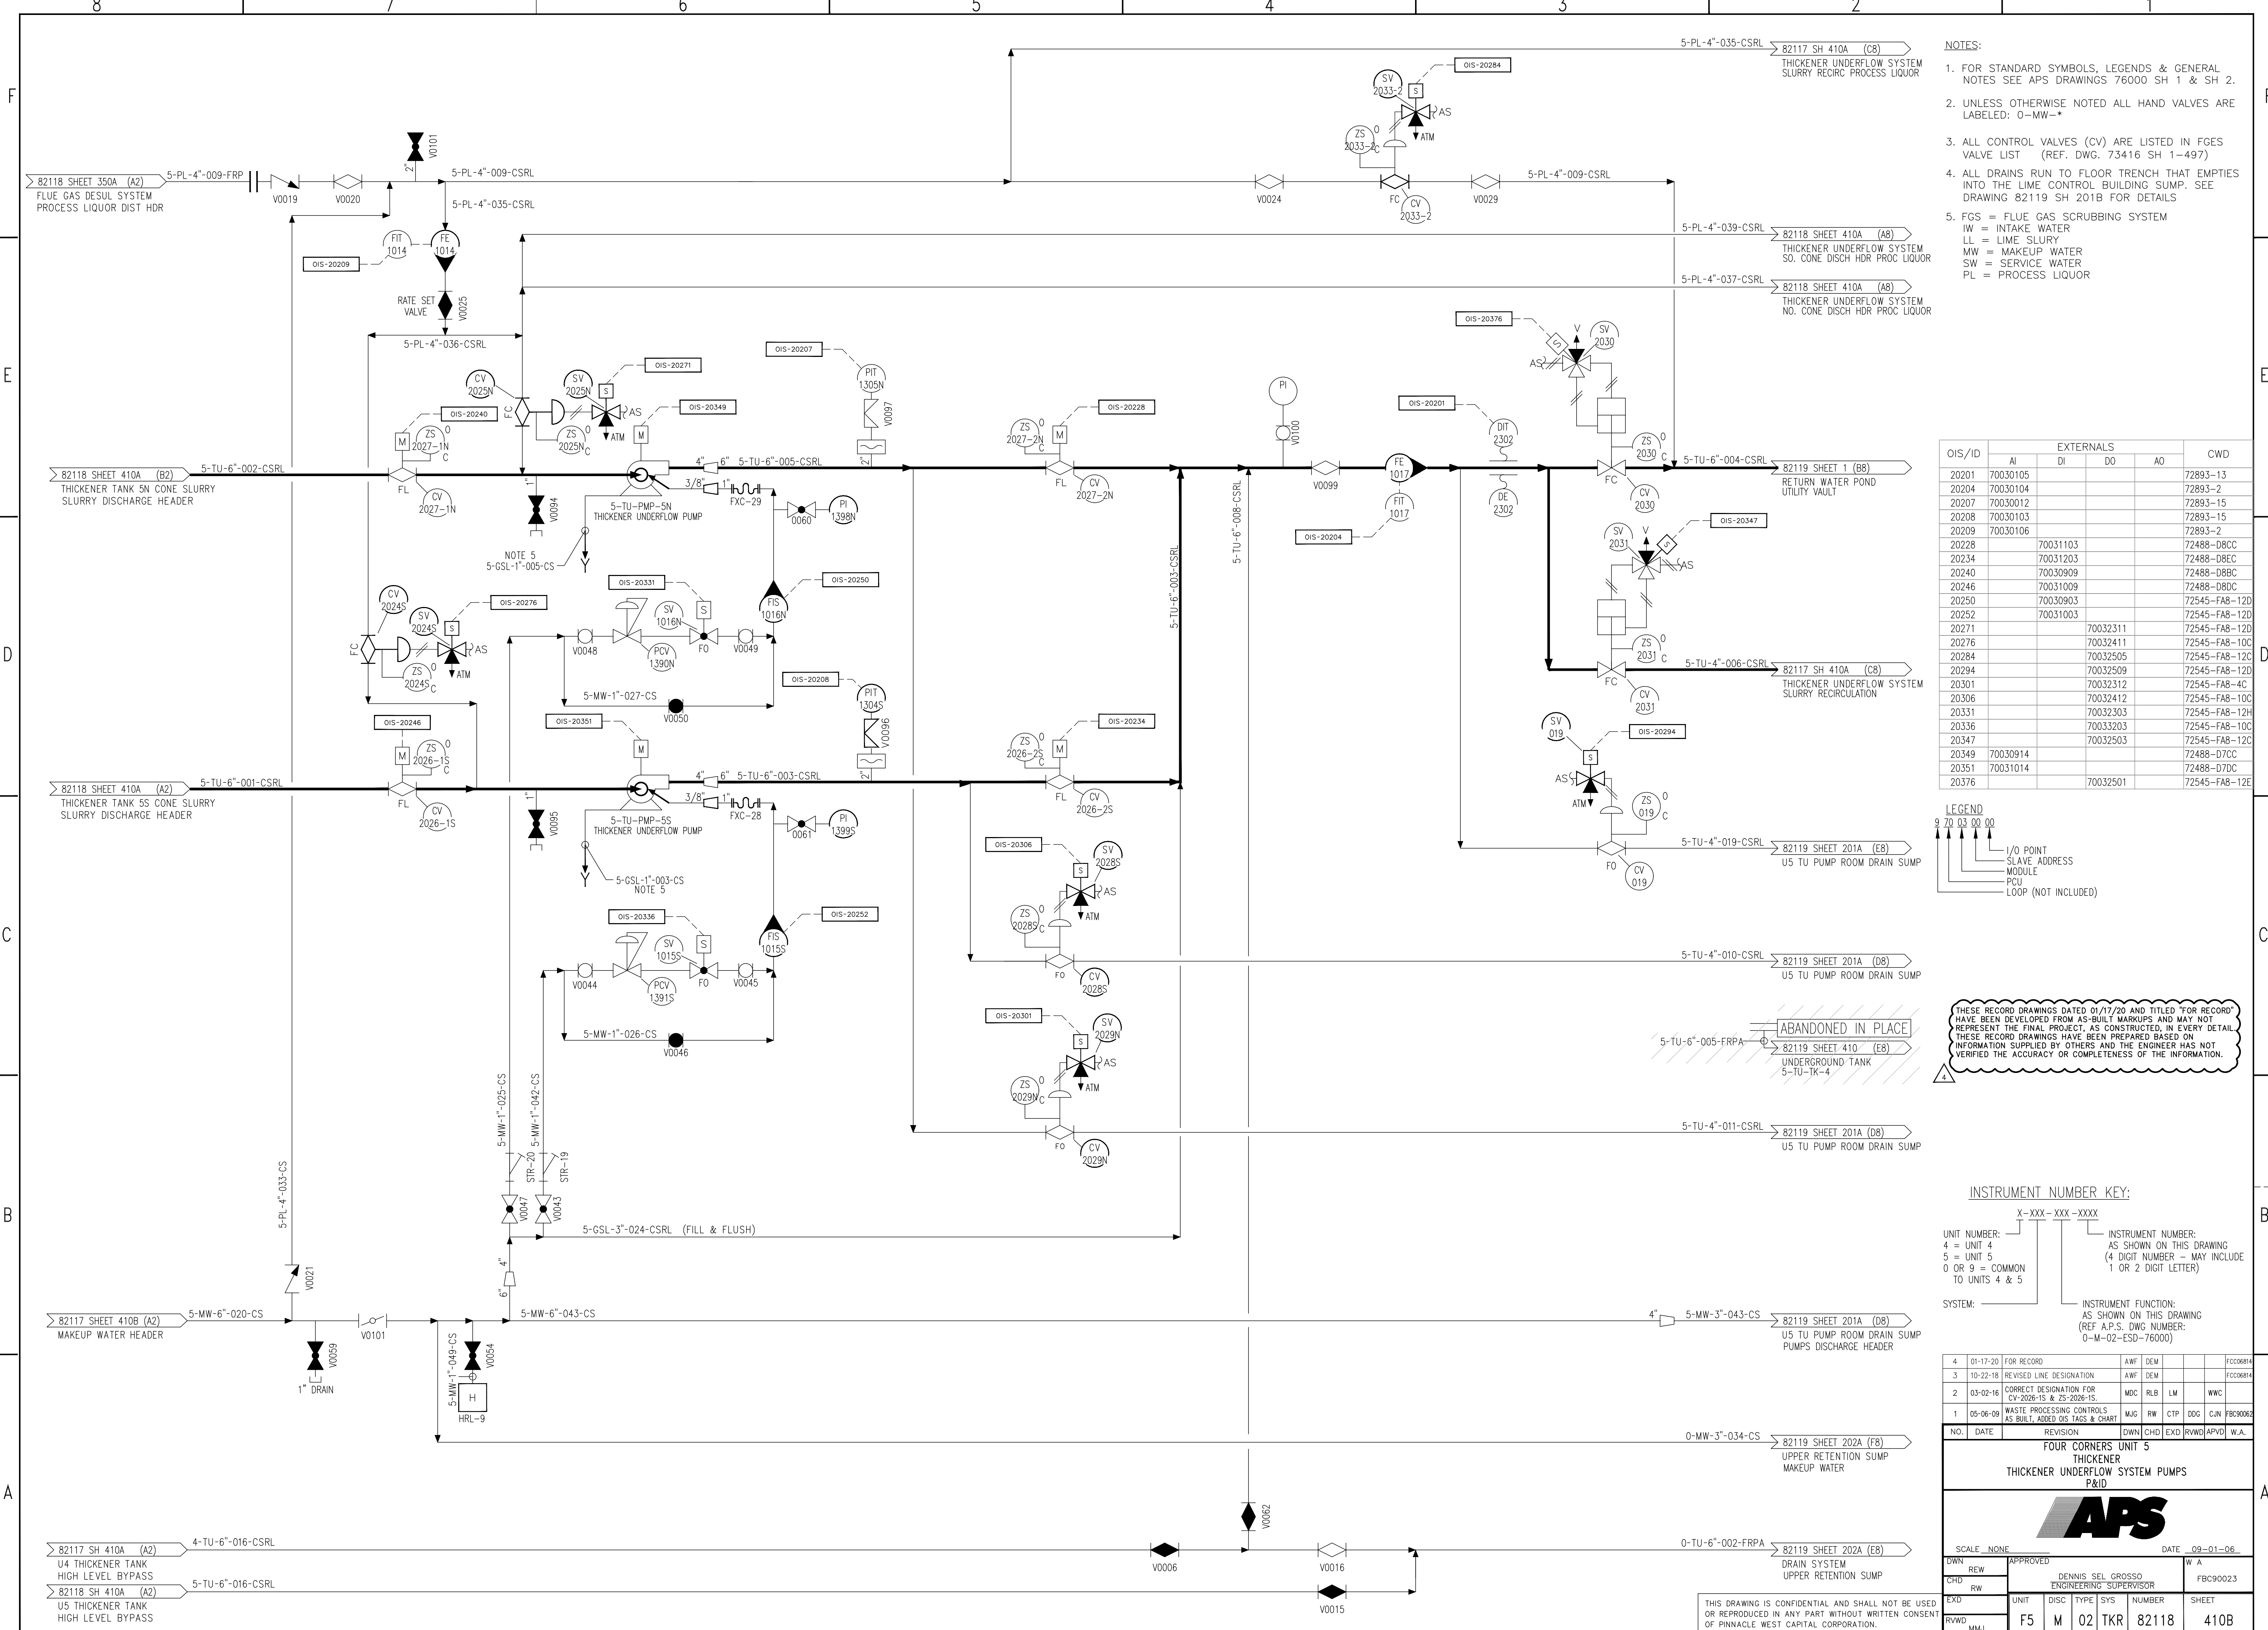

- NOTES:
- FOR STANDARD SYMBOLS, LEGENDS & GENERAL NOTES SEE APS DRAWINGS 76000 SH 1 & SH 2.
 - UNLESS OTHERWISE NOTED ALL HAND VALVES ARE LABELED: 0-MW-*
 - ALL CONTROL VALVES (CV) ARE LISTED IN FGES VALVE LIST (REF. DWG. 73416 SH 1-497)
 - ALL DRAINS RUN TO FLOOR TRENCH THAT EMPTIES INTO THE LIME CONTROL BUILDING SUMP. SEE DRAWING 82119 SH 201B FOR DETAILS
 - FGS = FLUE GAS SCRUBBING SYSTEM
IW = INTAKE WATER
LL = LIME SLURRY
MW = MAKEUP WATER
SW = SERVICE WATER
PL = PROCESS LIQUOR

OIS/ID	EXTERNALS				CWD
	AI	DI	DO	AO	
20201	70030105				72893-13
20204	70030104				72893-2
20207	70030012				72893-15
20208	70030103				72893-15
20209	70030106				72893-2
20228		70031103			72488-D8CC
20234		70031203			72488-D8EC
20240		70030909			72488-D8BC
20246		70031009			72488-D8DC
20250		70030903			72545-F8-12D
20252		70031003			72545-F8-12D
20271			70032311		72545-F8-12D
20276			70032411		72545-F8-10C
20284			70032505		72545-F8-12C
20294			70032509		72545-F8-12D
20301			70032312		72545-F8-4C
20306			70032412		72545-F8-10C
20331			70032303		72545-F8-12H
20336			70032303		72545-F8-10C
20347			70032503		72545-F8-12C
20349	70030914				72488-D7CC
20351	70031014				72488-D7DC
20376			70032501		72545-F8-12E

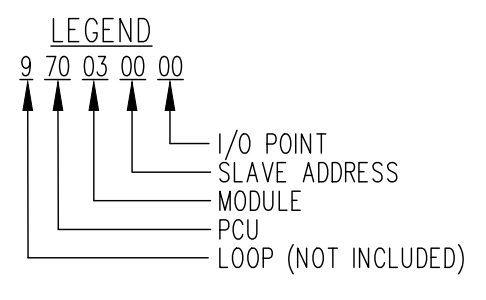

THESE RECORD DRAWINGS DATED 01/17/20 AND TITLED "FOR RECORD" HAVE BEEN DEVELOPED FROM AS-BUILT MARKUPS AND MAY NOT REPRESENT THE FINAL PROJECT, AS CONSTRUCTED, IN EVERY DETAIL. THESE RECORD DRAWINGS HAVE BEEN PREPARED BASED ON INFORMATION SUPPLIED BY OTHERS AND THE ENGINEER HAS NOT VERIFIED THE ACCURACY OR COMPLETENESS OF THE INFORMATION.

INSTRUMENT NUMBER KEY:

UNIT NUMBER:
 4 = UNIT 4
 5 = UNIT 5
 0 OR 9 = COMMON TO UNITS 4 & 5

SYSTEM: _____

INSTRUMENT NUMBER:
 AS SHOWN ON THIS DRAWING
 (4 DIGIT NUMBER - MAY INCLUDE 1 OR 2 DIGIT LETTER)

INSTRUMENT FUNCTION:
 AS SHOWN ON THIS DRAWING
 (REF A.P.S. DWG NUMBER:
 0-M-02-ESD-76000)

NO.	DATE	REVISION	DWN	CHD	EXD	RWD	APVD	W.A.
4	01-17-20	FOR RECORD		ANF	DEM			fcc0884
3	10-22-18	REVISED LINE DESIGNATION		ANF	DEM			fcc0884
2	03-02-18	CORRECT DESIGNATION FOR CV-2026-1S & ZS-2026-1S		MDC	RLB	LM		WNC
1	05-06-09	WASTE PROCESSING CONTROLS AS BUILT, ADDED OIS TAGS & CHART		MUG	RW	CTP	DDG	CJN FBC0006


FOUR CORNERS UNIT 5
THICKENER
THICKENER UNDERFLOW SYSTEM PUMPS
P&ID

SCALE: NONE DATE: 09-01-06

APPROVED: DENNIS SEL GROSSO
ENGINEERING SUPERVISOR

EXD UNIT DISC TYPE SYS NUMBER SHEET
 F5 M 02 TKR 82118 410B

THIS DRAWING IS CONFIDENTIAL AND SHALL NOT BE USED OR REPRODUCED IN ANY PART WITHOUT WRITTEN CONSENT OF PINNACLE WEST CAPITAL CORPORATION.

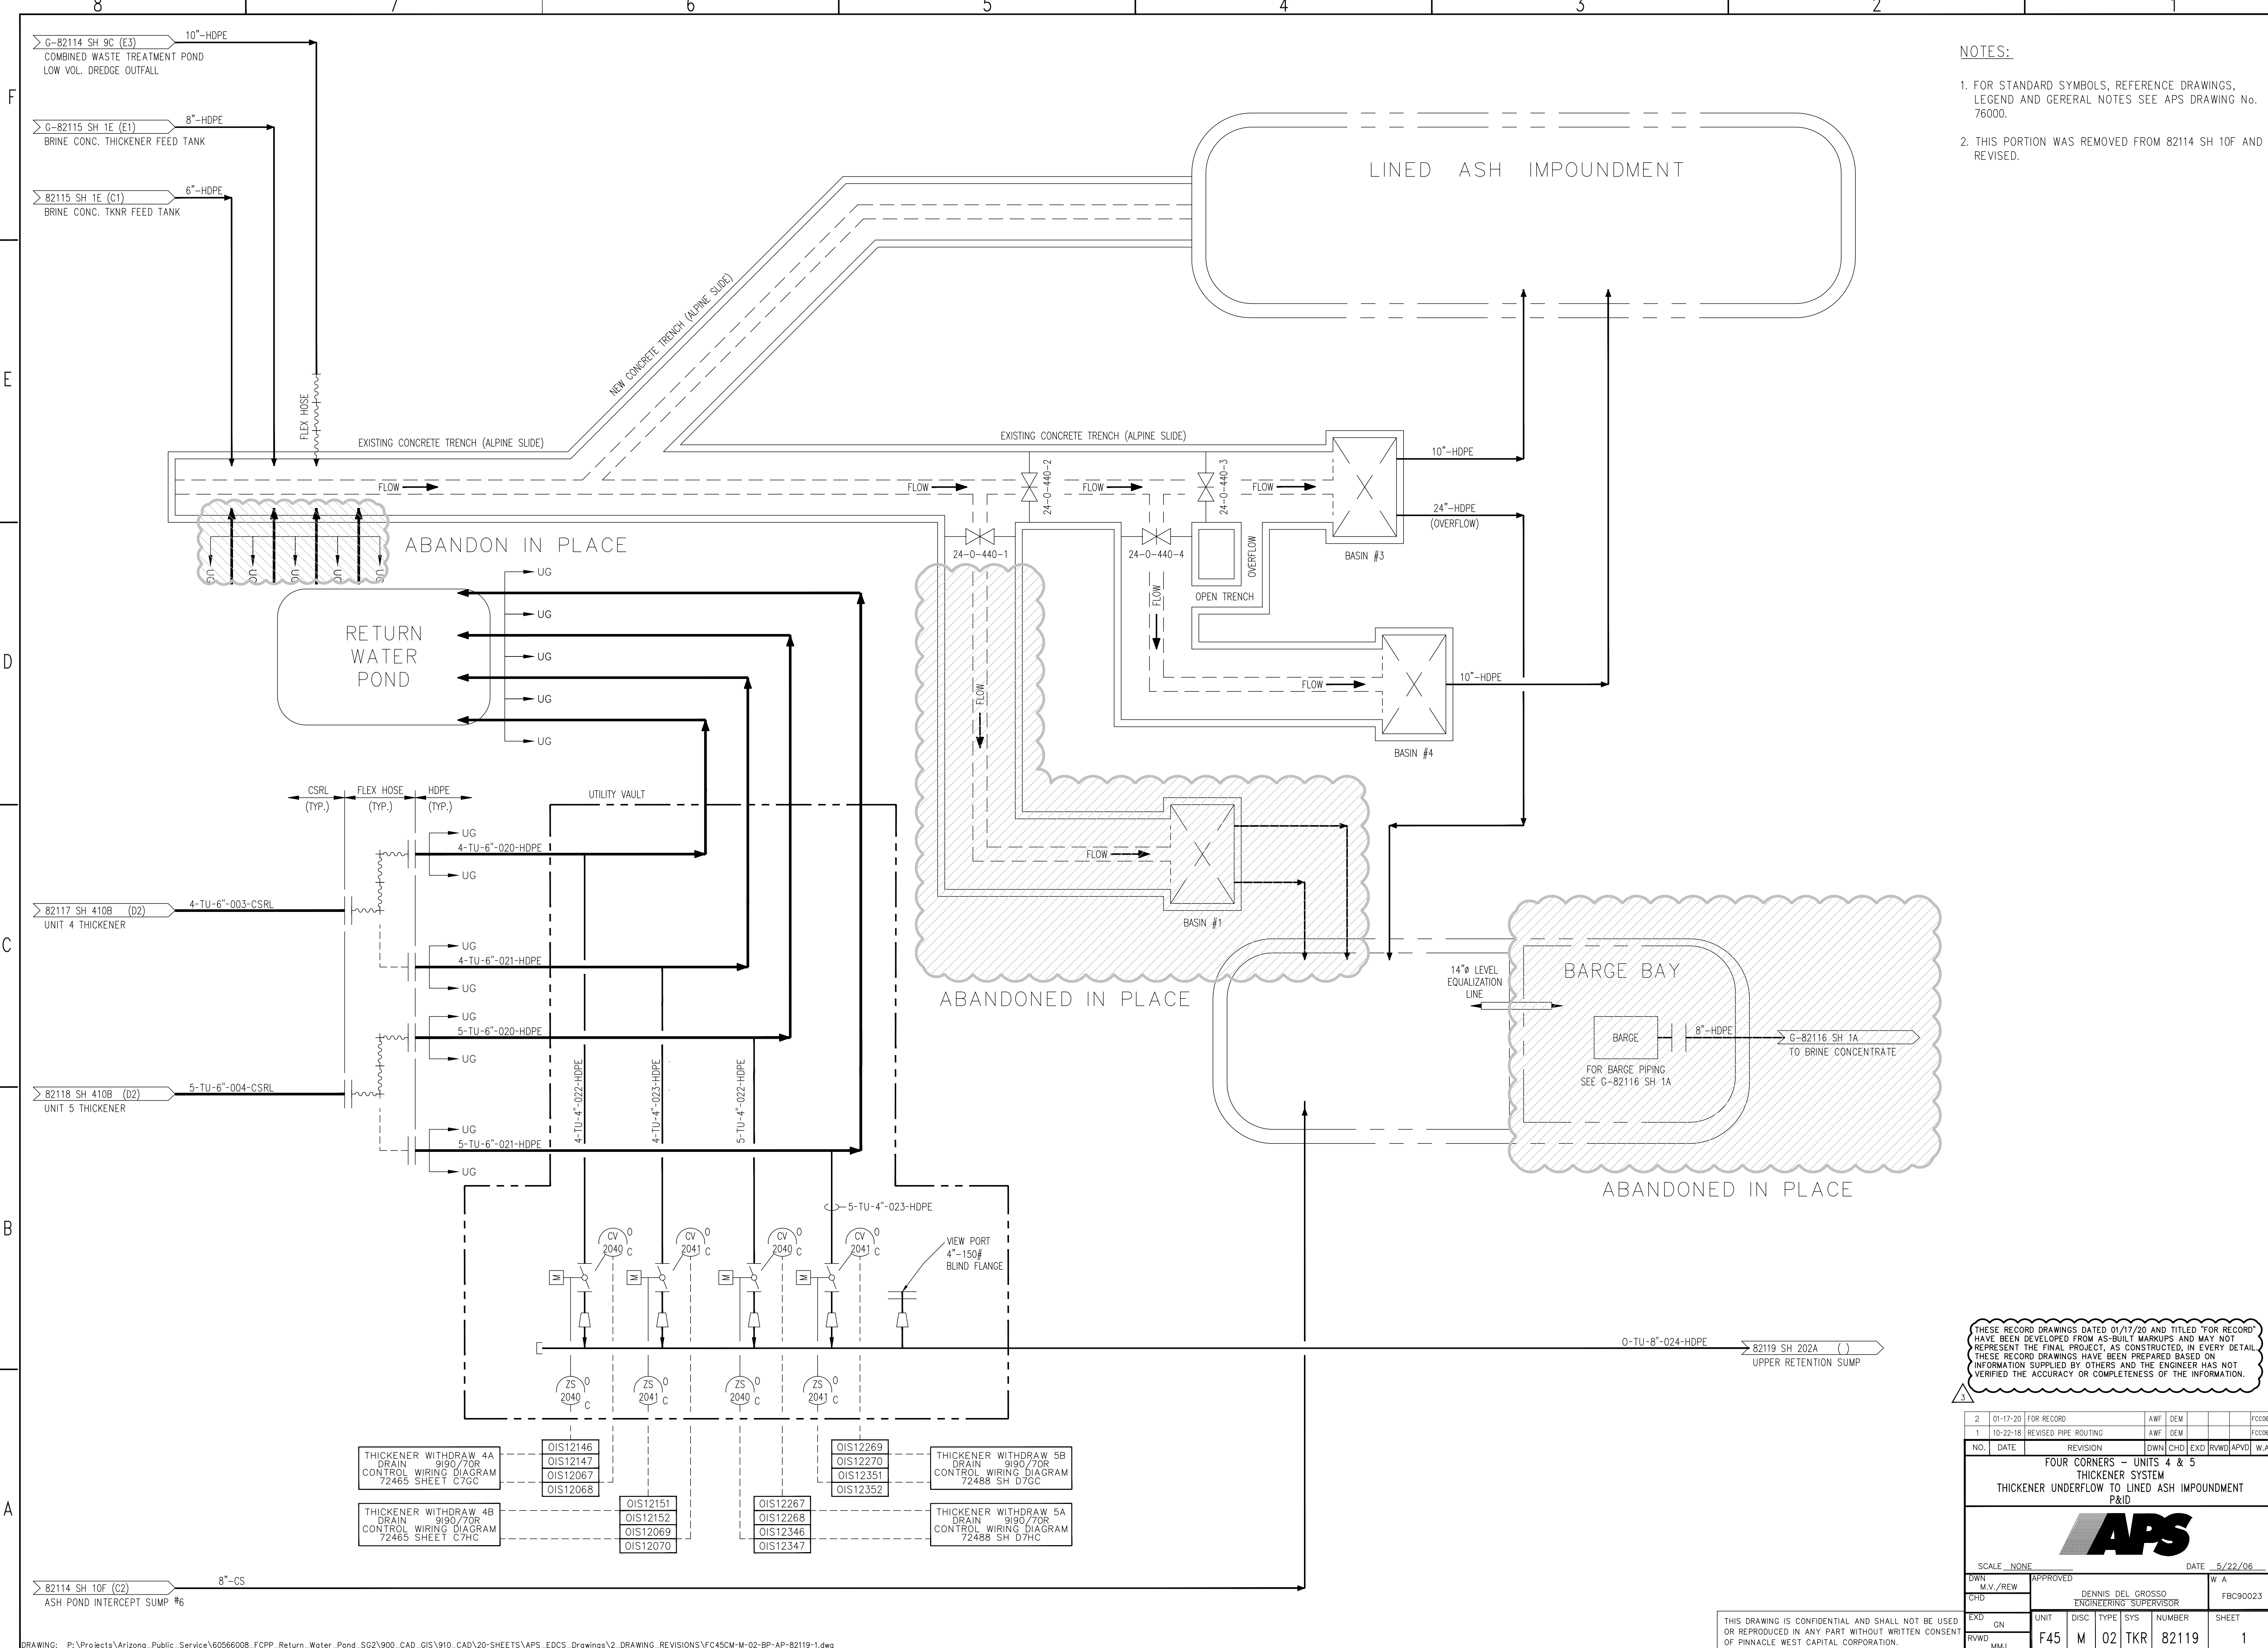


NOTES:
 1. FOR STANDARD SYMBOLS, REFERENCE DRAWINGS, LEGEND AND GENERAL NOTES SEE APS DRAWING No. 76000.
 2. THIS PORTION WAS REMOVED FROM 82114 SH 10F AND REVISED.

THESE RECORD DRAWINGS DATED 01/17/20 AND TITLED "FOR RECORD" HAVE BEEN DEVELOPED FROM AS-BUILT MARKUPS AND MAY NOT REPRESENT THE FINAL PROJECT, AS CONSTRUCTED. IN EVERY DETAIL, THESE RECORD DRAWINGS HAVE BEEN PREPARED BASED ON INFORMATION SUPPLIED BY OTHERS AND THE ENGINEER HAS NOT VERIFIED THE ACCURACY OR COMPLETENESS OF THE INFORMATION.

NO.	DATE	REVISION	DWN	CHD	EXD	RWVD	APVD	W.A.
2	01-17-20	FOR RECORD	AWF	DEM				FC006814
1	10-22-18	REVISED PIPE ROUTING	AWF	DEM				FC006814

FOUR CORNERS - UNITS 4 & 5
 THICKENER SYSTEM
 THICKENER UNDERFLOW TO LINED ASH IMPOUNDMENT
 P&ID

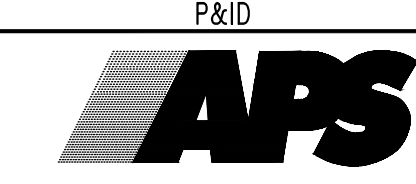

SCALE: NONE DATE: 5/22/06

DWN	M.V./REW	APPROVED	W A
CHD		DENNIS DEL GROSSO ENGINEERING SUPERVISOR	FBC90023
EXD	GN	UNIT DISC TYPE SYS NUMBER SHEET	
RWVD	MMJ	F45 M 02 TKR 82119 1	

THIS DRAWING IS CONFIDENTIAL AND SHALL NOT BE USED OR REPRODUCED IN ANY PART WITHOUT WRITTEN CONSENT OF PINNACLE WEST CAPITAL CORPORATION.

STRUCTURAL NOTES

GENERAL:

- G1. SCOPE**
THE NOTES ON THIS SHEET AND STRUCTURAL DETAILS ARE TYPICAL AND APPLY TO THE ENTIRE PROJECT WHETHER SPECIFICALLY CALLED OUT OR NOT, EXCEPT WHERE THERE ARE SPECIFIC INDICATIONS TO THE CONTRARY ON STRUCTURAL SHEETS. IF THERE ARE QUESTIONS, THEY SHALL BE SUBMITTED TO THE STRUCTURAL ENGINEER AND ANSWERED IN WRITING PRIOR TO CONSTRUCTION.
- G2. APPLICABLE SPECIFICATIONS AND CODES**
A. INTERNATIONAL BUILDING CODE (IBC) 2015
B. ACI 318-14
C. ACI 308-06
D. ASCE 7-10
E. AISC STEEL CONSTRUCTION MANUAL, 14TH EDITION
- G3. DESIGN CRITERIA, APPLIES TO ALL STRUCTURES (UNO)**
A. OCCUPANCY CATEGORY: III
B. DEAD LOAD:
MATERIAL WEIGHT
C. LIVE LOAD:
PUMP STATION: 40 PSF
- G4. SAFETY**
A. SAFETY AND STRUCTURE STABILITY DURING CONSTRUCTION ARE THE SOLE RESPONSIBILITY OF THE CONTRACTOR. STRUCTURES HAVE BEEN DESIGNED TO RESIST THE DESIGN LIVE LOADS ONLY AS A COMPLETED STRUCTURE. PROVIDE TEMPORARY BRACING AND SHORING AS REQUIRED FOR STABILITY DURING CONSTRUCTION.
B. SHORING AND RESHORING OF ELEVATED STRUCTURAL SLABS SHALL BE THE RESPONSIBILITY OF THE CONTRACTOR. CONTRACTOR SHALL SUBMIT DOCUMENTS SHOWING METHOD OF SHORING TO THE ENGINEER FOR INFORMATION ONLY.
- G5. OPENINGS**
A. OPENINGS FOR PIPES, DUCTS, CONDUITS, ETC. ARE NOT ALL SHOWN ON THE STRUCTURAL DRAWINGS. COORDINATE AND PROVIDE OPENINGS AS REQUIRED TO ACCOMMODATE ALL WORK SHOWN OR SPECIFIED IN THE CONTRACT DOCUMENTS AND OTHERWISE REQUIRED FOR THE FURNISHING OF A FUNCTIONALLY COMPLETE PROJECT. REINFORCE AROUND OPENINGS PER STANDARD STRUCTURAL DETAILS UNLESS OTHERWISE SHOWN.
B. COORDINATE FINAL SIZE AND LOCATION OF ALL OPENINGS WITH THE ACTUAL EQUIPMENT SUPPLIED, PROJECT REQUIREMENTS, AND WITH FIELD CONDITIONS.
C. THE ENGINEER OF RECORD PERMITS NO OPENINGS OR ALTERATIONS THROUGH BEAMS OR COLUMNS UNLESS DETAILED ON THE STRUCTURAL DRAWINGS OR APPROVED IN WRITING.
- G6. STANDARD DETAILS**
THE STANDARD DETAILS DEPICT TYPICAL DETAILING TO BE USED ON THIS PROJECT. IF CONDITIONS ARE NOT EXPLICITLY SHOWN ON THE DRAWINGS THEY SHALL BE MADE SIMILAR TO THE STANDARD DETAILS. OBTAIN APPROVAL OF ENGINEER IN WRITING FOR SIMILAR CONDITIONS PRIOR TO CONSTRUCTION.
- G7. THE CONTRACTOR SHALL FIELD VERIFY ALL EXISTING CONDITIONS, DIMENSIONS, AND ELEVATIONS PRIOR TO START OF CONSTRUCTION AS REQUIRED TO COORDINATE NEW CONSTRUCTION. NOTIFY ENGINEER OF ANY DISCREPANCIES OR CONFLICTS FOUND IN CONTRACT DOCUMENTS AND/OR FIELD CONDITIONS.**
- G9. SEE CIVIL DRAWINGS FOR ALL EXTERIOR PAVING AND FLATWORK.**
- G10. ALL WATERSTOPS SHALL BE 6 IN PVC, UNLESS NOTED OTHERWISE. SEE SPECIFICATIONS FOR ADDITIONAL INFORMATION. THE CONTRACTOR SHALL BE RESPONSIBLE TO MAKE ALL WATERSTOPS CONTINUOUS AND ALL JOINTS LEAK-FREE, AS REQUIRED.**
- G11. CONTRACTOR SHALL BE RESPONSIBLE FOR REPAIRING ANY LEAKS IN WATER BEARING STRUCTURES UTILIZING EPOXY INJECTION MATERIALS.**
- G12. SHOP DRAWINGS SHALL BE FURNISHED FOR REVIEW BEFORE ANY FABRICATION AND ERECTION. POORLY EXECUTED SHOP DRAWINGS SHALL BE REJECTED AND RESUBMITTED.**

CONCRETE:

- C1. CAST-IN-PLACE CONCRETE**
A. CLASS A CONCRETE, TYPE II PORTLAND CEMENT, ASTM C150 W/ 20% FLY ASH CLASS F CONFORMING TO ASTM C618
B. $f'c = 4,500$ PSI @ 28 DAYS
C. MAXIMUM WATER CEMENT RATIO = 0.45
D. EXPOSURE CLASS: F2/S2, AIR ENTRAINED
E. MAX SLUMP: 4"
- C2. ALL REINFORCING STEEL SHALL CONFORM TO ASTM A615, GRADE 60 ($F_y = 60$ KSI).**
- C3. COARSE AGGREGATE SHALL BE WELL GRADED CRUSHED STONE, NATURAL ROCK CONFORMING TO REQUIREMENT OF ASTM C33, AND SHALL CONTAIN LESS THAN PERCENT ASBESTOS BY WEIGHT OR VOLUME.**
- C4. ALL SPLICES SHALL BE CLASS B, TENSION LAPS UNLESS NOTED ON PLAN.**
- C5. REINFORCING BARS SHALL HAVE MATCHING CORNER BARS.**
- C6. DOWEL CONCRETE WALLS AND PIERS INTO FOOTINGS AND BASE SLABS WITH DOWELS THE SAME SIZE AND SPACING AS VERTICAL REINFORCEMENT. EXTEND DOWELS TO WITHIN 3" OF BOTTOM OF FOOTING, TERMINATED WITH ACI STD. 90 DEGREE HOOK, UNLESS OTHERWISE NOTED.**
- C7. CONCRETE COVER: UNLESS OTHERWISE NOTED, PROVIDE CONCRETE COVER FOR REINFORCING ACCORDING TO DETAIL.**
- C8. PLACEMENT OF CONCRETE SHALL BE IN CONFORMANCE WITH ACI 117-10 "SPECIFICATION FOR TOLERANCES FOR CONCRETE CONSTRUCTION AND MATERIALS AND COMMENTARY."**
- C9. ALL CONCRETE WORK SHALL BE IN ACCORDANCE WITH THE LATEST EDITIONS OF THE AMERICAN CONCRETE INSTITUTE STANDARDS. "BUILDING CODE REQUIREMENTS FOR STRUCTURAL CONCRETE" (ACI 318), "SPECIFICATIONS FOR STRUCTURAL CONCRETE FOR BUILDINGS" (ACI 301), AND "CODE REQUIREMENTS FOR ENVIRONMENTAL ENGINEERING CONCRETE STRUCTURES AND COMMENTARY" (ACI 350).**
- C10. REFER TO OTHER DISCIPLINE DRAWINGS PRIOR TO CONSTRUCTION FOR EMBEDDED ITEMS AND PENETRATIONS NOT SHOWN ON STRUCTURAL DRAWINGS AS REQUIRED TO ACCOMMODATE ALL WORK SHOWN OR SPECIFIED IN THE CONTRACT DOCUMENTS AND OTHERWISE REQUIRED FOR THE FURNISHING OF A FUNCTIONALLY COMPLETE PROJECT. REINFORCE AROUND OPENINGS PER STANDARD STRUCTURAL DETAILS UNLESS OTHERWISE SHOWN.**
- C11. CONDUITS AND PIPES MAY NOT BE EMBEDDED WITHIN A SLAB, WALL, OR BEAM WITHOUT PRIOR APPROVAL OF ENGINEER.**
- C12. UNLESS NOTED OTHERWISE PROVIDE 3/4"x3/4" CHAMFERS AT ALL EXPOSED EDGES. NOT ALL CHAMFERS MAY BE SHOWN ON DRAWINGS.**
- C13. ANCHOR BOLTS NOT SPECIFIED BY ENGINEER SHALL BE DESIGNED AND CERTIFIED BY A REGISTERED PROFESSIONAL ENGINEER, RETAINED BY THE CONTRACTOR, IN ACCORDANCE WITH APPLICABLE PROJECT AND CODE REQUIREMENTS. SUBMIT AS A SHOP DRAWING FOR REVIEW BY THE ENGINEER. COORDINATE LOCATION, SIZE AND EMBEDMENT PRIOR TO CASTING CONCRETE.**
- C14. ABSOLUTELY NO WELDING OF REINFORCING BARS OR TORCHING TO BEND REINFORCING BARS SHALL BE ALLOWED WITHOUT SPECIFIC APPROVAL FROM THE STRUCTURAL ENGINEER.**
- C15. POST-INSTALLED DRILL AND EPOXY ANCHORS INTO CONCRETE SHALL BE HILTI HIT-HY 200 ADHESIVE ANCHORING SYSTEM, OR APPROVED EQUAL, WITH MINIMUM 3/4" DIAMETER, A36 ANCHOR WITH MINIMUM OF 6" EMBEDMENT UNLESS OTHERWISE SHOWN.**
- C16. PRIOR TO INSTALLING POST-INSTALLED ANCHORS INTO CONCRETE, THE CONTRACTOR SHALL LOCATE REINFORCING. DO NOT DAMAGE CONCRETE REINFORCING.**
- C17. COMPLY WITH CURING PROCEDURE SET FORTH IN ACI 301, ACI 308.**



STEEL:

- S1. MATERIALS SHALL CONFORM TO THE STANDARDS LISTED:**
A. WIDE FLANGE SECTIONS: ASTM A992 OR ASTM A572, GRADE 50 ($F_y = 50$ KSI)
B. STRUCTURAL BOLTS: ASTM A325
C. NON-STRUCTURAL BOLTS: ASTM A307
D. HSS: ASTM A500 GRADE B
E. ALL STEEL MEMBERS AND BOLTS SHALL BE HOT DIP GALVANIZED.
- S2. DIMENSIONS: TO CENTERLINES OF COLUMNS AND BEAMS, TOP SURFACES OF BEAMS AND TUBES AND BACKS OF CHANNELS AND ANGLES UNO.**
- S3. BOLTED CONNECTIONS UNLESS NOTED OTHERWISE:**
A. STRUCTURAL: 3/4" DIAMETER MIN., TYPE N, FULL DEPTH CONNECTION, (2) BOLTS MINIMUM
B. ANCHOR RODS: 3/4" DIAMETER MIN., (4) BOLTS MINIMUM, MINIMUM 12" EMBED INTO CONCRETE, PROJECTION ABOVE CONCRETE, AS REQUIRED.
C. NON-STRUCTURAL: 5/8" DIAMETER MIN.
- S4. ALL BOLTED STRUCTURAL CONNECTIONS ARE BEARING TYPE CONNECTIONS UNLESS OTHERWISE SPECIFIED TO BE SLIP-CRITICAL. PROVIDE LOAD INDICATING WASHERS AT SLIP-CRITICAL CONNECTIONS.**
- S5. ALL WELDING SHALL BE DONE BY CERTIFIED WELDERS AND SHALL BE DONE IN ACCORDANCE WITH THE LATEST STANDARDS OF THE AWS AND AISC. INSPECT ALL WELDING IN ACCORDANCE WITH THE SPECIAL INSPECTIONS AND SPECIFICATIONS.**
- S6. WHEN FILLET WELD SIZE IS NOT INDICATED, PROVIDE MAXIMUM WELD SIZE BASED ON CONNECTED MATERIAL THICKNESSES IN ACCORDANCE WITH AISC SPECIFICATIONS.**
- S7. ALL STRUCTURAL STEEL FABRICATION AND ERECTION SHALL CONFORM TO AISC 360, STEEL CONSTRUCTION MANUAL AND AISC 341, SEISMIC DESIGN MANUAL.**
- S8. PLACE NATURAL CAMBER OF BEAMS UPWARD.**
- S9. DO NOT FIELD CUT OR ALTER STRUCTURAL MEMBERS WITHOUT ENGINEER'S APPROVAL.**
- S10. FIELD REPAIR OF DAMAGED GALVANIZED COATING BY SHERWIN WILLIAMS PRO-CRYL UNIVERSAL PRIMER, B66-310 SERIES AND SHERWIN WILLIAMS INDUSTRIAL VOC SEMI-GLOSS, B66W650 SERIES OR EQUAL.**

SPECIAL INSPECTIONS:

- SPI. SPECIAL INSPECTIONS SHALL BE PROVIDED TO MEET THE REQUIREMENTS OF IBC CHAPTER 17 IN THE FOLLOWING CATEGORIES:**
-SUBGRADE PREPARATION
-WELDING
-ANCHOR BOLTS
-HIGH STRENGTH BOLTING

BAR SIZE	DIAMETER (d_b) (INCHES)	DEVELOPMENT LENGTH (l_d) (INCHES)		CLASS B LAP SPLICE (INCHES)		90° STD HOOK (INCHES)		180° STD HOOK "v" (INCHES)
		"TOP" BARS	OTHER	"TOP" BARS	OTHER	H O O K	l_{dh}	
REINFORCING BARS IN TENSION								
#3	0.375	18	14	24	18	6	7	6
#4	0.5	25	19	32	25	8	10	6
#5	0.625	31	24	40	31	10	12	6
#6	0.75	37	28	48	37	12	14	6
#7	0.875	54	42	70	54	14	17	7
#8	1.0	62	47	80	62	16	19	8
#9	1.125	70	54	90	70	19	21	11
#10	1.25	78	60	102	78	22	24	12
#11	1.375	87	67	113	87	24	27	13
#14	1.75	104	80	136	104	30	32	14
REINFORCING BARS IN COMPRESSION								
#3	0.375	8		12		HOOKED BARS SHALL NOT BE USED IN COMPRESSION		
#4	0.5	9		15				
#5	0.625	12		19				
#6	0.75	14		23				
#7	0.875	17		26				
#8	1.0	19		30				
#9	1.125	21		34				
#10	1.25	24		38				
#11	1.375	27		42				
#14	1.75	32		51				

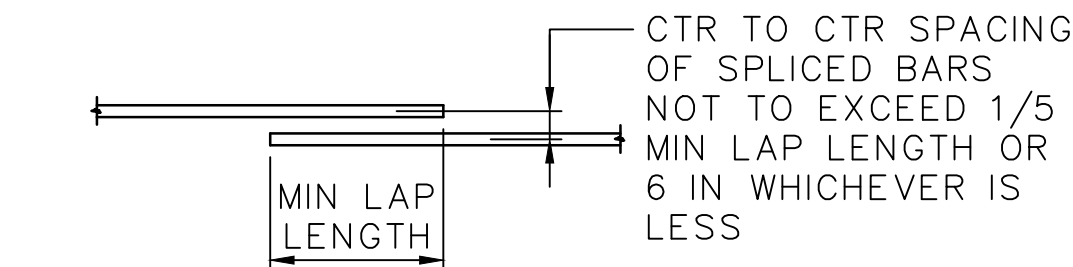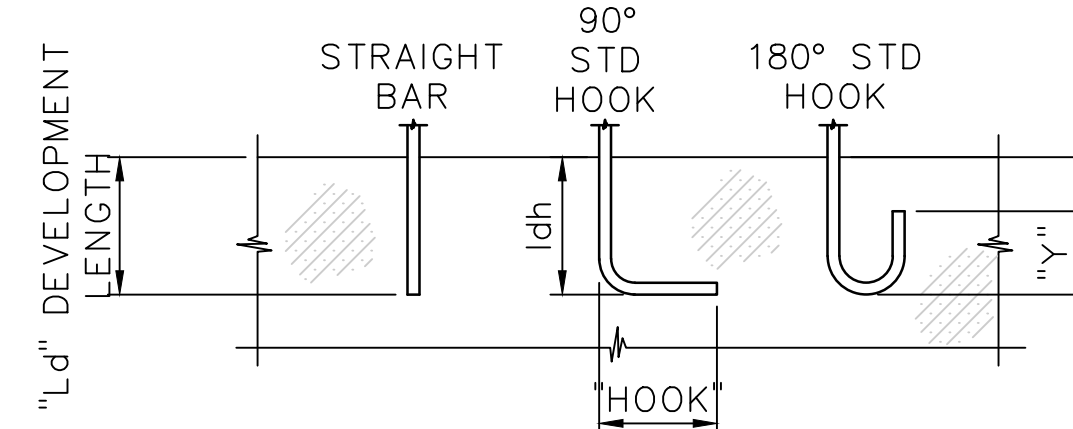

NOTES:

- "TOP" BARS SHALL BE HORIZONTAL REINFORCEMENT PLACED SO THAT MORE THAN 12" OF FRESH CONCRETE IS CAST IN THE MEMBER BELOW THE DEVELOPMENT LENGTH OR SPLICE.
- CLEAR SPACING OF BARS BEING DEVELOPED OR SPLICED SHALL:
A. NOT BE LESS THAN d_b , HAVE CLEAR COVER NOT LESS THAN d_b , AND STIRRUPS OR TIES THROUGHOUT l_d NOT LESS THAN THE CODE MINIMUM OR;
B. CLEAR SPACING OF BARS BEING DEVELOPED OR SPLICED NOT LESS THAN $2d_b$ AND CLEAR COVER NOT LESS THAN d_b . WHERE d_b = DIAMETER OF REINFORCING BAR AND l_d = DEVELOPMENT LENGTH.
- ALL LAP SPLICES SHALL BE CLASS B UNLESS NOTED OTHERWISE.
- WHEN SPLICING BAR OF DIFFERENT SIZE, THE LENGTH OF LAP SHALL BE GOVERNED BY THE LARGER DIAMETER BAR.
- SPLICES ARE TO BE MADE SO THAT THE GIVEN DISTANCES TO FACE OF CONCRETE WILL BE MAINTAINED.
- SPLICES SHALL BE STAGGERED TO GIVE 12 INCHES CLEAR BETWEEN ENDS OF ADJACENT SPLICES, IF BARS ARE SPACED CLOSER THAN 6 INCHES OR 6 BAR DIAMETERS.

STANDARD HOOK & REINF LAP SPLICE
SCALE: NTS

CONSTRUCTION NOTES:

- THE CONTRACTOR SHALL FIELD VERIFY ALL EXISTING CONDITIONS, DIMENSIONS, AND ELEVATIONS PRIOR TO START OF CONSTRUCTION AS REQUIRED TO COORDINATE NEW CONSTRUCTION. NOTIFY ENGINEER OF ANY DISCREPANCIES OR CONFLICTS FOUND IN CONTRACT DOCUMENTS AND/OR FIELD CONDITIONS.

THESE RECORD DRAWINGS DATED 01/17/20 AND TITLED "FOR RECORD" HAVE BEEN DEVELOPED FROM AS-BUILT MARKUPS AND MAY NOT REPRESENT THE FINAL PROJECT, AS CONSTRUCTED, IN EVERY DETAIL. THESE RECORD DRAWINGS HAVE BEEN PREPARED BASED ON INFORMATION SUPPLIED BY OTHERS AND THE ENGINEER HAS NOT VERIFIED THE ACCURACY OR COMPLETENESS OF THE INFORMATION.

1	01-17-20	FOR RECORD	AWF	DEM			FC006814	
NO.	DATE	REVISION	DWN	CHD	EXD	RWVD	APVD	W.A.

FOUR CORNERS POWER PLANT
RETURN WATER POND
STRUCTURAL GENERAL NOTES



SCALE: AS NOTED DATE: 10/04/19



DWN	CM	EXD	---	APPROVED	W A
CHD	HM	RWVD	---	ROBERT E. HAWTHORNE	FC006814
				DRAWING APPROVED BY	

UNIT	DISC	TYPE	SYS	SUBSYS	NUMBER	SHEET
FC45CM	S	98	WP	AP	200485	24




WORK SAFELY TODAY

THIS DRAWING IS CONFIDENTIAL AND SHALL NOT BE USED OR REPRODUCED IN ANY PART WITHOUT WRITTEN CONSENT OF PINNACLE WEST CAPITAL CORPORATION.

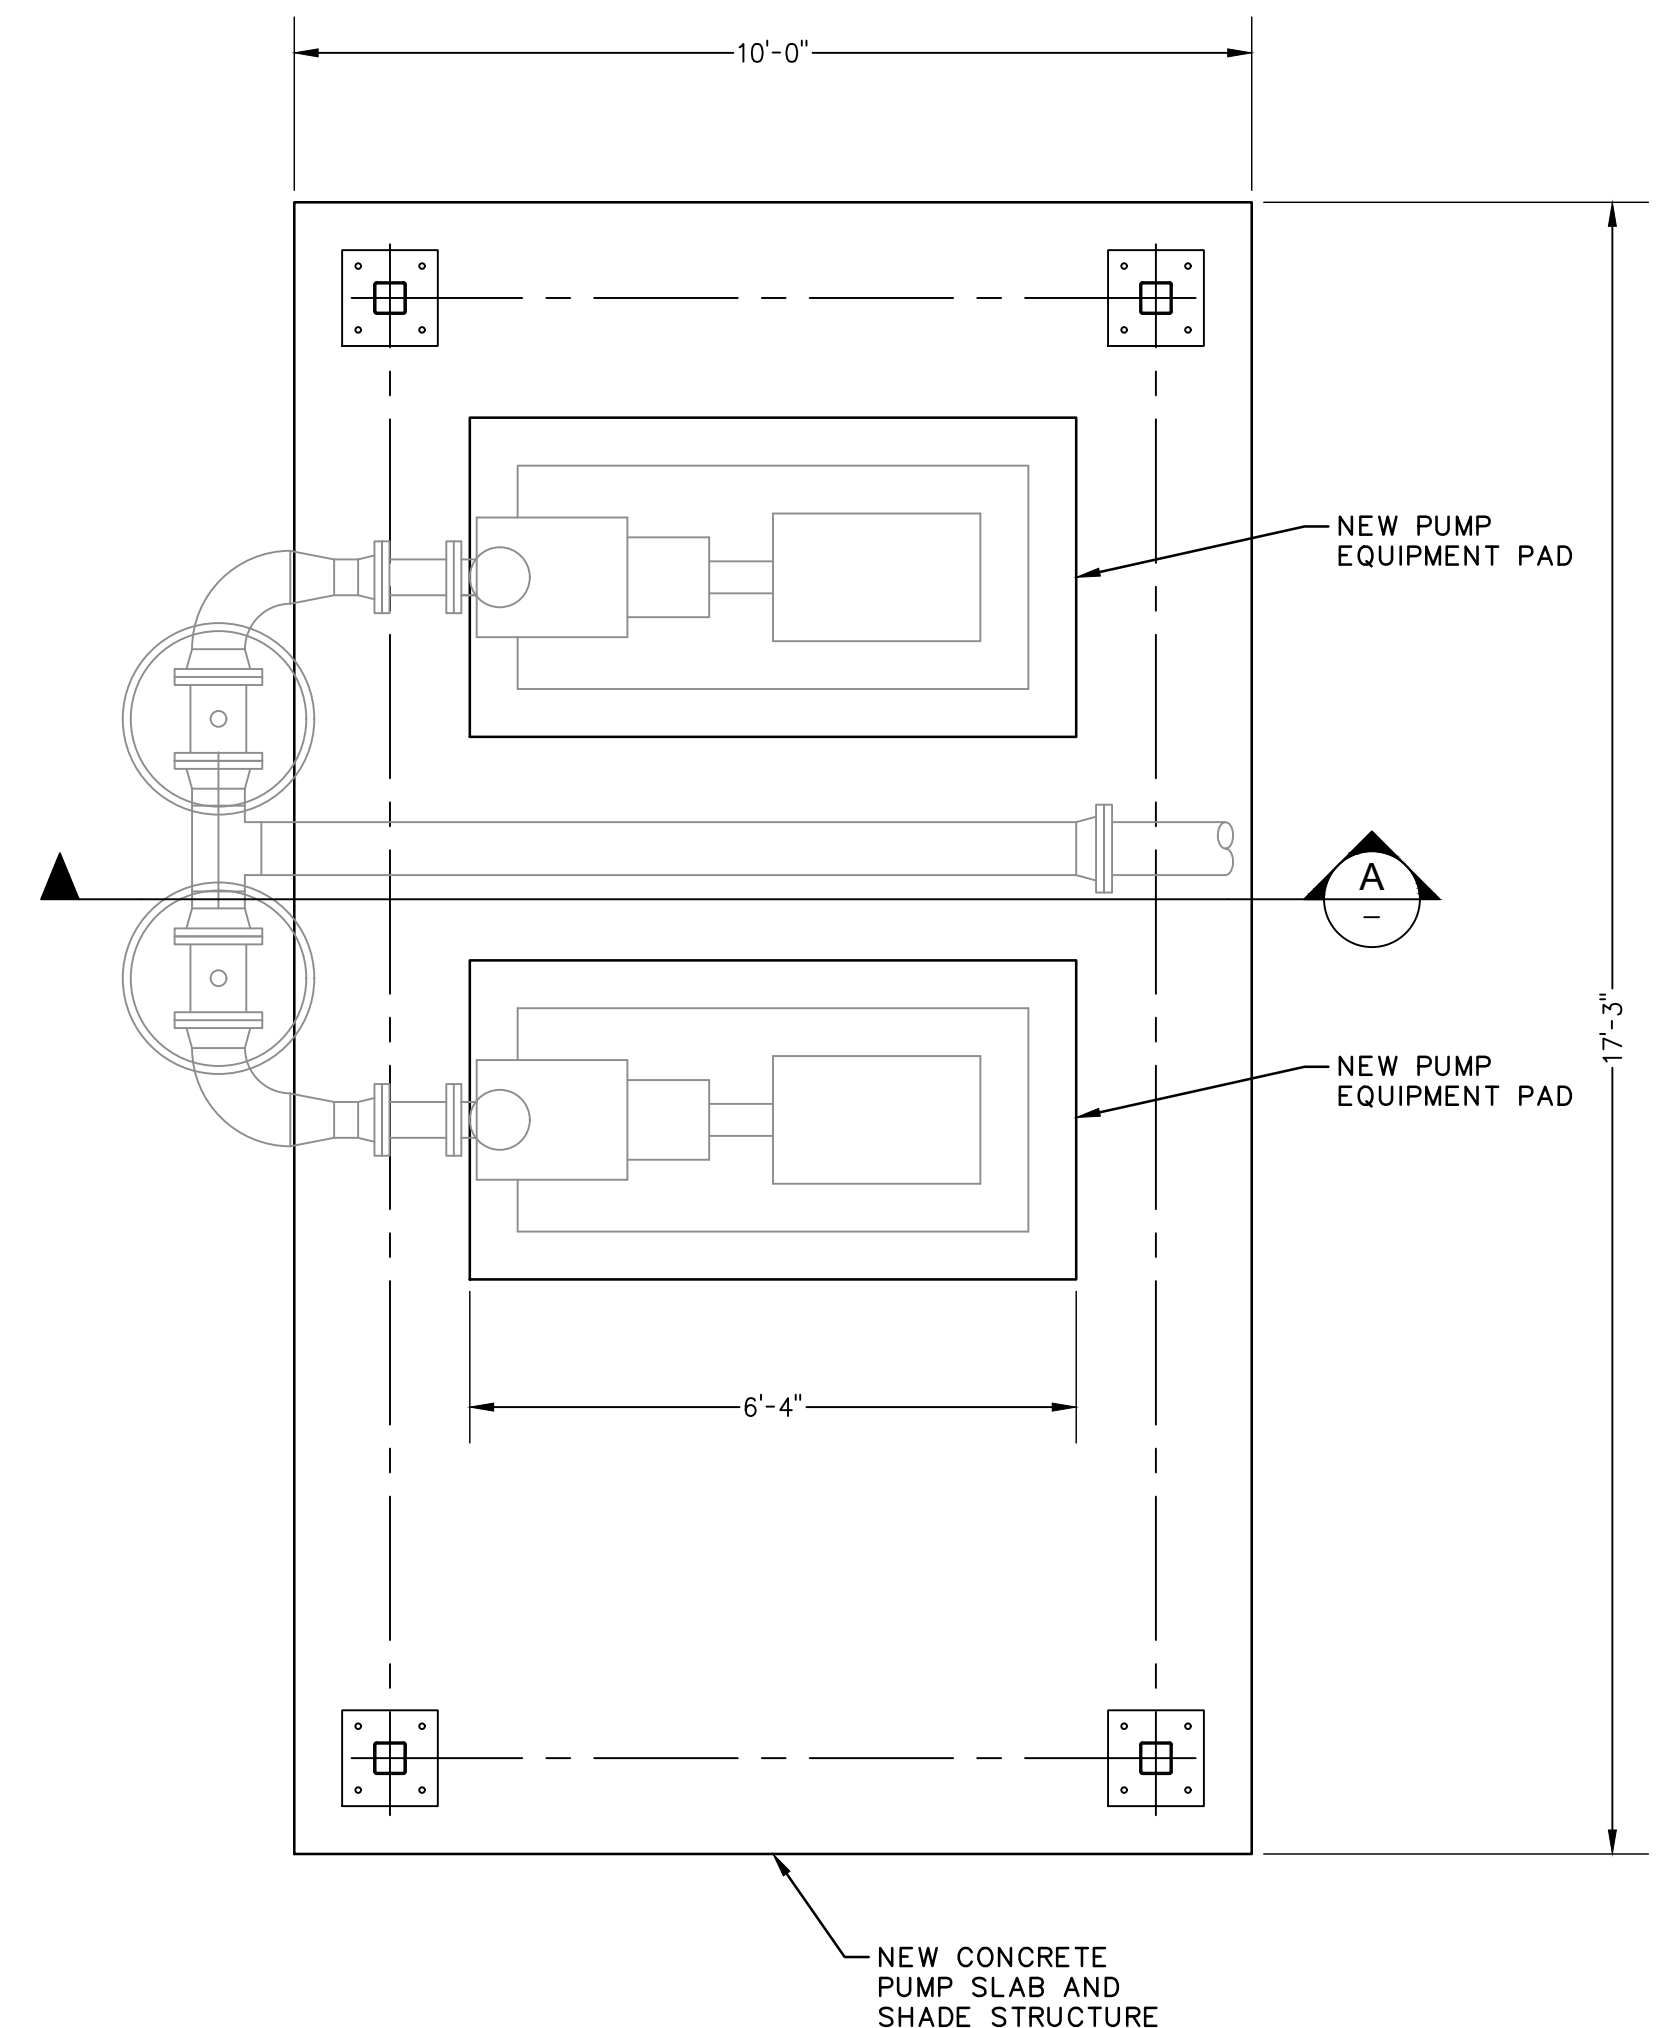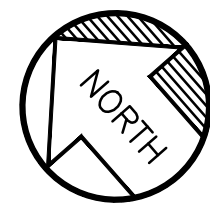

PLAN VIEW
RETURN WATER PUMP SLAB
SCALE: 1/2"=1'-0" (FULL SIZE)

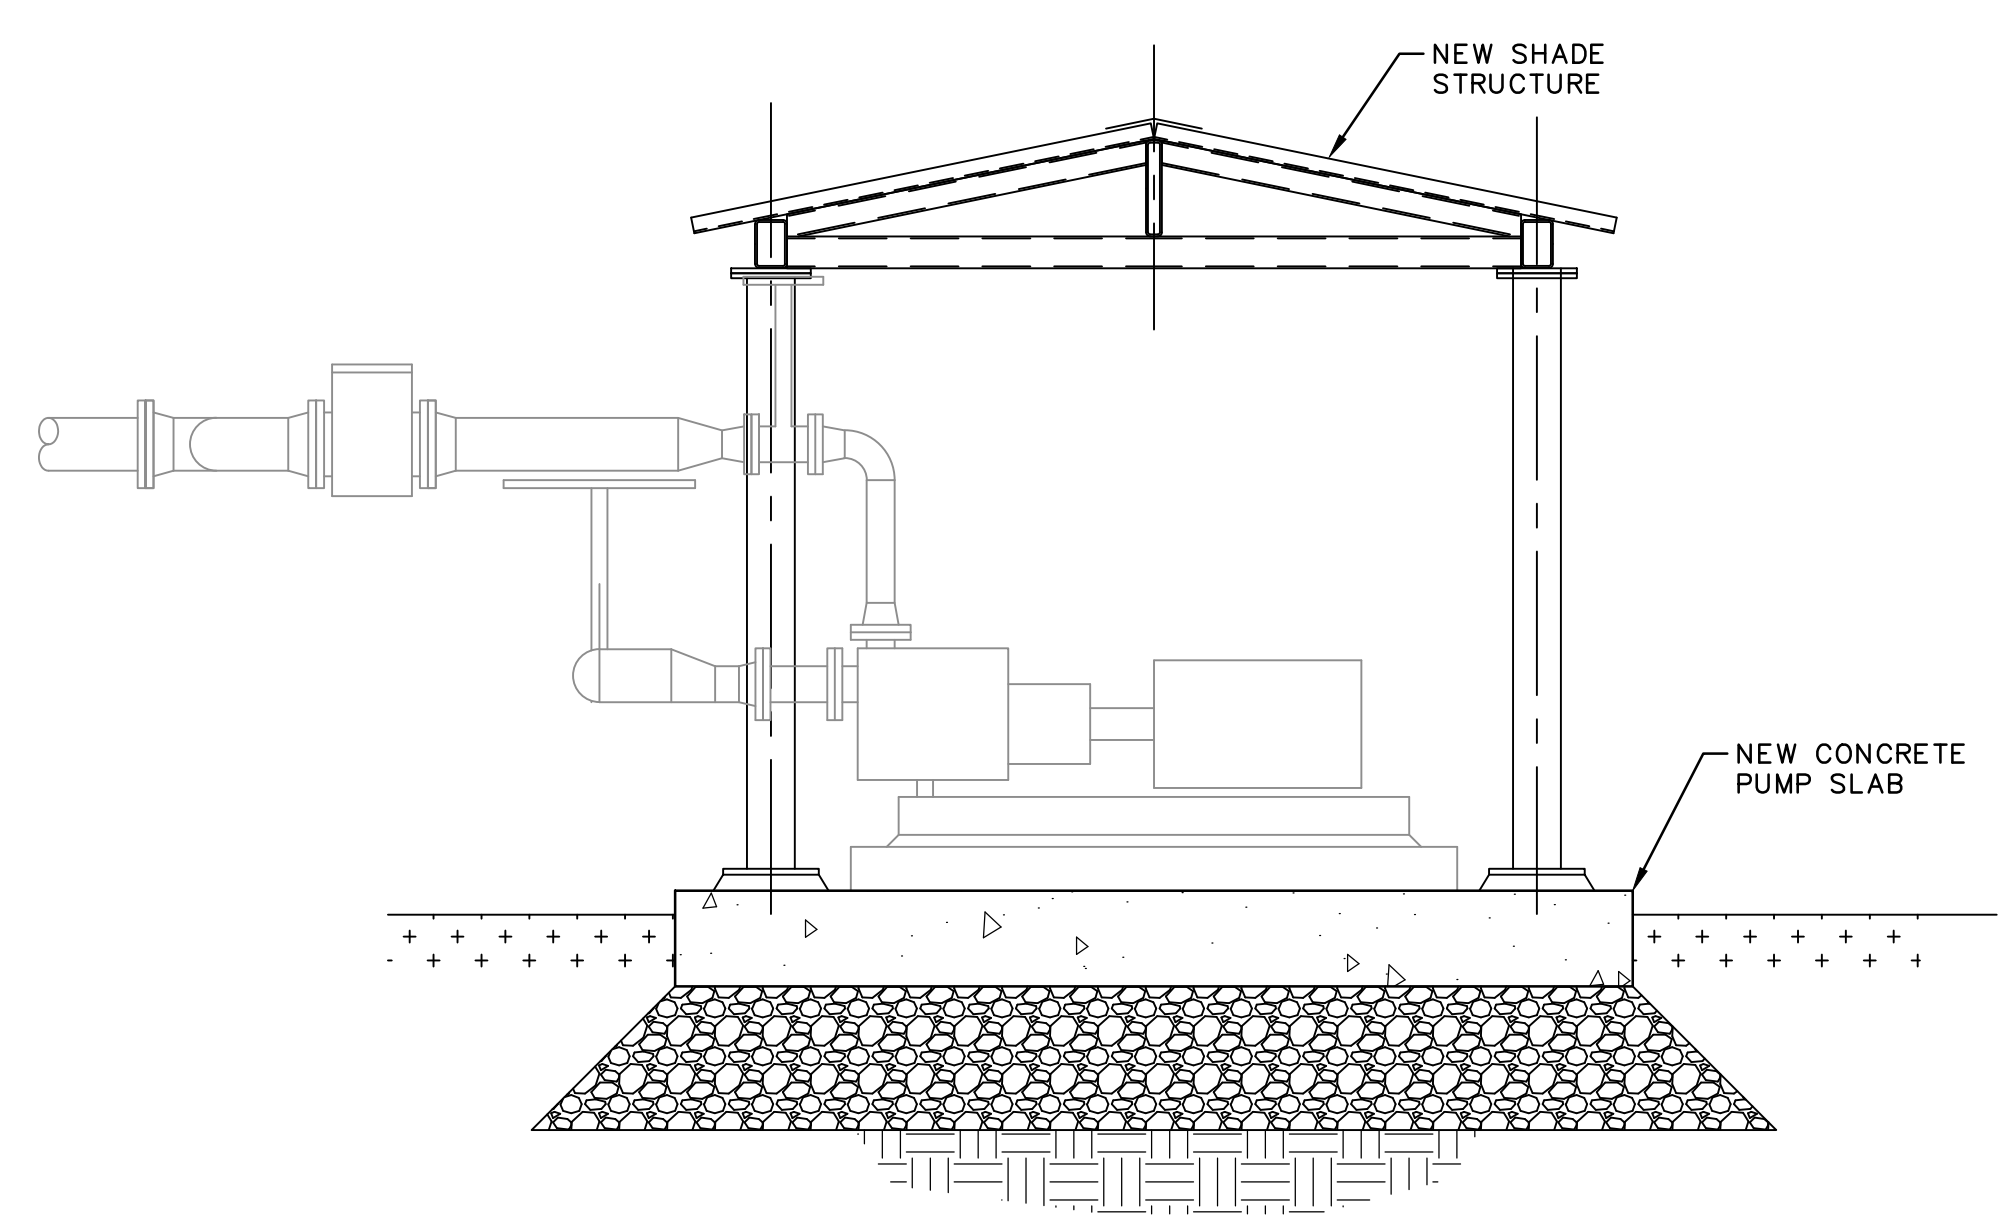

SECTION A-A
SHADE STRUCTURE
1/2"=1'-0"

CONSTRUCTION NOTES:

1. THE CONTRACTOR SHALL FIELD VERIFY ALL EXISTING CONDITIONS, DIMENSIONS, AND ELEVATIONS PRIOR TO START OF CONSTRUCTION AS REQUIRED TO COORDINATE NEW CONSTRUCTION. NOTIFY ENGINEER OF ANY DISCREPANCIES OR CONFLICTS FOUND IN CONTRACT DOCUMENTS AND/OR FIELD CONDITIONS.

THESE RECORD DRAWINGS DATED 01/17/20 AND TITLED "FOR RECORD" HAVE BEEN DEVELOPED FROM AS-BUILT MARKUPS AND MAY NOT REPRESENT THE FINAL PROJECT, AS CONSTRUCTED, IN EVERY DETAIL. THESE RECORD DRAWINGS HAVE BEEN PREPARED BASED ON INFORMATION SUPPLIED BY OTHERS AND THE ENGINEER HAS NOT VERIFIED THE ACCURACY OR COMPLETENESS OF THE INFORMATION.

1	01-17-20	FOR RECORD	AWF	DEM			FCC06814	
NO.	DATE	REVISION	DWN	CHD	EXD	RWVD	APVD	W.A.

FOUR CORNERS POWER PLANT
RETURN WATER POND
STRUCTURAL PLAN AND SECTION



SCALE: 1"=2' DATE: 10/04/19


DWN	CM	EXD	---	APPROVED	W A
CHD	HM	RWVD	---	ROBERT E. HAWTHORNE	FCC06814
				DRAWING APPROVED BY	



UNIT	DISC	TYPE	SYS	SUBSYS	NUMBER	SHEET
FC45CM	S	47	WP	AP	200485	25

AECOM
7720 N. 16th Street Suite 100
Phoenix, Arizona 85020
(602) 371-1100


WORK SAFELY TODAY

THIS DRAWING IS CONFIDENTIAL AND SHALL NOT BE USED OR REPRODUCED IN ANY PART WITHOUT WRITTEN CONSENT OF PINNACLE WEST CAPITAL CORPORATION.

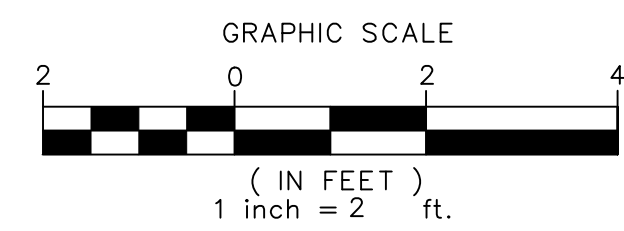


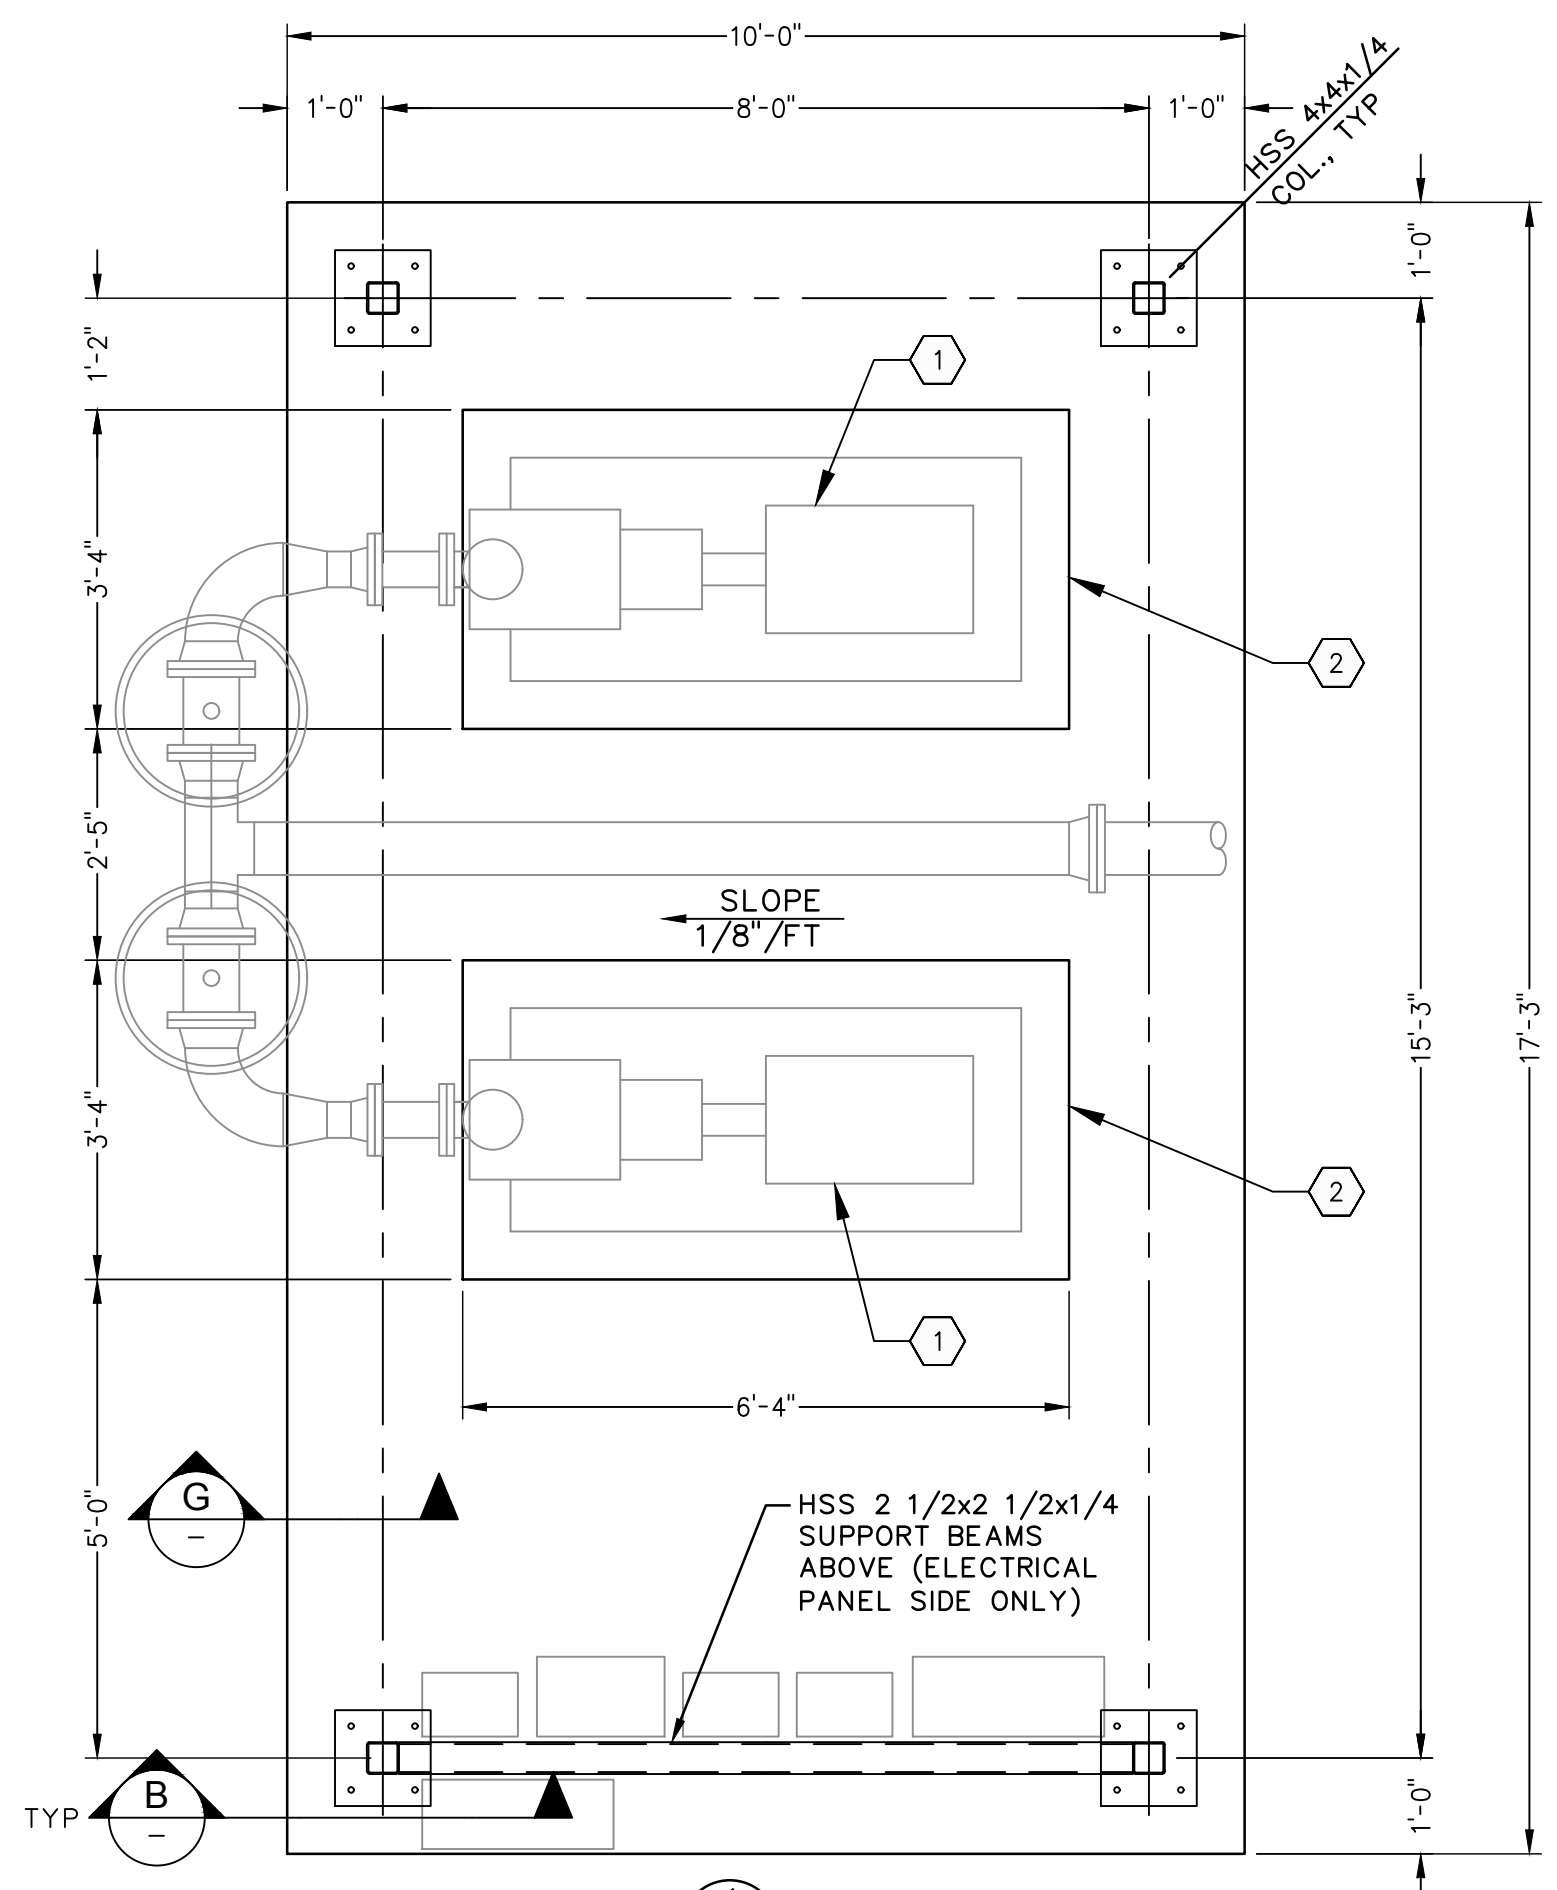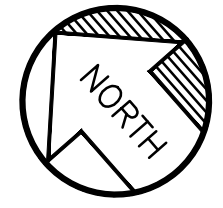


DETAIL 1 FOUNDATION PLAN
1/2"=1'-0"

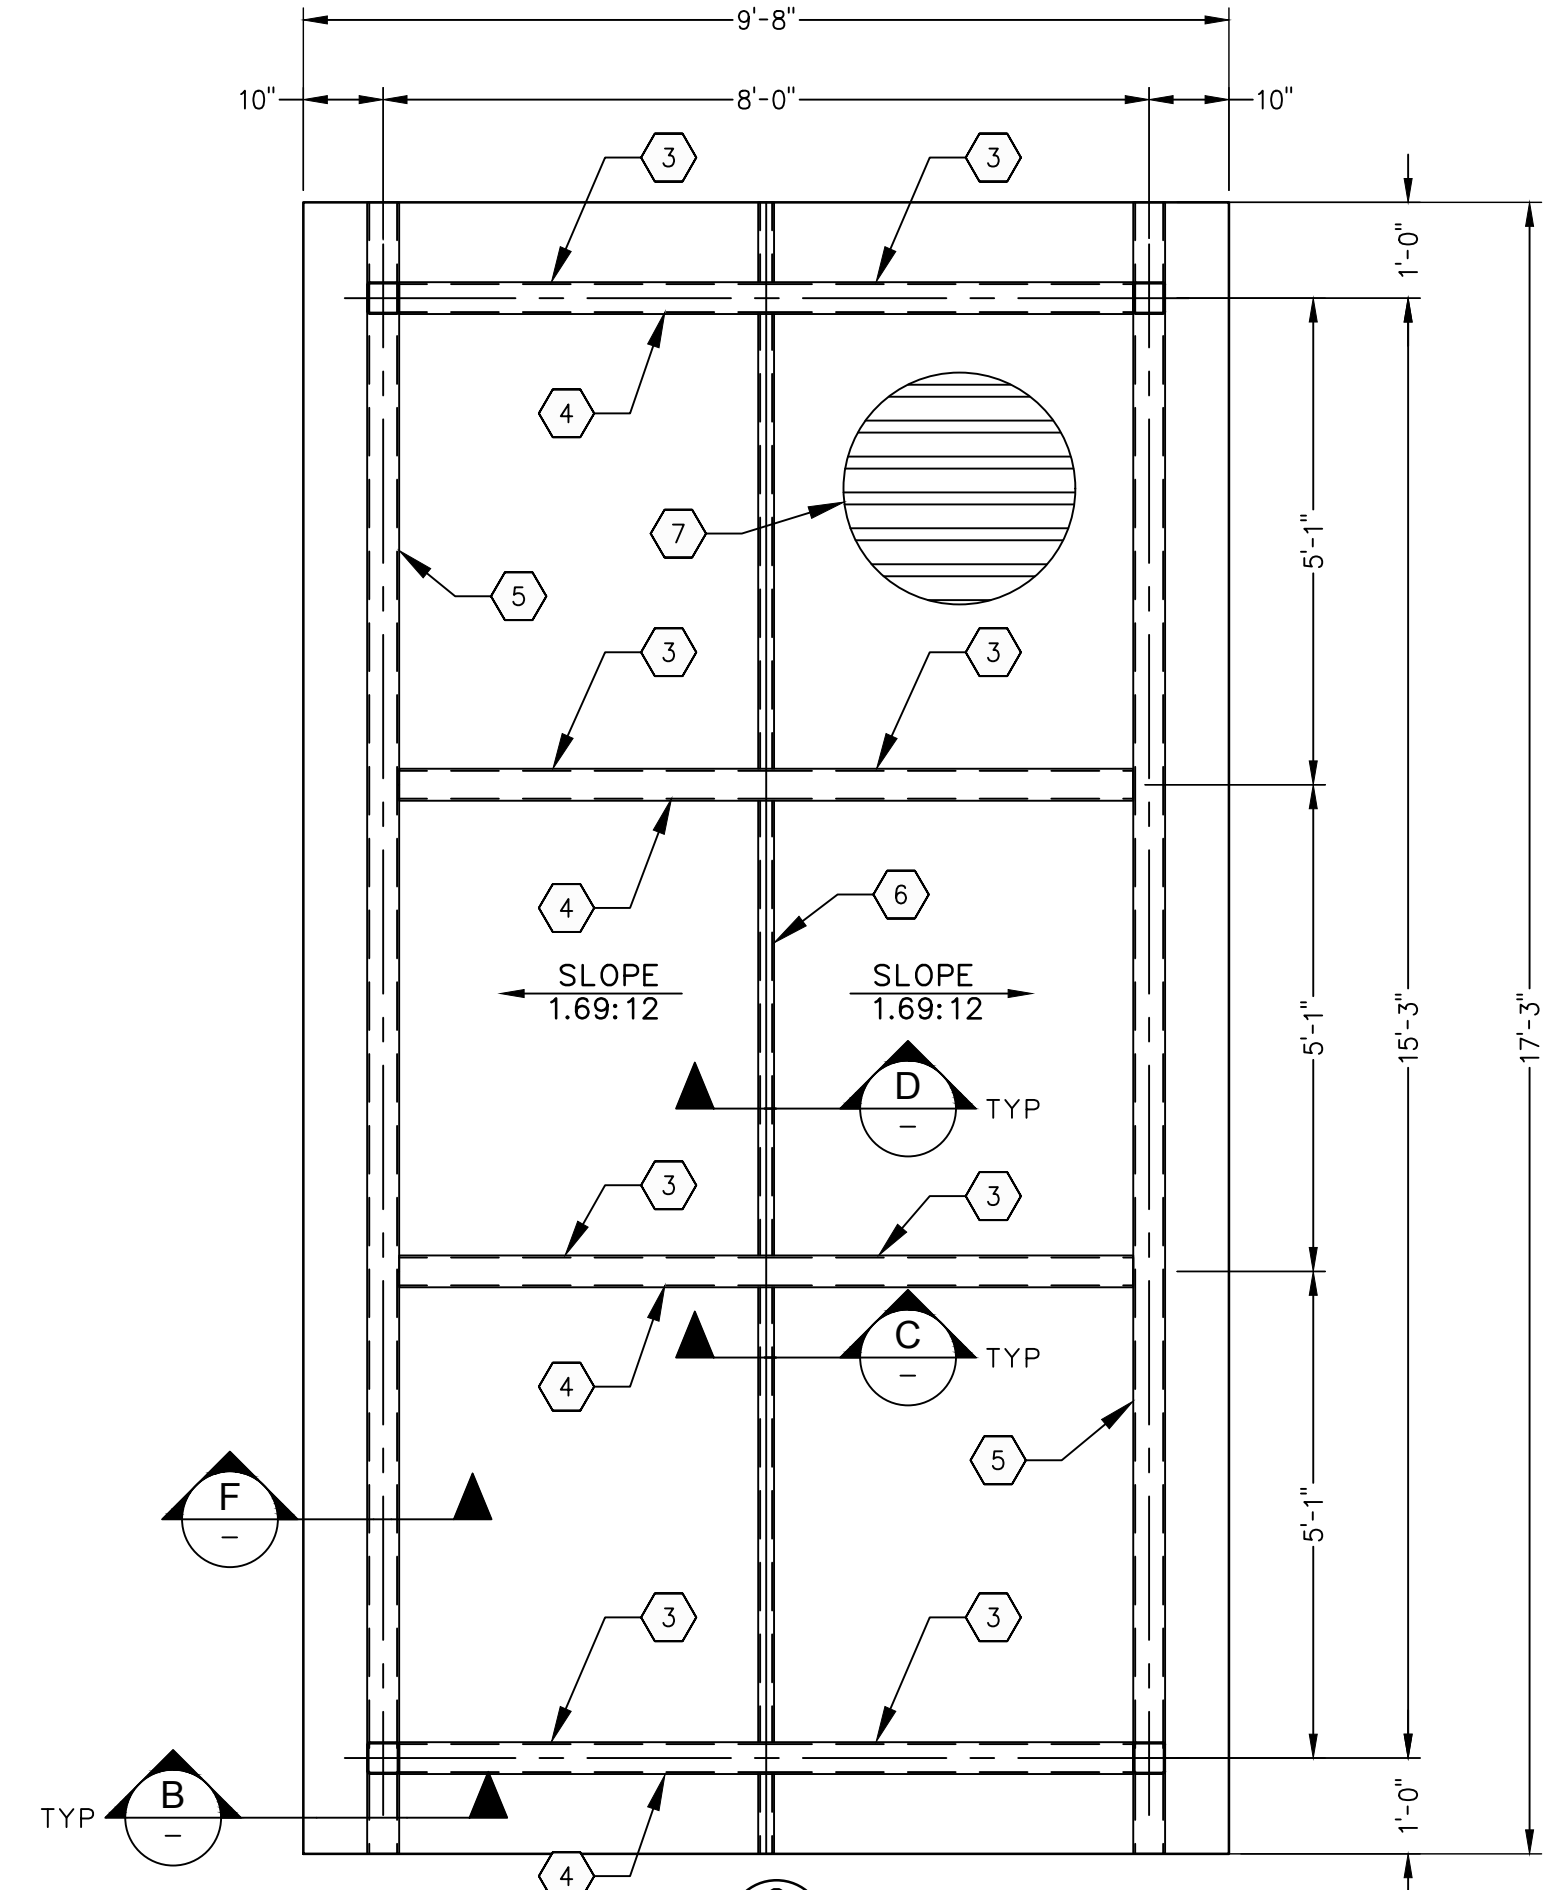


DETAIL 2 ROOF FRAMING PLAN
1/2"=1'-0"

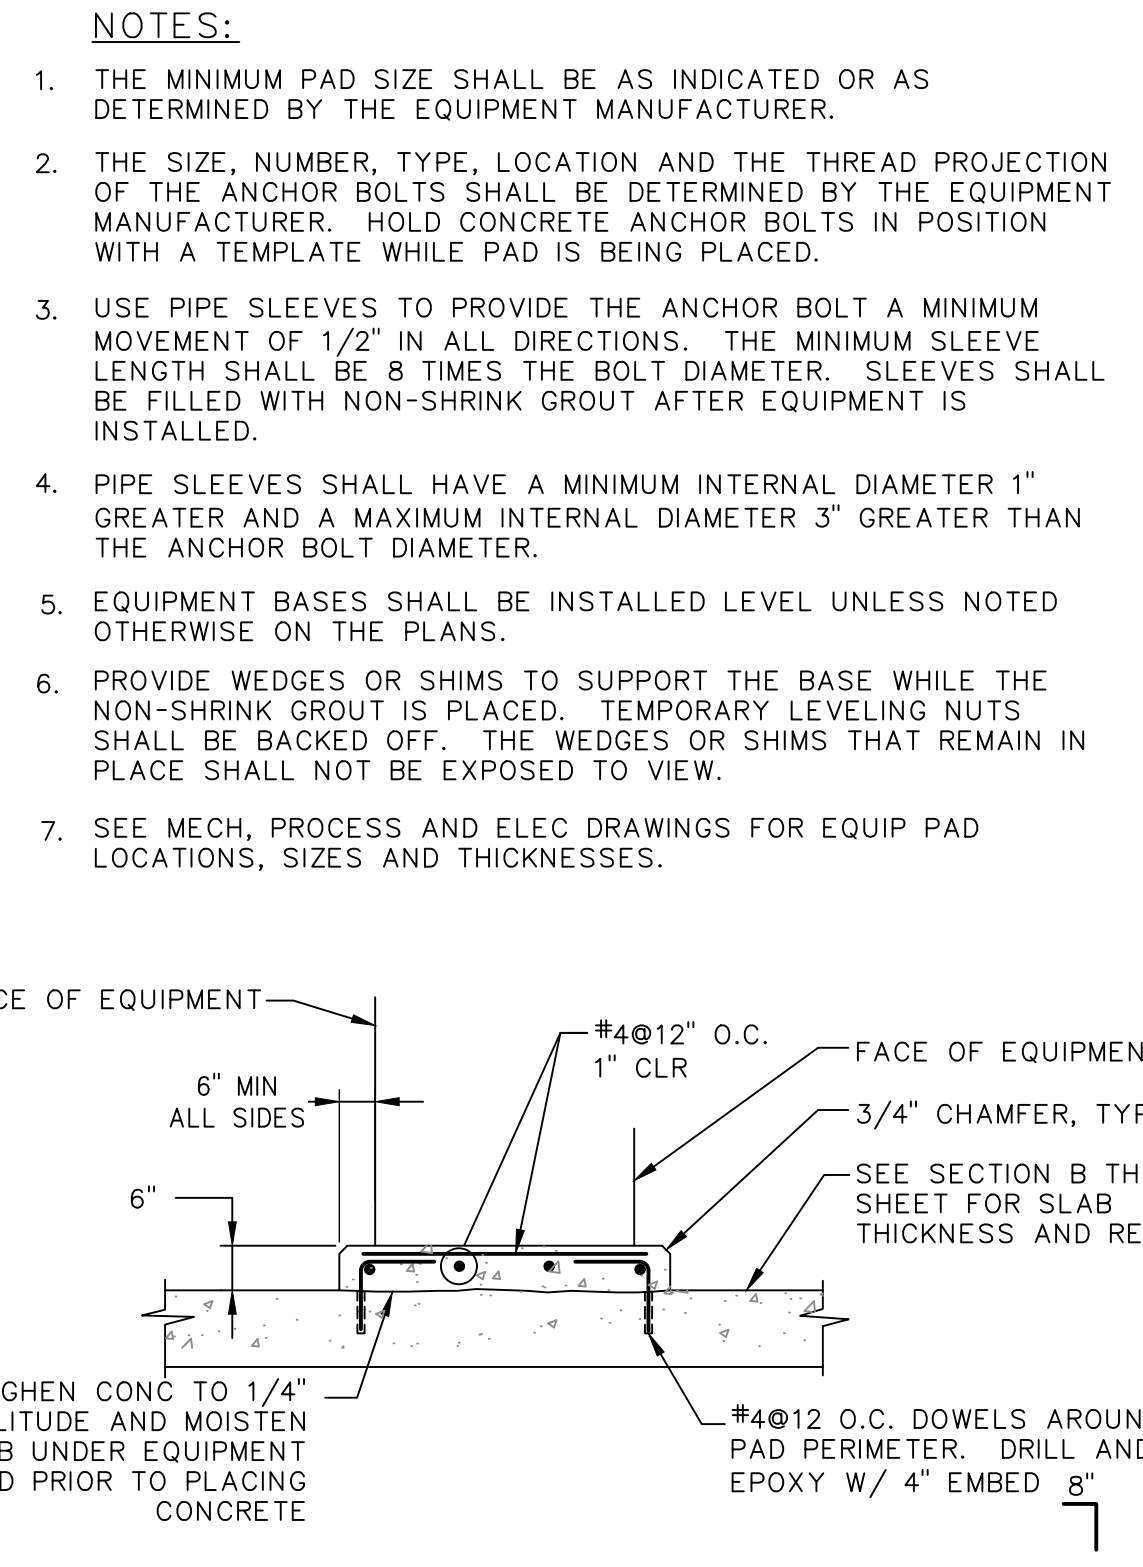


DETAIL 3 EQUIPMENT PAD
NTS

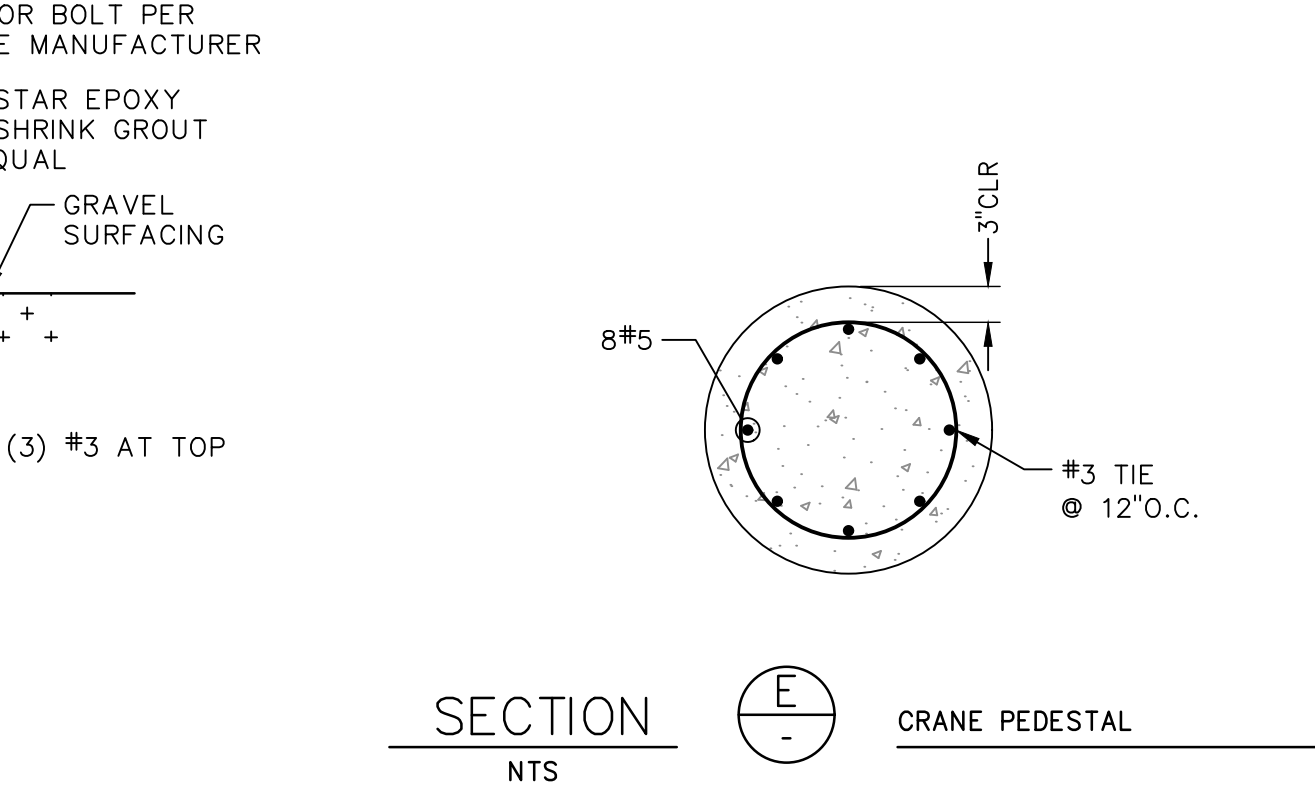


SECTION E CRANE PEDESTAL
NTS

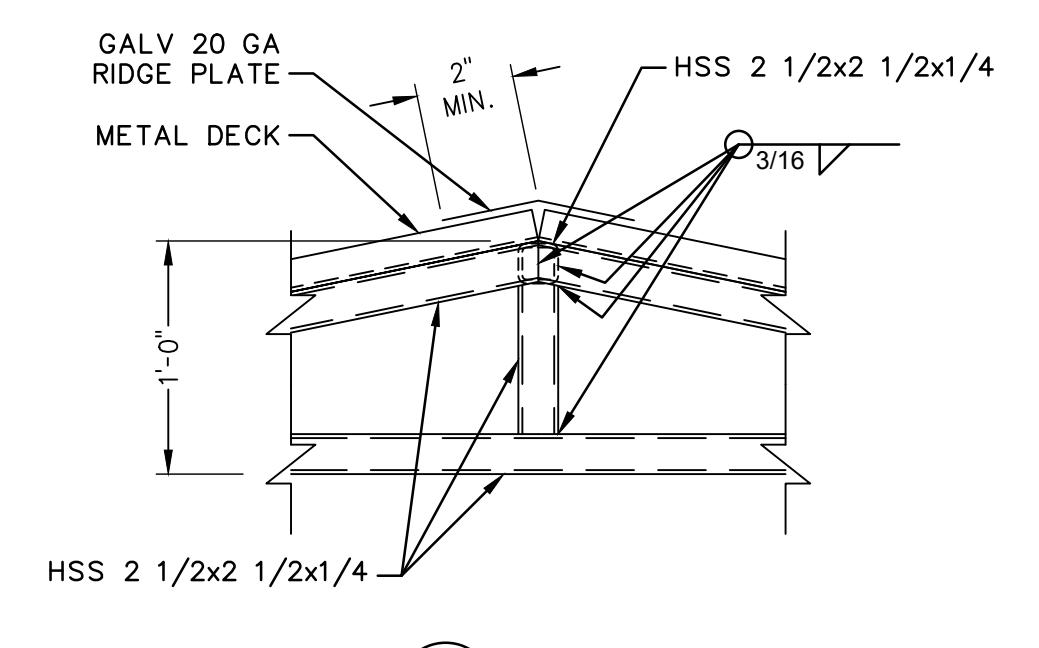


SECTION C TYPICAL STRUCTURE FRAMING
1"=1'-0"

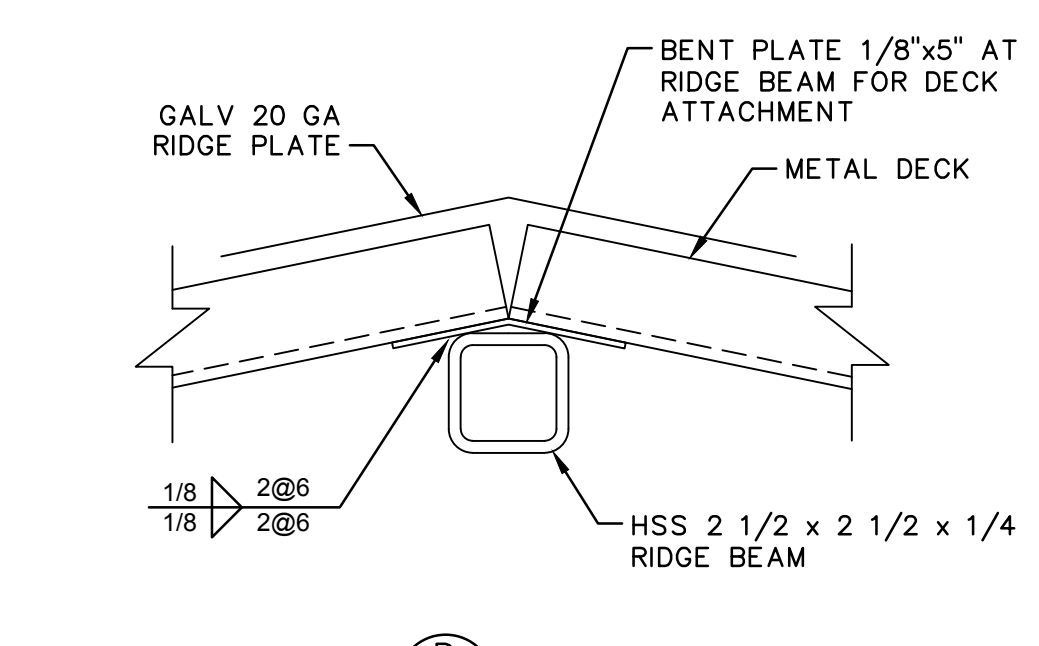


SECTION D TYPICAL STRUCTURE FRAMING
3"=1'-0"

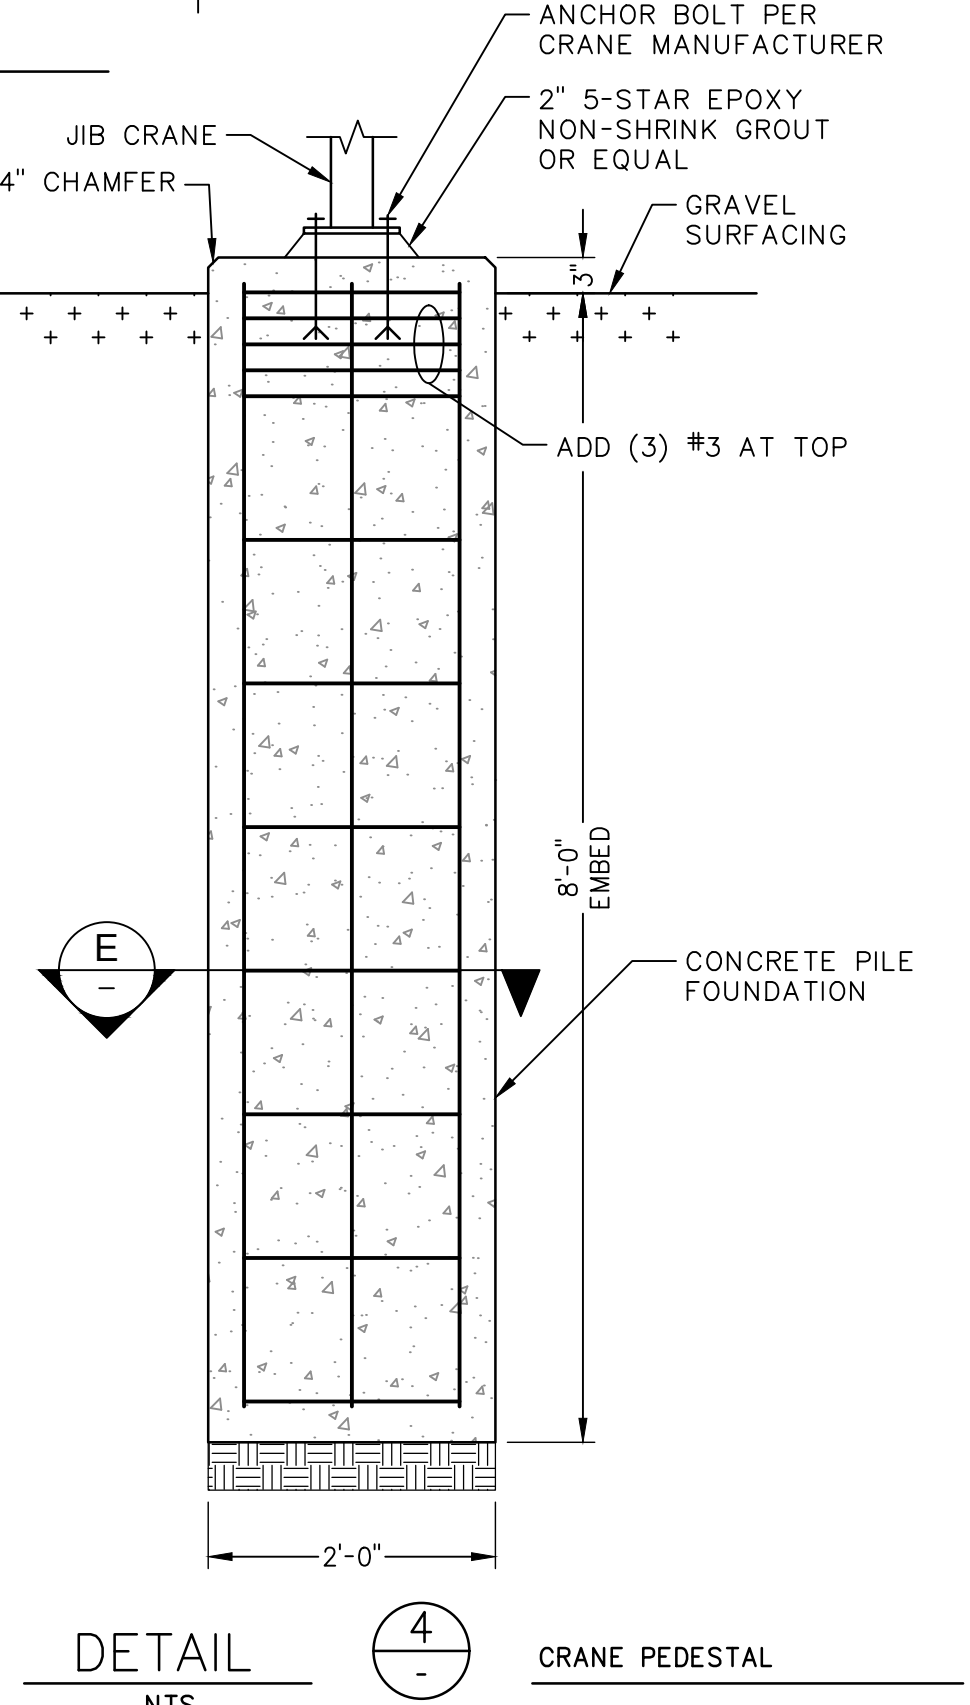


DETAIL 4 CRANE PEDESTAL
NTS

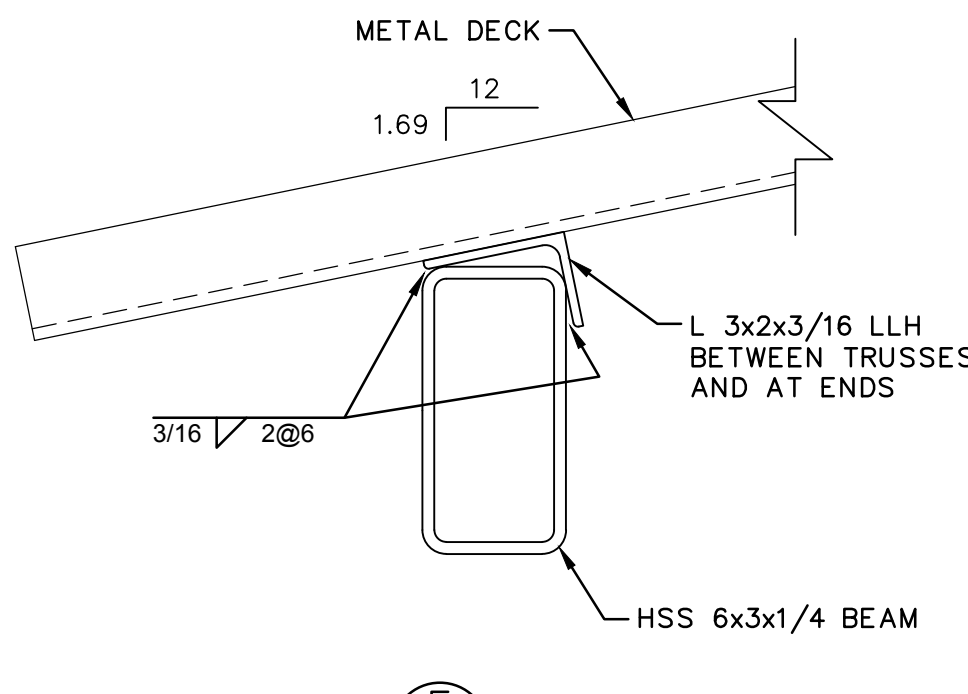


SECTION F TYPICAL STRUCTURE FRAMING
3"=1'-0"

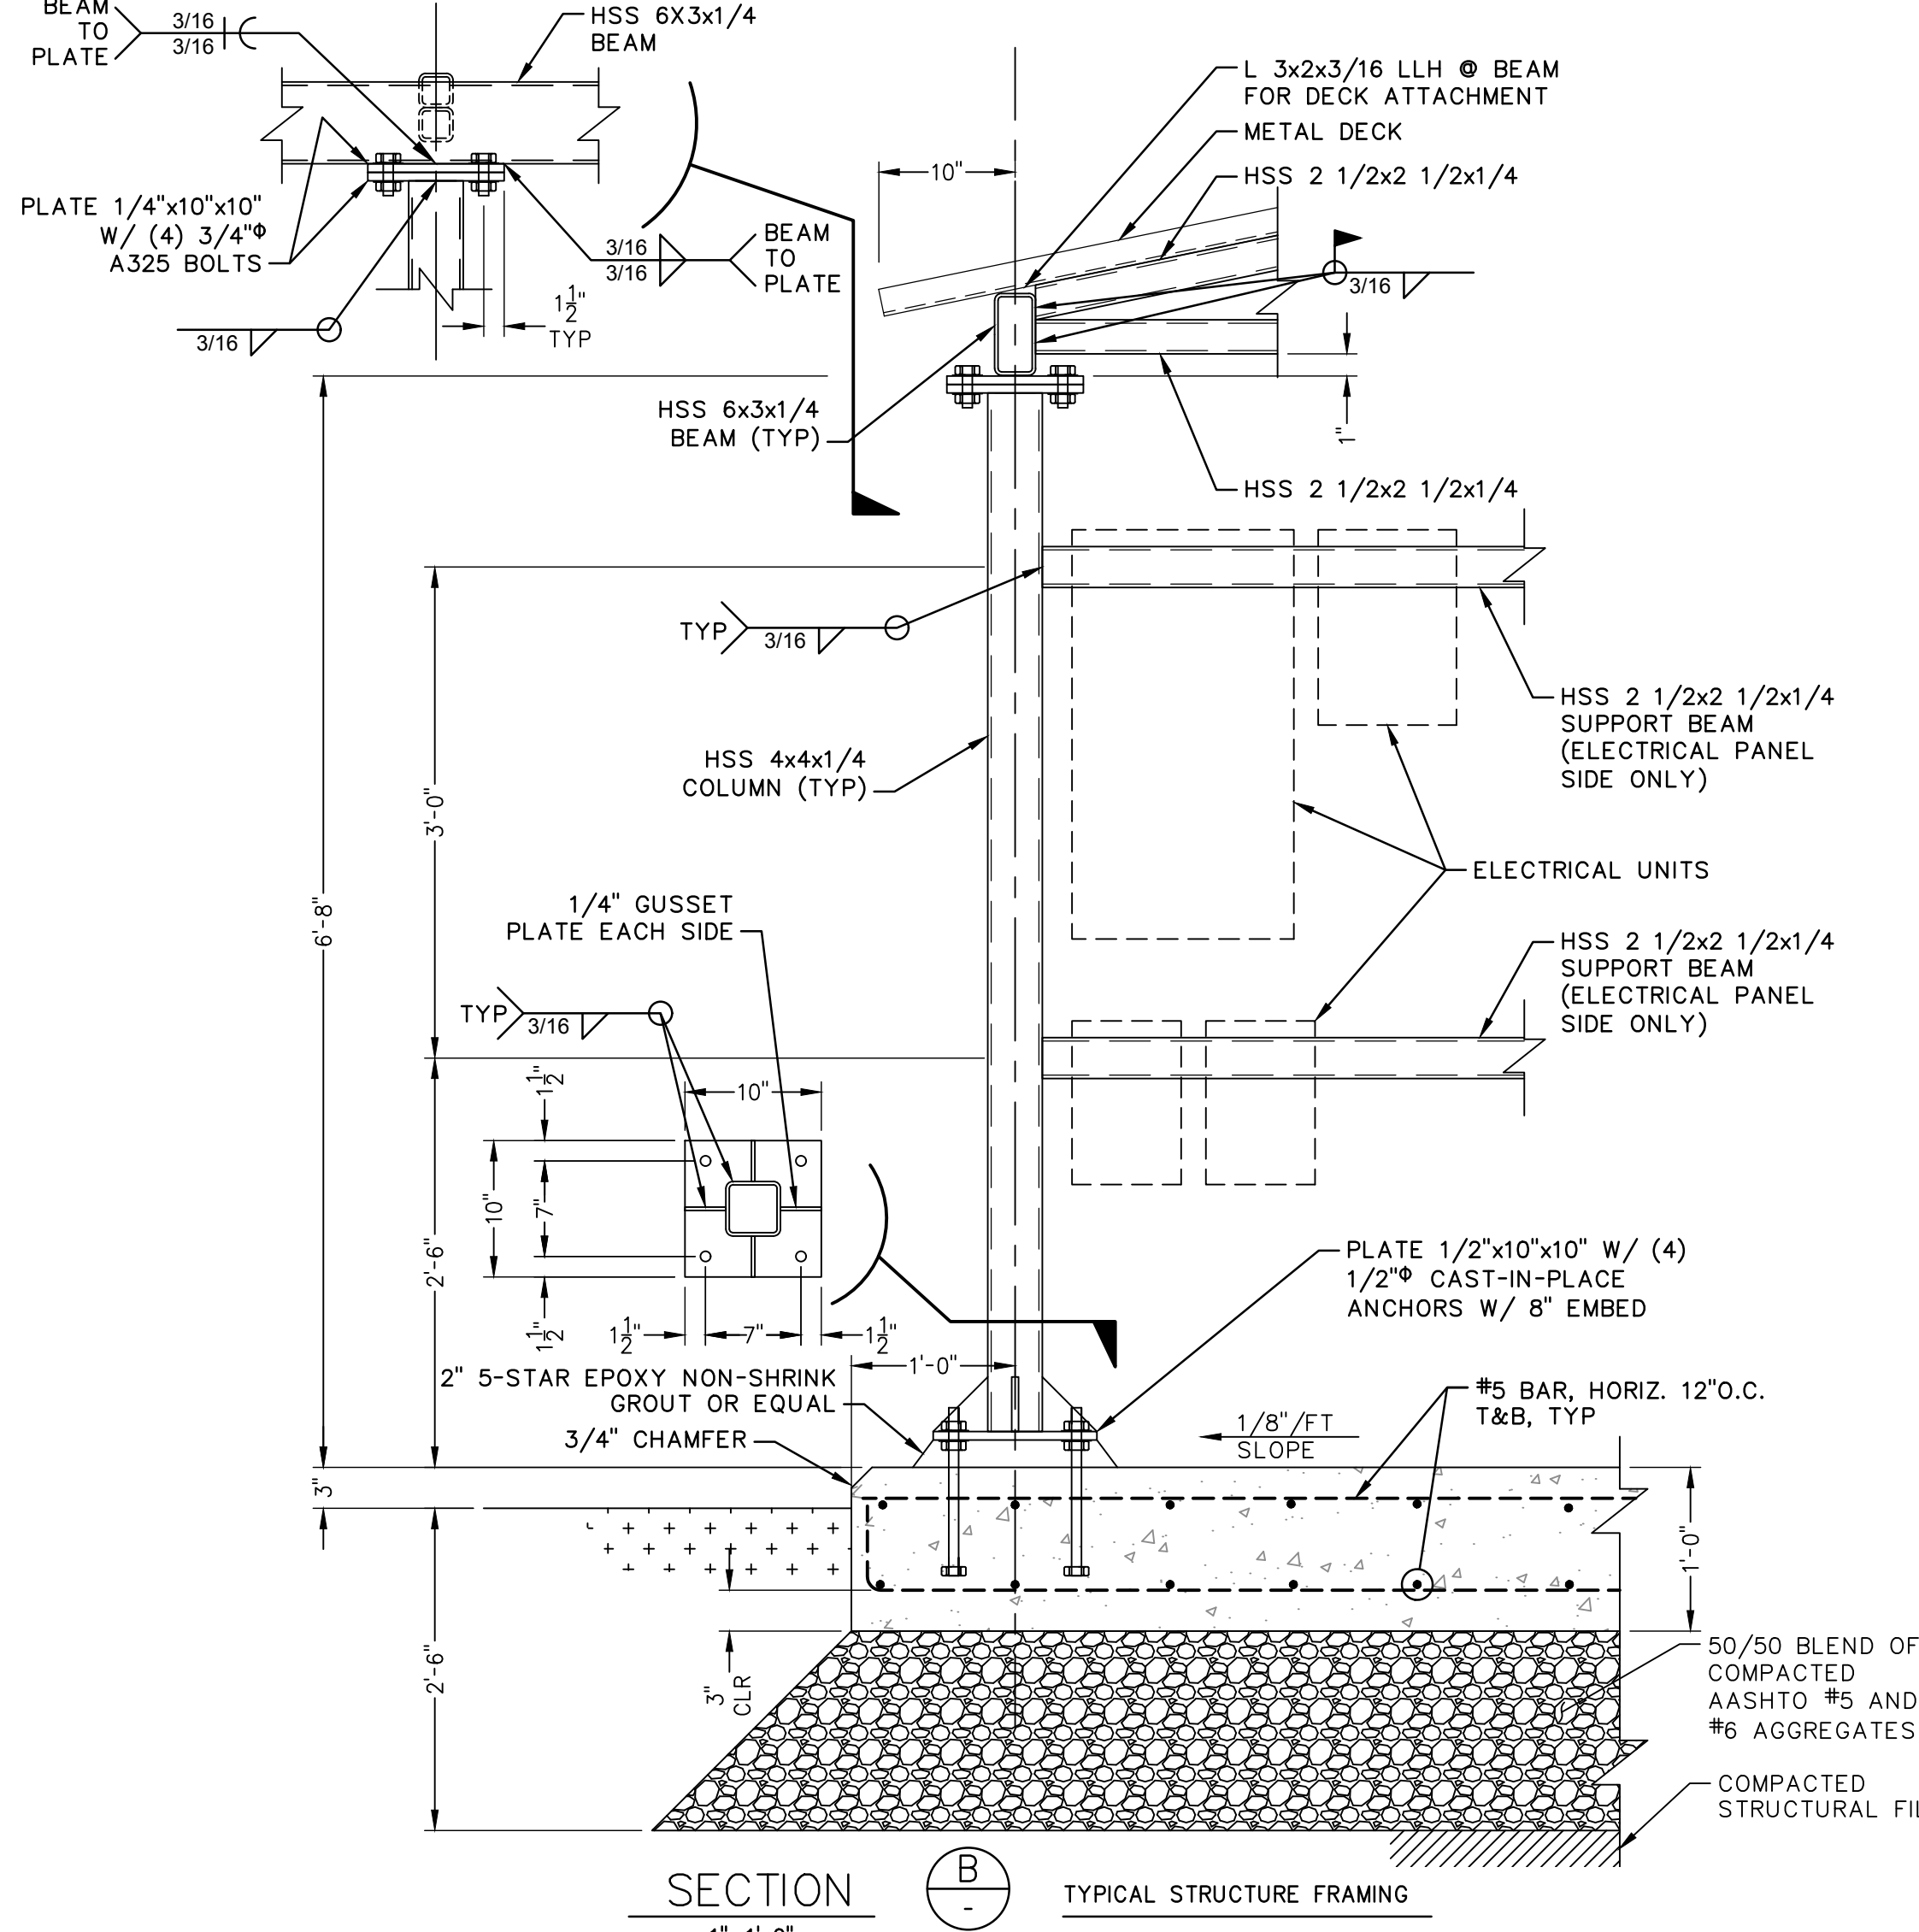

SECTION B TYPICAL STRUCTURE FRAMING
1"=1'-0"

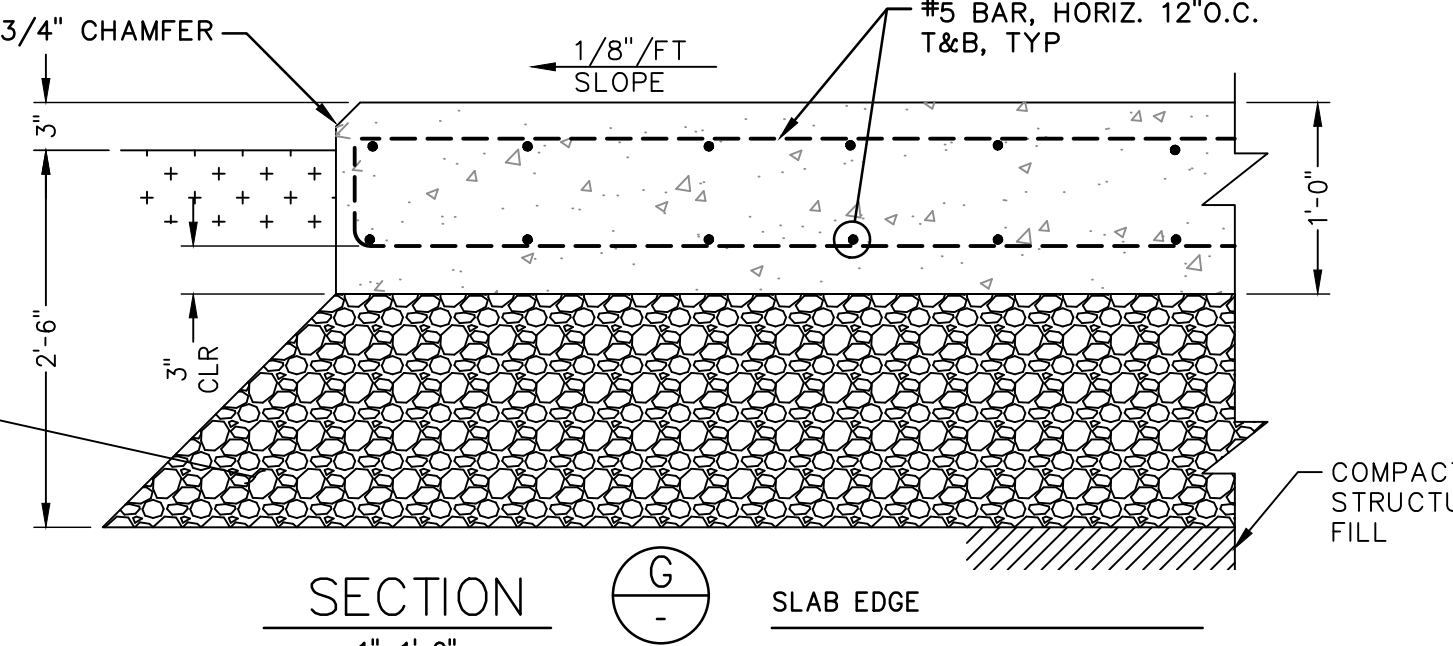

SECTION G SLAB EDGE
1"=1'-0"

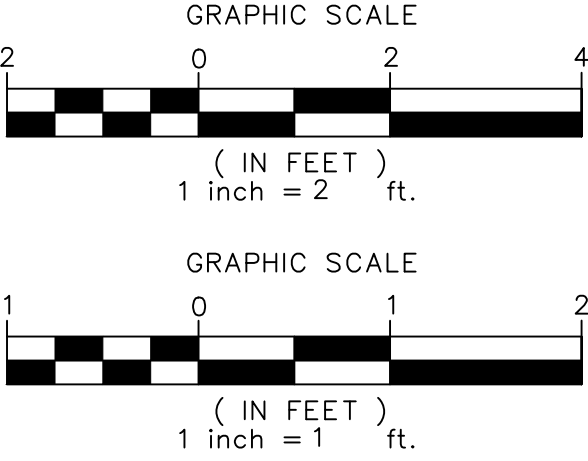

- NOTES:
1. THE MINIMUM PAD SIZE SHALL BE AS INDICATED OR AS DETERMINED BY THE EQUIPMENT MANUFACTURER.
 2. THE SIZE, NUMBER, TYPE, LOCATION AND THE THREAD PROJECTION OF THE ANCHOR BOLTS SHALL BE DETERMINED BY THE EQUIPMENT MANUFACTURER. HOLD CONCRETE ANCHOR BOLTS IN POSITION WITH A TEMPLATE WHILE PAD IS BEING PLACED.
 3. USE PIPE SLEEVES TO PROVIDE THE ANCHOR BOLT A MINIMUM MOVEMENT OF 1/2" IN ALL DIRECTIONS. THE MINIMUM SLEEVE LENGTH SHALL BE 8 TIMES THE BOLT DIAMETER. SLEEVES SHALL BE FILLED WITH NON-SHRINK GROUT AFTER EQUIPMENT IS INSTALLED.
 4. PIPE SLEEVES SHALL HAVE A MINIMUM INTERNAL DIAMETER 1" GREATER AND A MAXIMUM INTERNAL DIAMETER 3" GREATER THAN THE ANCHOR BOLT DIAMETER.
 5. EQUIPMENT BASES SHALL BE INSTALLED LEVEL UNLESS NOTED OTHERWISE ON THE PLANS.
 6. PROVIDE WEDGES OR SHIMS TO SUPPORT THE BASE WHILE THE NON-SHRINK GROUT IS PLACED. TEMPORARY LEVELING NUTS SHALL BE BACKED OFF. THE WEDGES OR SHIMS THAT REMAIN IN PLACE SHALL NOT BE EXPOSED TO VIEW.
 7. SEE MECH, PROCESS AND ELEC DRAWINGS FOR EQUIP PAD LOCATIONS, SIZES AND THICKNESSES.

CONSTRUCTION NOTES:

1. THE CONTRACTOR SHALL FIELD VERIFY ALL EXISTING CONDITIONS, DIMENSIONS, AND ELEVATIONS PRIOR TO START OF CONSTRUCTION AS REQUIRED TO COORDINATE NEW CONSTRUCTION. NOTIFY ENGINEER OF ANY DISCREPANCIES OR CONFLICTS FOUND IN CONTRACT DOCUMENTS AND/OR FIELD CONDITIONS.

KEY NOTES:

- 1 NEW RETURN WATER POND PUMPS, SEE MECHANICAL FOR ADDITIONAL INFORMATION.
- 2 76"x40"x6" THICK EQUIPMENT PAD, SEE DETAIL 3 THIS SHEET.
- 3 ROOF FRAMING MEMBER HSS 2 1/2 x 2 1/2 x 1/4 ABOVE.
- 4 ROOF FRAMING MEMBER HSS 2 1/2 x 2 1/2 x 1/4 BELOW.
- 5 ROOF FRAMING MEMBER HSS 6 x 3 x 1/4.
- 6 RIDGE BEAM HSS 2 1/2 x 2 1/2 x 1/4.
- 7 VULCRAFT TYPE 1.5A 20 GA GALV. METAL DECK. FASTEN WITH #12 SCREWS W/ NEOPRENE WASHERS @ 36" PATTERN AT SUPPORTS AND #12 SCREWS @ 12" O.C. SIDE LAPS.

THESE RECORD DRAWINGS DATED 01/17/20 AND TITLED "FOR RECORD" HAVE BEEN DEVELOPED FROM AS-BUILT MARKUPS AND MAY NOT REPRESENT THE FINAL PROJECT, AS CONSTRUCTED, IN EVERY DETAIL. THESE RECORD DRAWINGS HAVE BEEN PREPARED BASED ON INFORMATION SUPPLIED BY OTHERS AND THE ENGINEER HAS NOT VERIFIED THE ACCURACY OR COMPLETENESS OF THE INFORMATION.

NO.	DATE	REVISION	DWN	CHD	EXD	RWD	APVD	W.A.
2	01-17-20	FOR RECORD	AWF	DEM				FCC06814
1	12/20/18	REVISED AGGREGATE	LDB	HM				REH

FOUR CORNERS POWER PLANT
RETURN WATER POND
STRUCTURAL SECTIONS AND DETAILS



SCALE AS NOTED DATE 10/04/19


APPROVED
ROBERT E. HAWTHORNE
DRAWING APPROVED BY

UNIT DISC TYPE SYS SUBSYS NUMBER SHEET
FC45CM S 65 WP AP 200485 26



WORK SAFELY TODAY

THIS DRAWING IS CONFIDENTIAL AND SHALL NOT BE USED OR REPRODUCED IN ANY PART WITHOUT WRITTEN CONSENT OF PINNACLE WEST CAPITAL CORPORATION.

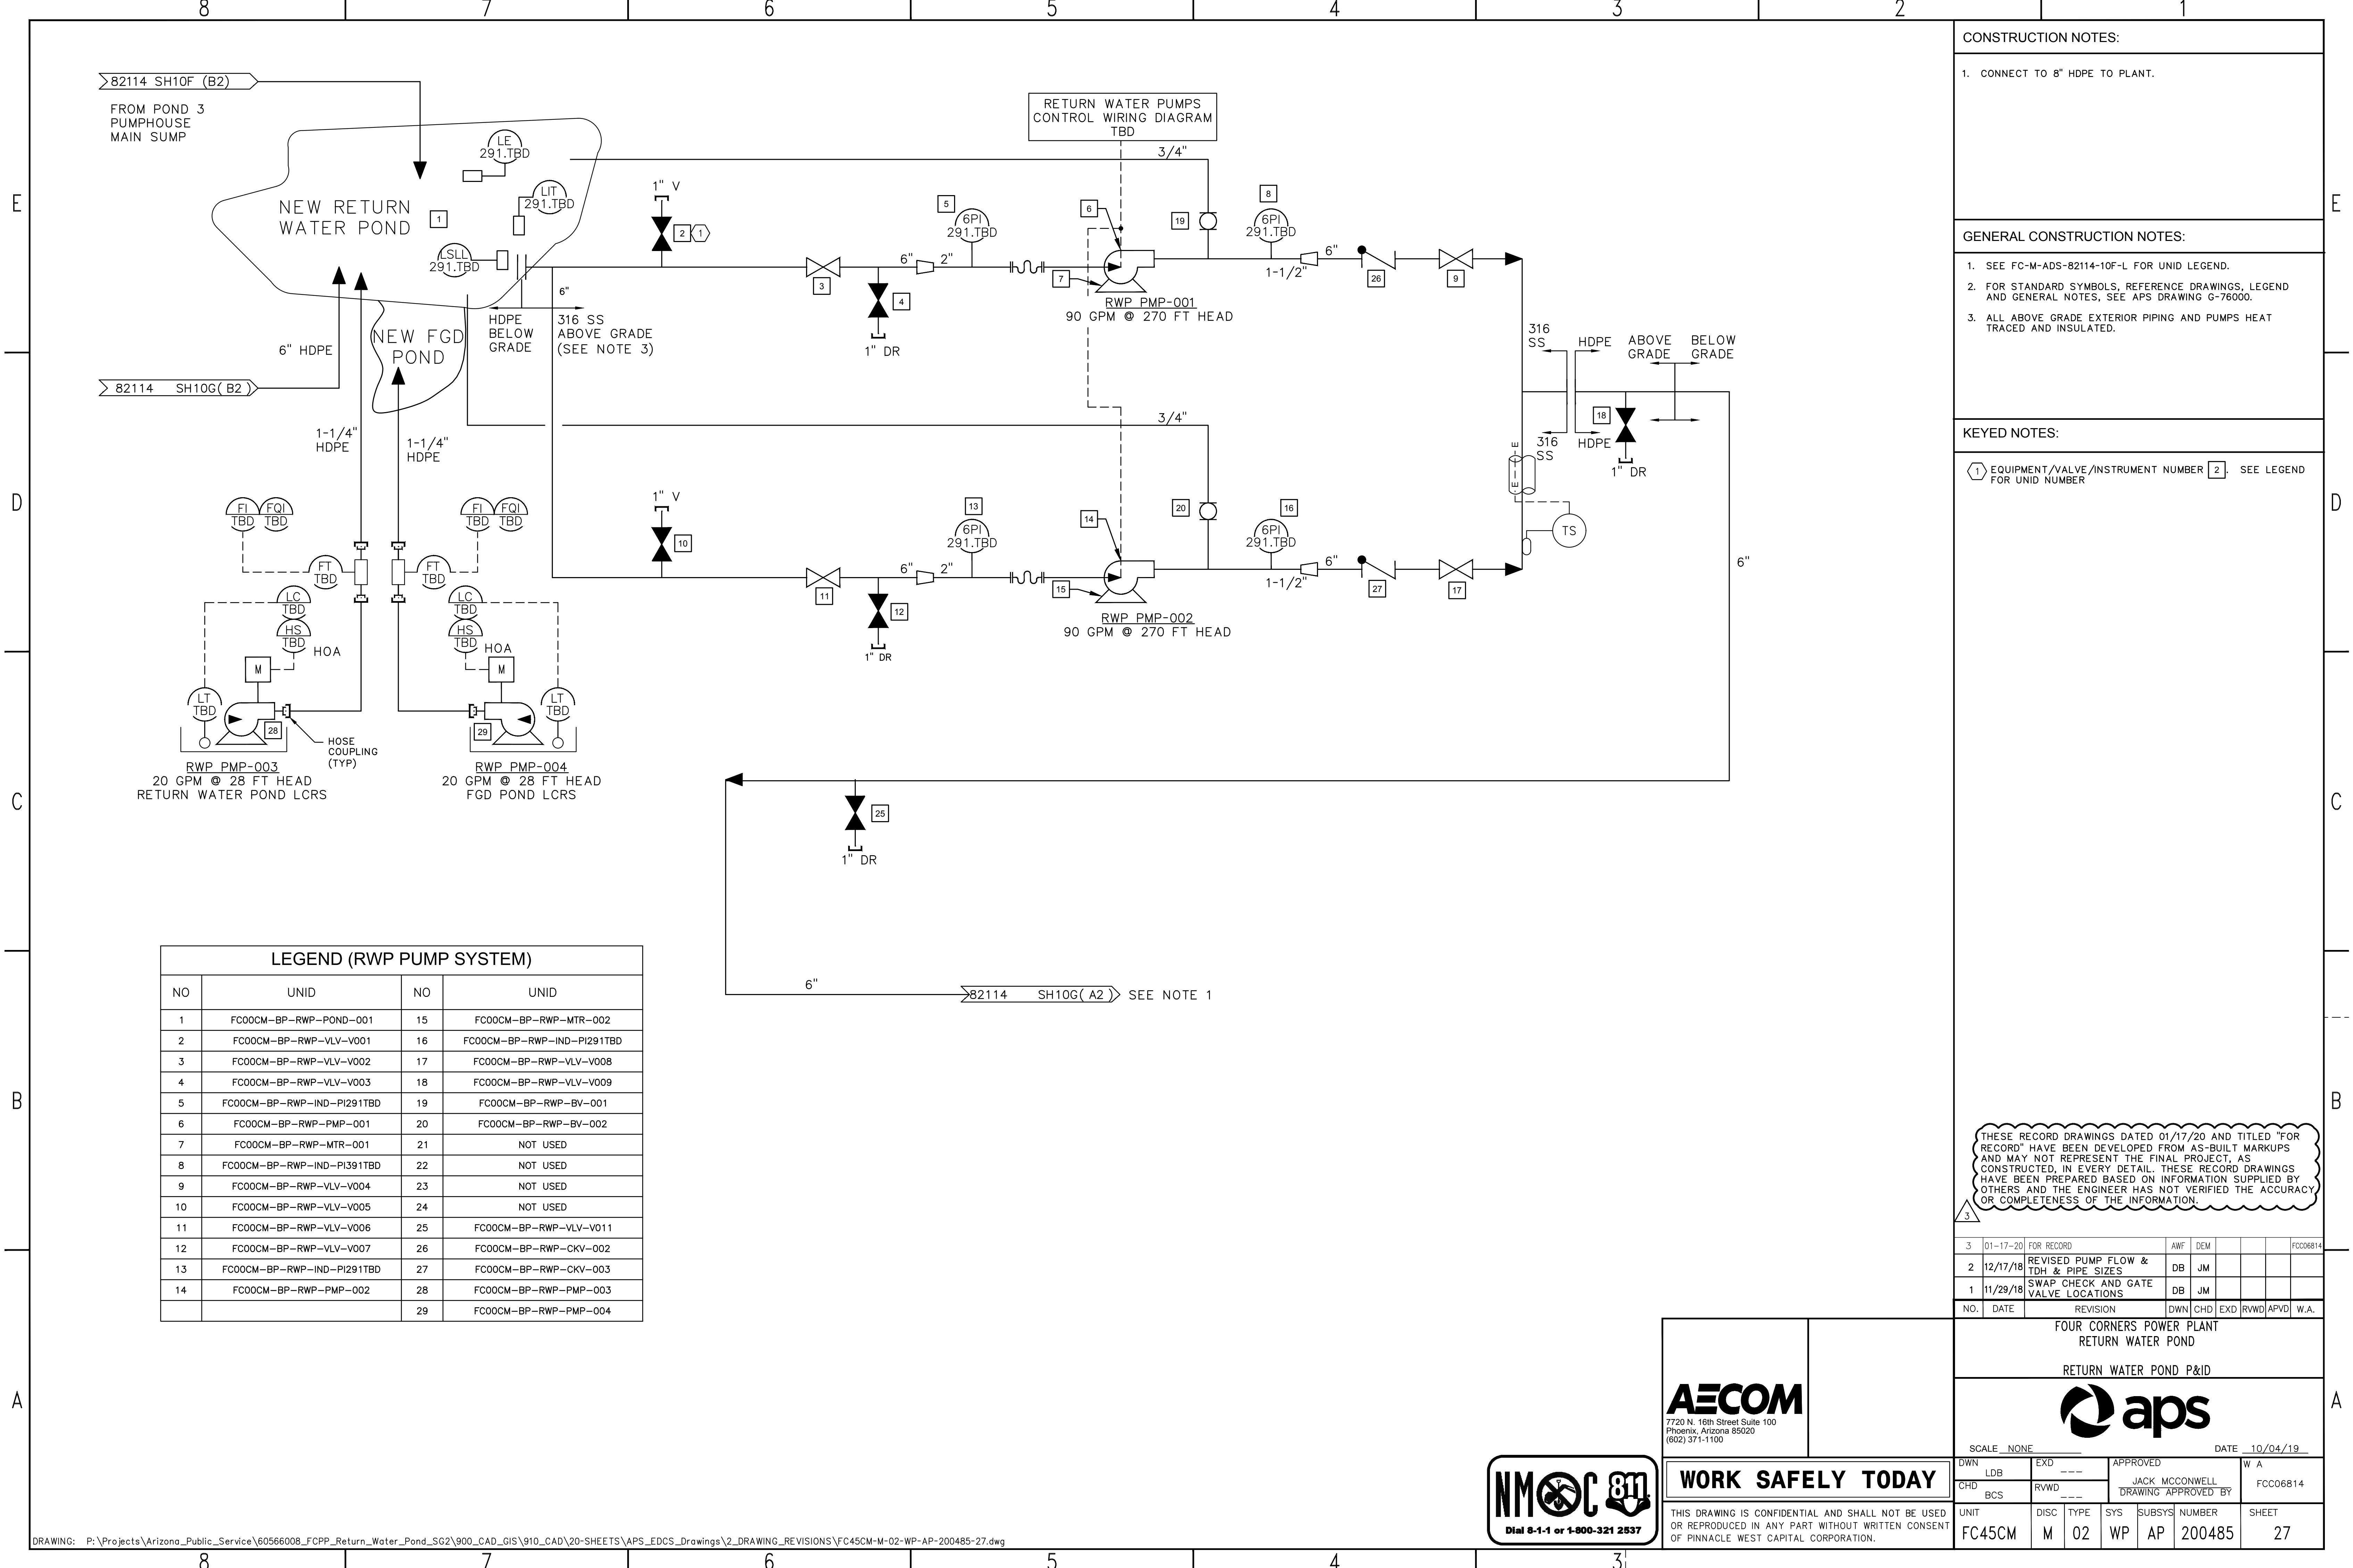

CONSTRUCTION NOTES:

- CONNECT TO 8" HDPE TO PLANT.

GENERAL CONSTRUCTION NOTES:

- SEE FC-M-ADS-82114-10F-L FOR UNID LEGEND.
- FOR STANDARD SYMBOLS, REFERENCE DRAWINGS, LEGEND AND GENERAL NOTES, SEE APS DRAWING G-76000.
- ALL ABOVE GRADE EXTERIOR PIPING AND PUMPS HEAT TRACED AND INSULATED.

KEYED NOTES:

① EQUIPMENT/VALVE/INSTRUMENT NUMBER ② SEE LEGEND FOR UNID NUMBER

THESE RECORD DRAWINGS DATED 01/17/20 AND TITLED "FOR RECORD" HAVE BEEN DEVELOPED FROM AS-BUILT MARKUPS AND MAY NOT REPRESENT THE FINAL PROJECT, AS CONSTRUCTED, IN EVERY DETAIL. THESE RECORD DRAWINGS HAVE BEEN PREPARED BASED ON INFORMATION SUPPLIED BY OTHERS AND THE ENGINEER HAS NOT VERIFIED THE ACCURACY OR COMPLETENESS OF THE INFORMATION.

LEGEND (RWP PUMP SYSTEM)			
NO	UNID	NO	UNID
1	FC00CM-BP-RWP-POND-001	15	FC00CM-BP-RWP-MTR-002
2	FC00CM-BP-RWP-VLV-V001	16	FC00CM-BP-RWP-IND-PI291TBD
3	FC00CM-BP-RWP-VLV-V002	17	FC00CM-BP-RWP-VLV-V008
4	FC00CM-BP-RWP-VLV-V003	18	FC00CM-BP-RWP-VLV-V009
5	FC00CM-BP-RWP-IND-PI291TBD	19	FC00CM-BP-RWP-BV-001
6	FC00CM-BP-RWP-PMP-001	20	FC00CM-BP-RWP-BV-002
7	FC00CM-BP-RWP-MTR-001	21	NOT USED
8	FC00CM-BP-RWP-IND-PI391TBD	22	NOT USED
9	FC00CM-BP-RWP-VLV-V004	23	NOT USED
10	FC00CM-BP-RWP-VLV-V005	24	NOT USED
11	FC00CM-BP-RWP-VLV-V006	25	FC00CM-BP-RWP-VLV-V011
12	FC00CM-BP-RWP-VLV-V007	26	FC00CM-BP-RWP-CKV-002
13	FC00CM-BP-RWP-IND-PI291TBD	27	FC00CM-BP-RWP-CKV-003
14	FC00CM-BP-RWP-PMP-002	28	FC00CM-BP-RWP-PMP-003
		29	FC00CM-BP-RWP-PMP-004

AECOM
7720 N. 16th Street Suite 100
Phoenix, Arizona 85020
(602) 371-1100

WORK SAFELY TODAY


THIS DRAWING IS CONFIDENTIAL AND SHALL NOT BE USED OR REPRODUCED IN ANY PART WITHOUT WRITTEN CONSENT OF PINNACLE WEST CAPITAL CORPORATION.

aps

SCALE: NONE DATE: 10/04/19

FOUR CORNERS POWER PLANT
RETURN WATER POND
RETURN WATER POND P&ID

NO.	DATE	REVISION	DWN	CHD	EXD	RWVD	APVD	W.A.
3	01-17-20	FOR RECORD	AWF	DEM				FCC06814
2	12/17/18	REVISED PUMP FLOW & TDH & PIPE SIZES	DB	JM				
1	11/29/18	SWAP CHECK AND GATE VALVE LOCATIONS	DB	JM				

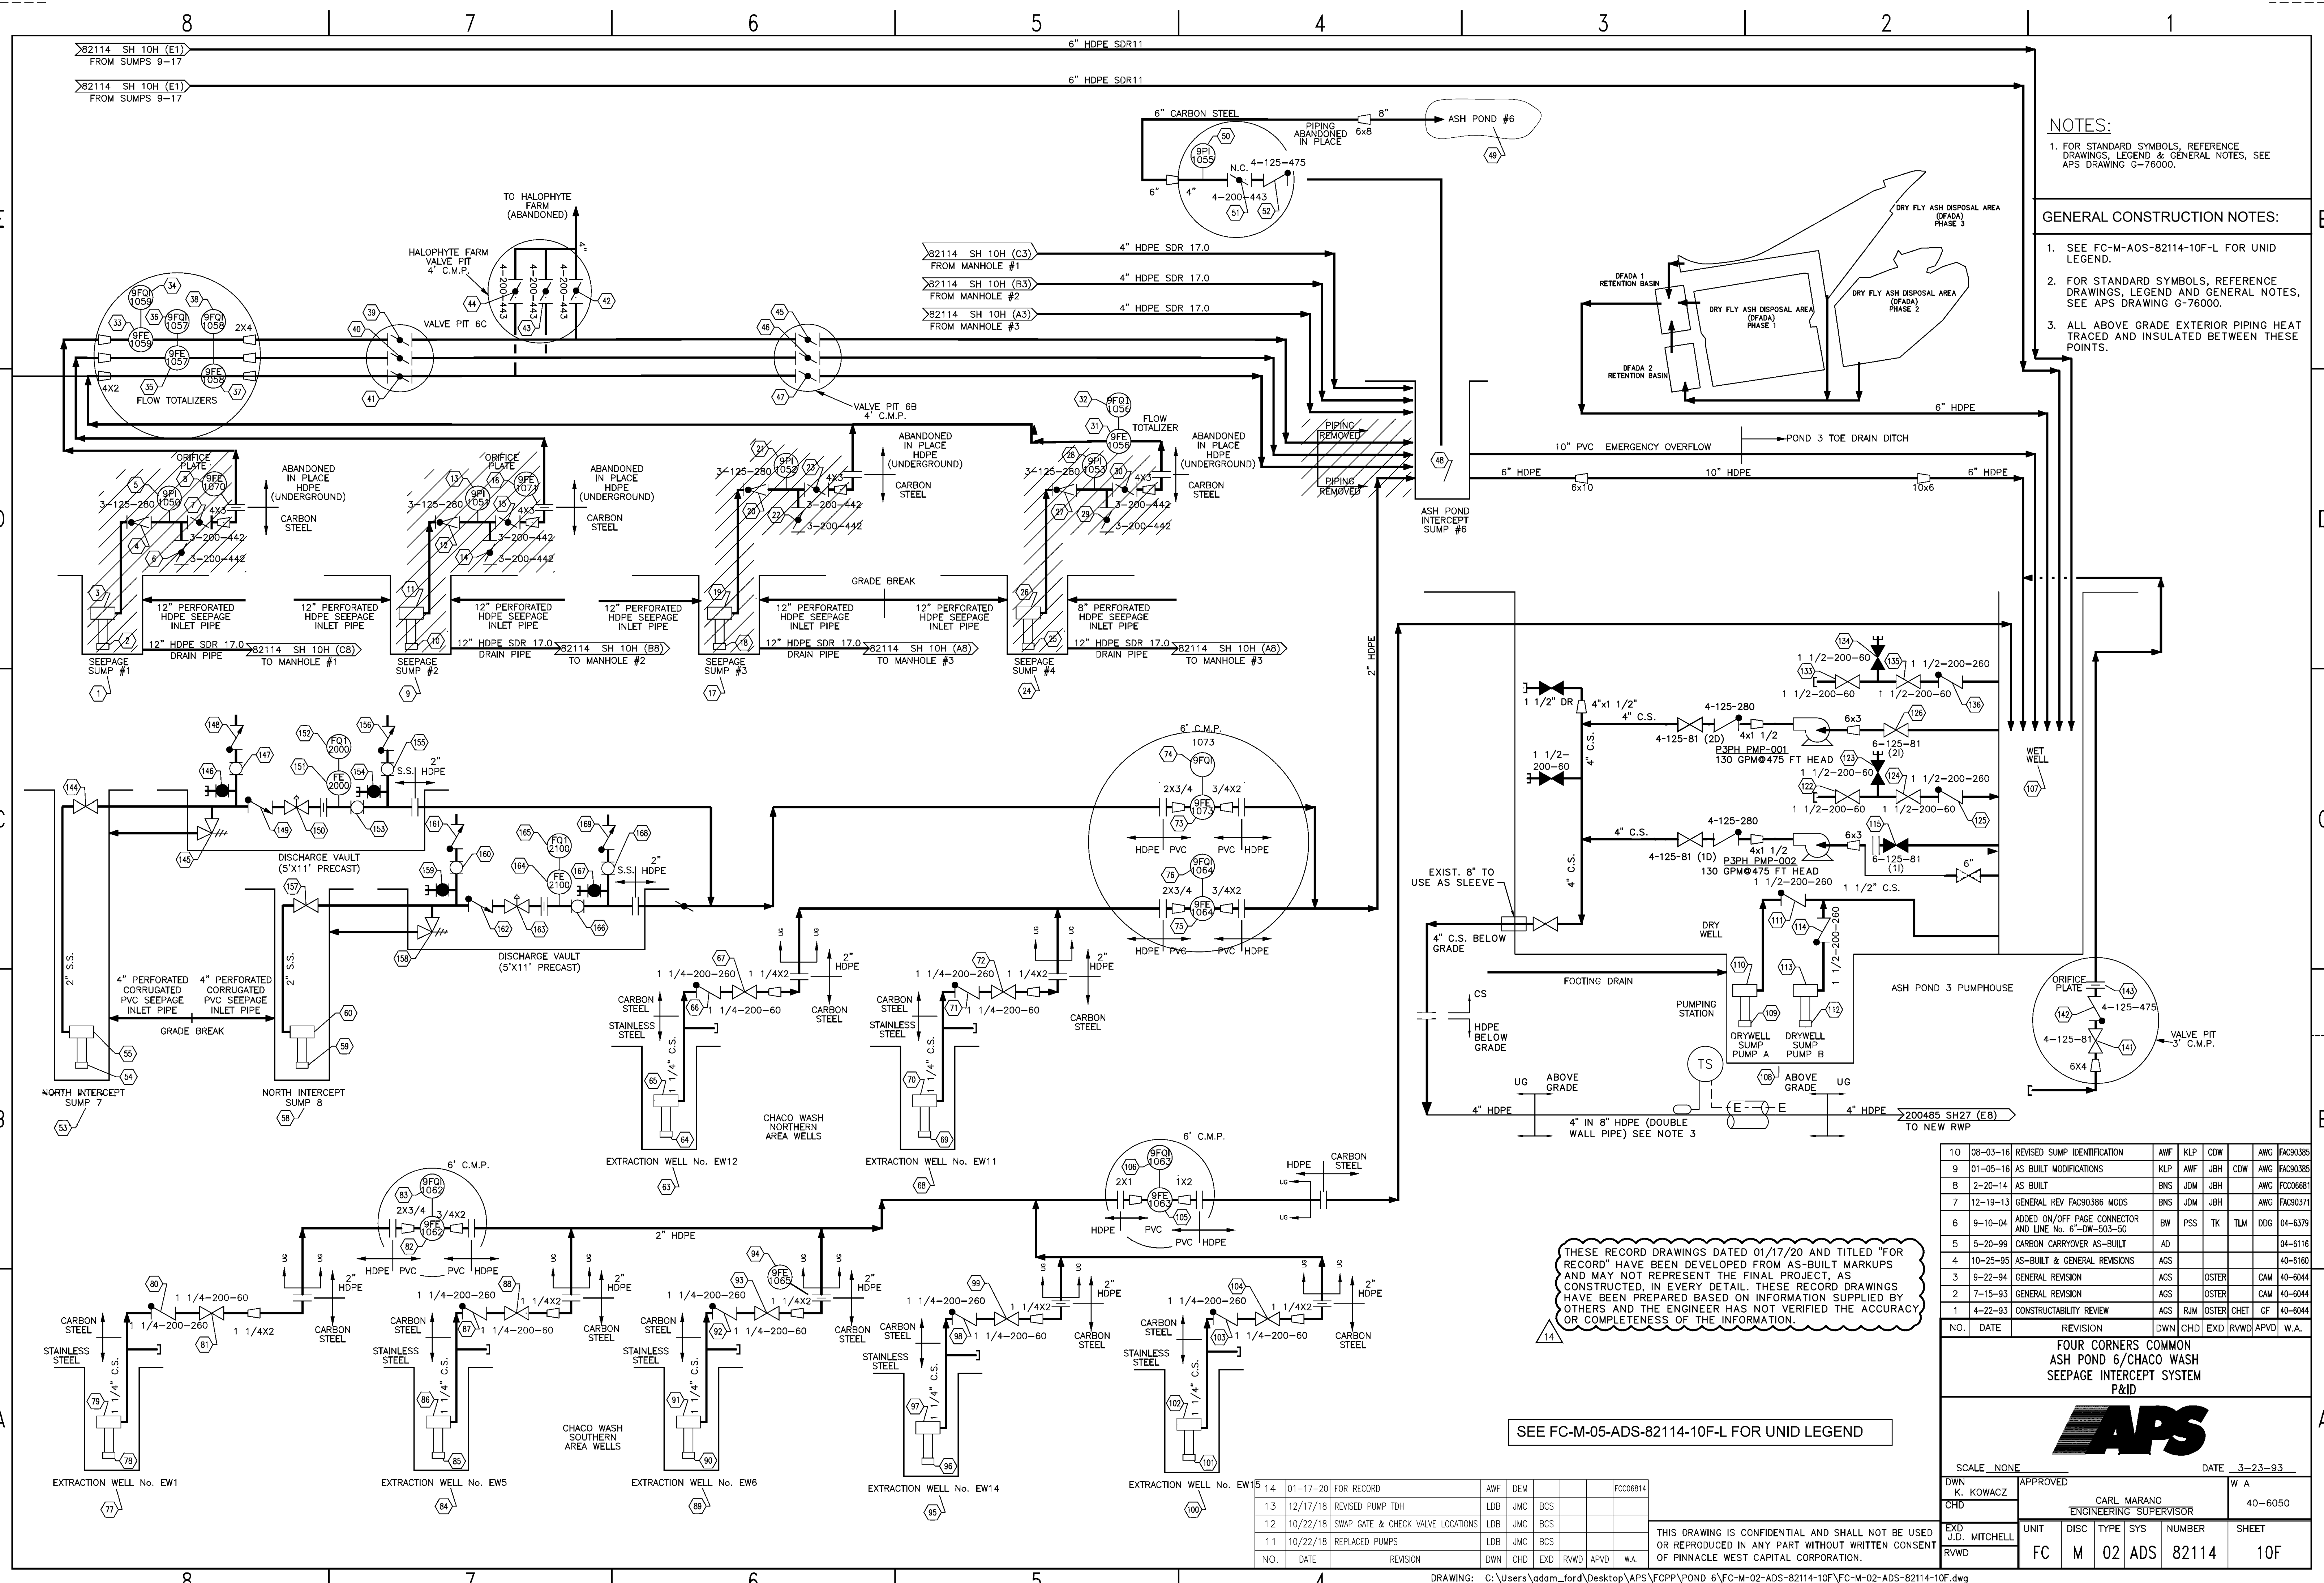

NOTES:
 1. FOR STANDARD SYMBOLS, REFERENCE DRAWINGS, LEGEND & GENERAL NOTES, SEE APS DRAWING G-76000.

GENERAL CONSTRUCTION NOTES:

1. SEE FC-M-AOS-82114-10F-L FOR UNID LEGEND.
2. FOR STANDARD SYMBOLS, REFERENCE DRAWINGS, LEGEND AND GENERAL NOTES, SEE APS DRAWING G-76000.
3. ALL ABOVE GRADE EXTERIOR PIPING HEAT TRACED AND INSULATED BETWEEN THESE POINTS.

THESE RECORD DRAWINGS DATED 01/17/20 AND TITLED "FOR RECORD" HAVE BEEN DEVELOPED FROM AS-BUILT MARKUPS AND MAY NOT REPRESENT THE FINAL PROJECT, AS CONSTRUCTED, IN EVERY DETAIL. THESE RECORD DRAWINGS HAVE BEEN PREPARED BASED ON INFORMATION SUPPLIED BY OTHERS AND THE ENGINEER HAS NOT VERIFIED THE ACCURACY OR COMPLETENESS OF THE INFORMATION.

SEE FC-M-05-ADS-82114-10F-L FOR UNID LEGEND

NO.	DATE	REVISION	DWN	CHD	EXD	RWVD	APVD	W.A.
10	08-03-16	REVISED SUMP IDENTIFICATION	AWF	KLP	CDW			AWG FAC30385
9	01-05-16	AS BUILT MODIFICATIONS	KLP	AWF	JBH	CDW		AWG FAC30385
8	2-20-14	AS BUILT	BNS	JDM	JBH			AWG FC026681
7	12-19-13	GENERAL REV FAC30386 MOOS	BNS	JDM	JBH			AWG FAC30371
6	9-10-04	ADDED ON/OFF PAGE CONNECTOR AND LINE No. 6-DW-503-50	BW	PSS	TK	TLM	DDG	04-6373
5	5-20-99	CARBON CARRYOVER AS-BUILT	AD					04-6116
4	10-25-95	AS-BUILT & GENERAL REVISIONS	AGS					40-6160
3	9-22-94	GENERAL REVISION	AGS		OSTER			CAM 40-6044
2	7-15-93	GENERAL REVISION	AGS		OSTER			CAM 40-6044
1	4-22-93	CONSTRUCTABILITY REVIEW	AGS	RM	OSTER	CHET	GF	40-6044


**FOUR CORNERS COMMON
 ASH POND 6/CHACO WASH
 SEEPAGE INTERCEPT SYSTEM
 P&ID**





SCALE NONE		DATE 3-23-93	
DWN	K. KOWACZ	APPROVED	W.A.
CHD		CARL MARANO	40-6050
EXD	J.D. MITCHELL	ENGINEERING SUPERVISOR	
RWVD			
UNIT	FC	DISC	M
TYPE	02	SYS	ADS
NUMBER	82114		
SHEET	10F		

NO.	DATE	REVISION	DWN	CHD	EXD	RWVD	APVD	W.A.
14	01-17-20	FOR RECORD	AWF	DEM				FC006814
13	12/17/18	REVISED PUMP TDH	LDB	JMC	BCS			
12	10/22/18	SWAP GATE & CHECK VALVE LOCATIONS	LDB	JMC	BCS			
11	10/22/18	REPLACED PUMPS	LDB	JMC	BCS			

THIS DRAWING IS CONFIDENTIAL AND SHALL NOT BE USED OR REPRODUCED IN ANY PART WITHOUT WRITTEN CONSENT OF PINNACLE WEST CAPITAL CORPORATION.

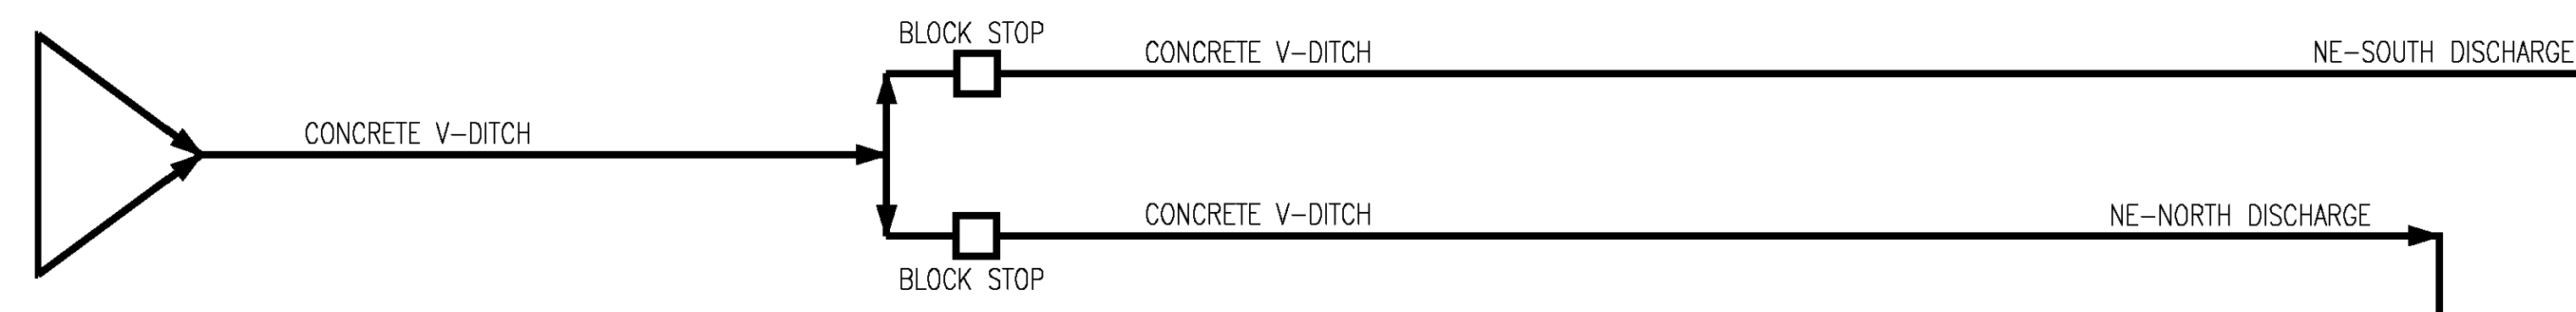

- NOTES:**
1. FOR STANDARD SYMBOLS, LEGENDS AND GENERAL NOTES, SEE APS DRAWING 76000 SHEETS 1 & 2.
- REFERENCE DRAWINGS**
1. FC-M-05-APS-152857-1, DECANT WATER POND PIPING PLANS & SECTIONS.
 2. FC-M-05-APS-152857-2, DECANT WATER POND, DEAD POOL PIPING, PLANS & SECTIONS.
 3. FC-M-05-APS-152857-3, DECANT WATER POND, PUMP SKID DETAILS.
 4. FC-M-05-ADS-152857-4, DECANT WATER POND, SKID/PIPE SUPPORT LOCATIONS.
 5. 22331 SHEET 43A-46A CONTROL WIRING DIAGRAM.
 6. 152743 SH. 1-20 ELECTRICAL REFERENCE DRAWINGS.
 7. 96819 SH. 28, 29 PIPING & INSULATION SCHEDULE

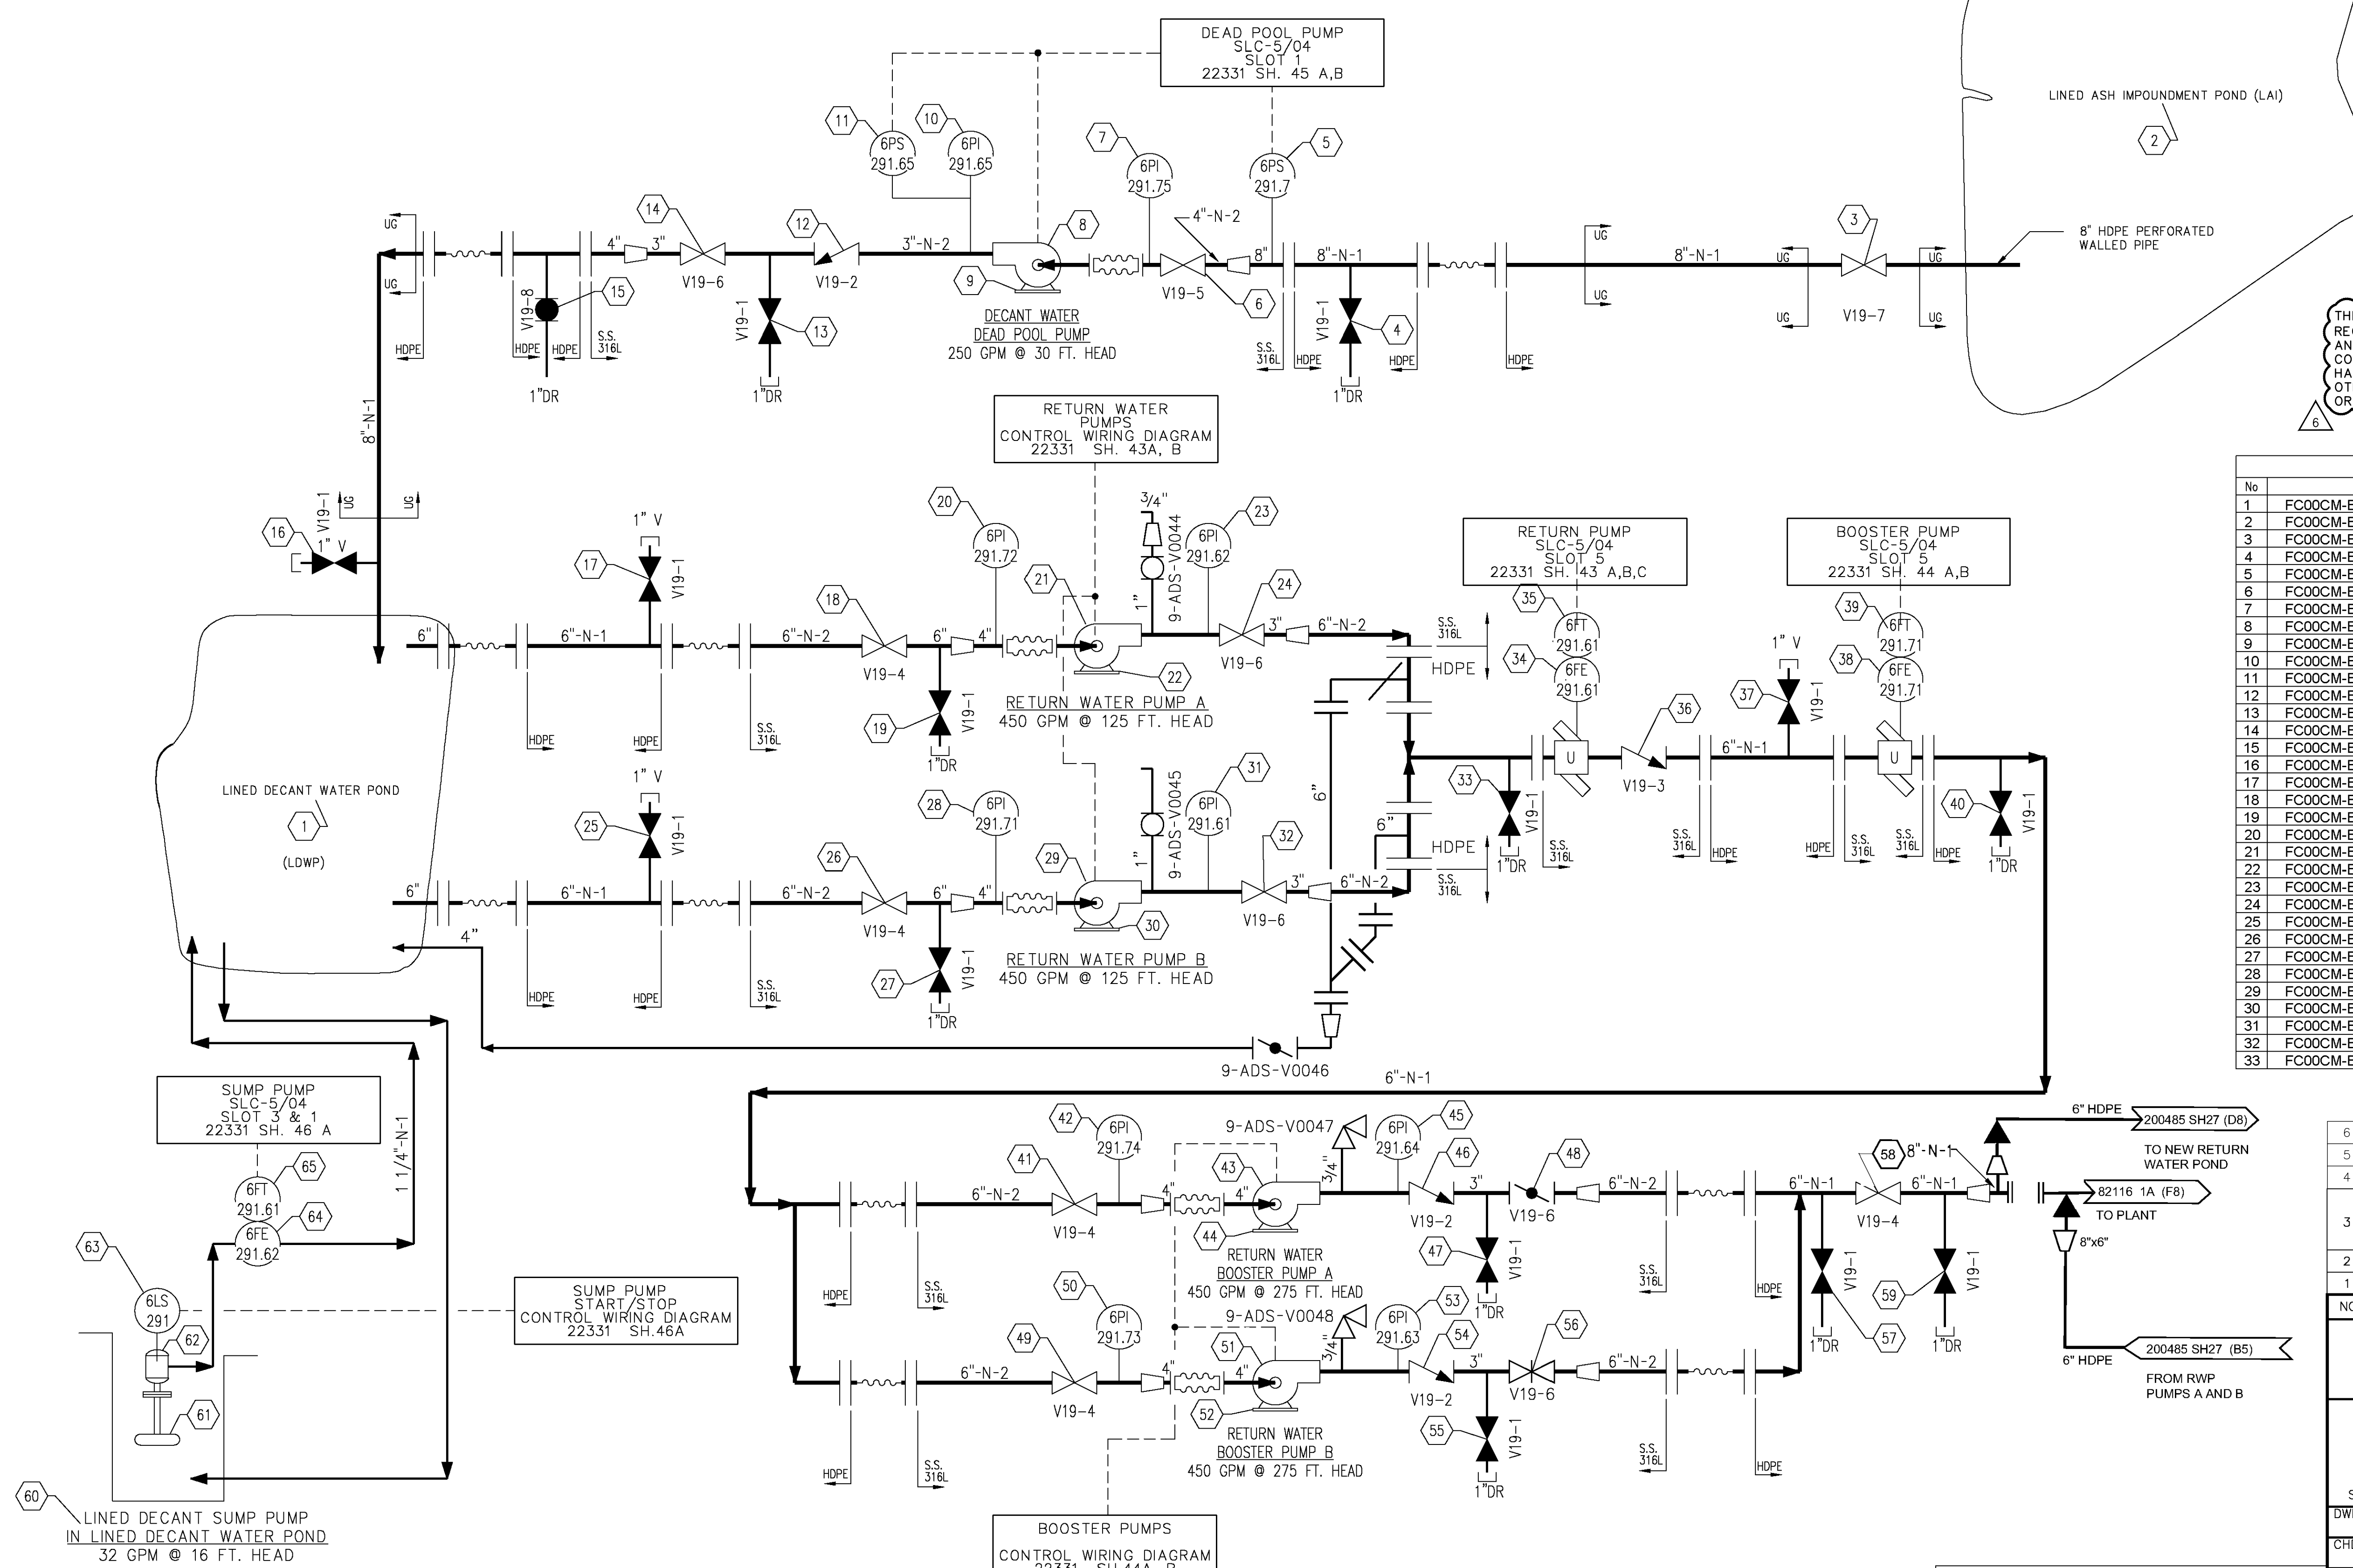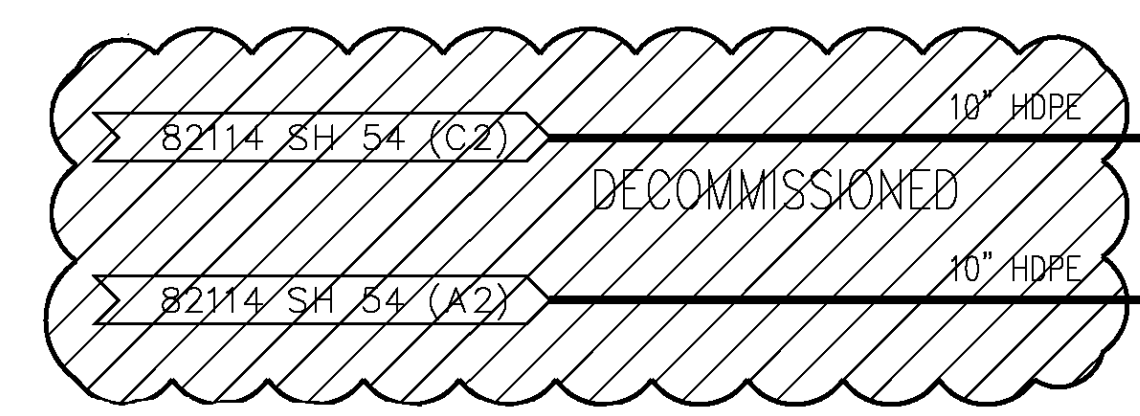

THESE RECORD DRAWINGS DATED 01/17/20 AND TITLED "FOR RECORD" HAVE BEEN DEVELOPED FROM AS-BUILT MARKUPS AND MAY NOT REPRESENT THE FINAL PROJECT, AS CONSTRUCTED, IN EVERY DETAIL. THESE RECORD DRAWINGS HAVE BEEN PREPARED BASED ON INFORMATION SUPPLIED BY OTHERS AND THE ENGINEER HAS NOT VERIFIED THE ACCURACY OR COMPLETENESS OF THE INFORMATION.

LEGEND (Ash Pond System)

No	UNID	No	UNID
1	FC00CM-BP-AP-PND-LDWP	34	FC00CM-BP-AP-FLE-FE29161
2	FC00CM-BP-AP-PND-LAI	35	FC00CM-BP-AP-XMT-FT29161
3	FC00CM-BP-AP-VLV-V197	36	FC00CM-BP-AP-CKV-193
4	FC00CM-BP-AP-VLV-V191	37	FC00CM-BP-AP-VLV-V208
5	FC00CM-BP-AP-SWT-PS2917	38	FC00CM-BP-AP-FLE-FE29171
6	FC00CM-BP-AP-VLV-V195	39	FC00CM-BP-AP-XMT-FT29171
7	FC00CM-BP-AP-IND-PI29175	40	FC00CM-BP-AP-VLV-V209
8	FC00CM-BP-AP-MTR-291	41	FC00CM-BP-AP-VLV-V210
9	FC00CM-BP-AP-MTR-291	42	FC00CM-BP-AP-IND-PI29174
10	FC00CM-BP-AP-IND-PI29165	43	FC00CM-BP-AP-MTR-294
11	FC00CM-BP-AP-SWT-PS29165	44	FC00CM-BP-AP-MTR-294
12	FC00CM-BP-AP-CKV-V192	45	FC00CM-BP-AP-IND-PI29164
13	FC00CM-BP-AP-VLV-V193	46	FC00CM-BP-AP-CKV-194
14	FC00CM-BP-AP-VLV-V196	47	FC00CM-BP-AP-VLV-V211
15	FC00CM-BP-AP-VLV-V198	48	FC00CM-BP-AP-VLV-V212
16	FC00CM-BP-AP-VLV-V194	49	FC00CM-BP-AP-VLV-V213
17	FC00CM-BP-AP-VLV-V199	50	FC00CM-BP-AP-IND-PI29173
18	FC00CM-BP-AP-VLV-V200	51	FC00CM-BP-AP-MTR-295
19	FC00CM-BP-AP-VLV-V201	52	FC00CM-BP-AP-MTR-295
20	FC00CM-BP-AP-IND-PI29172	53	FC00CM-BP-AP-IND-PI29163
21	FC00CM-BP-AP-MTR-292	54	FC00CM-BP-AP-CKV-195
22	FC00CM-BP-AP-MTR-292	55	FC00CM-BP-AP-VLV-V214
23	FC00CM-BP-AP-IND-PI29162	56	FC00CM-BP-AP-VLV-V215
24	FC00CM-BP-AP-VLV-V202	57	FC00CM-BP-AP-VLV-V216
25	FC00CM-BP-AP-VLV-V203	58	FC00CM-BP-AP-VLV-V217
26	FC00CM-BP-AP-VLV-V204	59	FC00CM-BP-AP-VLV-V218
27	FC00CM-BP-AP-VLV-V205	60	FC00CM-BP-AP-SMP-LDWP
28	FC00CM-BP-AP-IND-PI29171	61	FC00CM-BP-AP-MTR-LDWP
29	FC00CM-BP-AP-MTR-293	62	FC00CM-BP-AP-MTR-LDWP
30	FC00CM-BP-AP-MTR-293	63	FC00CM-BP-AP-SWT-LS291
31	FC00CM-BP-AP-IND-PI29161	64	FC00CM-BP-AP-FLE-FE29162
32	FC00CM-BP-AP-VLV-206	65	FC00CM-BP-AP-FLE-FT291.61
33	FC00CM-BP-AP-VLV-207		

NO.	DATE	REVISION	DWN	CHD	EXD	RVWD	APVD	W.A.
6	01-17-20	FOR RECORD	AWF	DEM				FC006814
5	12/04/18	ADDED FLANGES	LDB	JMC	BCS			
4	10/22/18	ADDED NEW PIPING	LDB	JMC	BCS			
3	09-21-16	ADDED 6" TO 4" DRAIN FOR R.W.P. A & B. ADDED VALVES 9-ADS-V0044, V0045, V0046, V0047 & V0048.	MDC	CM	WVC			
2	2-20-14	AS BUILT	BNS	JDM	JBH			AWG FCC0681
1	12-20-13	GENERAL REV FAC90386 MODS	BNS	JDM	JRH			AWG FAC90371

FOUR CORNERS COMMON ASH HANDLING SYSTEM LINED DECANT WATER POND P&ID

SCALE: NONE DATE: 01-03-05

APPROVED: Dennis Del Grosso, ENGINEERING SUPERVISOR


UNIT: FC DISC: M TYPE: 02 SYS: ADS NUMBER: 82114 SHEET: 10G

THIS DRAWING IS CONFIDENTIAL AND SHALL NOT BE USED OR REPRODUCED IN ANY PART WITHOUT WRITTEN CONSENT OF PINNACLE WEST CAPITAL CORPORATION.

INDEX

CONSTRUCTION NOTES:
 1. THE CONTRACTOR SHALL FIELD VERIFY ALL EXISTING CONDITIONS, DIMENSIONS, AND ELEVATIONS PRIOR TO START OF CONSTRUCTION AS REQUIRED TO COORDINATE NEW CONSTRUCTION. NOTIFY ENGINEER OF ANY DISCREPANCIES OR CONFLICTS FOUND IN CONTRACT DOCUMENTS AND/OR FIELD CONDITIONS.

PUMP SCHEDULE														
MARK	MANUFACTURER	MODEL NUMBER	PUMP TYPE	GPM	HEAD (FT. WG.)	MOTOR DATA			SERVICE	CONFIGURATION	WEIGHT (LBS)	MIN. EFFICIENCY		REMARKS
						MAX. HP	RPM	VOLT/PH				PUMP %	MOTOR %	
P3PH PMP-001	FLOWSERVE	2K3X1.5V-13RV M3V	IN-LINE	130	475	100	3550	460/3	WATER	VERTICAL IN-LINE	2071	39.4	95	OWNER FURNISHED
P3PH PMP-002	FLOWSERVE	2K3X1.5V-13RV M3V	IN-LINE	130	475	100	3550	460/3	WATER	VERTICAL IN-LINE	2071	39.4	95	OWNER FURNISHED

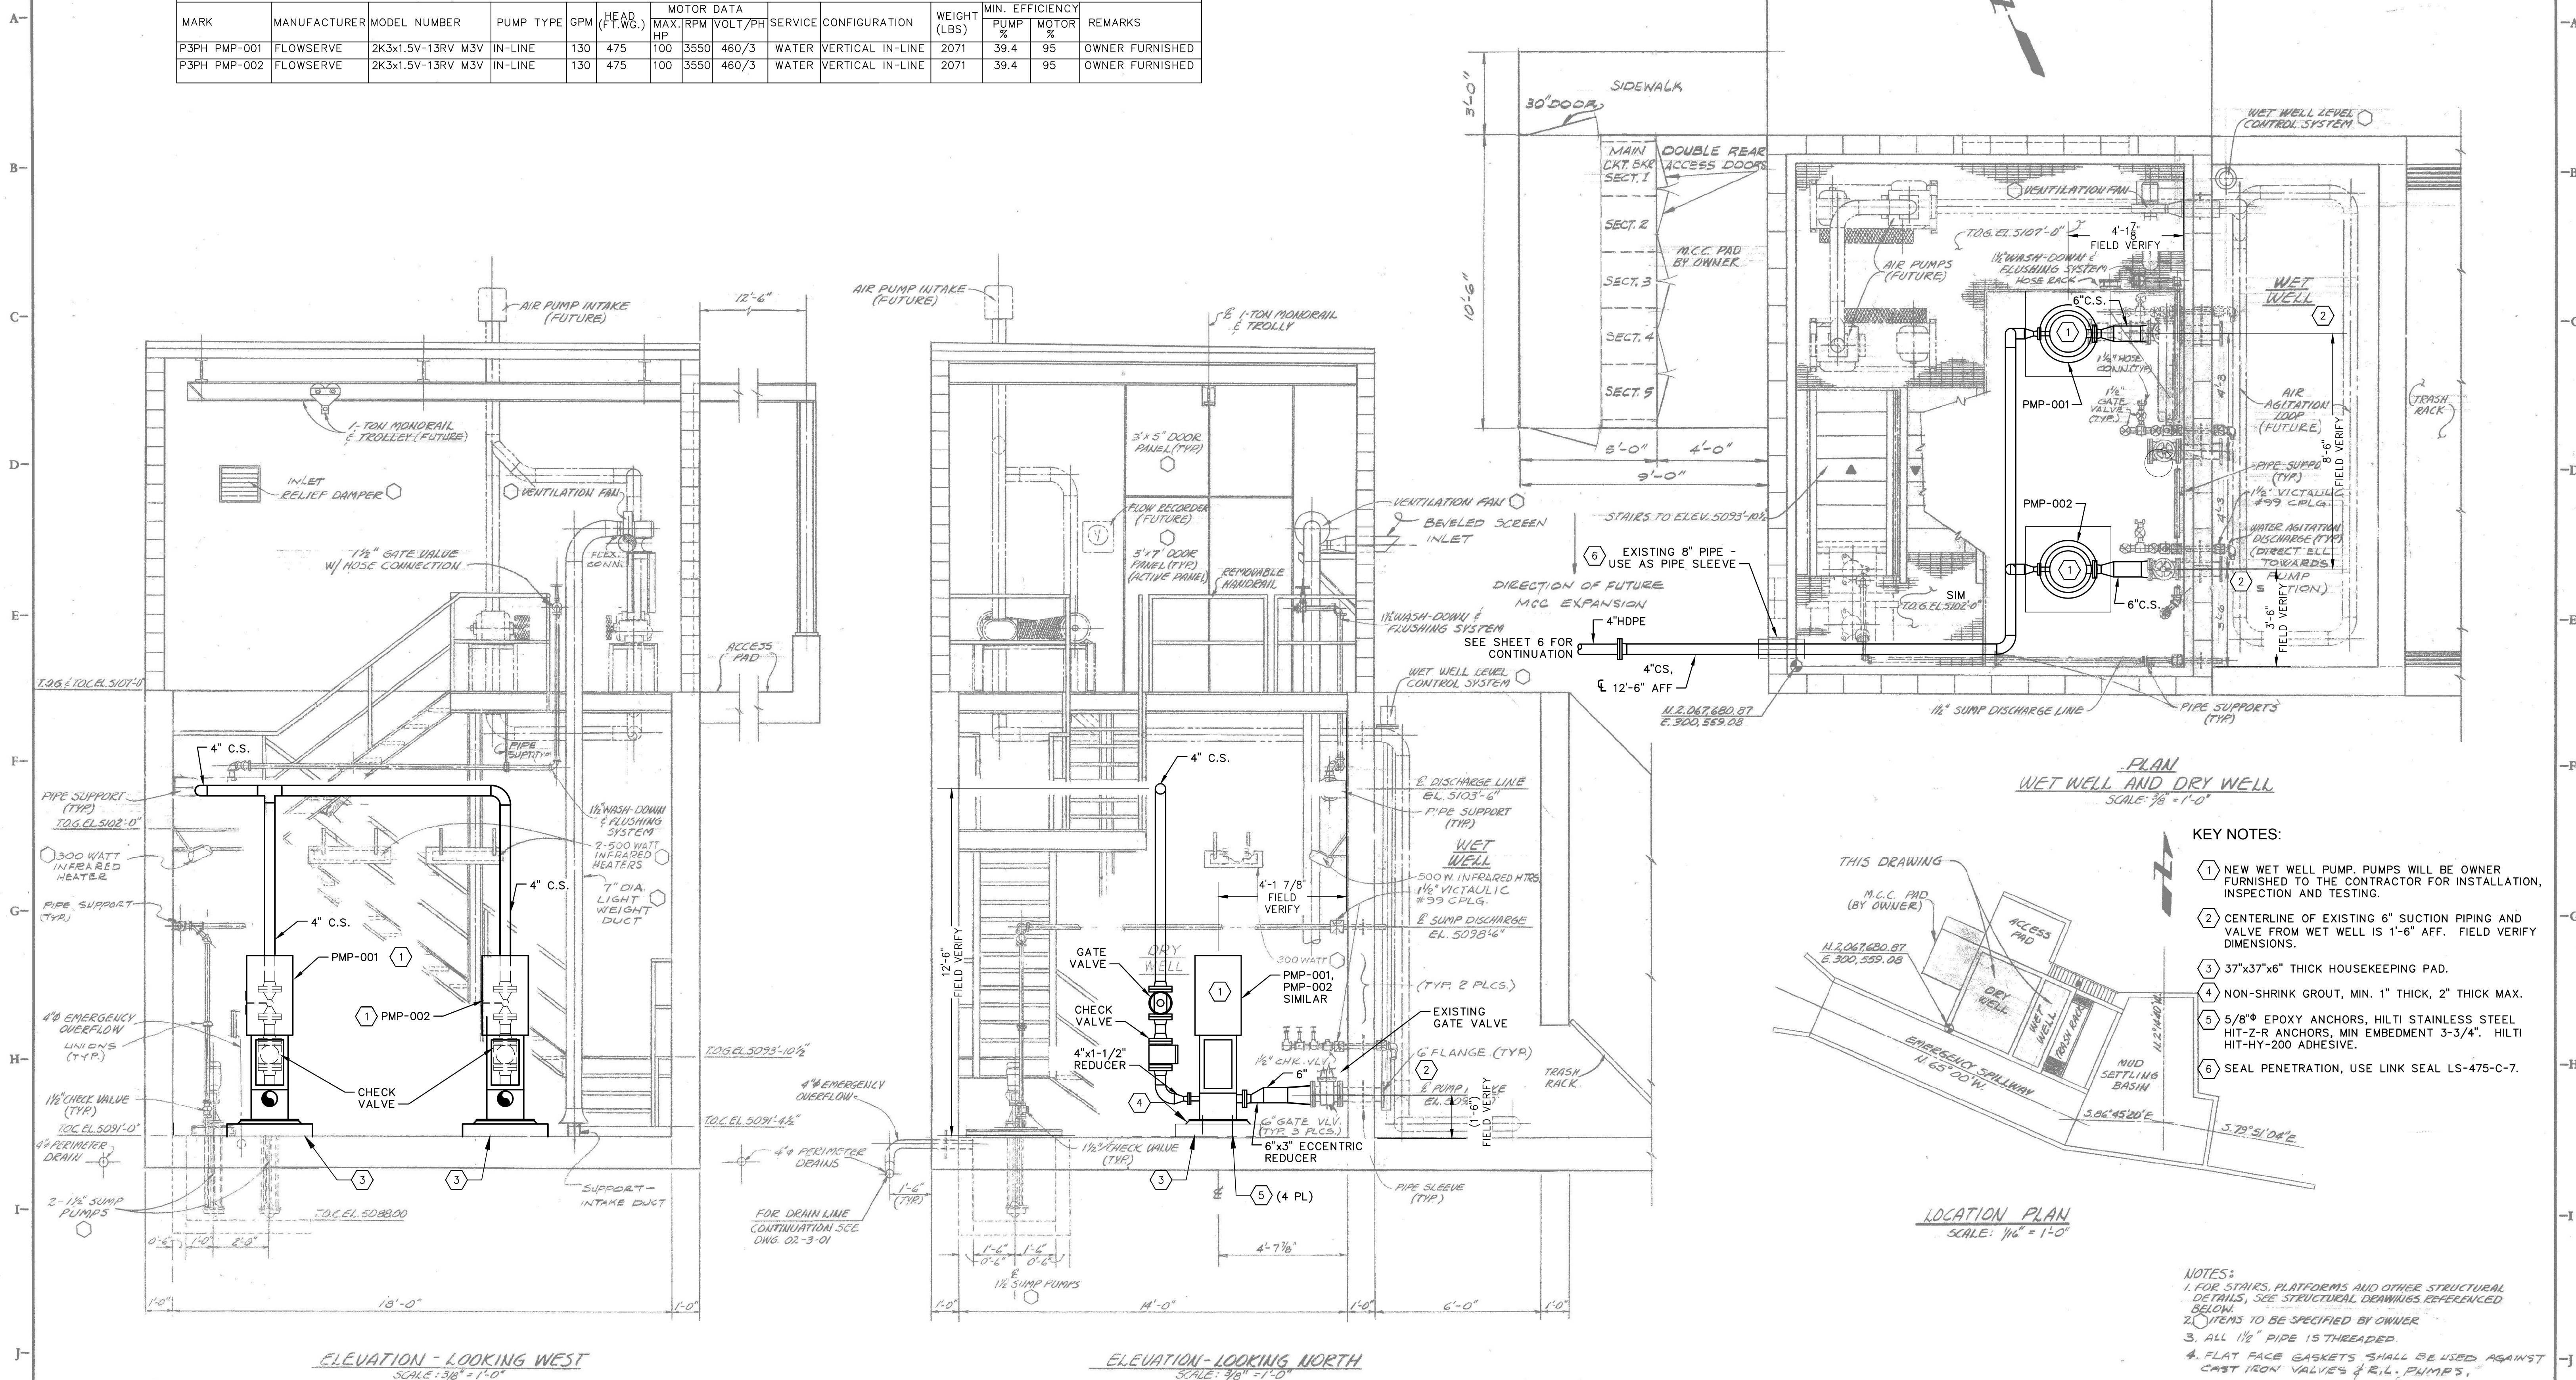

ELEVATION - LOOKING WEST
SCALE: 3/8" = 1'-0"

ELEVATION - LOOKING NORTH
SCALE: 3/8" = 1'-0"

PLAN WET WELL AND DRY WELL
SCALE: 3/8" = 1'-0"

LOCATION PLAN
SCALE: 1/4" = 1'-0"

- KEY NOTES:**
- NEW WET WELL PUMP, PUMPS WILL BE OWNER FURNISHED TO THE CONTRACTOR FOR INSTALLATION, INSPECTION AND TESTING.
 - CENTERLINE OF EXISTING 6" SUCTION PIPING AND VALVE FROM WET WELL IS 1'-6" AFF. FIELD VERIFY DIMENSIONS.
 - 37"x37"x6" THICK HOUSEKEEPING PAD.
 - NON-SHRINK GROUT, MIN. 1" THICK, 2" THICK MAX.
 - 5/8" EPOXY ANCHORS, HILTI STAINLESS STEEL HIT-Z-R ANCHORS, MIN EMBEDMENT 3-3/4". HILTI HIT-HY-200 ADHESIVE.
 - SEAL PENETRATION, USE LINK SEAL LS-475-C-7.

- NOTES:**
- FOR STAIRS, PLATFORMS AND OTHER STRUCTURAL DETAILS, SEE STRUCTURAL DRAWINGS REFERENCED BELOW.
 - ITEMS TO BE SPECIFIED BY OWNER.
 - ALL 1/2" PIPE IS THREADED.
 - FLAT FACE GASKETS SHALL BE USED AGAINST CAST IRON VALVES & R.L. PUMPS.

THESE RECORD DRAWINGS DATED 01/17/20 AND TITLED "FOR RECORD" HAVE BEEN DEVELOPED FROM AS-BUILT MARKUPS AND MAY NOT REPRESENT THE FINAL PROJECT, AS CONSTRUCTED, IN EVERY DETAIL. THESE RECORD DRAWINGS HAVE BEEN PREPARED BASED ON INFORMATION SUPPLIED BY OTHERS AND THE ENGINEER HAS NOT VERIFIED THE ACCURACY OR COMPLETENESS OF THE INFORMATION.

REVISIONS				REFERENCE DRAWINGS				PRINT RECORD				ENG. RECORD		DRAWING STATUS	
NO.	DESCRIPTION	DATE	BY	CHKD	APPD	NO.	DESCRIPTION	DATE	BY	CHKD	APPD	DATE	BY	CHKD	APPD
1	REVISE M.C.C. PAD & ADD C.C.T. BIKES, RELOCATE WASH-DOWN & FLUSHING SYSTEM, ALSO AGITATION DISCH. SPECIFY VENTURI	11-8-76	MG	BY		02-2-08	CIVIL - DISCHARGE LINE & ACC. RD. - PLAN & DETAILS								
2	RELOCATED PUMPS & REROUTED AND CHANGED PIPING		JB			02-2-06	CIVIL - PUMPING STATION - EXCAVATION								
3	AS-BUILT REC FIELD MARKUP	9-28-08	ERA			02-2-10	CIVIL - PUMPING STATION - FINAL GRADING								
4	ADD 8" BY-PASS WITH RESTRICTING ORIFICE, 2 PLACES, ON PUMP DISCHARGE PIPING, ADDED VENTURI MEASURING DEVICE REF	3-25-09	VIC			02-3-01/02	CONCRETE - PUMPING STA. & SPILLWAY - PLAN, SECT. & DET.								
5	REPLACE PUMPS/PIPING		LDB	JMC	BCS	02-3-03	CONCRETE - " " " - SECTIONS & ELEV.								
6	SWAP CHECK AND GATE VALVE LOCATIONS	11-28-18	LDB	JMC	BCS	02-3-04/05	CONCRETE - PUMPHOUSE - PLANS, SECTIONS & DETAILS								
7	UPDATED PUMP SCHEDULE	12-17-18	LDB	JMC	BCS										
8	FOR RECORD	01-17-20	AWF	DEM											

PUMPING STATION - PIPING
 & GENERAL ARRANGEMENT
 PLANS & ELEVATIONS
 ARIZONA PUBLIC SERVICE CO.
 FOUR CORNERS POWER PLANT

DWG. NO. 02-2-05
 SHEET NO. 5 OF 5
 DATE 1/17/20

SCALE AS SHOWN

Stearns-Roger
INCORPORATED

ORDER NO. 15745
X00002

CONSTRUCTION NOTES:

1. THE CONTRACTOR SHALL FIELD VERIFY ALL EXISTING CONDITIONS, DIMENSIONS, AND ELEVATIONS PRIOR TO START OF CONSTRUCTION AS REQUIRED TO COORDINATE NEW CONSTRUCTION. NOTIFY ENGINEER OF ANY DISCREPANCIES OR CONFLICTS FOUND IN CONTRACT DOCUMENTS AND/OR FIELD CONDITIONS.
2. PIPE SUPPORTS ARE NOT SHOWN FOR CLARITY. CONTRACTOR SHALL PROVIDE SUPPORTS PER SPECIFICATIONS.

KEY NOTES:

- 1 THE NEW RETURN WATER POND PUMPS WILL BE OWNER FURNISHED TO THE CONTRACTOR FOR INSTALLATION, INSPECTION AND TESTING.
- 2 76"x40"x6" THICK HOUSEKEEPING PAD.
- 3 NON-SHRINK GROUT, MIN. 1" THICK, 2" THICK MAX.
- 4 3/4"Ø EPOXY ANCHORS. HILTI STAINLESS STEEL HIT-Z-R ANCHORS, MIN. EMBED 4". HILTI HIT-HY-200 ADHESIVE.

THESE RECORD DRAWINGS DATED 01/17/20 AND TITLED "FOR RECORD" HAVE BEEN DEVELOPED FROM AS-BUILT MARKUPS AND MAY NOT REPRESENT THE FINAL PROJECT, AS CONSTRUCTED. IN EVERY DETAIL. THESE RECORD DRAWINGS HAVE BEEN PREPARED BASED ON INFORMATION SUPPLIED BY OTHERS AND THE ENGINEER HAS NOT VERIFIED THE ACCURACY OR COMPLETENESS OF THE INFORMATION.

NO.	DATE	REVISION	DWN	CHD	EXD	RWVD	APVD	W.A.
3	01-17-20	FOR RECORD		AWF	DEM			FCC06814
2	12/17/18	REVISED PUMP FLOW & ISH & PIPE SIZES		DB	JM			
1	11/29/18	SWAP CHECK AND GATE VALVE LOCATIONS		DB	JM			


FOUR CORNERS POWER PLANT
RETURN WATER POND

MECHANICAL RETURN WATER POND PUMPING STATION PLAN


aps

SCALE: 1/2" = 1'-0" DATE: 10/04/19

DWN	LDB	EXD	---	APPROVED	W A
CHD	BCS	RWVD	---	JACK MCCONWELL DRAWING APPROVED BY	FCC06814
UNIT	DISC	TYPE	SYS	SUBSYS	NUMBER
FC45CM	M	16	WP	AP	200485
					SHEET
					34

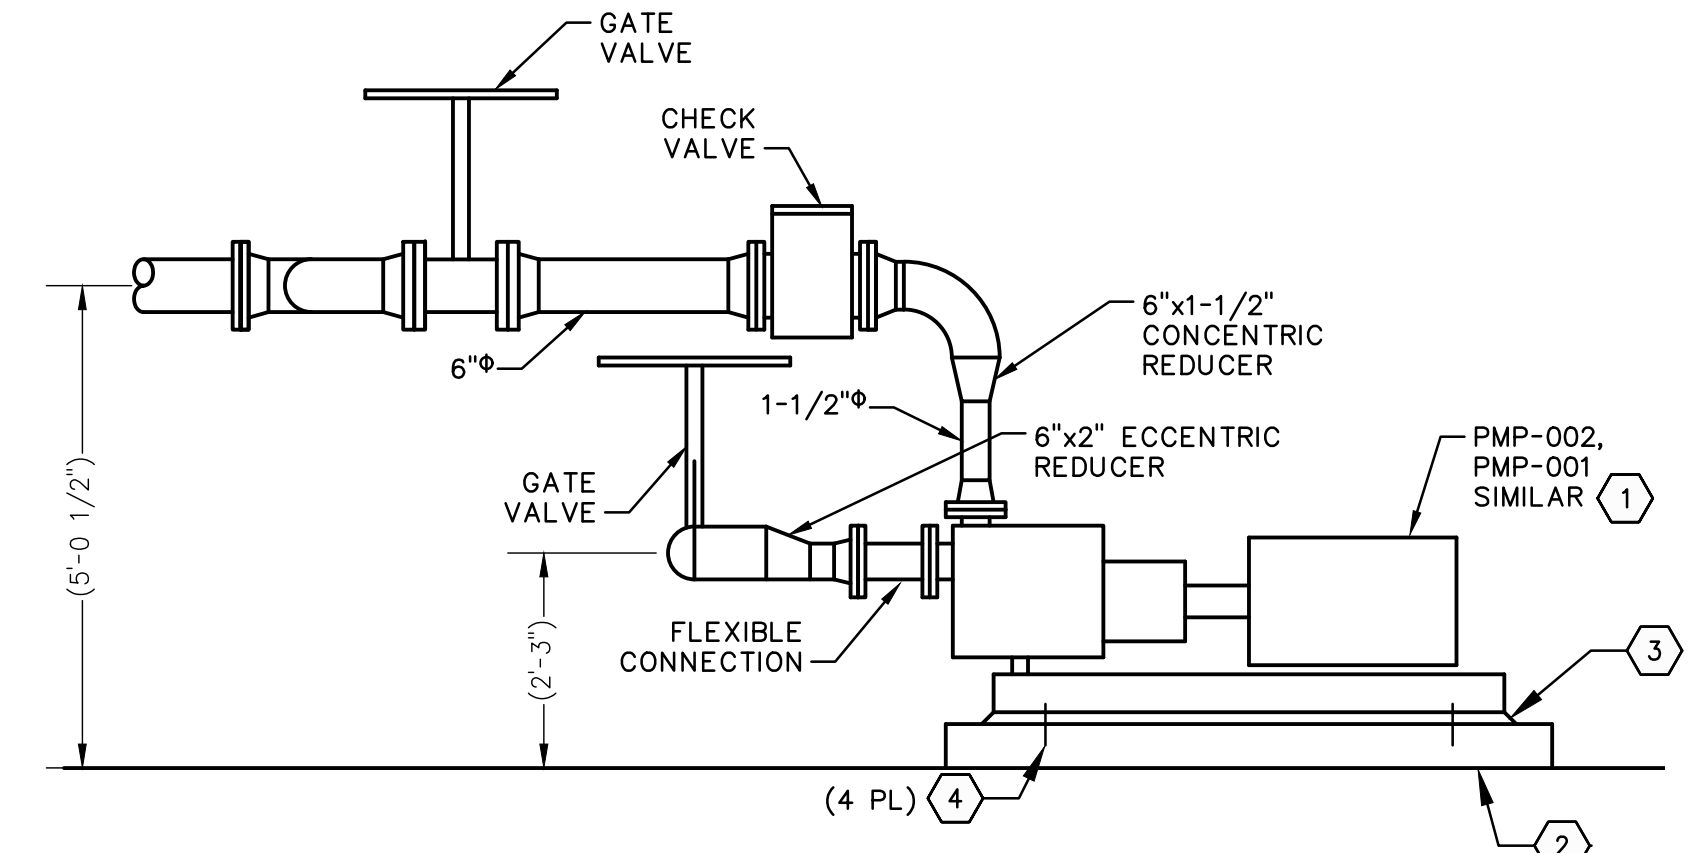


SECTION **B**
34 RWP PUMP PAD
1/2"=1'-0"

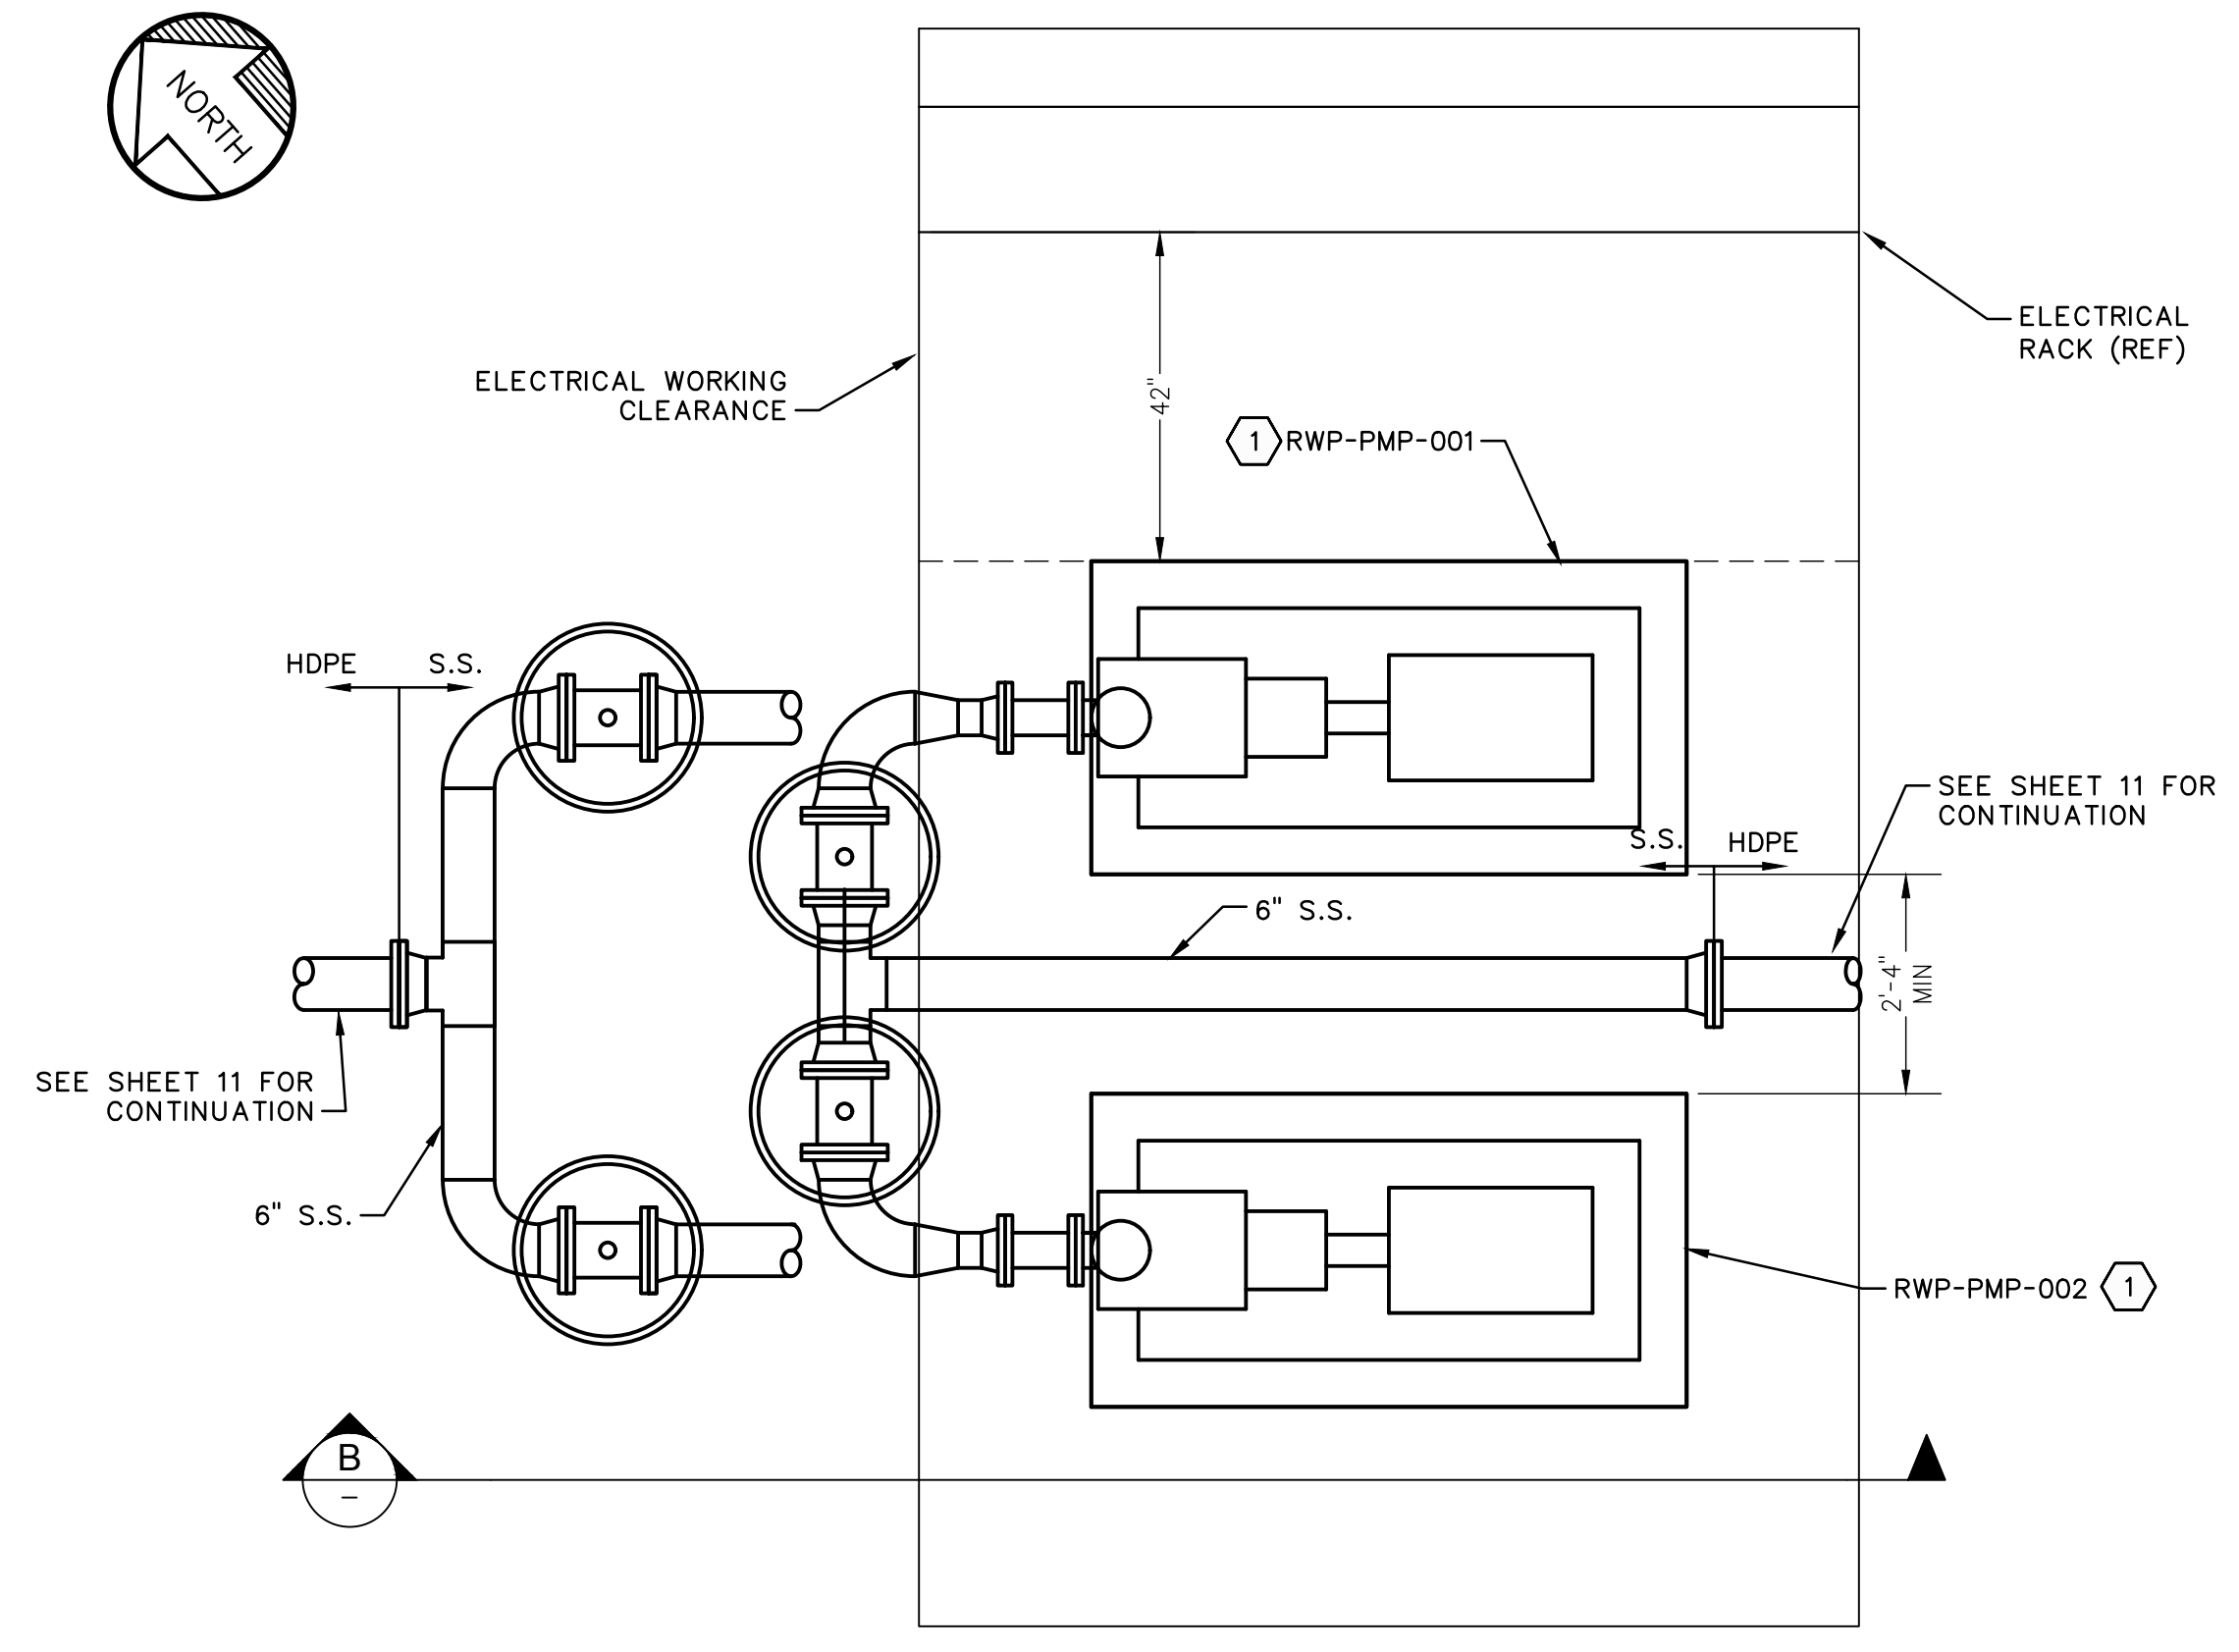

RWP PUMP PAD PLAN
SCALE: 1/2"=1'-0" (FULL SIZE)


PUMP SCHEDULE														
MARK	MANUFACTURER	MODEL NUMBER	PUMP TYPE	GPM	HEAD (FT. WG.)	MOTOR DATA			SERVICE	CONFIGURATION	WEIGHT (LBS)	MIN. EFFICIENCY		REMARKS
						MAX. HP	RPM	VOLT/PH				PUMP %	MOTOR %	
RWP PMP-001	FLOWSERVE	2K2x1.5US-10ARV	SELF PRIMING	90	270	30	3500	460/3	WATER	HORIZONTAL BASE MOUNTED	1260	30.5	92	OWNER FURNISHED
RWP PMP-002	FLOWSERVE	2K2x1.5US-10ARV	SELF PRIMING	90	270	30	3500	460/3	WATER	HORIZONTAL BASE MOUNTED	1260	30.5	92	OWNER FURNISHED

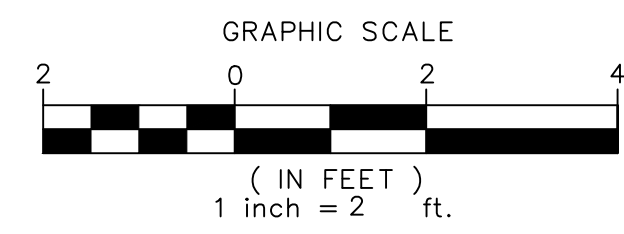

AECOM
7720 N. 16th Street Suite 100
Phoenix, Arizona 85020
(602) 371-1100

WORK SAFELY TODAY

THIS DRAWING IS CONFIDENTIAL AND SHALL NOT BE USED OR REPRODUCED IN ANY PART WITHOUT WRITTEN CONSENT OF PINNACLE WEST CAPITAL CORPORATION.

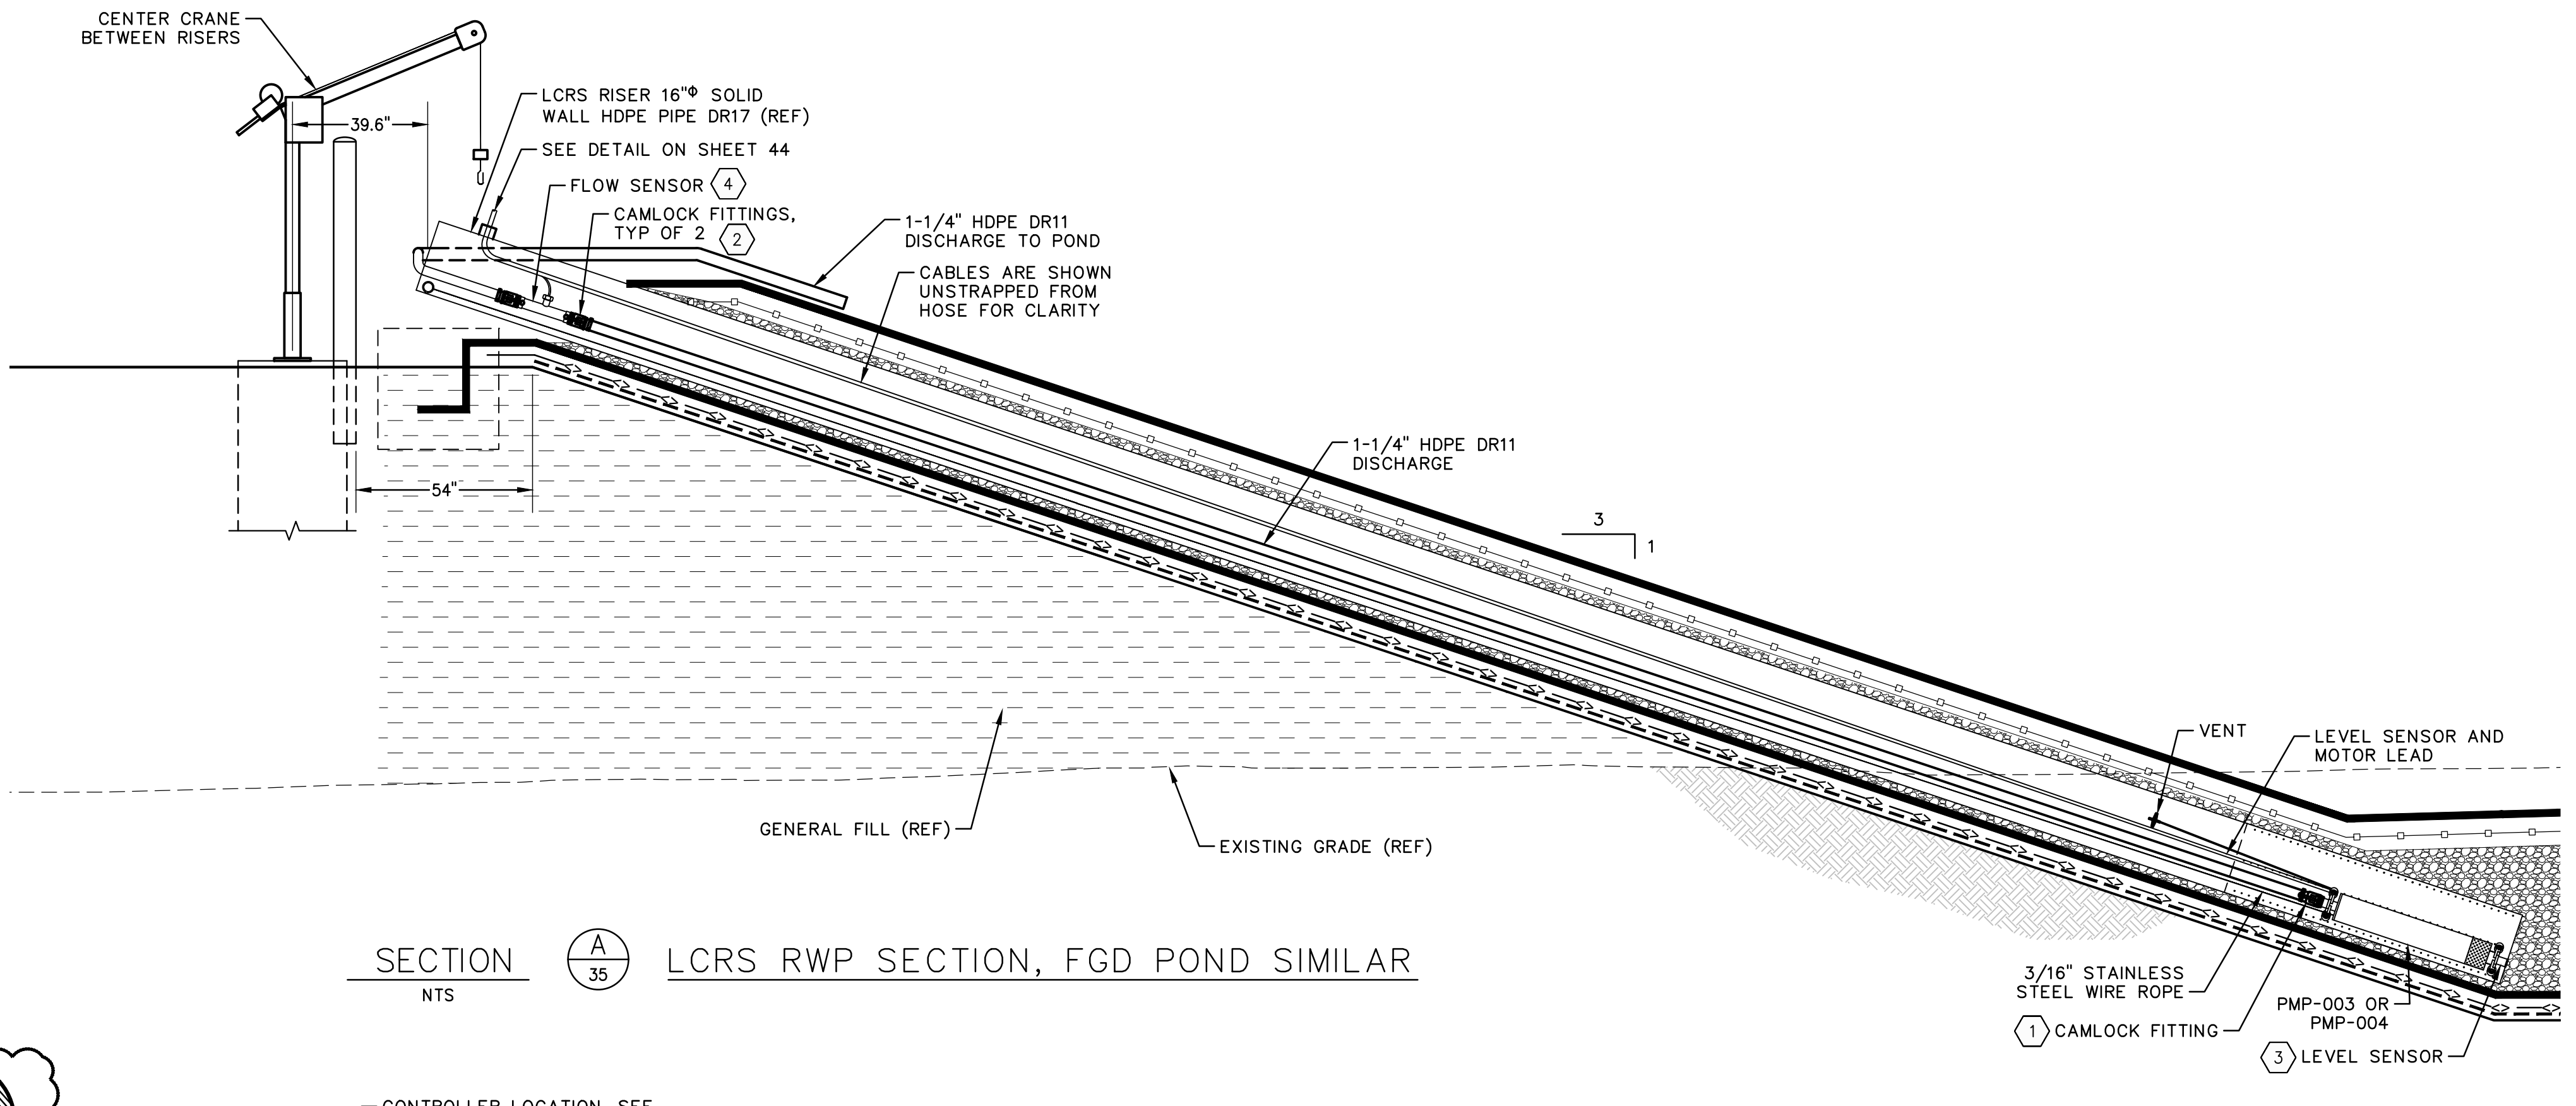


SECTION A-35 LCRS RWP SECTION, FGD POND SIMILAR
NTS

CONSTRUCTION NOTES:

1. THE CONTRACTOR SHALL FIELD VERIFY ALL EXISTING CONDITIONS, DIMENSIONS, AND ELEVATIONS PRIOR TO START OF CONSTRUCTION AS REQUIRED TO COORDINATE NEW CONSTRUCTION. NOTIFY ENGINEER OF ANY DISCREPANCIES OR CONFLICTS FOUND IN CONTRACT DOCUMENTS AND/OR FIELD CONDITIONS.
2. AS-BUILT LINES, GRADES, AND POINTS CAN BE FOUND IN APS DRAWING NUMBER FC00CM-C-17-SF-RG-100003-101.


KEYED NOTES:

- 1 DIXON 125-C-SS HOSE COUPLER WITH DIXON 1-1/4" FNPT ADAPTER 125-A-SS, TYPE 316 STAINLESS STEEL.
- 2 DIXON 125-C-SS HOSE COUPLER WITH DIXON 1-1/4" MNPT ADAPTER 125-F-SS, TYPE 316 STAINLESS STEEL.
- 3 EPG SUBMERSIBLE LEVEL SENSOR, 0-5 PSIG.
- 4 EPG E SERIES EP125 FLOW SENSOR, INSTALLED IN CLASS 150 TYPE 316 STAINLESS STEEL 1-1/4" FNPT TEE.
- 5 GALVANIZED STEEL DAVIT CRANE, 500 LB CAPACITY, FIRST MATE 500 SERIES MODEL 5122M1, WITH MANUALLY OPERATED WINCH WITH WINCH COVER, AND 60 FT OF 3/16" 316SS WIRE ROPE (MODEL WS19-60NS), PEDESTAL MOUNT (522GAL), AND 1/2" TYPE 316 STAINLESS STEEL ANCHOR KIT (MODEL AN50A-5S316). SEE DETAIL ON SHEET 26 FOR PEDESTAL.

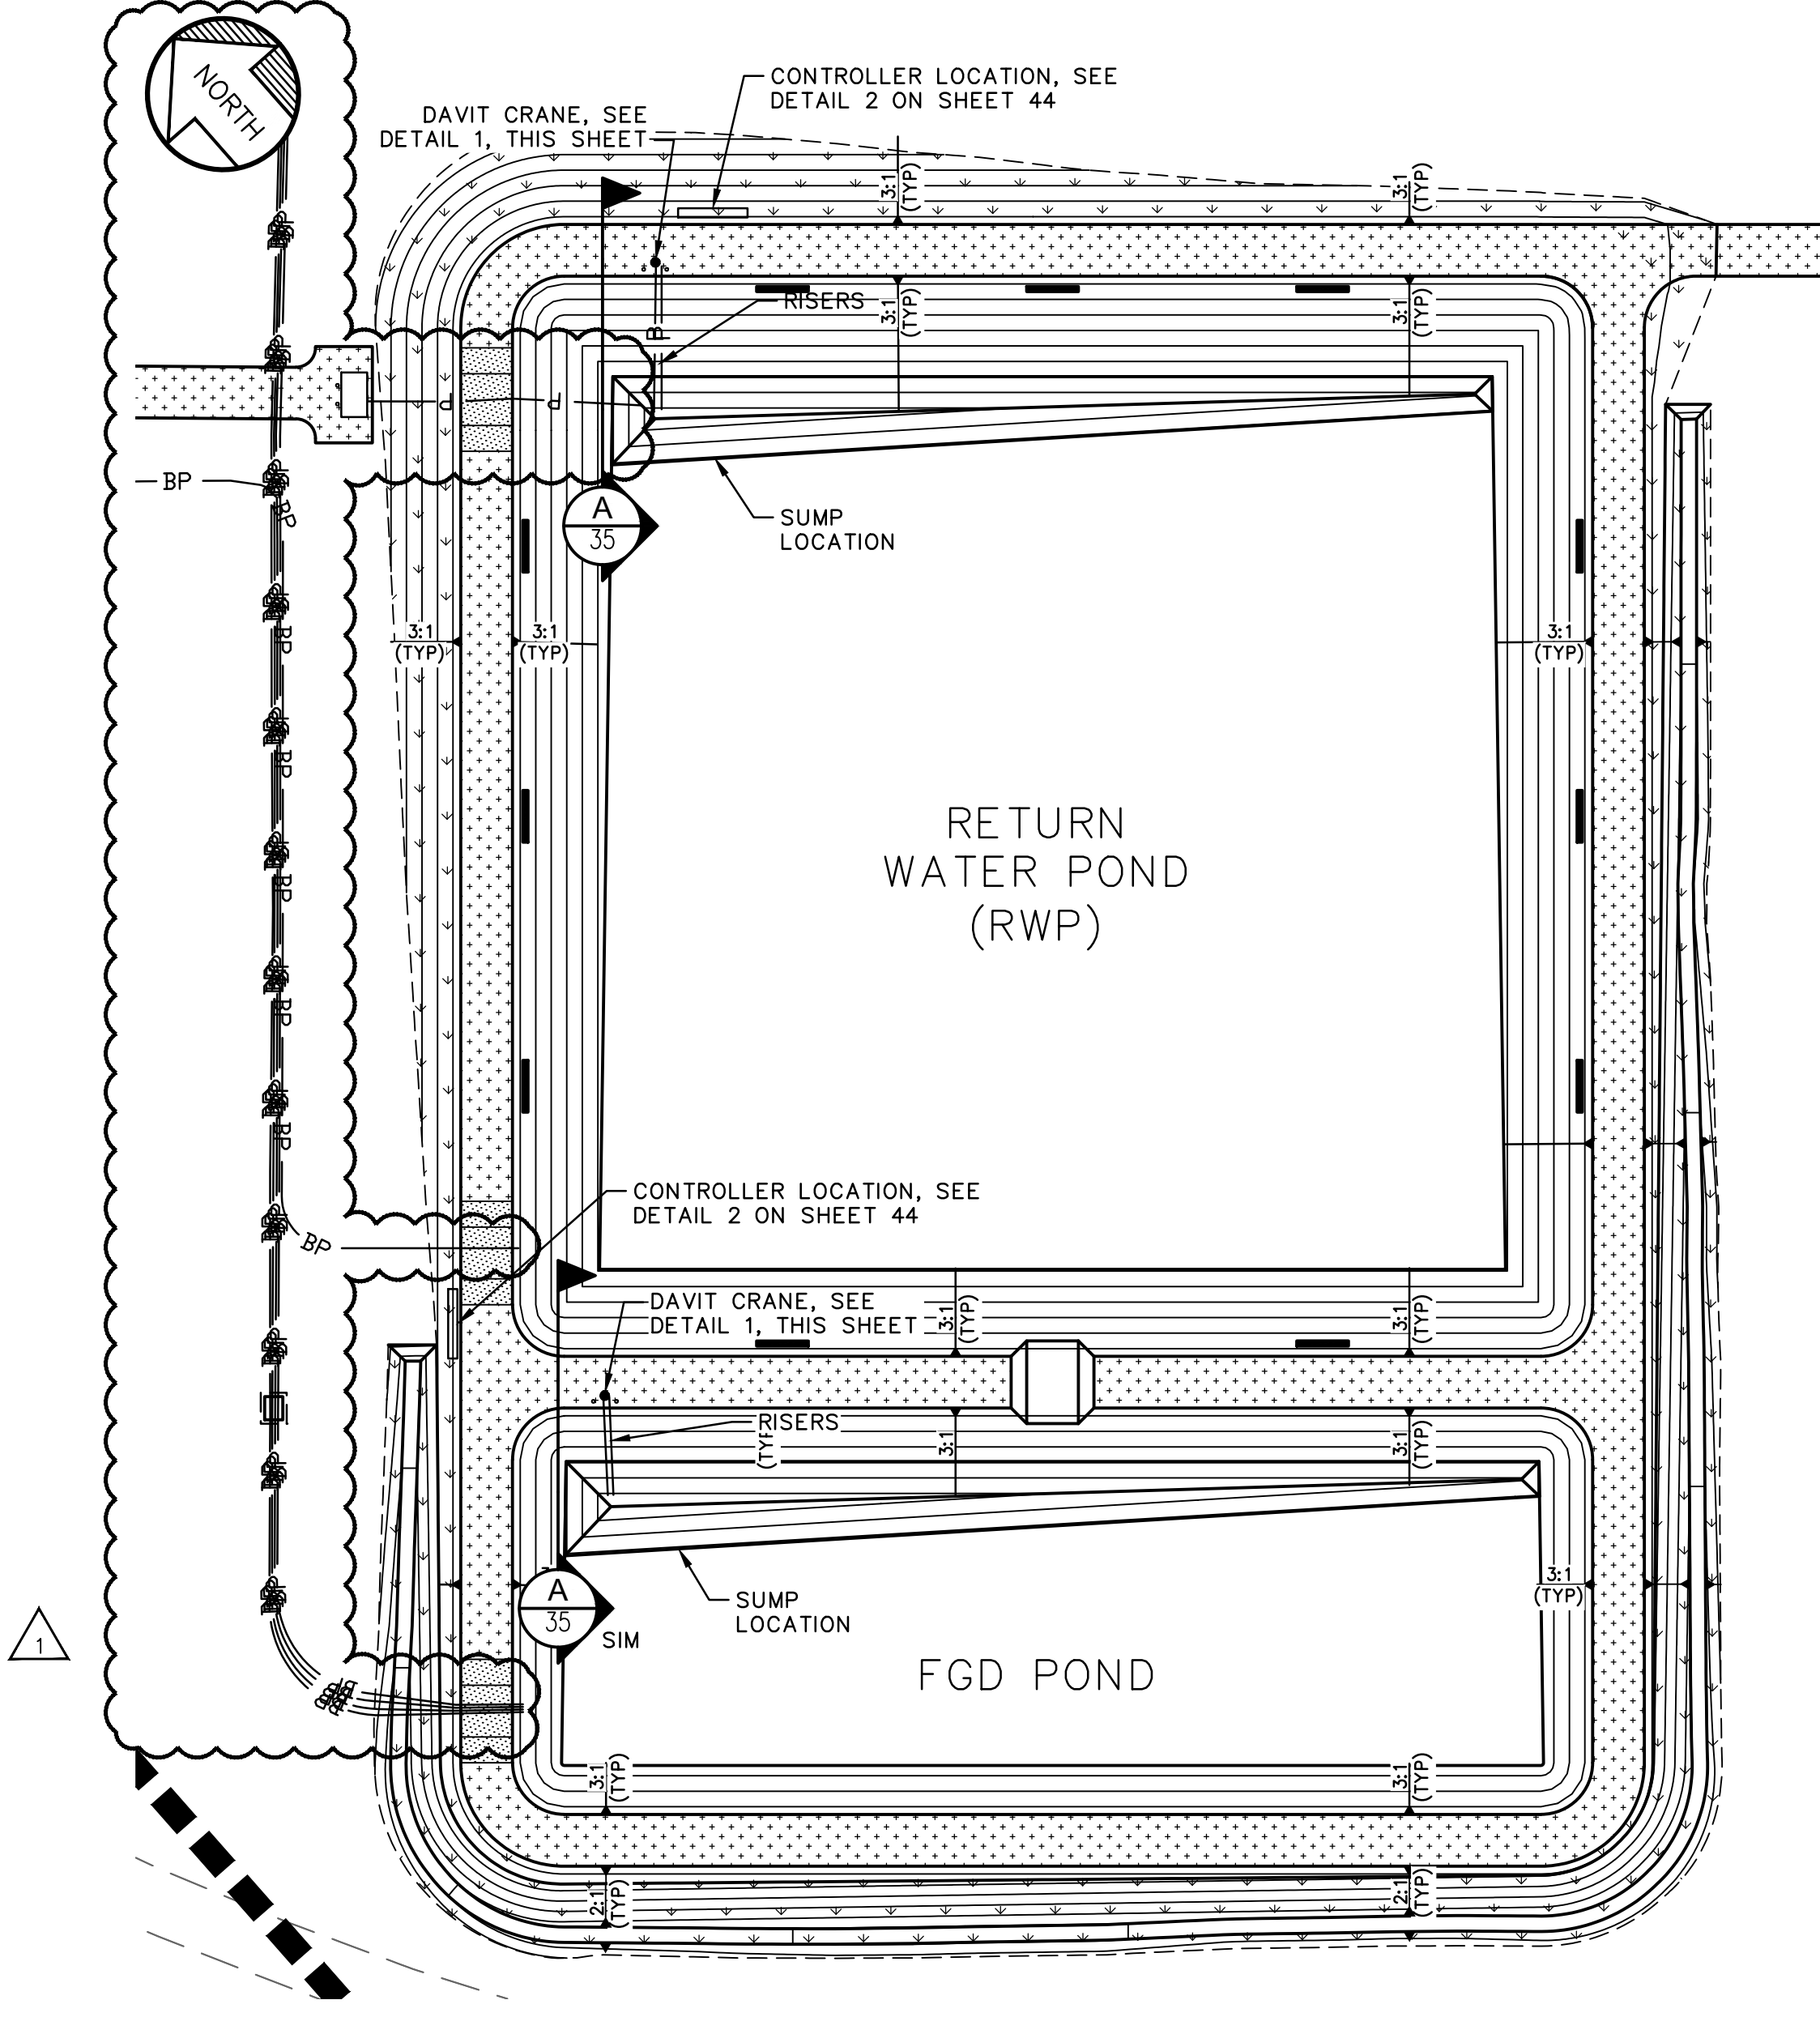

RWP POND LCRS PLAN
SCALE: NTS

MARK	MANUFACTURER	MODEL NUMBER	PUMP TYPE	GPM	HEAD (FT.WG.)	MOTOR DATA			SERVICE	CONFIGURATION	WEIGHT (LBS)	MIN. EFFICIENCY		REMARKS
						MAX HP	RPM	VOLT/PH				PUMP %	MOTOR %	
RWP PMP-003	EPG	SERIES 3 SUREPUMP MODEL WDPT 3-2	316SS WHEELED SUMP DRAINER	20	28	0.5	3450	460/3	WATER	SUBMERSIBLE HORIZONTAL/ANGLED	67	52.8	95	PROVIDE WITH 60' 3/16" CABLE, LEVEL SENSOR AND CABLE, AND 80' OF MOTOR LEAD FOR RWP PUMP
RWP PMP-004	EPG	SERIES 3 SUREPUMP MODEL WDPT 3-2	316SS WHEELED SUMP DRAINER	20	28	0.5	3450	460/3	WATER	SUBMERSIBLE HORIZONTAL/ANGLED	67	52.8	95	PROVIDE WITH 60' 3/16" CABLE, LEVEL SENSOR AND CABLE, AND 80' OF MOTOR LEAD FOR FGD POND PUMP

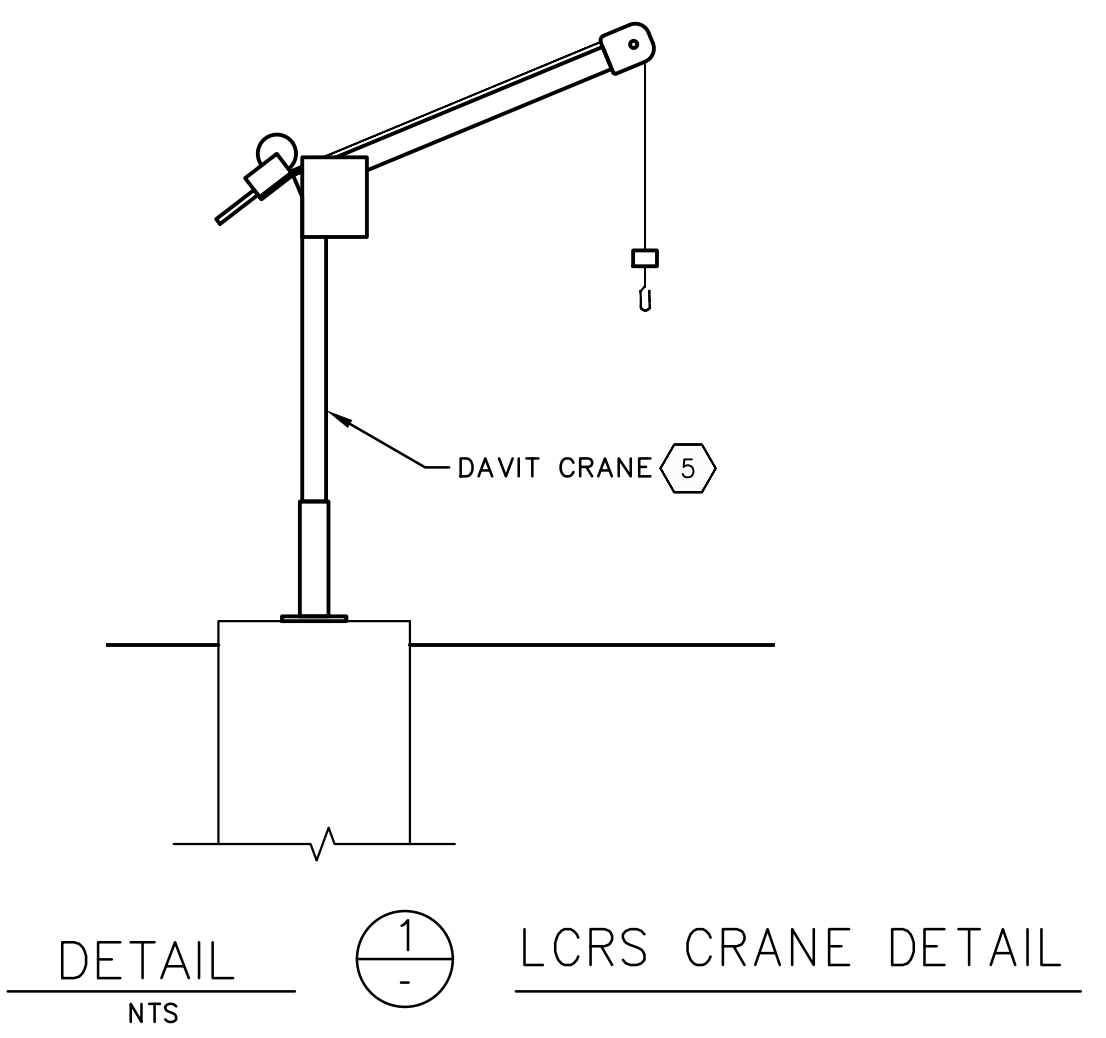

DETAIL 1-1 LCRS CRANE DETAIL
NTS

THESE RECORD DRAWINGS DATED 01/17/20 AND TITLED "FOR RECORD" HAVE BEEN DEVELOPED FROM AS-BUILT MARKUPS AND MAY NOT REPRESENT THE FINAL PROJECT, AS CONSTRUCTED, IN EVERY DETAIL. THESE RECORD DRAWINGS HAVE BEEN PREPARED BASED ON INFORMATION SUPPLIED BY OTHERS AND THE ENGINEER HAS NOT VERIFIED THE ACCURACY OR COMPLETENESS OF THE INFORMATION.

NO.	DATE	REVISION	DWN	CHD	EXD	RWVD	APVD	W.A.
1	01-17-20	FOR RECORD						FC006814

FOUR CORNERS POWER PLANT
RETURN WATER POND
LCRS PUMP SECTION, SCHEDULE AND DETAILS



SCALE: AS NOTED DATE: 10/04/19

APPROVED: JACK MCCONWELL
DRAWING APPROVED BY: FCC06814

UNIT	DISC	TYPE	SYS	SUBSYS	NUMBER	SHEET
FC45CM	M	65	WP	AP	200485	35

AECOM
7720 N. 16th Street Suite 100
Phoenix, Arizona 85020
(602) 371-1100

WORK SAFELY TODAY

THIS DRAWING IS CONFIDENTIAL AND SHALL NOT BE USED OR REPRODUCED IN ANY PART WITHOUT WRITTEN CONSENT OF PINNACLE WEST CAPITAL CORPORATION.



SYMBOLS

LIGHTING

2'x4' FLUORESCENT LIGHT FIXTURE
A = FIXTURE TYPE
1 = CIRCUIT NUMBER
o = SWITCH CONTROLLING FIXTURE

1'x4' FLUORESCENT LIGHT FIXTURE
A = FIXTURE TYPE
1 = CIRCUIT NUMBER
o = SWITCH CONTROLLING FIXTURE

1'x4' WALL MOUNTED FLUORESCENT LIGHT FIXTURE

2'x2' FLUORESCENT LIGHT FIXTURE
A = FIXTURE TYPE
1 = CIRCUIT NUMBER
o = SWITCH CONTROLLING FIXTURE

2'x4' FLUORESCENT LIGHT FIXTURE WITH EMERGENCY BALLAST OR EMERGENCY BATTERY PACK

1'x4' FLUORESCENT LIGHT FIXTURE WITH EMERGENCY BALLAST OR EMERGENCY BATTERY PACK

RECESSED OR CEILING MOUNTED INCANDESCENT LIGHT FIXTURE, LETTER DENOTES FIXTURE TYPE

WALL MOUNTED INCANDESCENT LIGHT FIXTURE, LETTER DENOTES FIXTURE TYPE

CEILING OR PENDANT MOUNTED LIGHT FIXTURE, LETTER DENOTES FIXTURE TYPE, SUBSCRIPT INDICATES CONTROL

CEILING MOUNTED DOUBLE FACE EXIT LIGHT, LETTER DENOTES FIXTURE TYPE, ARROW DENOTES DIRECTIONAL ARROWS

CEILING MOUNTED SINGLE FACE EXIT LIGHT

WALL MOUNTED EXIT LIGHT

EMERGENCY LIGHT FIXTURE, RECHARGEABLE TYPE

POLE MOUNTED LUMINAIRE

POLE MOUNTED LIGHT WITH CONCRETE BASE
LT/C

SWITCHES

S_o SINGLE POLE SWITCH, 20A, 120/277V, LOWER CASE LETTER DENOTES CONTROL

S₃ THREE-WAY SWITCH, 20A, 120/277V

S₄ FOUR-WAY SWITCH, 20A, 120/277V

S_D DIMMER SWITCH, 1500 WATT (FLUORESCENT TYPE) UNLESS OTHERWISE NOTED

S_T MOTOR RATED SWITCH, WITH THERMAL OVERLOAD PROTECTION

WALL MOUNTED OCCUPANCY SENSOR WITH OVERRIDE SWITCH (LIGHTING)

CEILING MOUNTED ULTRASONIC OCCUPANCY SENSOR (LIGHTING)

MOTION DETECTOR

MOTION DETECTOR

NON-FUSIBLE DISCONNECT SWITCH, NUMBER INDICATES SWITCH SIZE

FUSIBLE DISCONNECT SWITCH

THERMOSTAT

GROUNDING/LIGHTNING PROTECTION

AIR TERMINAL

CONNECTION POINT

EXOTHERMIC WELD

GROUND CONNECTION

GROUNDING ROD

GROUNDING BUS BAR

PANELBOARDS/POWER EQUIPMENT

PAD MOUNTED TRANSFORMER

LP-x LIGHTING PANELBOARD

PP-x POWER PANELBOARD

MOTOR, NUMBER INDICATES HORSEPOWER

RECEPTACLES/J-BOXES

20A, 120V, SIMPLEX RECEPTACLE

20A, 120V, DUPLEX RECEPTACLE

20A, 120V, GROUND FAULT CIRCUIT INTERRUPTER DUPLEX RECEPTACLE WITH WEATHERPROOF COVER

20A, 120V, DUPLEX RECEPTACLE, CEILING MOUNTED

20A, 120V, DUPLEX RECEPTACLE, IN FLOOR BOX

20A, 120V, DOUBLE DUPLEX RECEPTACLE

20A, 120V, DOUBLE DUPLEX RECEPTACLE, CEILING MOUNTED

20A, 120V, DOUBLE DUPLEX RECEPTACLE, IN FLOOR BOX

SPECIAL PURPOSE RECEPTACLE, GROUNDING TYPE, WALL MOUNTED (NEMA TYPE & AMP RATING AS NOTED)

SPECIAL PURPOSE RECEPTACLE, GROUNDING TYPE, CEILING MOUNTED (NEMA TYPE & AMP RATING AS NOTED)

JUNCTION BOX, RECESSED/CEILING MOUNTED

JUNCTION BOX, WALL MOUNTED

JUNCTION BOX, FLUSH IN FLOOR

HOME RUN WITH 1 NEUTRAL, 1 HOT, 1 GROUND

COMMUNICATIONS/SPECIAL SYSTEMS

COMBINATION TELEPHONE/DATA OUTLET, WALL MOUNTED (1 VOICE; 2 DATA JACKS)

COMBINATION TELEPHONE/DATA OUTLET, IN FLOOR BOX (1 VOICE; 2 DATA JACKS)

UNDERGROUND COMMUNICATIONS DUCTS

TELEPHONE OUTLET, WALL MOUNTED

CCTV CAMERA, WALL MOUNTED

EXTERIOR PUBLIC ADDRESS SPEAKER
WP = WEATHERPROOF

WALL MOUNTED SPEAKER

CEILING SPEAKER, FLUSH MOUNTED

INTERCOM OUTLET, WALL MOUNTED

DATA OUTLET, WALL MOUNTED (# REFERS TO QUANTITY IF MORE THAN ONE)

FIRE ALARM SYSTEM

FACP FIRE ALARM CONTROL PANEL

FAAN FIRE ALARM ANNUCIATOR PANEL

FIRE ALARM MANUAL PULL STATION, WALL MOUNTED

FIRE ALARM BELL, WALL MOUNTED

FIRE ALARM HORN/STROBE, ONE ASSEMBLY, WALL MOUNTED

FIRE ALARM FLASHING STROBE LIGHT, WALL MOUNTED

DUCT DETECTOR

FIRE ALARM HEAT DETECTOR, COMBINATION TYPE, CEILING MOUNTED

SMOKE DETECTOR

TAMPER SWITCH

FLOW SWITCH

PRESSURE SWITCH

END OF LINE RESISTOR

ONE-LINE DIAGRAM

TRANSFORMER, DELTA-WYE CONNECTION

CIRCUIT BREAKER
AF = FRAME RATING IN AMPERES
AT = TRIP RATING IN AMPERES

DISCONNECT SWITCH, RATED AS NOTED

FUSE, RATING AS NOTED

DRAWOUT BREAKER

MANUAL OR AUTOMATIC TRANSFER SWITCH

CONNECTION POINT

COMBINATION MAGNETIC STARTER
1 = INDICATES NEMA STARTER SIZE
30A = INDICATES DISCONNECT RATING

MAGNETIC STARTER
1 = INDICATES NEMA STARTER SIZE

UNDERGROUND ELECTRICAL

UNDERGROUND ELECTRICAL PRIMARY POWER CIRCUIT IN CONCRETE ENCASED DUCT

ABBREVIATIONS

AMPERE

AIR DRYER

ABOVE FINISHED FLOOR

ABOVE FINISHED GRADE

AMPERES INTERRUPTING CAPACITY

APPROXIMATELY

AMERICAN WIRE GAUGE

BARE COPPER

CONDUIT

AIR COMPRESSOR

CIRCUIT

CIRCUIT BREAKER

CIRCUIT

CENTER LINE

CONDUIT ONLY

CONCRETE

CURRENT TRANSFORMER

COPPER

WATER CONDENSOR

DOMESTIC WATER PUMP

EXISTING

EXHAUST FAN

ELECTRICAL MANHOLE

ENERGY MONITORING AND CONTROL SYSTEM

HAZARDOUS CLASSIFICATION - EXPLOSION PROOF

ELECTRIC WATER COOLER

FIRE ALARM

FIRE ALARM CONTROL PANEL

FAN COIL

FLOOR

FEET

GAUGE

GROUND FAULT CIRCUIT INTERRUPTER

GROUND

GALVANIZED RIDGID STEEL

HIGH INTENSITY DISCHARGE

HANDHOLE

HIGH POWER FACTOR

HEAT PUMP

HIGH PRESSURE SODIUM

INCHES

INCANDESCENT

THOUSAND CIRCULAR MILLS

KILOVOLT AMPERE

KILOWATT-HOUR

LOCAL AREA NETWORK

LONG TIME

LIGHTING PANEL

METER

MAXIMUM

MOTOR CONTROL CENTER

MAIN DISTRIBUTION PANELBOARD

MINIMUM

MILLIMETER

NOT APPLICABLE

NOT IN CONTRACT

ON CENTER

ON CENTER EACH WAY

OVERHEAD

OUTPUT

PUBLIC ADDRESS

PULL BOX

PAIR

POUNDS PER SQUARE INCH

POTENTIAL TRANSFORMER

POWER PANEL / POWER POLE

POLYVINYL CHLORIDE

RIGID GALVANIZED STEEL

RADIANT HEATER

ROOM

ROOT MEAN SQUARE

RECEPTACLE PANEL

RIGID STEEL CONDUIT

SHORT TIME

SYMMETRICAL

TRANSFORMER

TERMINAL CABINET

TELEPHONE TERMINAL BOARD

TRANSIENT VOLTAGE SURGE SUPPRESSION & FILTERING

TW/SHLD

TWISTED SHIELDED

TYPICAL

UNIT HEATER

UNLESS OTHERWISE NOTED

VOLT

VARIABLE MESSAGE SIGN

WATT-WIM

WITH

WEATHERPROOF

EXPLOSION PROOF

TRANSFORMER

GENERAL CONSTRUCTION NOTES:

- CALL BEFORE YOU DIG IN THE STATE OF NEW MEXICO. CALL 1-800-321-ALERT FOR THE NEW MEXICO ONE CALL SYSTEM.
- MINIMUM POWER CABLE SIZE FOR THIS INSTALLATION SHALL BE #12 AWG.
- MINIMUM CONDUIT SIZE IS 3/4".

THESE RECORD DRAWINGS DATED 01/17/20 AND TITLED "FOR RECORD" HAVE BEEN DEVELOPED FROM AS-BUILT MARKUPS AND MAY NOT REPRESENT THE FINAL PROJECT, AS CONSTRUCTED, IN EVERY DETAIL. THESE RECORD DRAWINGS HAVE BEEN PREPARED BASED ON INFORMATION SUPPLIED BY OTHERS AND THE ENGINEER HAS NOT VERIFIED THE ACCURACY OR COMPLETENESS OF THE INFORMATION.

NO.	DATE	REVISION	DWN	CHD	EXD	RWVD	APVD	W.A.
1	01-17-20	FOR RECORD						FCC06814

FOUR CORNERS POWER PLANT
RETURN WATER POND
ELECTRICAL LEGEND



SCALE: NONE DATE: 10/04/19

DWN	LDB	EXD	---	APPROVED	W A
CHD	DEM	RWVD	---	GENE MOE	FCC06814
				DRAWING APPROVED BY	


UNIT	DISC	TYPE	SYS	SUBSYS	NUMBER	SHEET
FC45CM	E	98	WP	AP	200485	37



WORK SAFELY TODAY

THIS DRAWING IS CONFIDENTIAL AND SHALL NOT BE USED OR REPRODUCED IN ANY PART WITHOUT WRITTEN CONSENT OF PINNACLE WEST CAPITAL CORPORATION.



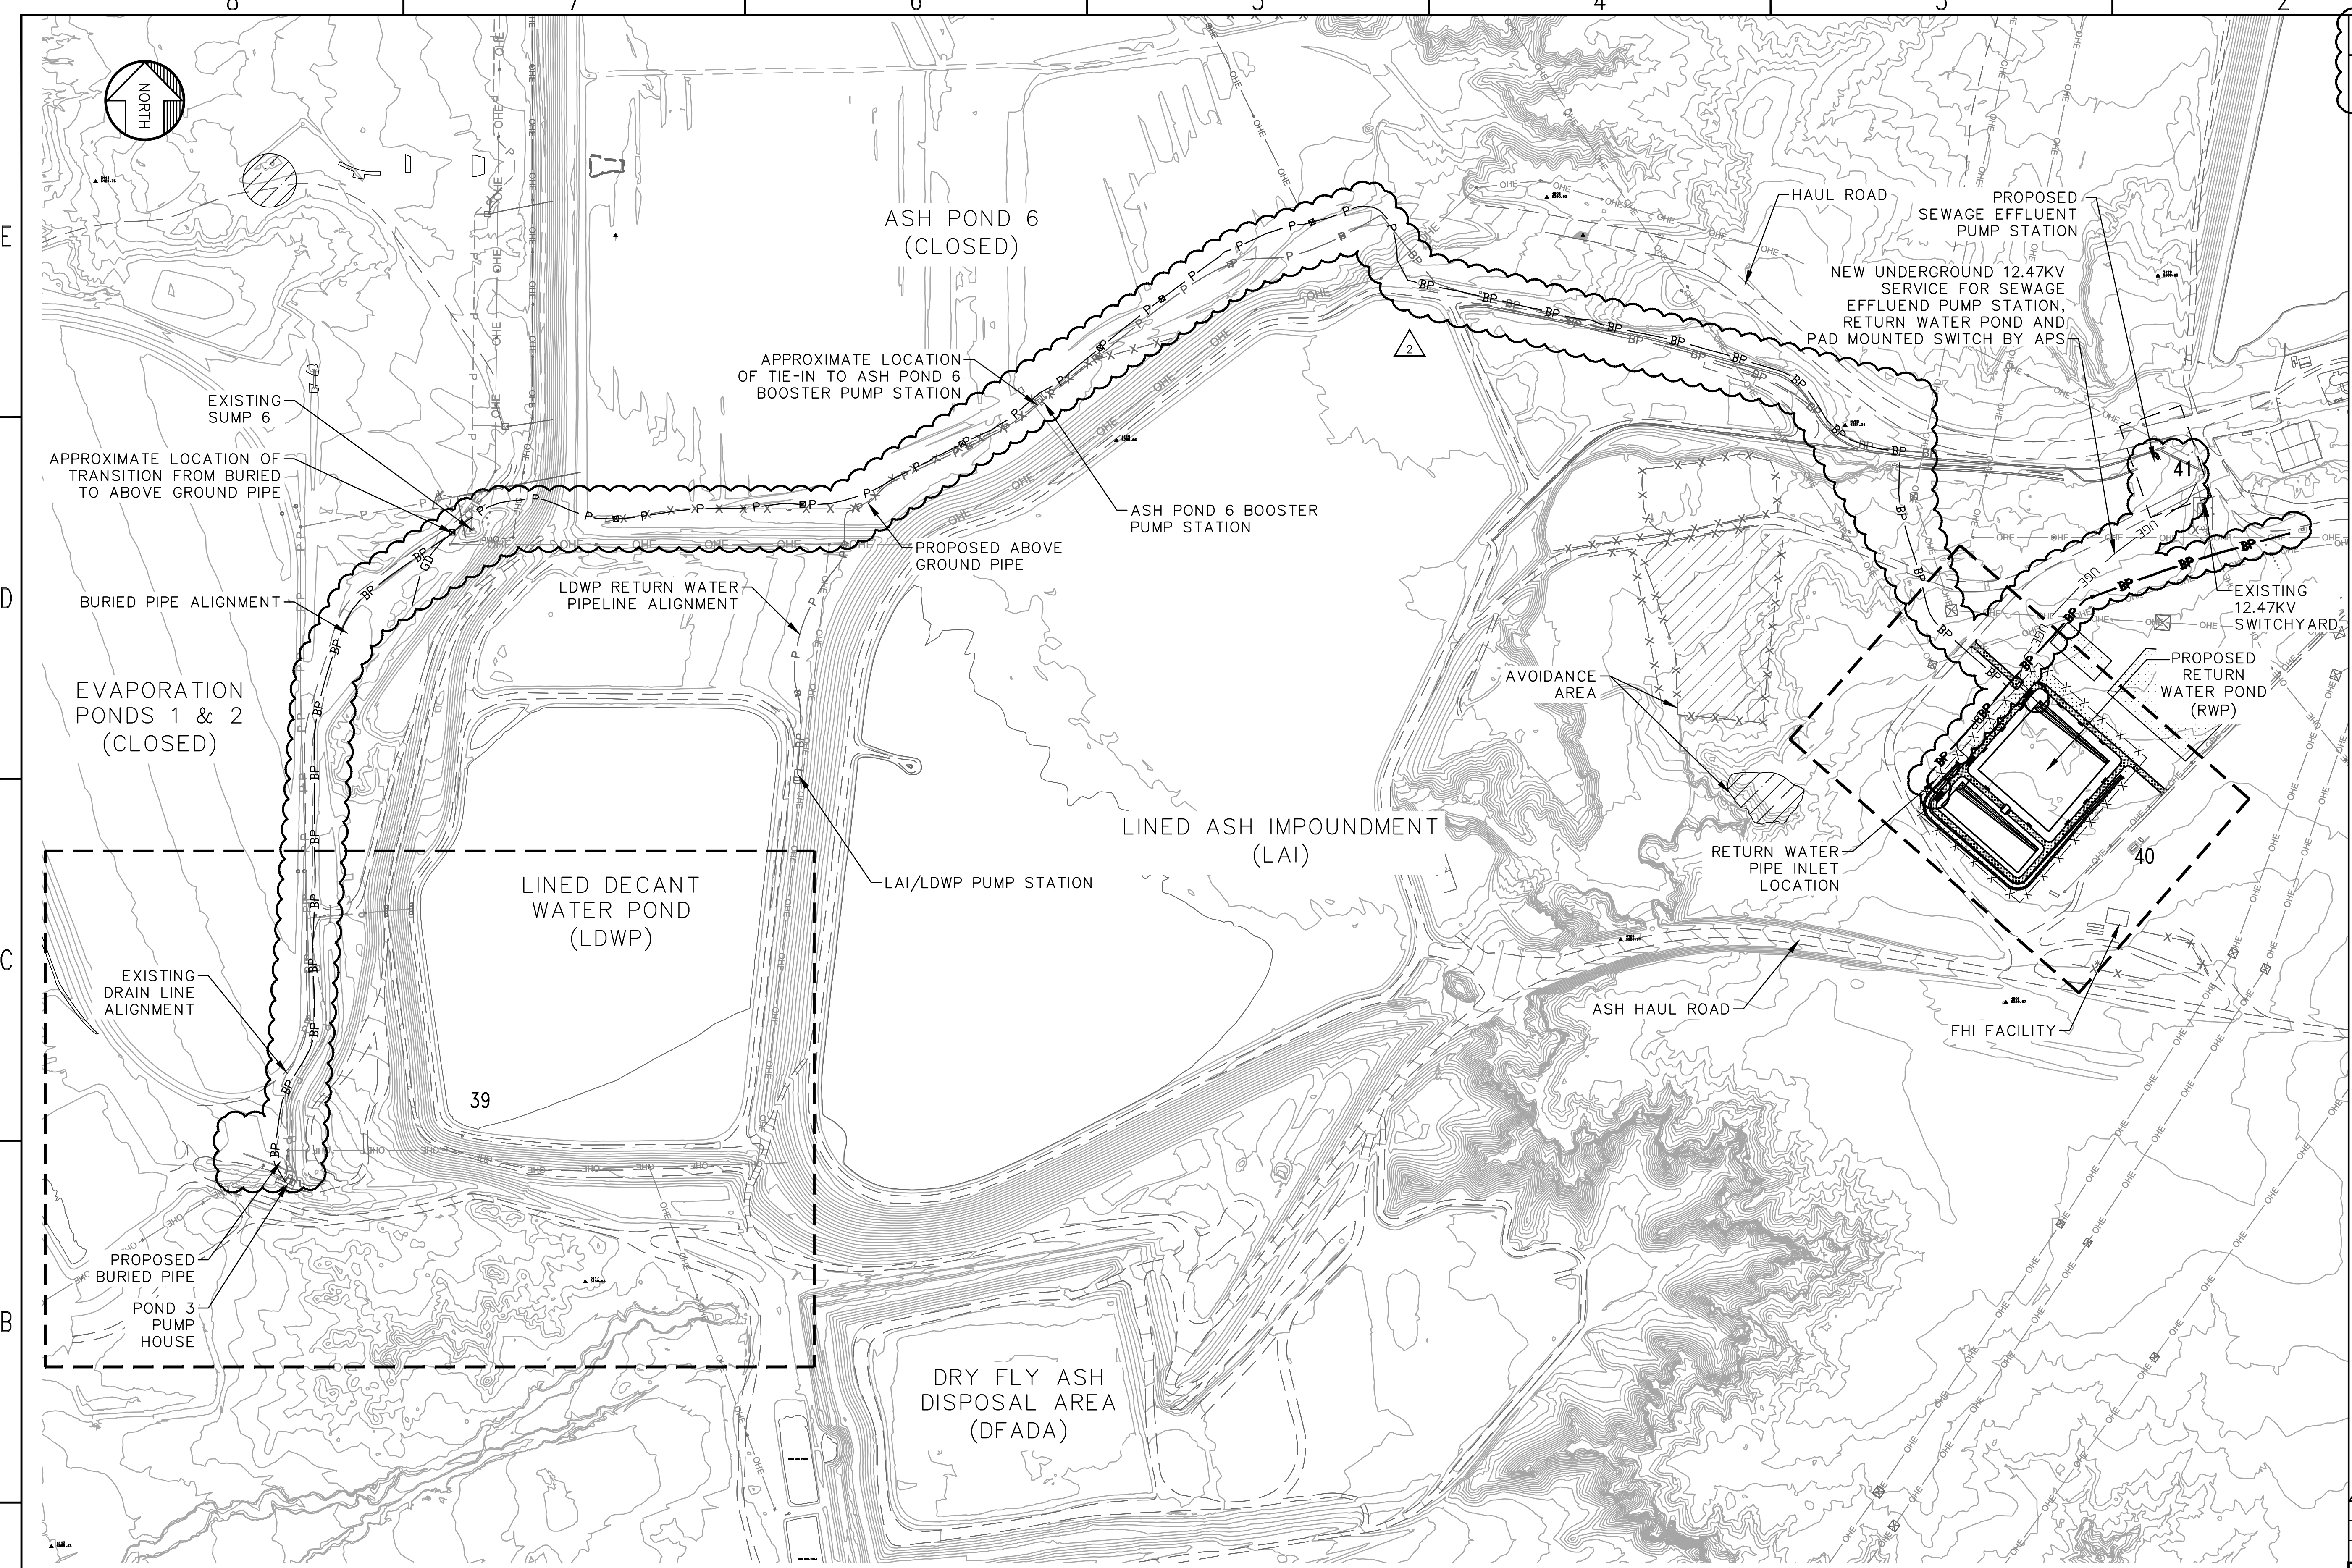


CONSTRUCTION NOTES:
 1. AS-BUILT LINES, GRADES, AND POINTS CAN BE FOUND IN APS DRAWING NUMBER FC00CM-C-17-SF-RG-100003-101.

THESE RECORD DRAWINGS DATED 01/17/20 AND TITLED "FOR RECORD" HAVE BEEN DEVELOPED FROM AS-BUILT MARKUPS AND MAY NOT REPRESENT THE FINAL PROJECT, AS CONSTRUCTED, IN EVERY DETAIL. THESE RECORD DRAWINGS HAVE BEEN PREPARED BASED ON INFORMATION SUPPLIED BY OTHERS AND THE ENGINEER HAS NOT VERIFIED THE ACCURACY OR COMPLETENESS OF THE INFORMATION.

2	01-17-20	FOR RECORD	AWF	DEM			FC006814	
1	5-16-19	CHANGE TO GROUNDED Y SERVICE	LDB	DEM			EDM	
NO.	DATE	REVISION	DWN	CHD	EXD	RWVD	APVD	W.A.

ELECTRICAL PLAN VIEW
 SCALE: 1"=300' (FULL SIZE)

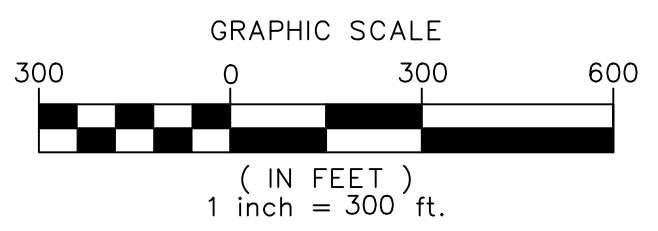

AECOM
 7720 N. 16th Street Suite 100
 Phoenix, Arizona 85020
 (602) 371-1100



WORK SAFELY TODAY

THIS DRAWING IS CONFIDENTIAL AND SHALL NOT BE USED OR REPRODUCED IN ANY PART WITHOUT WRITTEN CONSENT OF PINNACLE WEST CAPITAL CORPORATION.


FOUR CORNERS POWER PLANT
 RETURN WATER POND
 ELECTRICAL OVERALL SITE KEY PLAN



SCALE: 1" = 300' DATE: 10/04/19

DWN	LDB	EXD	---	APPROVED	W A	
CHD	DEM	RWVD	---	GENE MOE	FCC06814	
DRAWING APPROVED BY						
UNIT	DISC	TYPE	SYS	SUBSYS	NUMBER	SHEET
FC45CM	E	16	WP	AP	200485	38

CONSTRUCTION NOTES:
 1. AS-BUILT LINES, GRADES, AND POINTS CAN BE FOUND IN APS DRAWING NUMBER FC00CM-C-17-SF-RG-100003-101.

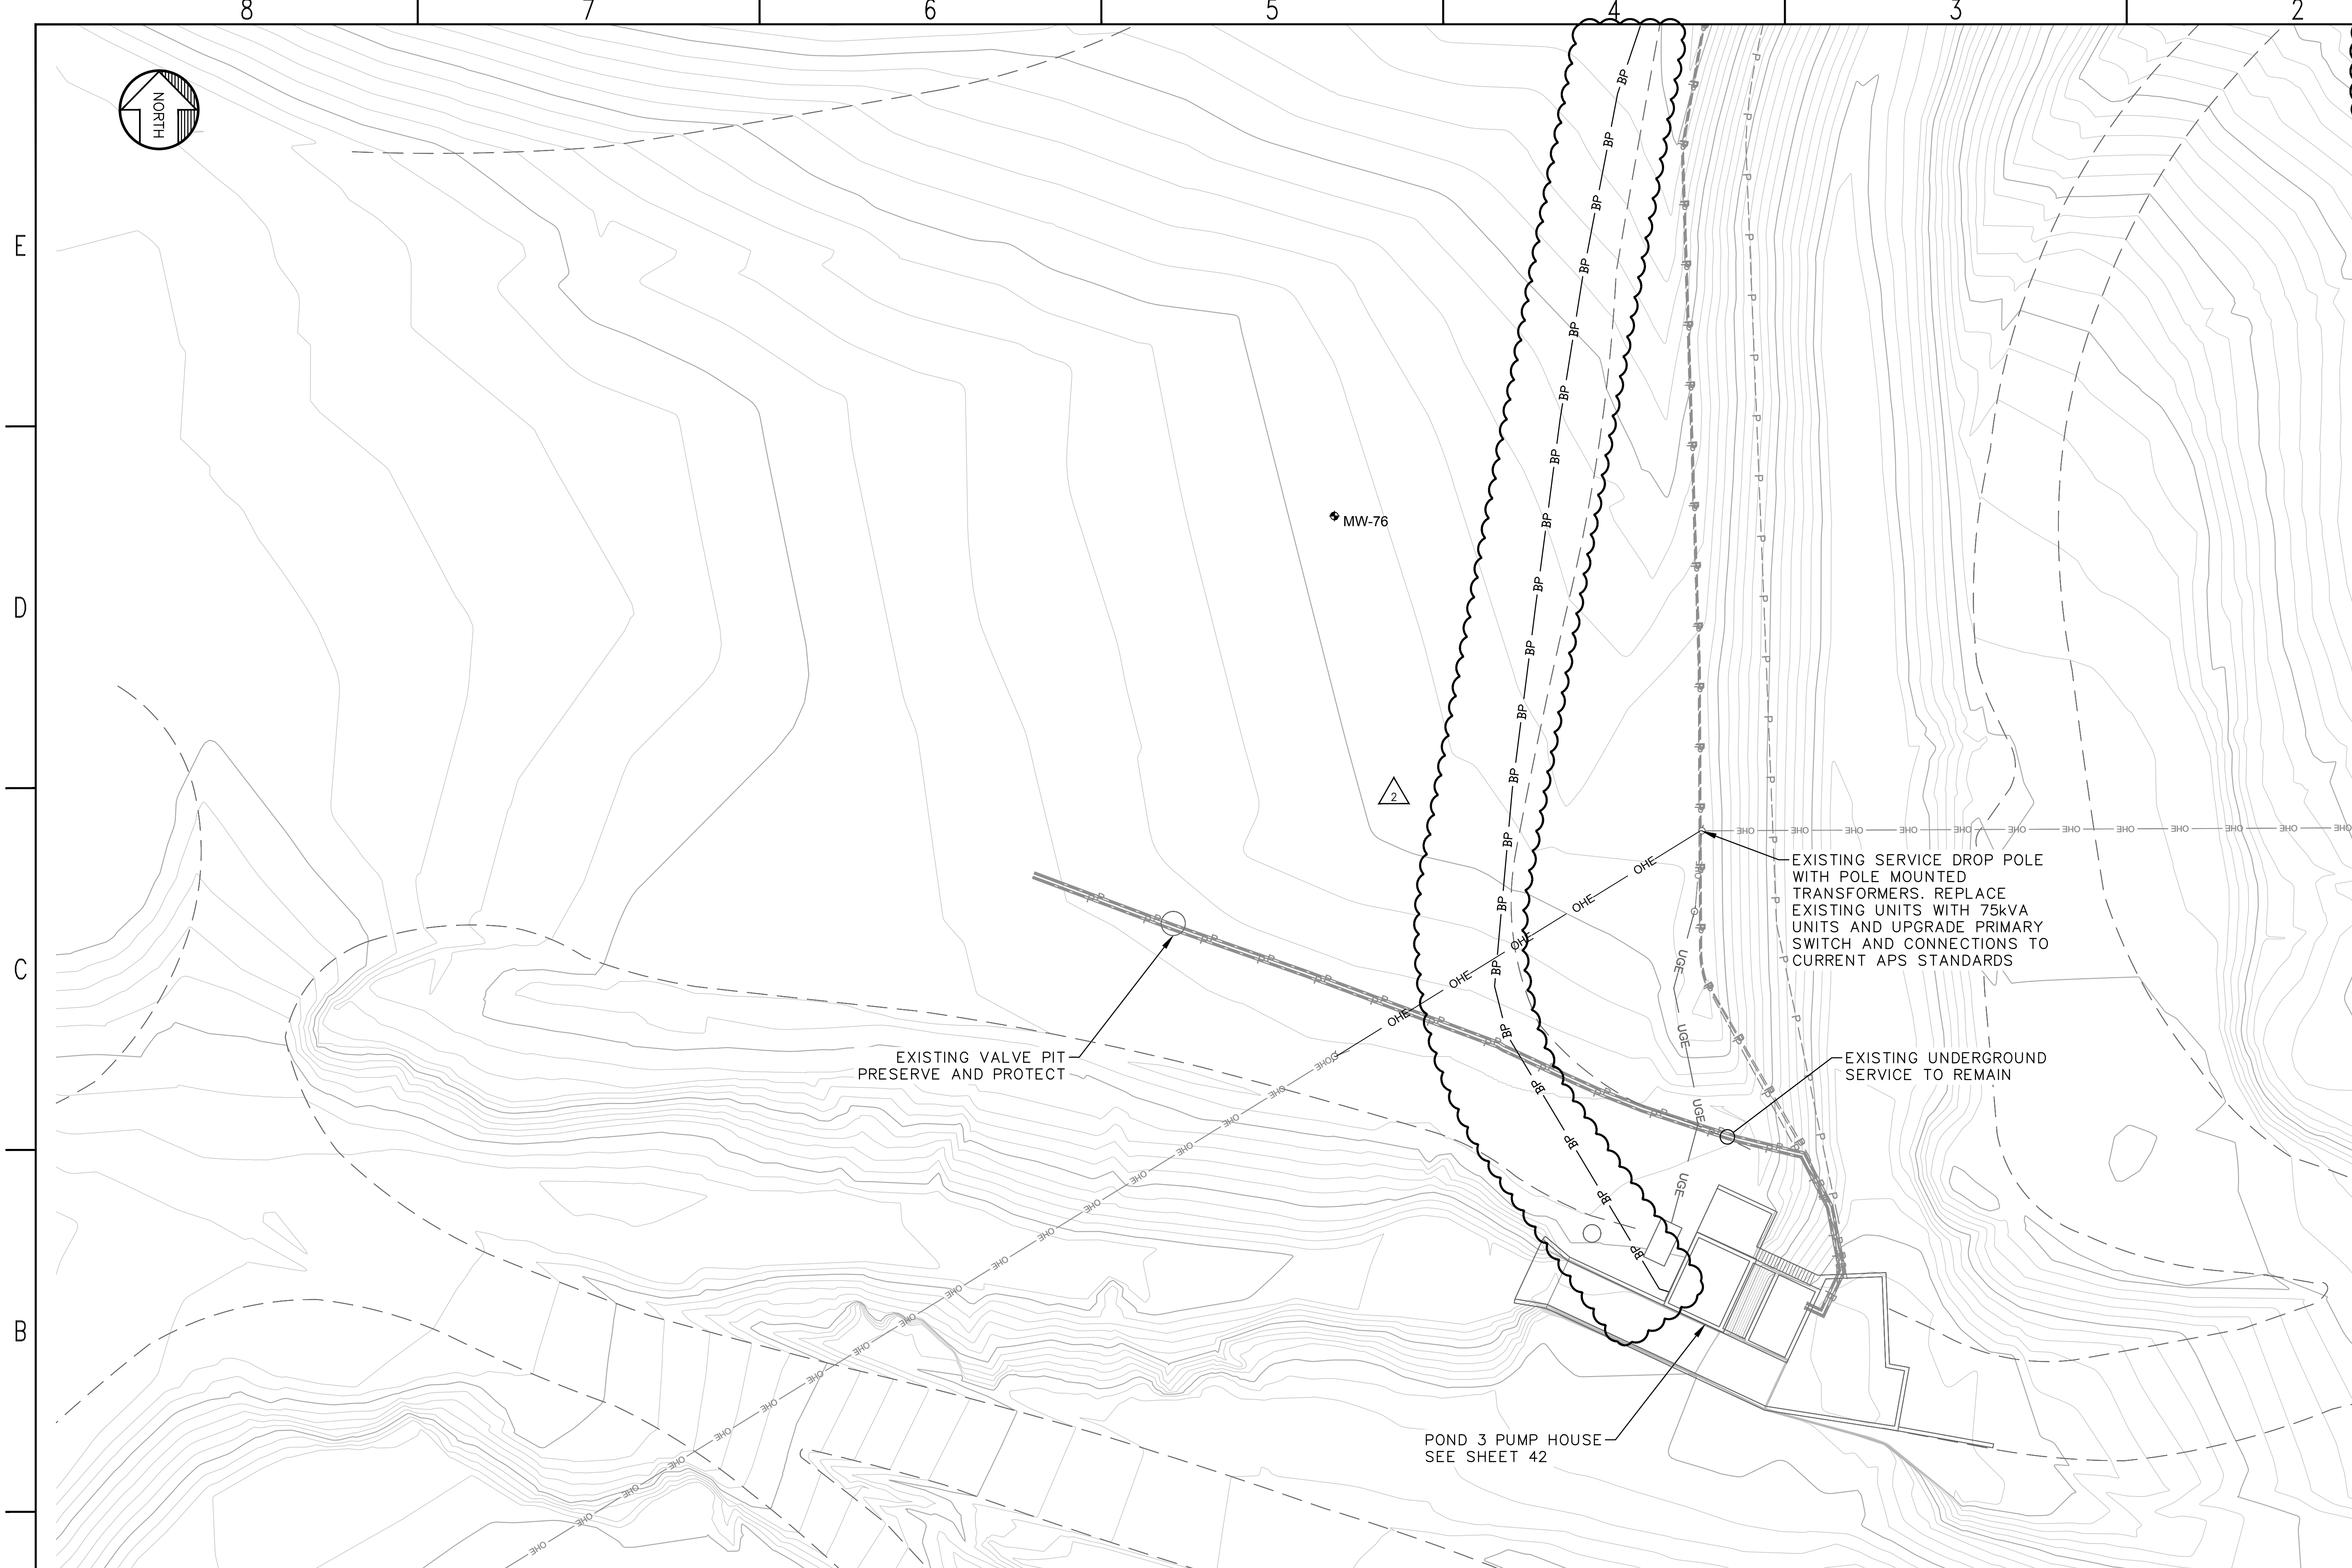

EXISTING VALVE PIT
PRESERVE AND PROTECT


EXISTING SERVICE DROP POLE
WITH POLE MOUNTED
TRANSFORMERS. REPLACE
EXISTING UNITS WITH 75kVA
UNITS AND UPGRADE PRIMARY
SWITCH AND CONNECTIONS TO
CURRENT APS STANDARDS

EXISTING UNDERGROUND
SERVICE TO REMAIN

POND 3 PUMP HOUSE
SEE SHEET 42

THESE RECORD DRAWINGS DATED 01/17/20 AND TITLED "FOR RECORD" HAVE BEEN DEVELOPED FROM AS-BUILT MARKUPS AND MAY NOT REPRESENT THE FINAL PROJECT, AS CONSTRUCTED, IN EVERY DETAIL. THESE RECORD DRAWINGS HAVE BEEN PREPARED BASED ON INFORMATION SUPPLIED BY OTHERS AND THE ENGINEER HAS NOT VERIFIED THE ACCURACY OR COMPLETENESS OF THE INFORMATION.

PLAN VIEW
SCALE: 1"=20' (FULL SIZE)

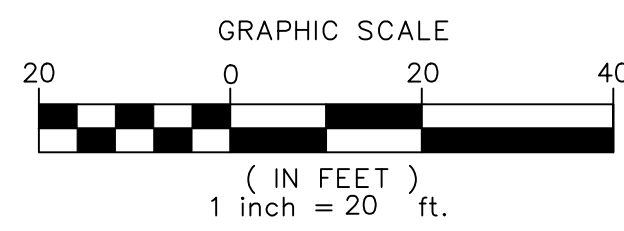

2	01-17-20	FOR RECORD	AWF	DEM			fcc06814	
1	5-16-19	CHANGE TO GROUNDED Y SERVICE	LDB	DEM		EDM		
NO.	DATE	REVISION	DWN	CHD	EXD	RWVD	APVD	W.A.

FOUR CORNERS POWER PLANT
RETURN WATER POND
ELECTRICAL POND 3 SITE PLAN



SCALE 1" = 20' DATE 10/04/19

DWN	LDB	EXD	---	APPROVED	W A
CHD	DEM	RWVD	---	GENE MOE	FCC06814
				DRAWING APPROVED BY	


UNIT	DISC	TYPE	SYS	SUBSYS	NUMBER	SHEET
FC45CM	E	16	WP	AP	200485	39

AECOM
 7720 N. 16th Street Suite 100
 Phoenix, Arizona 85020
 (602) 371-1100

NMOC 811
 Dial 8-1-1 or 1-800-321-2537

WORK SAFELY TODAY

THIS DRAWING IS CONFIDENTIAL AND SHALL NOT BE USED OR REPRODUCED IN ANY PART WITHOUT WRITTEN CONSENT OF PINNACLE WEST CAPITAL CORPORATION.

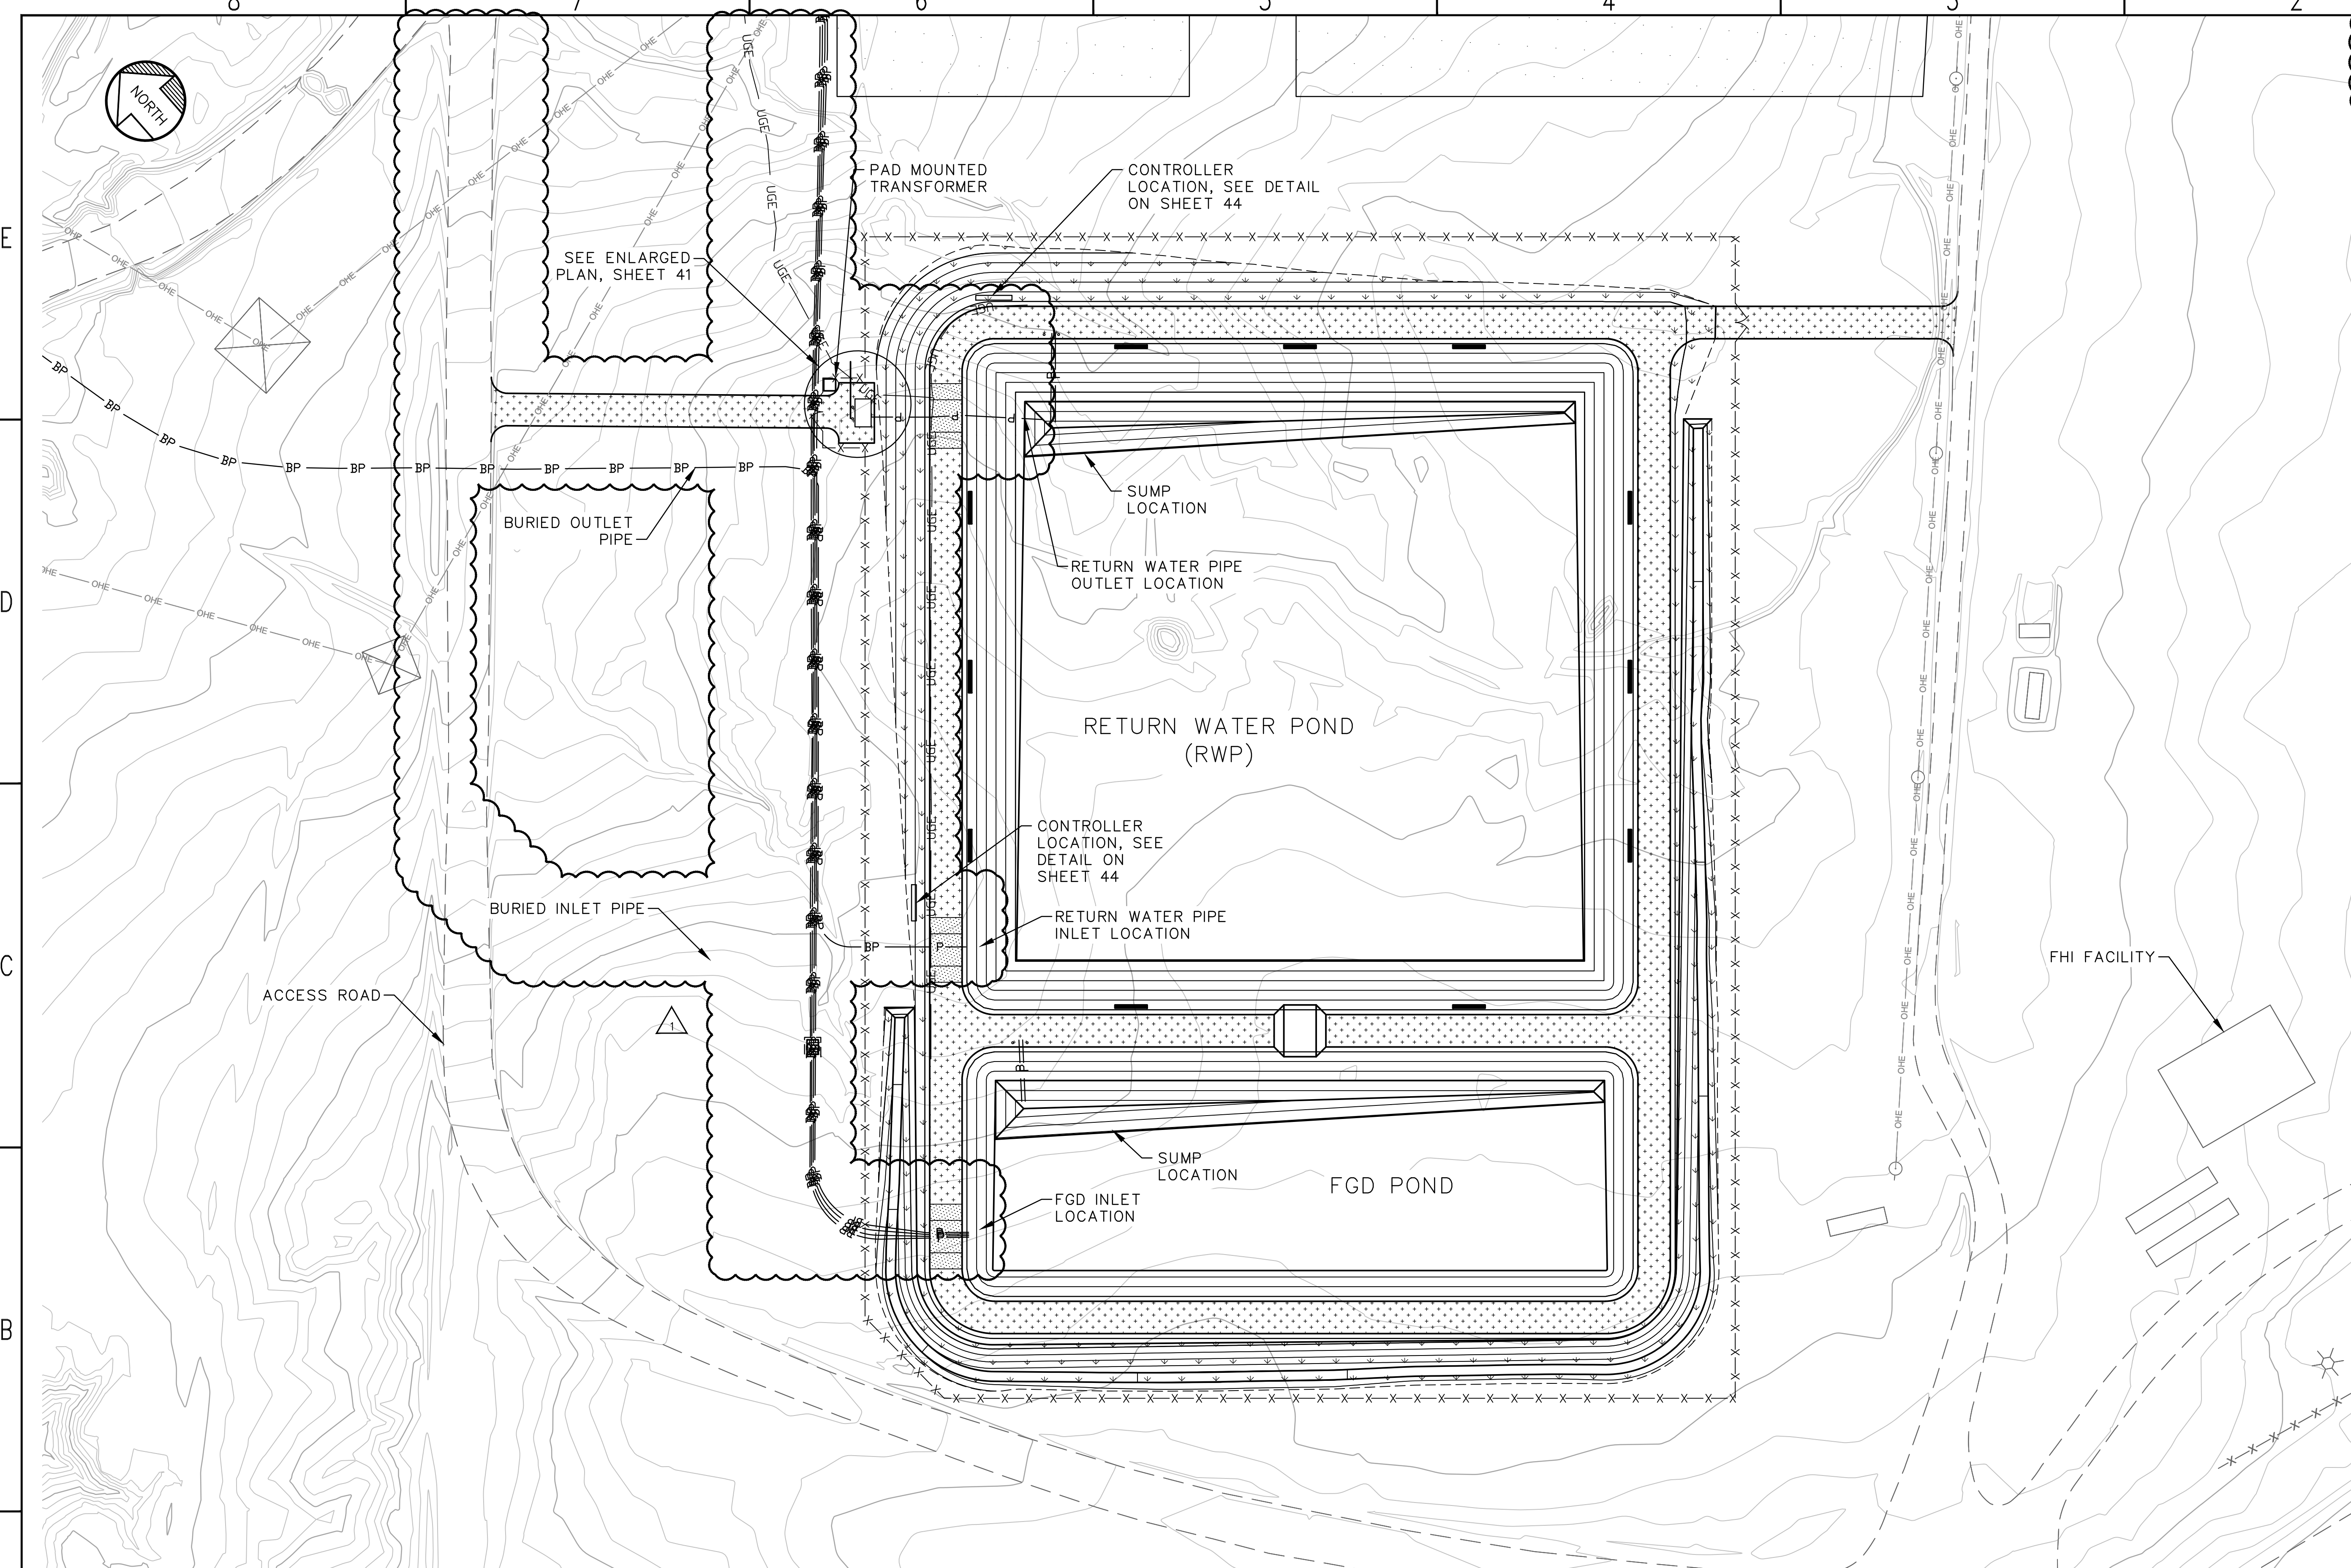

CONSTRUCTION NOTES:
 1. AS-BUILT LINES, GRADES, AND POINTS CAN BE FOUND IN APS DRAWING NUMBER FC00CM-C-17-SF-RG-100003-101.

ACCESS ROAD

BURIED OUTLET PIPE

BURIED INLET PIPE

PAD MOUNTED TRANSFORMER

CONTROLLER LOCATION, SEE DETAIL ON SHEET 44

SEE ENLARGED PLAN, SHEET 41

SUMP LOCATION

RETURN WATER PIPE OUTLET LOCATION

RETURN WATER POND (RWP)

CONTROLLER LOCATION, SEE DETAIL ON SHEET 44

RETURN WATER PIPE INLET LOCATION


FHI FACILITY

SUMP LOCATION

FGD INLET LOCATION

FGD POND

PLAN VIEW
 SCALE: 1"=50' (FULL SIZE)

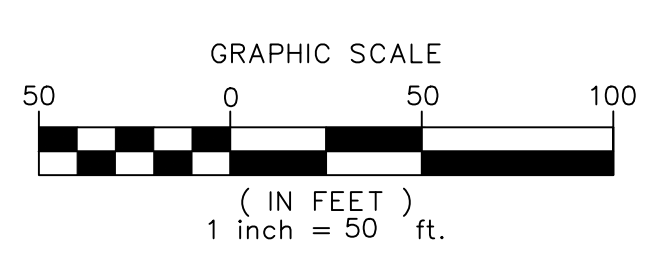

THESE RECORD DRAWINGS DATED 01/17/20 AND TITLED "FOR RECORD" HAVE BEEN DEVELOPED FROM AS-BUILT MARKUPS AND MAY NOT REPRESENT THE FINAL PROJECT, AS CONSTRUCTED, IN EVERY DETAIL. THESE RECORD DRAWINGS HAVE BEEN PREPARED BASED ON INFORMATION SUPPLIED BY OTHERS AND THE ENGINEER HAS NOT VERIFIED THE ACCURACY OR COMPLETENESS OF THE INFORMATION.

1	01-17-20	FOR RECORD	AWF	DEM				FC006814
NO.	DATE	REVISION	DWN	CHD	EXD	RWVD	APVD	W.A.

FOUR CORNERS POWER PLANT
 RETURN WATER POND
 ELECTRICAL RETURN WATER POND PLAN



SCALE: 1" = 50' DATE: 10/04/19

DWN	LDB	EXD	---	APPROVED	W A
CHD	DEM	RWVD	---	GENE MOE	FCC06814
				DRAWING APPROVED BY	

UNIT	DISC	TYPE	SYS	SUBSYS	NUMBER	SHEET
FC45CM	E	16	WP	AP	200485	40

AECOM
 7720 N. 16th Street Suite 100
 Phoenix, Arizona 85020
 (602) 371-1100

NMOC 811
 Dial 8-1-1 or 1-800-321-2537

WORK SAFELY TODAY

THIS DRAWING IS CONFIDENTIAL AND SHALL NOT BE USED OR REPRODUCED IN ANY PART WITHOUT WRITTEN CONSENT OF PINNACLE WEST CAPITAL CORPORATION.

GENERAL NOTES:

- REFER TO SHEET 43 FOR CONDUIT/CABLE INFORMATION.
- AS-BUILT LINES, GRADES, AND POINTS CAN BE FOUND IN APS DRAWING NUMBER FC00CM-C-17-SF-RG-100003-101.

THESE RECORD DRAWINGS DATED 01/17/20 AND TITLED "FOR RECORD" HAVE BEEN DEVELOPED FROM AS-BUILT MARKUPS AND MAY NOT REPRESENT THE FINAL PROJECT, AS CONSTRUCTED, IN EVERY DETAIL. THESE RECORD DRAWINGS HAVE BEEN PREPARED BASED ON INFORMATION SUPPLIED BY OTHERS AND THE ENGINEER HAS NOT VERIFIED THE ACCURACY OR COMPLETENESS OF THE INFORMATION.

1	01-17-20	FOR RECORD	AWF	DEM				FC006814
NO.	DATE	REVISION	DWN	CHD	EXD	RWVD	APVD	W.A.

FOUR CORNERS POWER PLANT
RETURN WATER POND
RWP AND SEWAGE EFFLUENT PUMPING STATION PLANS



SCALE: 1/2" = 1'-0" DATE: 10/04/19



DWN	LDB	EXD	---	APPROVED	W A
CHD	DEM	RWVD	---	GENE MOE	FCC06814
				DRAWING APPROVED BY	

UNIT	DISC	TYPE	SYS	SUBSYS	NUMBER	SHEET
FC45CM	E	16	WP	AP	200485	41




WORK SAFELY TODAY


THIS DRAWING IS CONFIDENTIAL AND SHALL NOT BE USED OR REPRODUCED IN ANY PART WITHOUT WRITTEN CONSENT OF PINNACLE WEST CAPITAL CORPORATION.

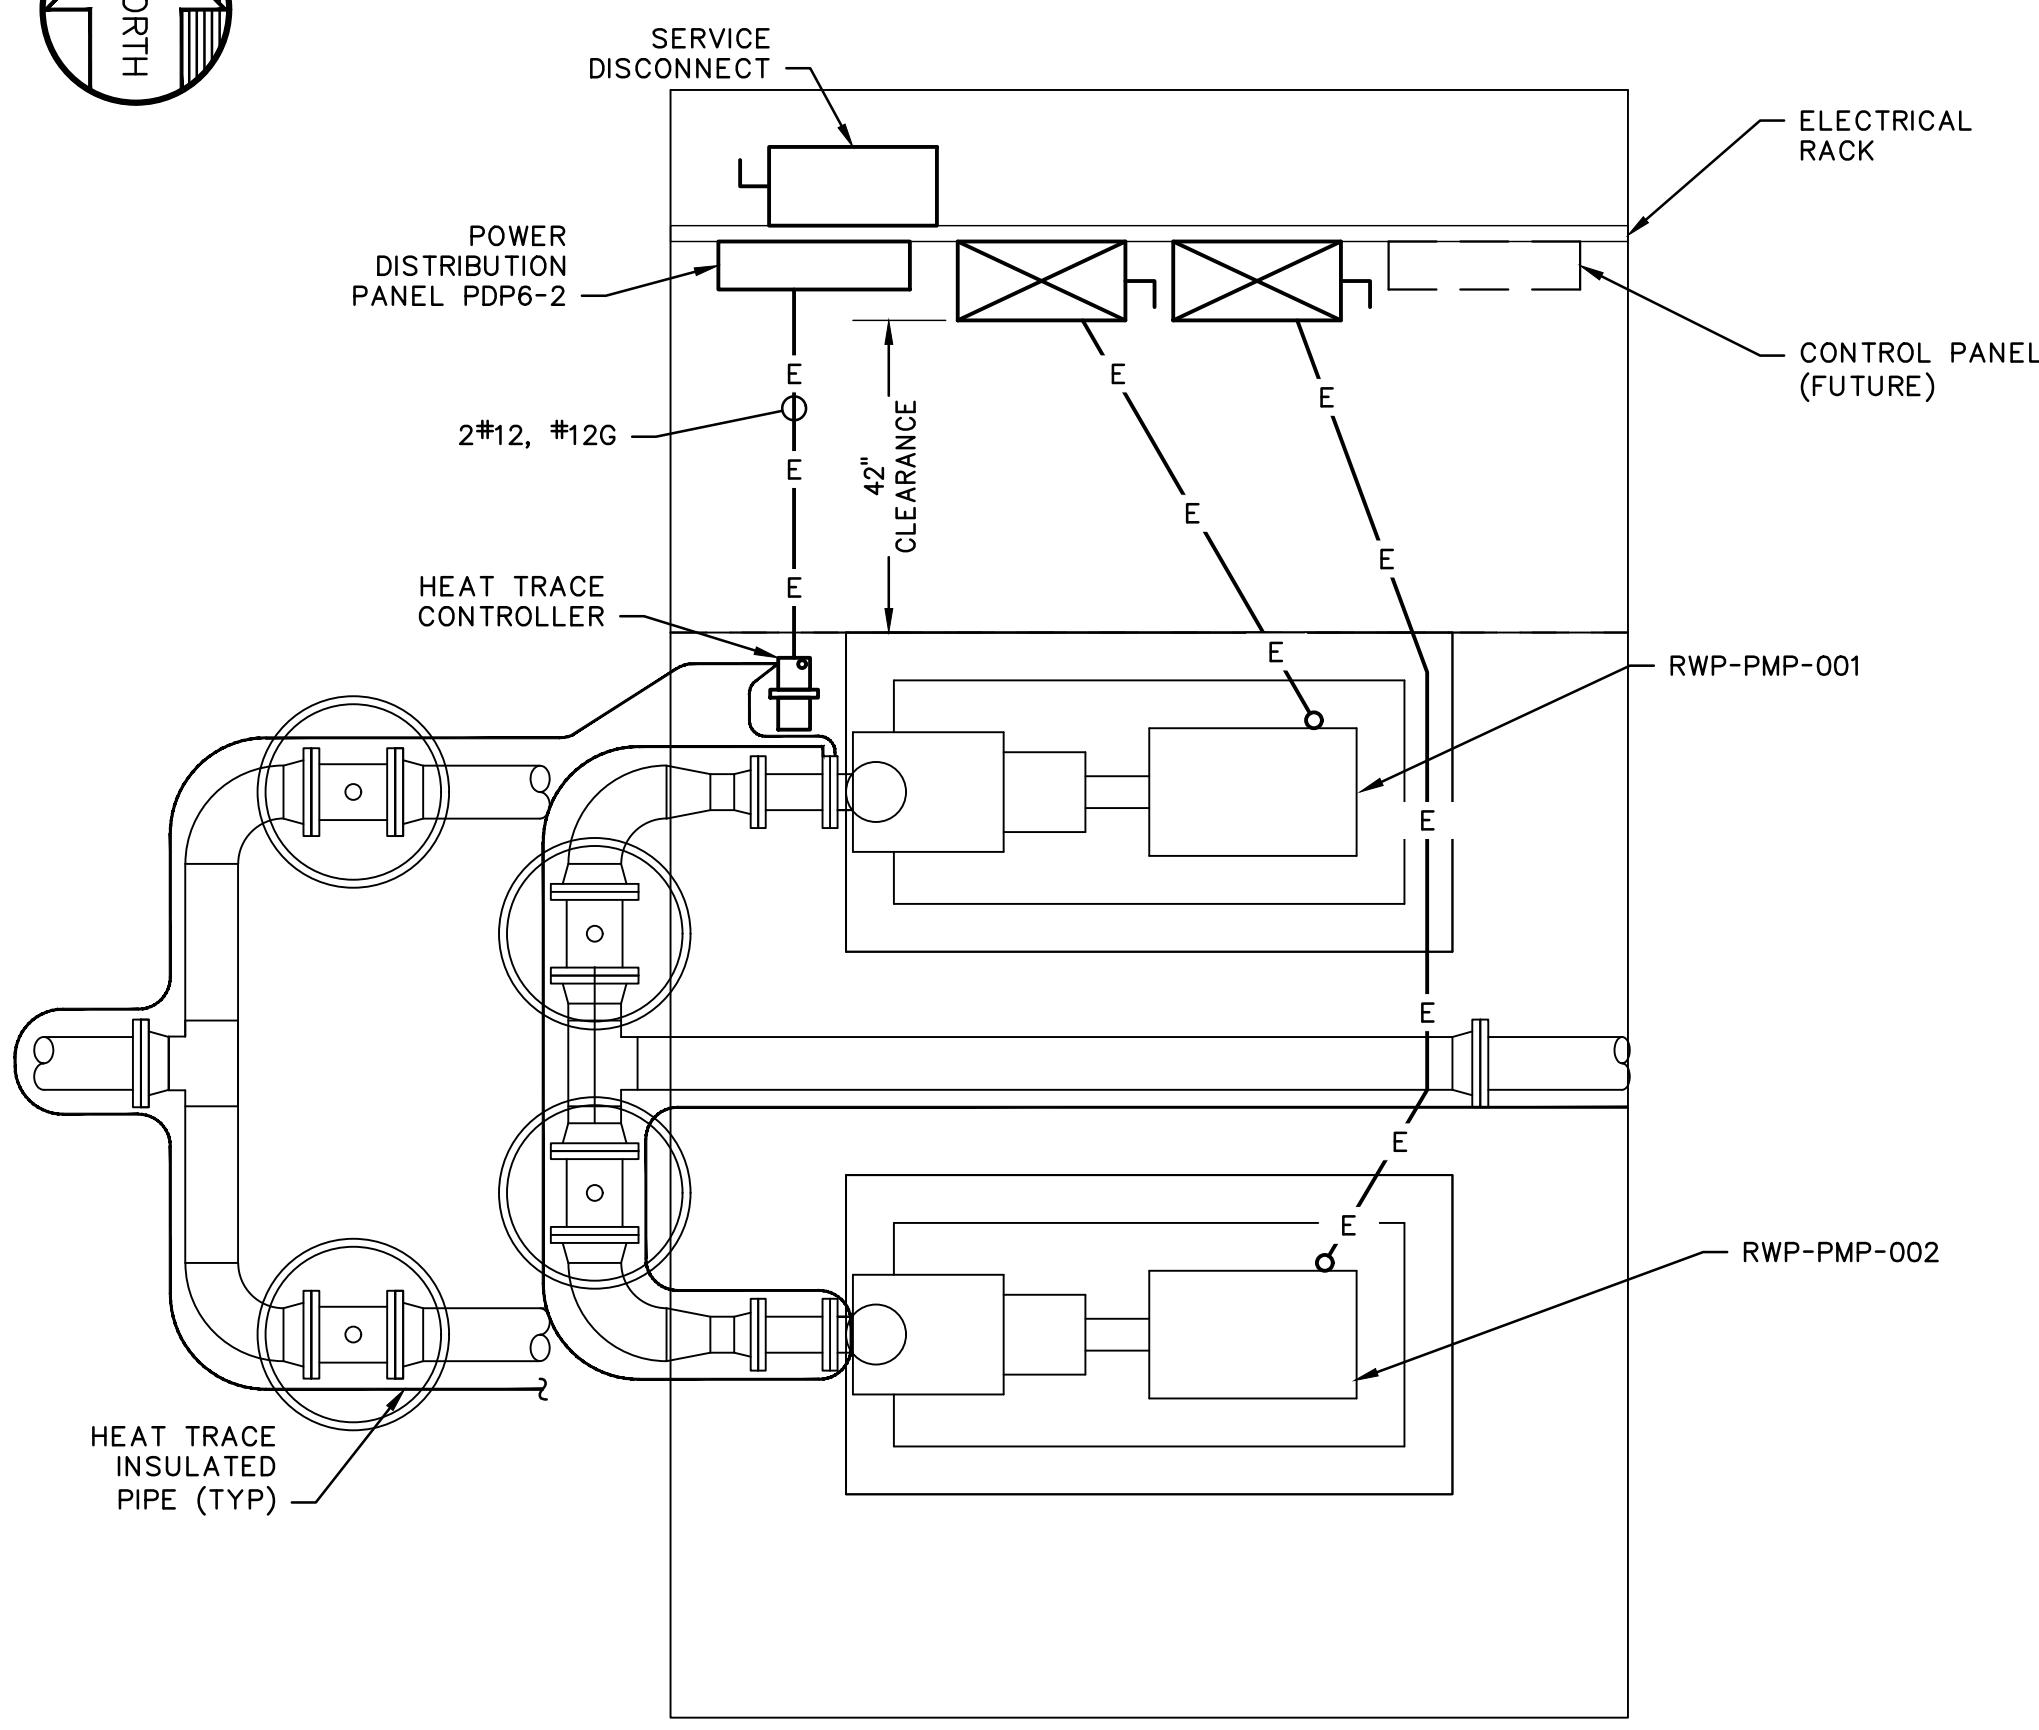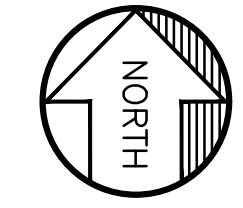



PLAN VIEW
SCALE: 1/2"=1'-0" (FULL SIZE)

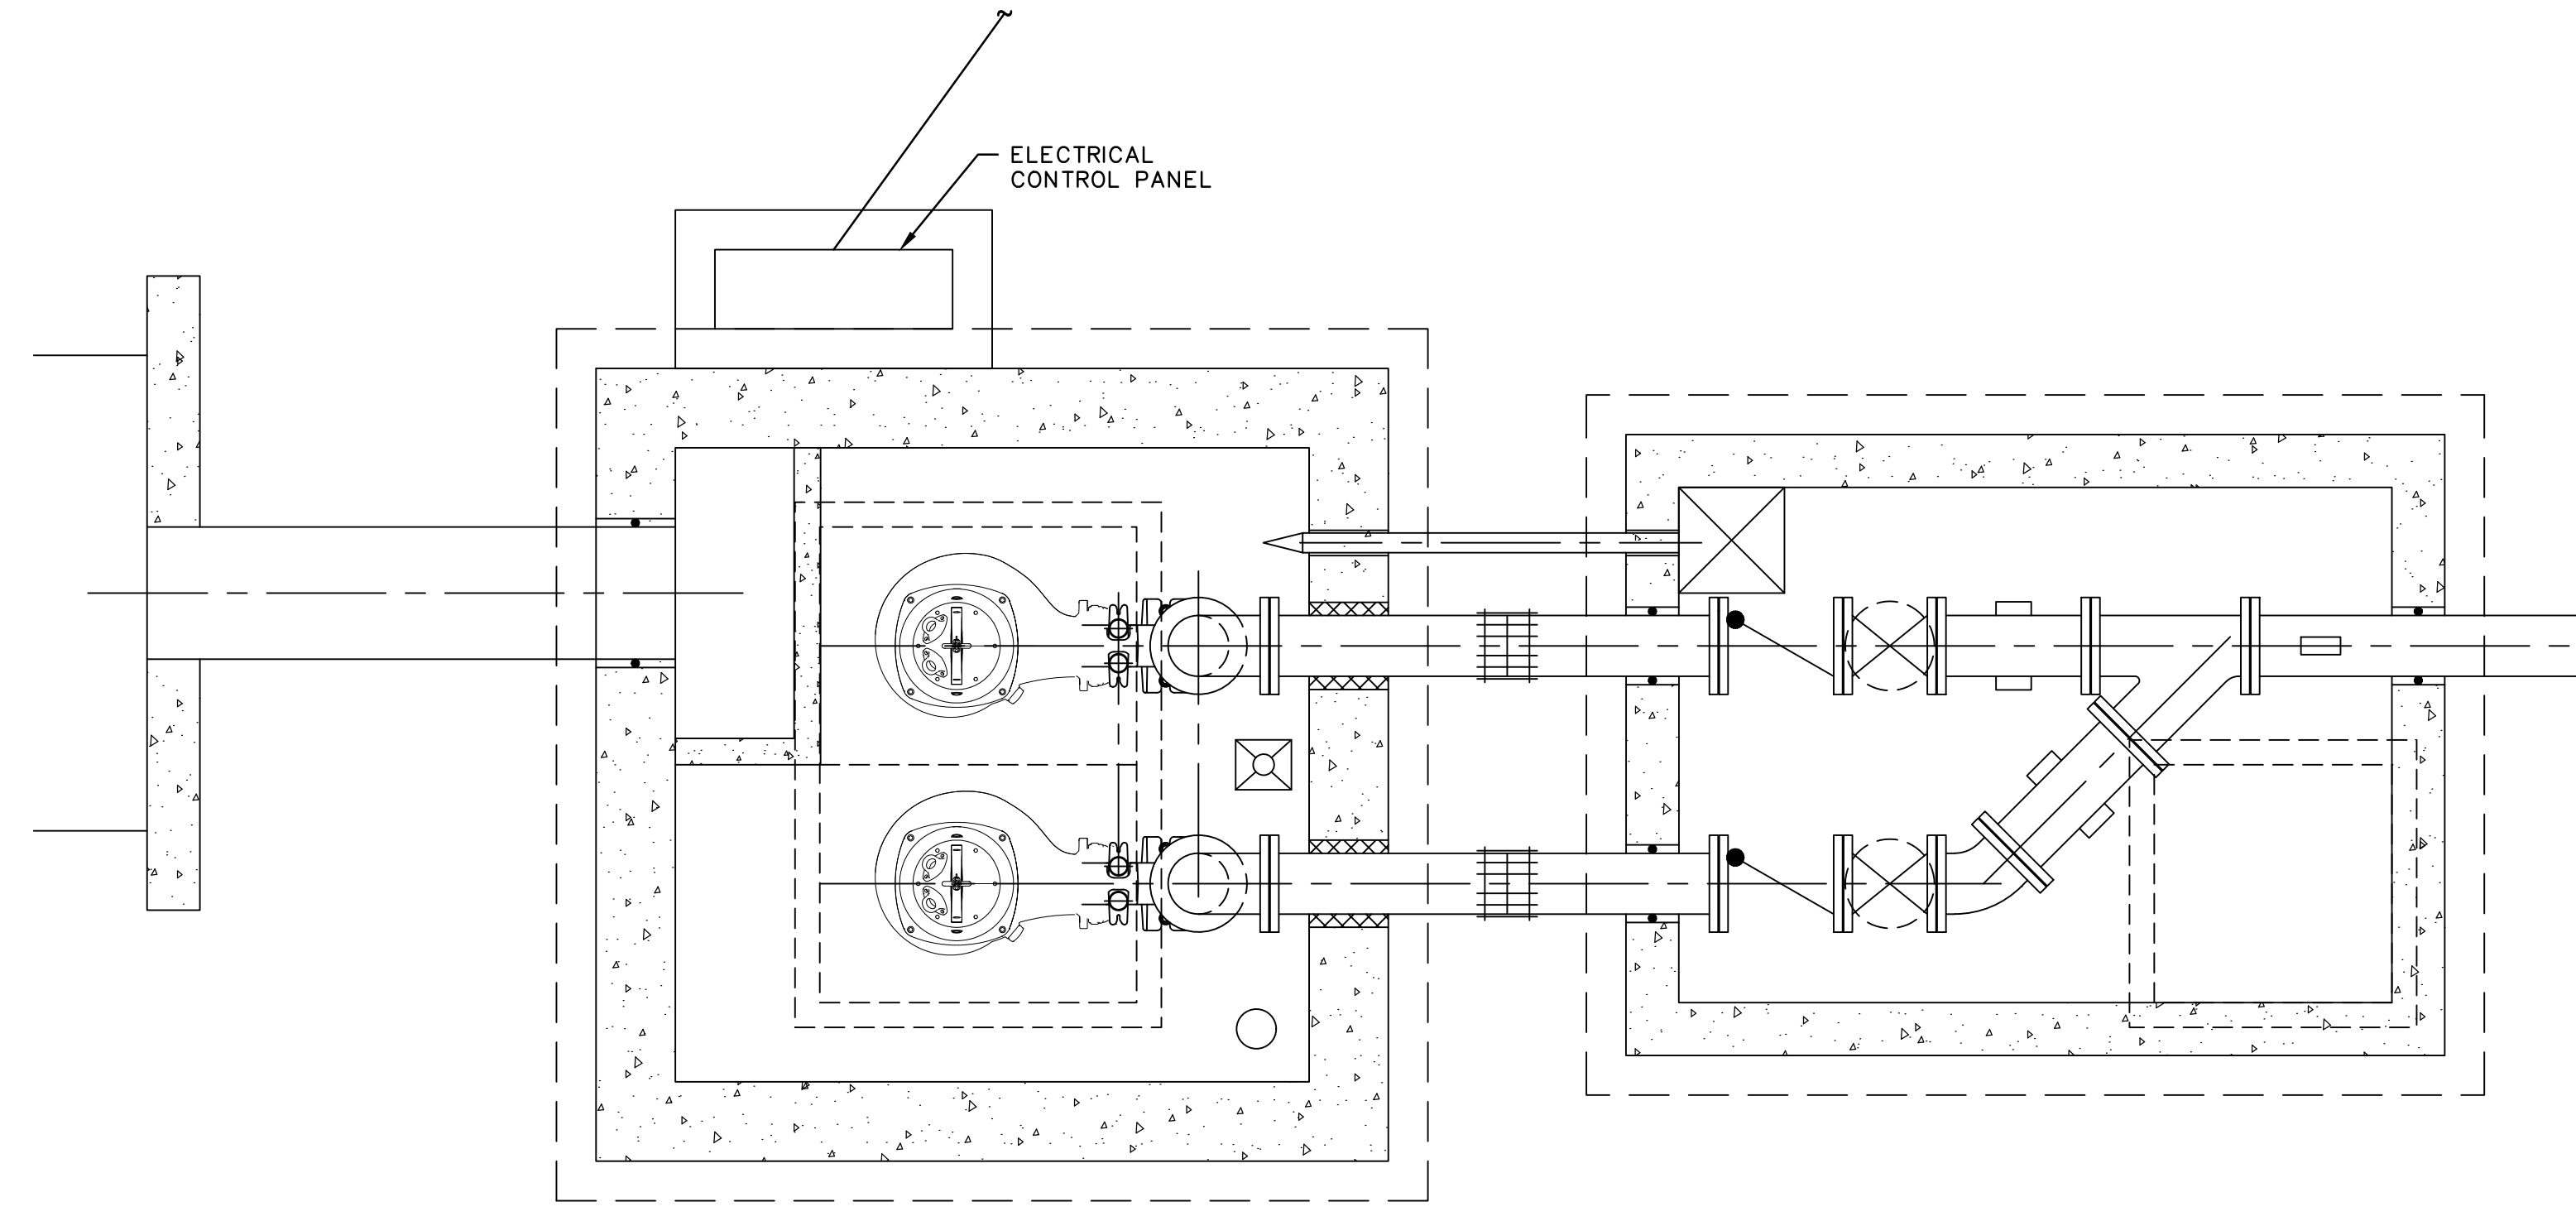


PLAN VIEW
SCALE: 1/2"=1'-0" (FULL SIZE)

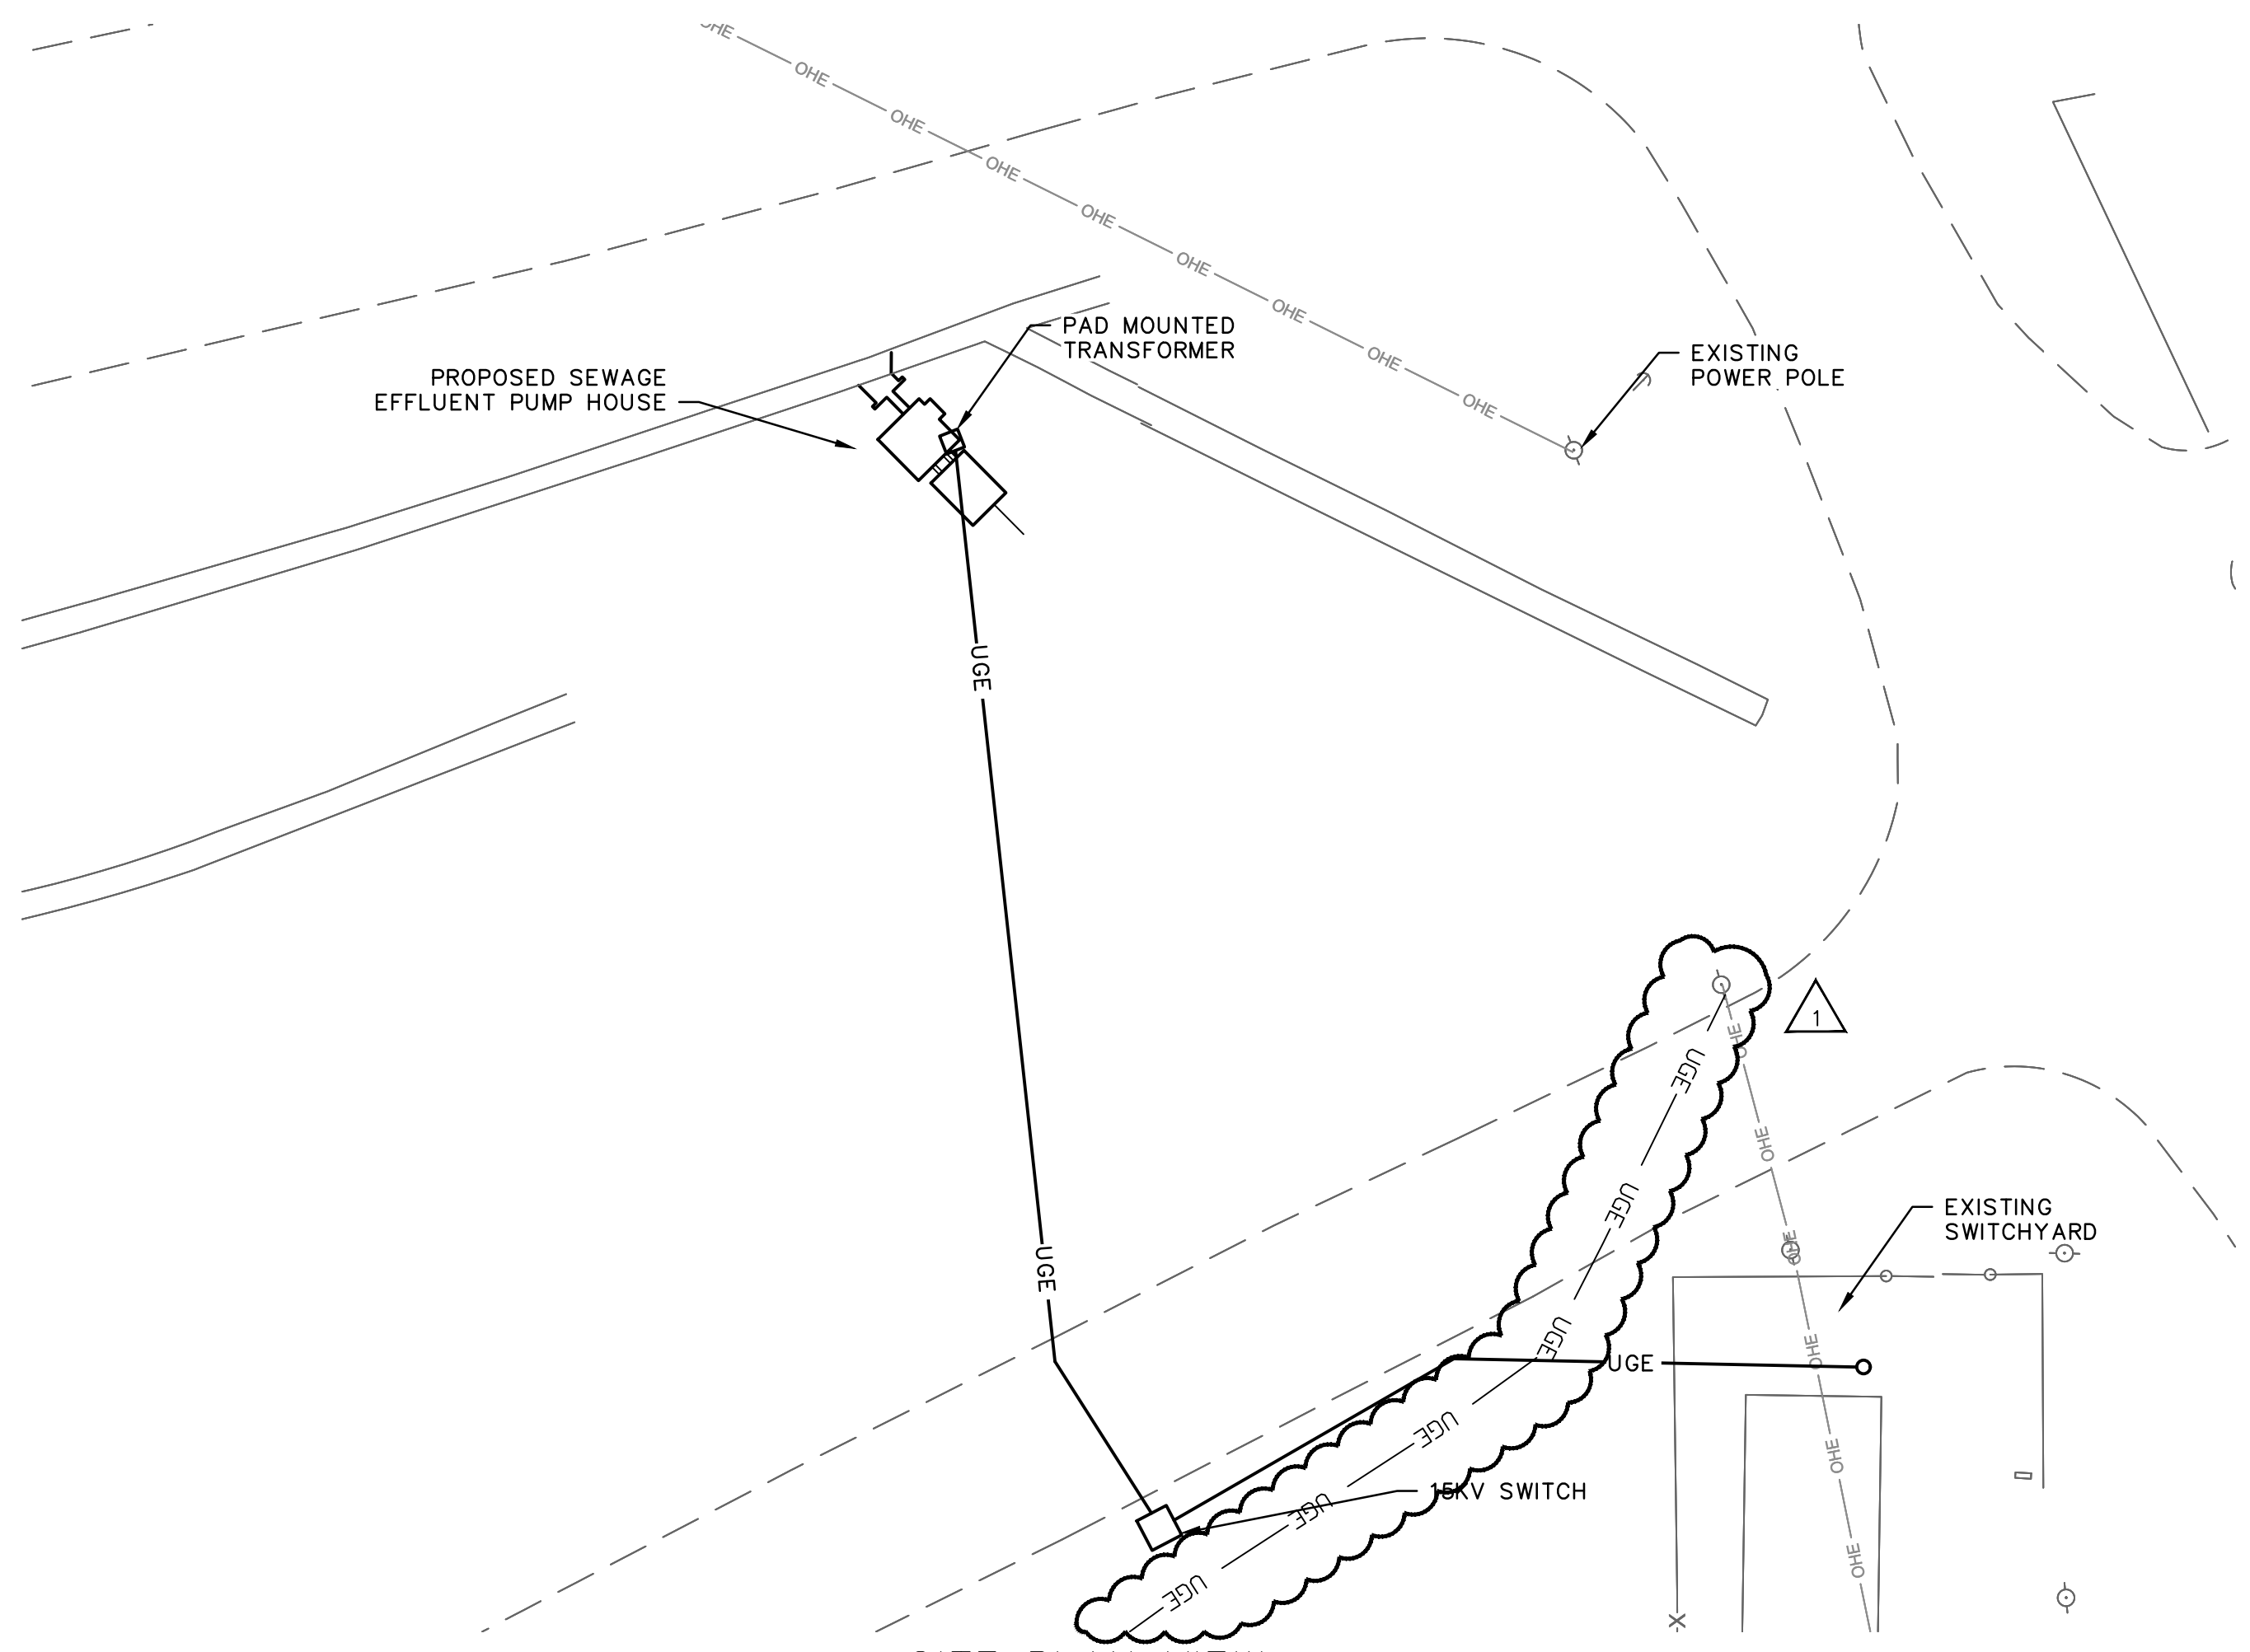

SITE PLAN VIEW
SCALE: 1"=30'-0" (FULL SIZE)

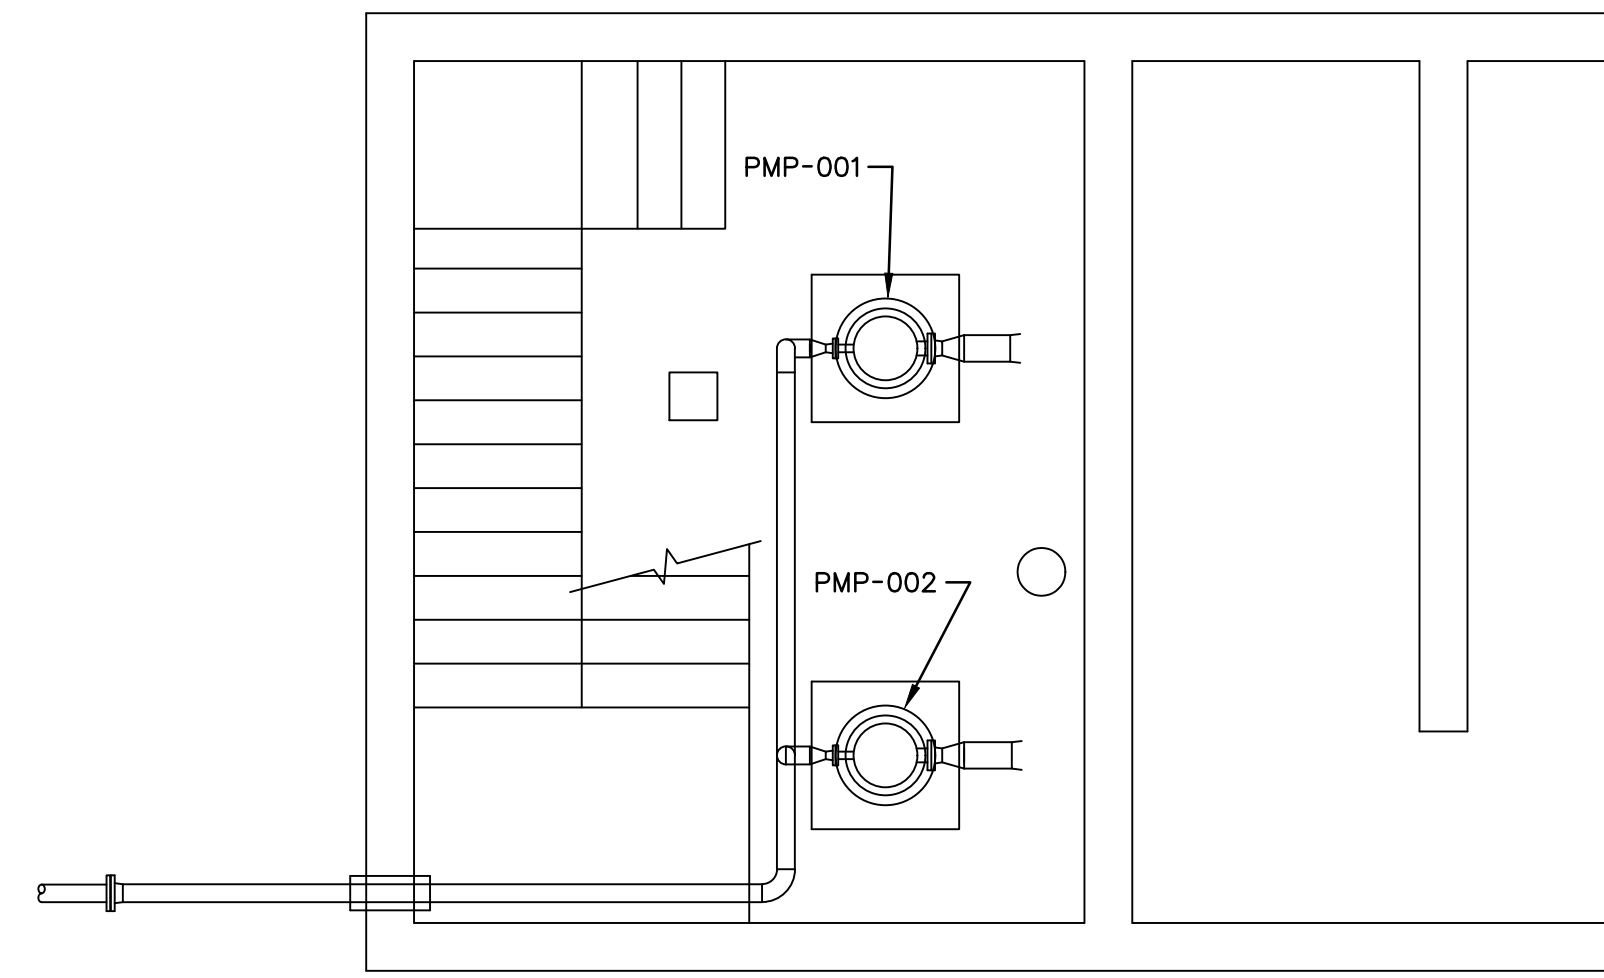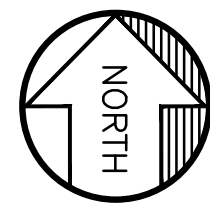

ELECTRICAL LOWER LEVEL PLAN
SCALE: 1/4"=1'-0" (FULL SIZE)

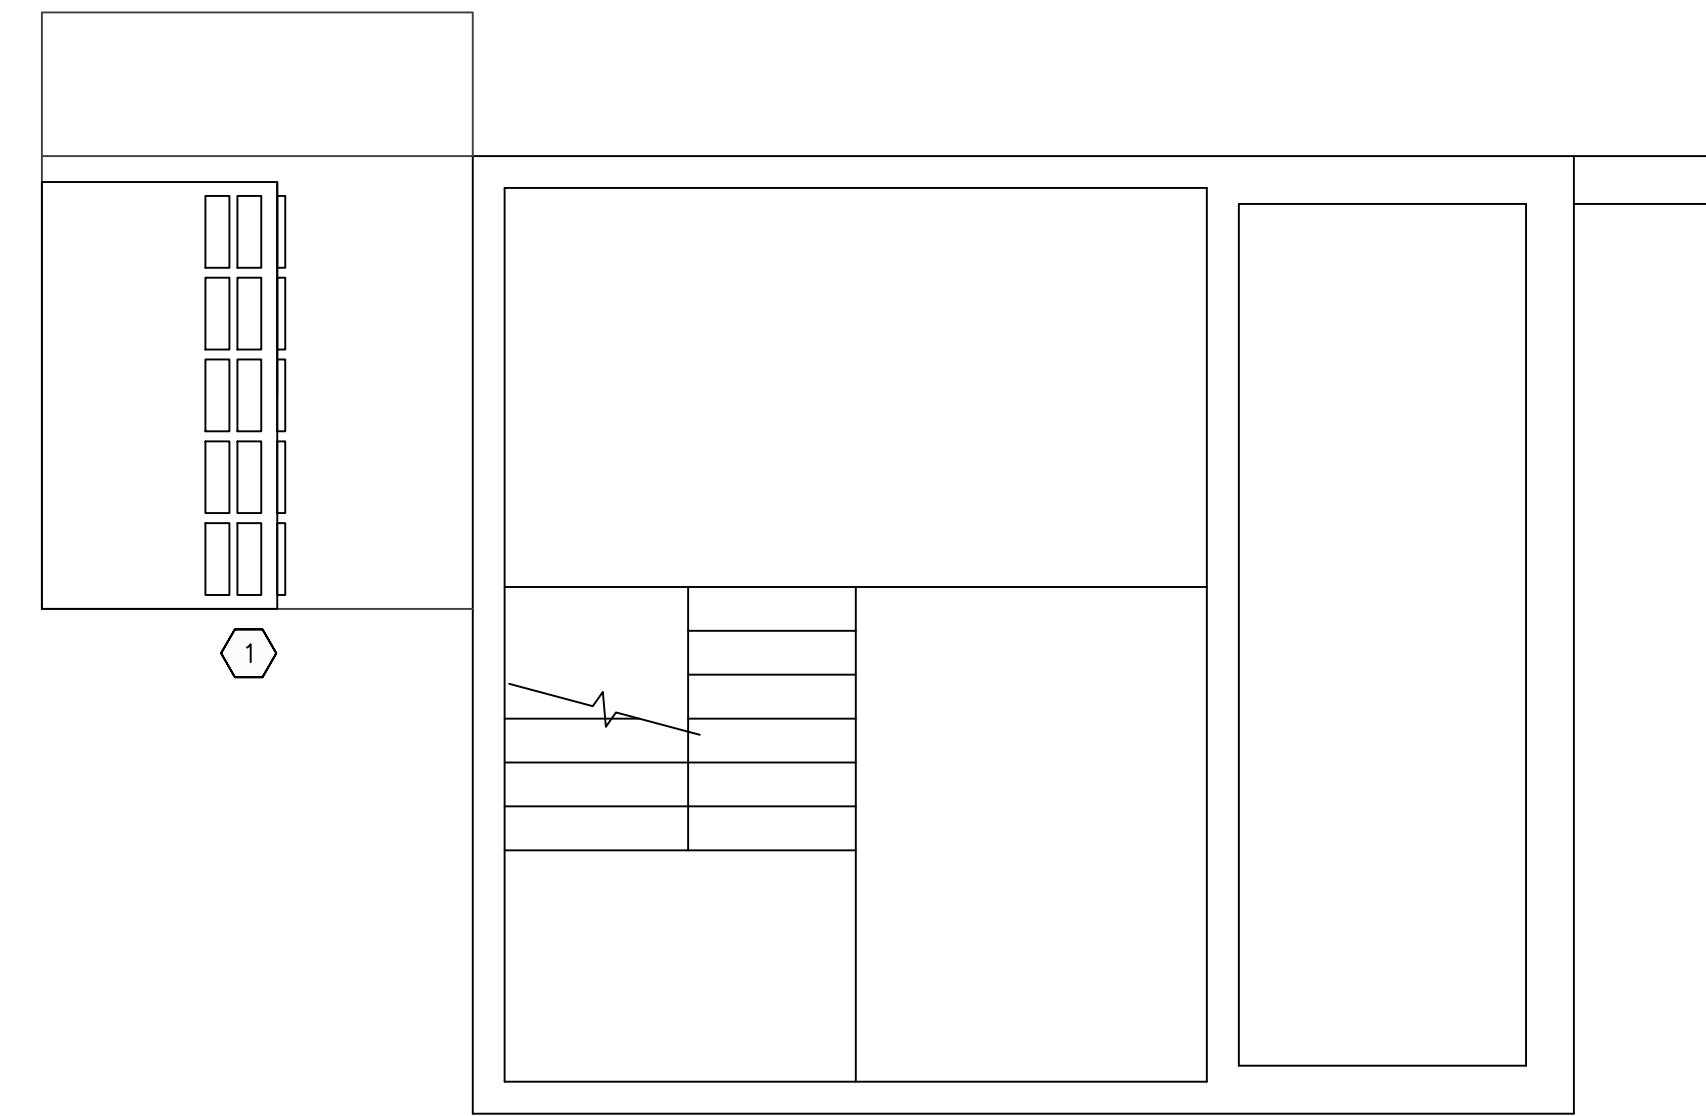

ELECTRICAL UPPER LEVEL PLAN
SCALE: 1/4"=1'-0" (FULL SIZE)

CONSTRUCTION NOTES:

1. THE CONTRACTOR SHALL FIELD VERIFY ALL EXISTING CONDITIONS, DIMENSIONS, AND ELEVATIONS PRIOR TO START OF CONSTRUCTION AS REQUIRED TO COORDINATE NEW CONSTRUCTION. NOTIFY ENGINEER OF ANY DISCREPANCIES OR CONFLICTS FOUND IN CONTRACT DOCUMENTS AND/OR FIELD CONDITIONS.

KEY NOTES:

- 1 NEW MCC BUS, 800A, 480V/3Ø/3W, 65KAIC.

THESE RECORD DRAWINGS DATED 01/17/20 AND TITLED "FOR RECORD" HAVE BEEN DEVELOPED FROM AS-BUILT MARKUPS AND MAY NOT REPRESENT THE FINAL PROJECT, AS CONSTRUCTED, IN EVERY DETAIL. THESE RECORD DRAWINGS HAVE BEEN PREPARED BASED ON INFORMATION SUPPLIED BY OTHERS AND THE ENGINEER HAS NOT VERIFIED THE ACCURACY OR COMPLETENESS OF THE INFORMATION.

1	01-17-20	FOR RECORD	AWF	DEM			FCC06814	
NO.	DATE	REVISION	DWN	CHD	EXD	RVWD	APVD	W.A.

FOUR CORNERS POWER PLANT
RETURN WATER POND


ELECTRICAL ASH DISPOSAL PUMPING STATION PLAN



SCALE: 1/4" = 1'-0" DATE: 10/04/19


DWN	LDB	EXD	---	APPROVED	W A
CHD	DEM	RVWD	---	GENE MOE	FCC06814
				DRAWING APPROVED BY	


UNIT	DISC	TYPE	SYS	SUBSYS	NUMBER	SHEET
FC45CM	E	16	WP	AP	200485	42

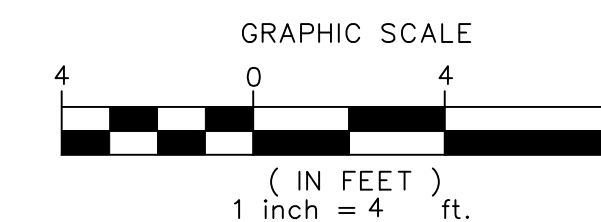



WORK SAFELY TODAY

THIS DRAWING IS CONFIDENTIAL AND SHALL NOT BE USED OR REPRODUCED IN ANY PART WITHOUT WRITTEN CONSENT OF PINNACLE WEST CAPITAL CORPORATION.

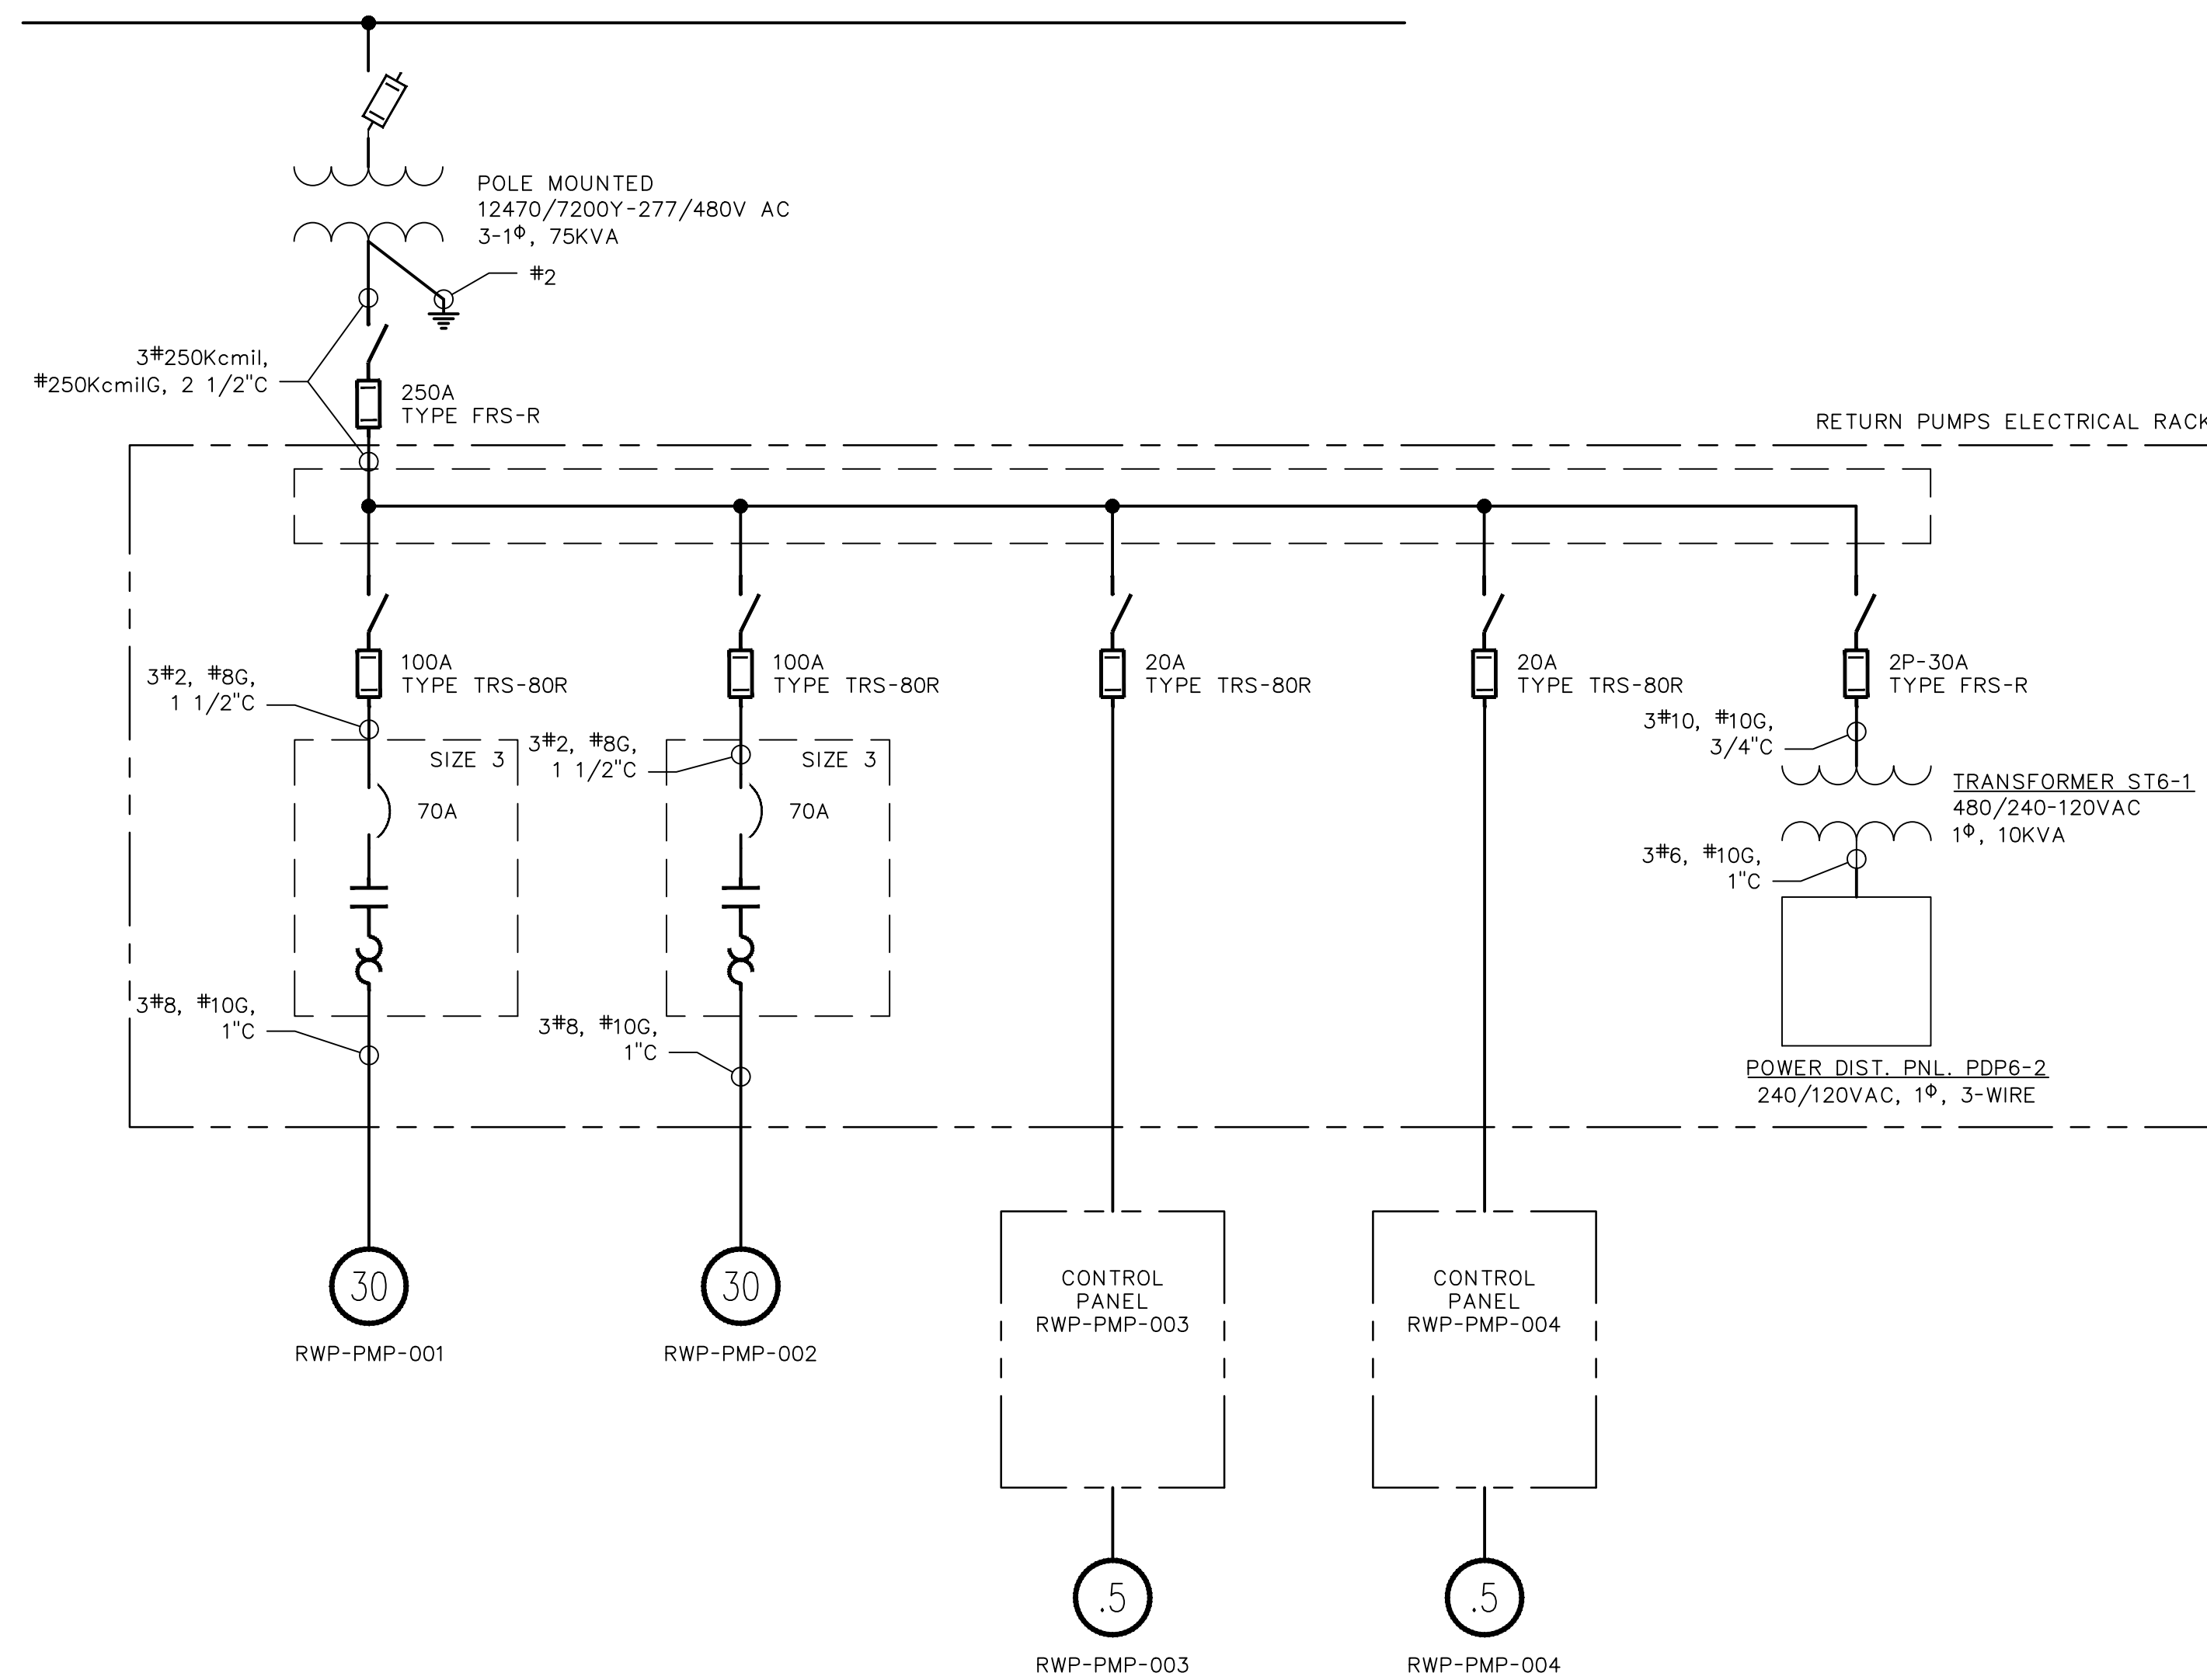

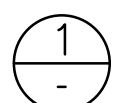ONE-LINE DIAGRAM  RETURN WATER PUMP STATION
NTS

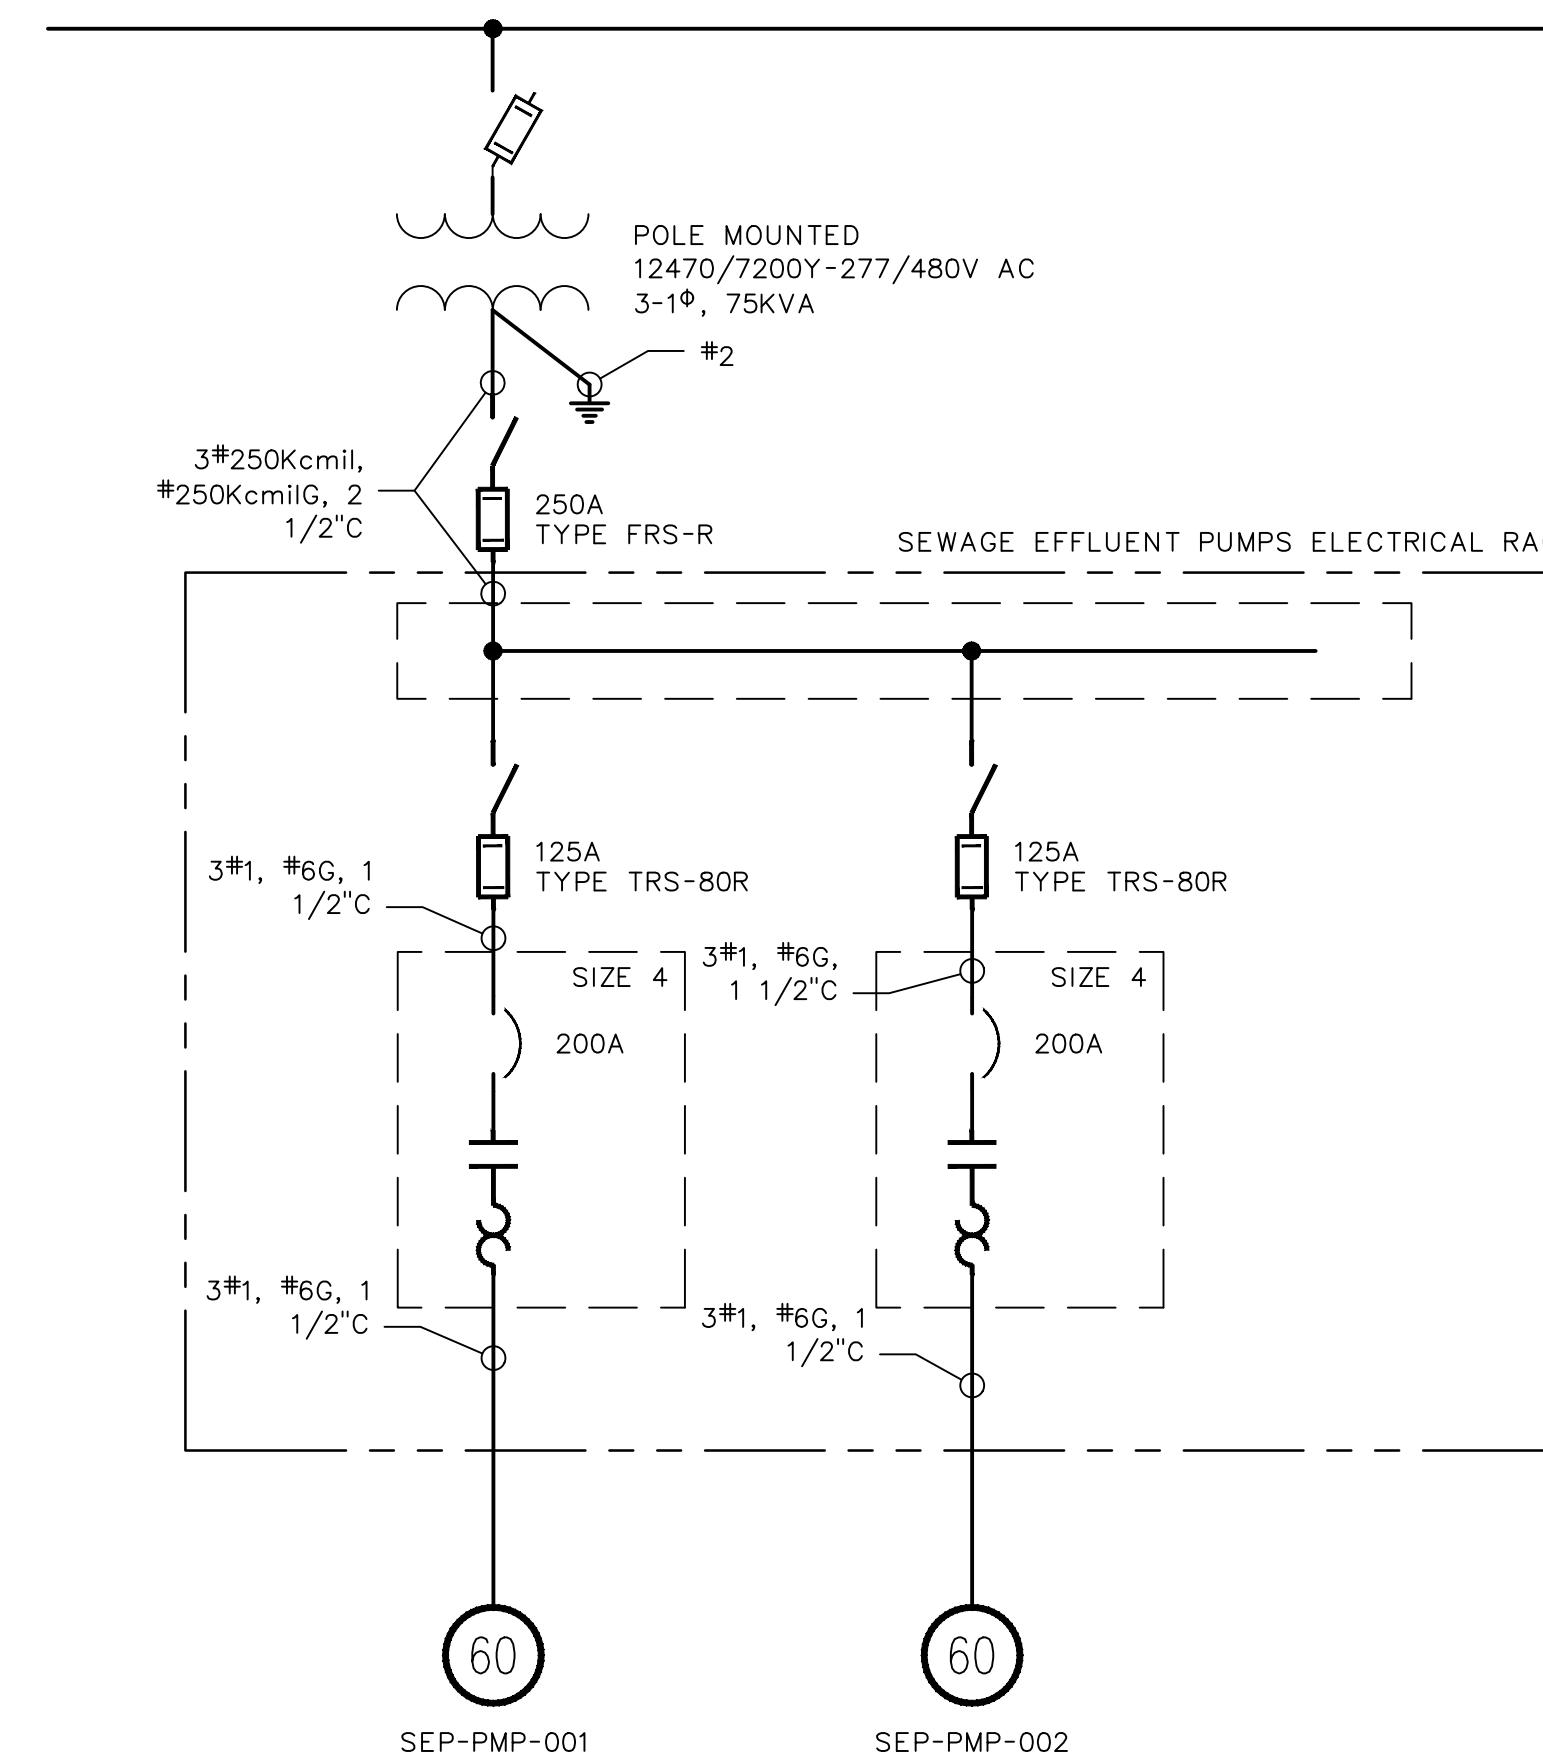

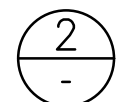ONE-LINE DIAGRAM  SEWAGE EFFLUENT PUMP STATION
NTS

PANEL:	PDP6-2	PHASE:	1	WIRE:	3 WITH GROUND	LOCATION:	RETURN PUMPS EQUIPMENT RACK
TYPE:	NEMA 3R	MAIN CIRCUIT BREAKER:	60A MCB	MOUNTING:	SURFACE		
VOLTAGE:	240 / 120 V	BREAKER TYPE:	BOLT ON				
SPD:	YES	FED FROM:	10KVA TRANSFR	PANEL DEVICE MIN. RATING:	10,000 A RMS SYMMETRICAL		
BUSING AMP:	##						

DESCRIPTION	BRANCH CHARACTERISTICS								DESCRIPTION	
	LOAD VA		BKR		CCT		LOAD VA			
	A	B	TR	NO	TR	NO	TR	A	B	
LIGHTS	300.		20	1	A	2	20	360.		RECEPTACLES
CONTROL PANEL (FUTURE)		500.	20	3	B	4	20	750.		HEAT TRACE
SPARE			20	5	A	6	20			SPARE
SPARE			20	7	B	8	20			SPARE
SPACE			20	9	A	10				SPACE
SPACE				11	B	12				SPACE
SPACE				13	A	14				SPACE
SPACE				15	B	16				SPACE
SPACE				17	A	18				SPACE
SPACE				19	B	20				SPACE
SPACE				21	A	22				SPACE
SPACE				23	B	24				SPACE
TOTAL CONNECTED VA	300	500						360	750	

TOTAL CONNECTED VA	PHASE A = 660	TOTAL CONNECTED AMPS	8.0 A	MANUFACTURER AND TYPE	
	PHASE B = 1250	TOTAL DEMAND AMPS	+8.0 A	X 125% FUTURE	9.9 A
		TOTAL DEMAND VA	= 1910 VA	X 125% FUTURE =	2387.5 VA
SUBTOTAL =	1910	SECTION 1	MOTOR STARTING AMPS		
TOTAL =	1910	SECTION 2	LESS MOTOR STARTING		

THESE RECORD DRAWINGS DATED 01/17/20 AND TITLED "FOR RECORD" HAVE BEEN DEVELOPED FROM AS-BUILT MARKUPS AND MAY NOT REPRESENT THE FINAL PROJECT, AS CONSTRUCTED, IN EVERY DETAIL. THESE RECORD DRAWINGS HAVE BEEN PREPARED BASED ON INFORMATION SUPPLIED BY OTHERS AND THE ENGINEER HAS NOT VERIFIED THE ACCURACY OR COMPLETENESS OF THE INFORMATION.

NO.	DATE	REVISION	DWN	CHD	EXD	RWVD	APVD	W.A.
3	01-17-20	FOR RECORD		AWF	DEM			FCC06814
2	5-16-19	CHANGE TO GROUNDED Y SERVICE		LDB	DEM			EDM
1	12-14-18	REVISED PUMP INFO		LDB	DEM			EDM

FOUR CORNERS POWER PLANT
RETURN WATER POND
ELECTRICAL ONE-LINE DIAGRAMS



SCALE: NONE DATE: 10/04/19


DWN	LDB	EXD	---	APPROVED	W A
CHD	DEM	RWVD	---	GENE MOE	FCC06814
				DRAWING APPROVED BY	

UNIT	DISC	TYPE	SYS	SUBSYS	NUMBER	SHEET
FC45CM	E	01	WP	AP	200485	43




WORK SAFELY TODAY

THIS DRAWING IS CONFIDENTIAL AND SHALL NOT BE USED OR REPRODUCED IN ANY PART WITHOUT WRITTEN CONSENT OF PINNACLE WEST CAPITAL CORPORATION.

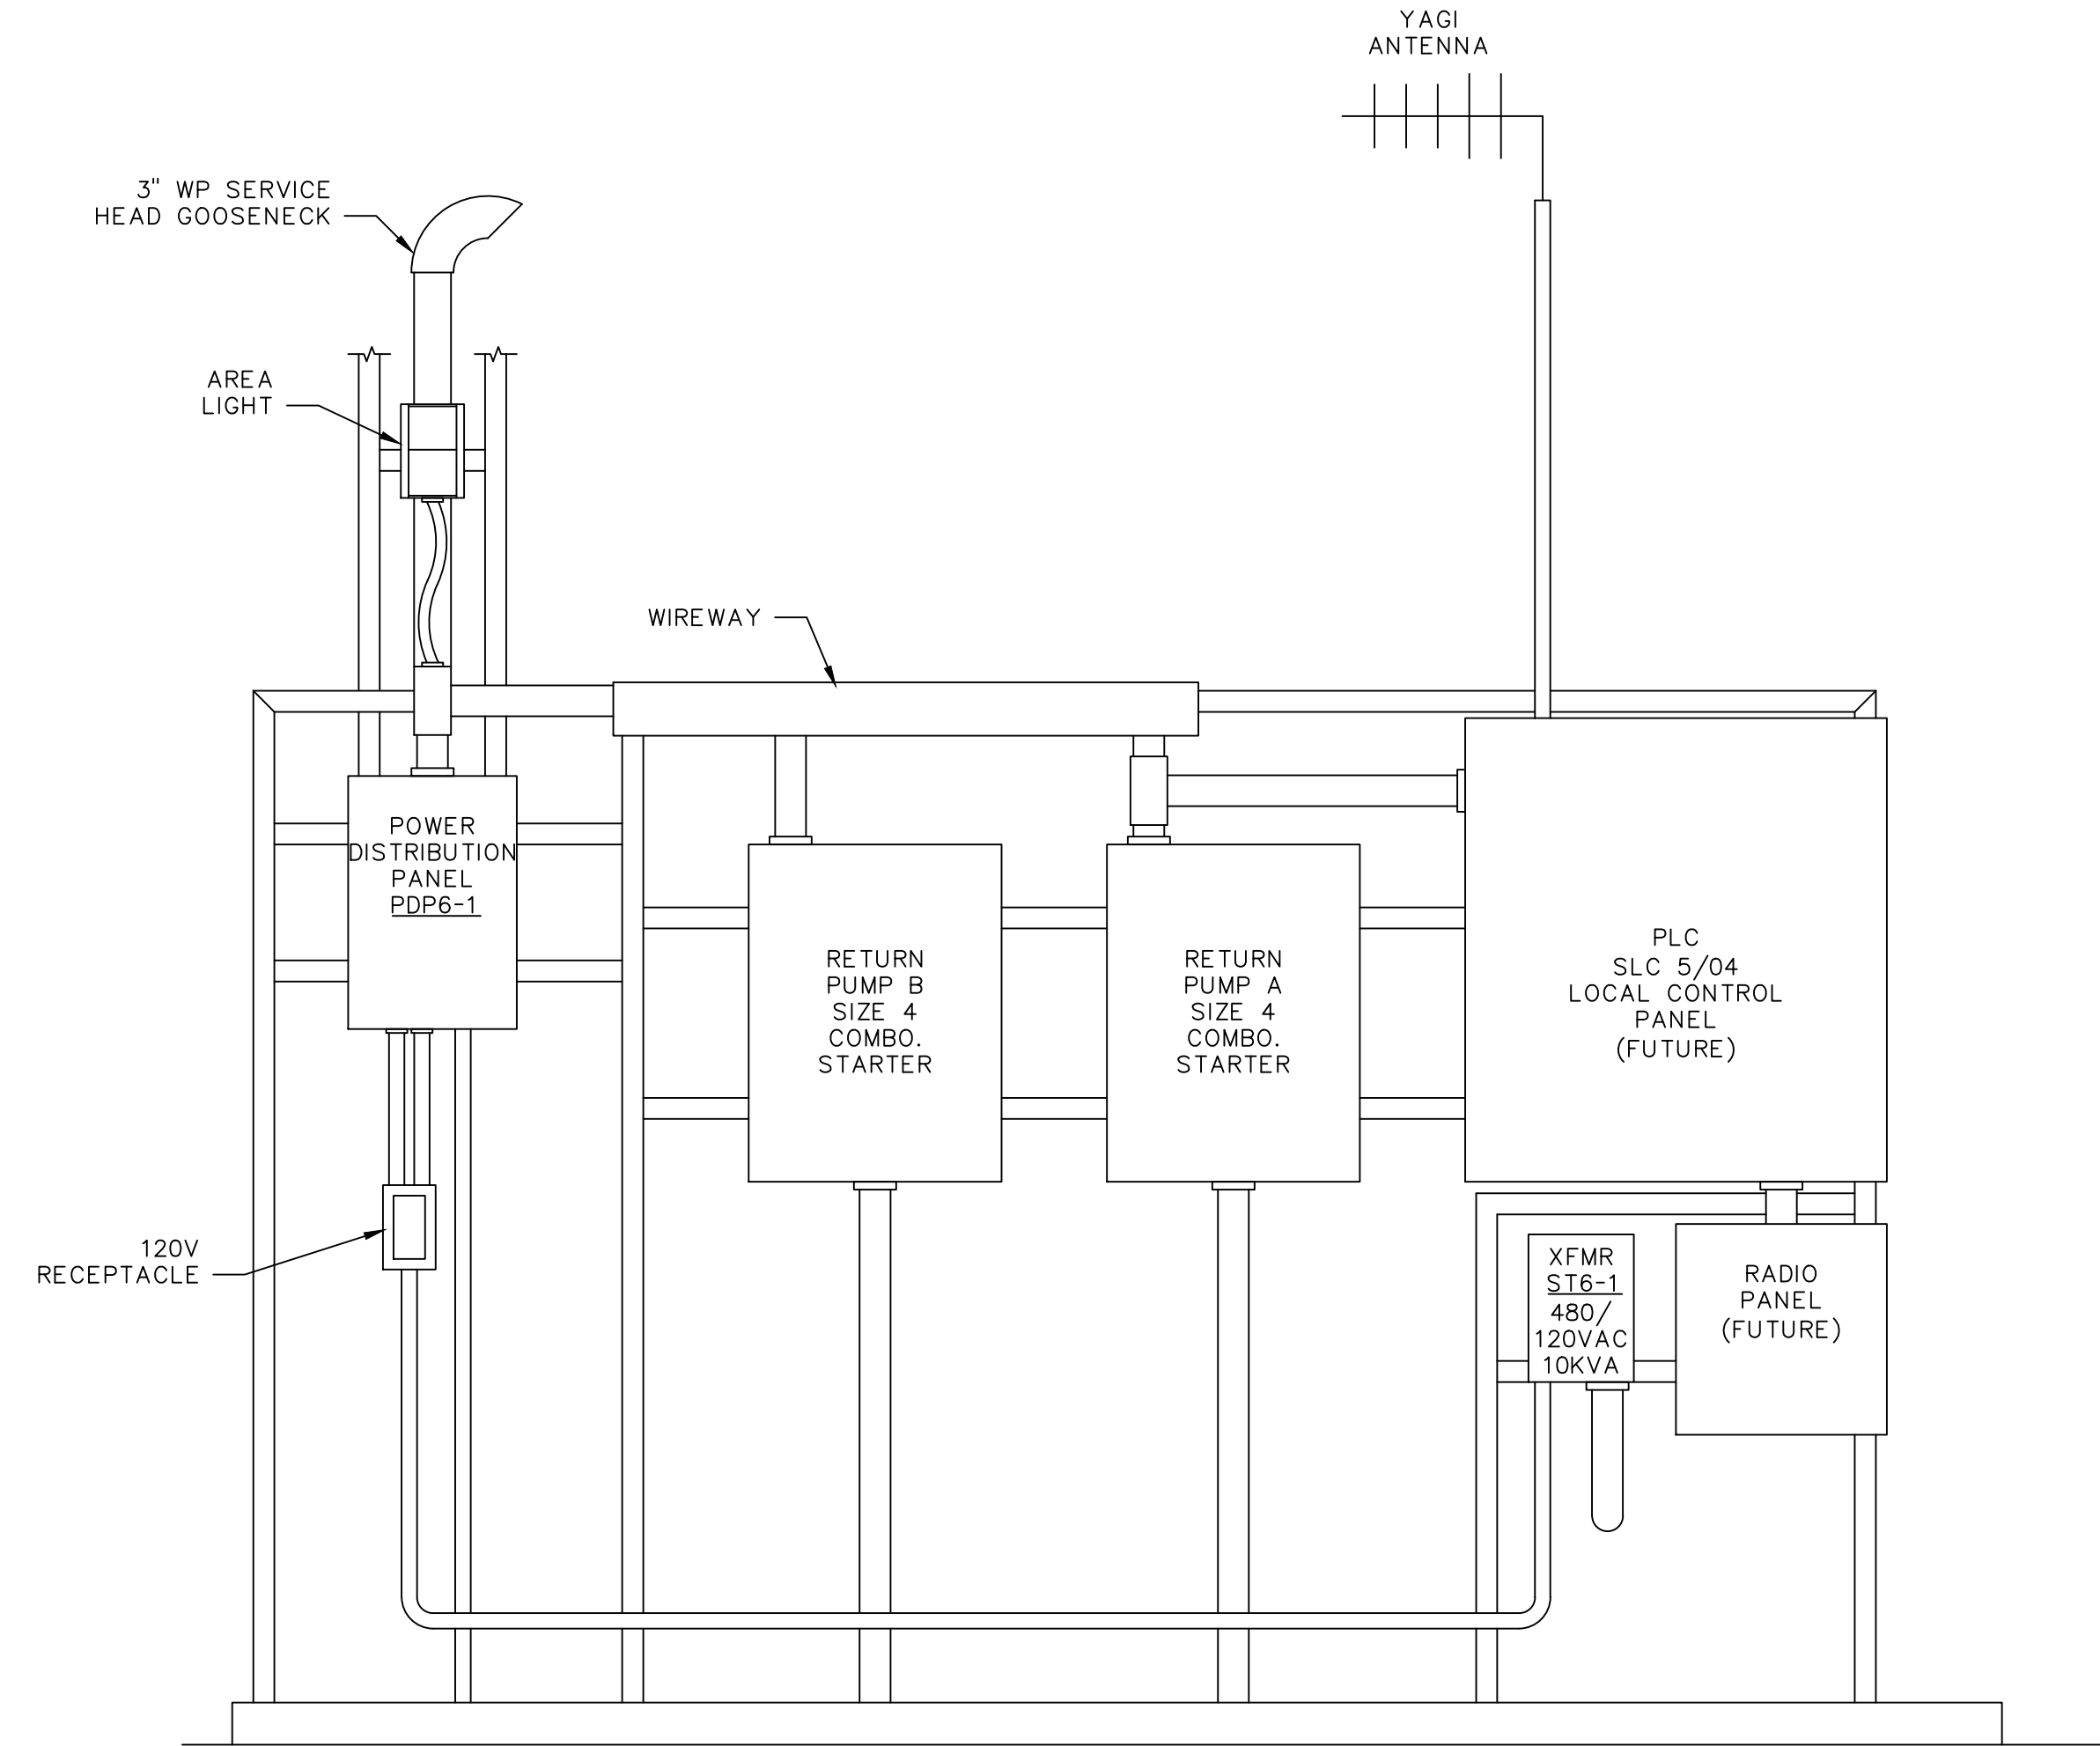

DETAIL 1
NTS 42 RETURN PUMPS EQUIPMENT RACK

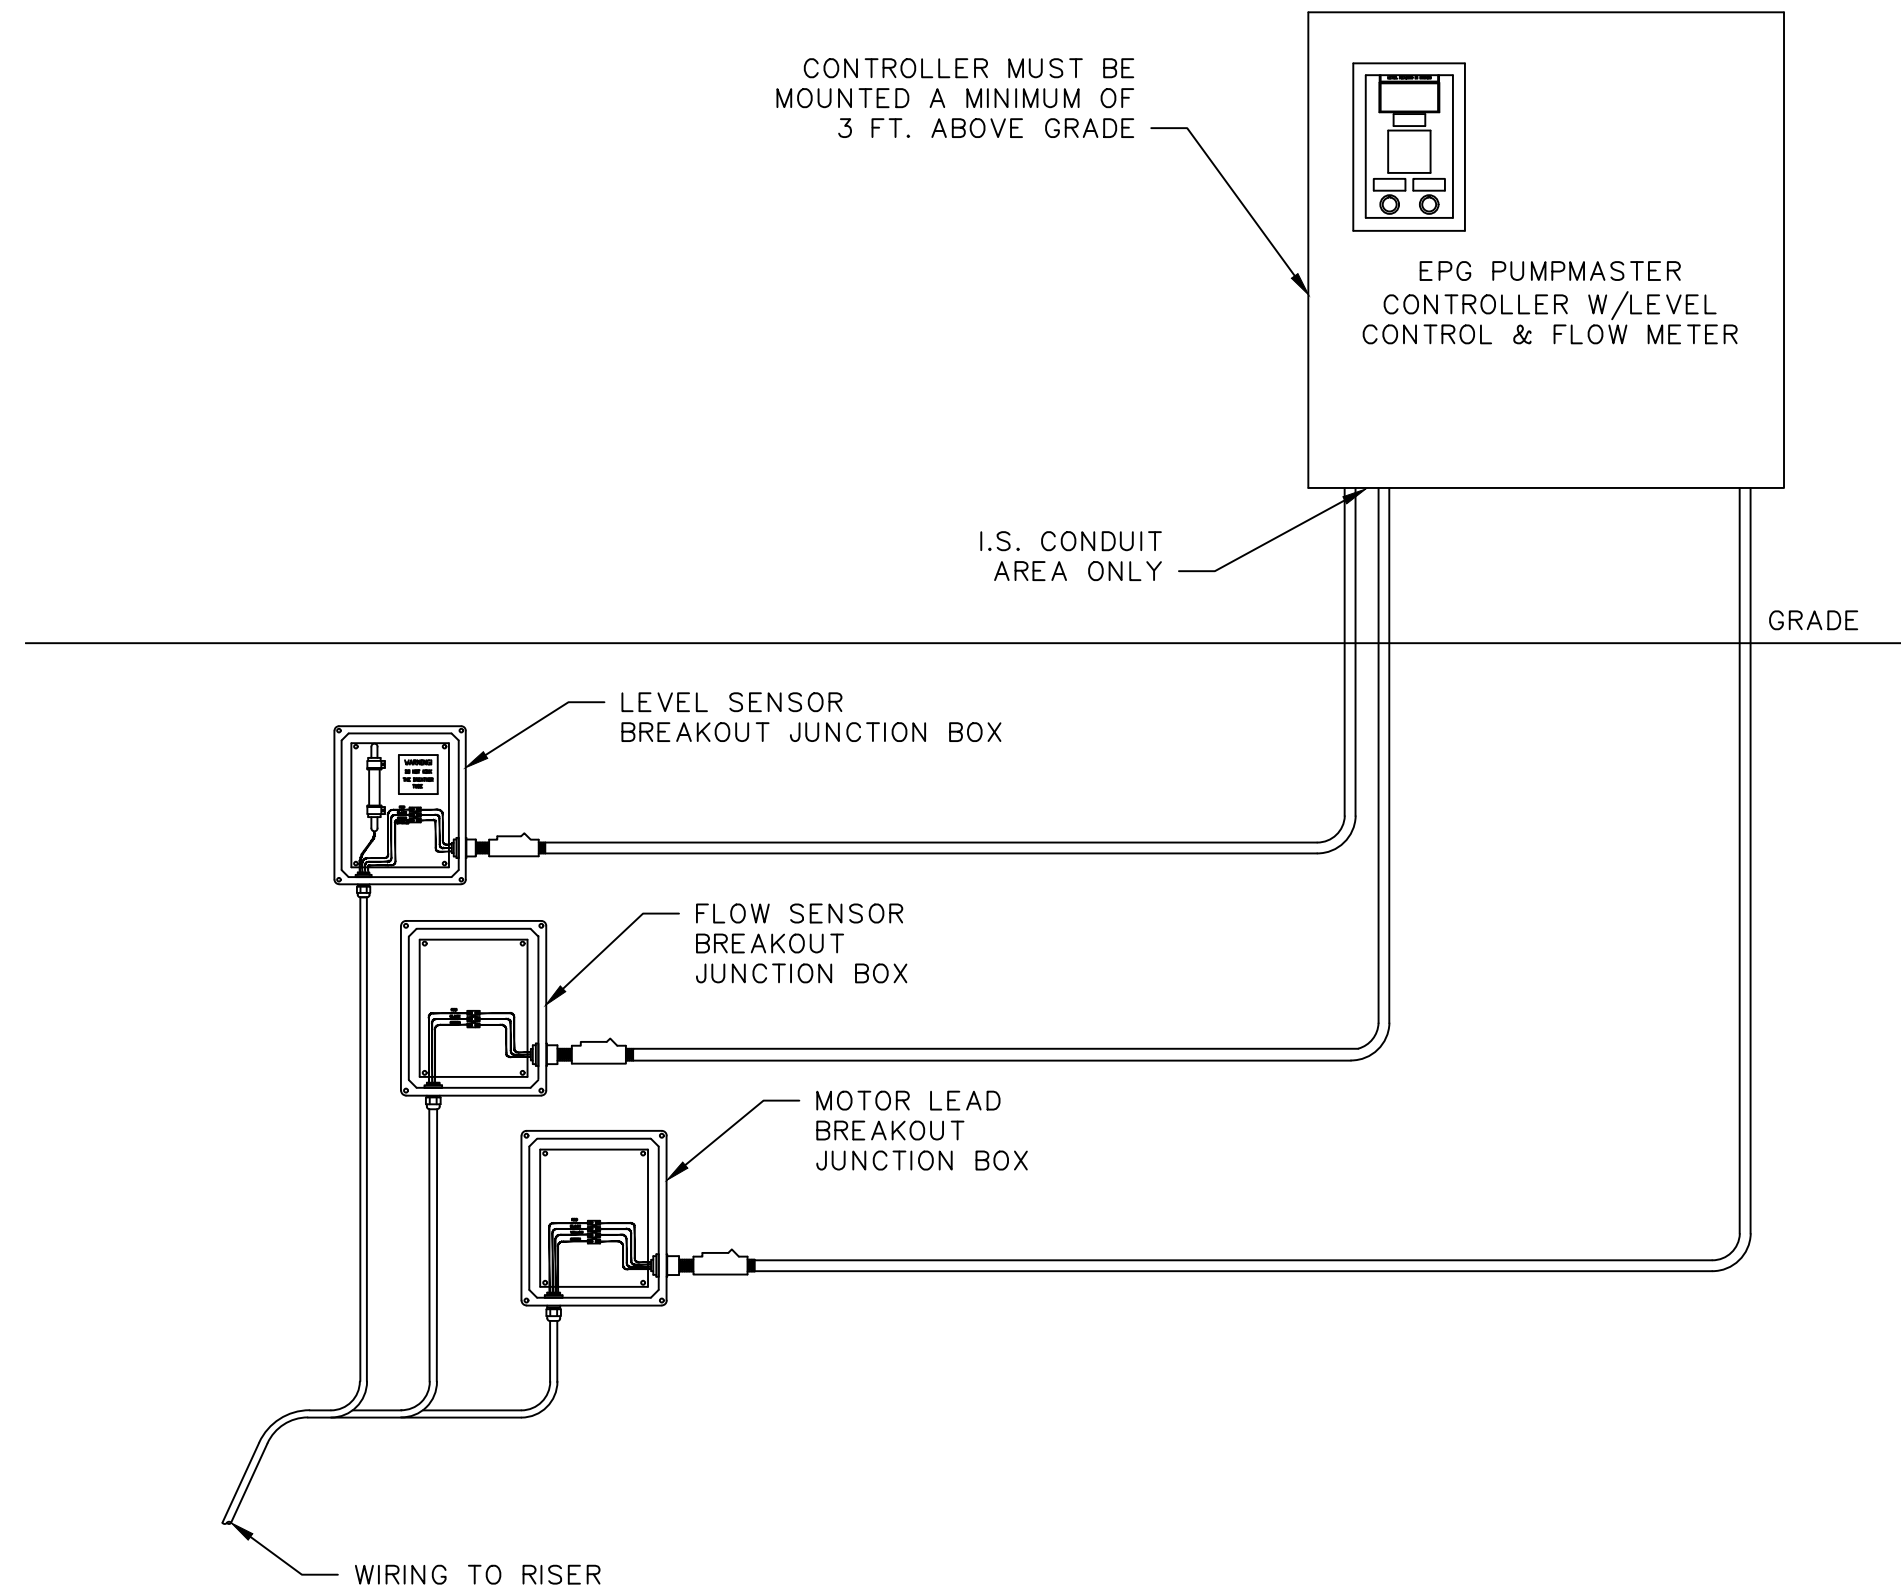

DETAIL 2
NTS 35 LCRS PUMP EQUIPMENT RACK

THESE RECORD DRAWINGS DATED 01/17/20 AND TITLED "FOR RECORD" HAVE BEEN DEVELOPED FROM AS-BUILT MARKUPS AND MAY NOT REPRESENT THE FINAL PROJECT, AS CONSTRUCTED, IN EVERY DETAIL. THESE RECORD DRAWINGS HAVE BEEN PREPARED BASED ON INFORMATION SUPPLIED BY OTHERS AND THE ENGINEER HAS NOT VERIFIED THE ACCURACY OR COMPLETENESS OF THE INFORMATION.

NO.	DATE	REVISION	DWN	CHD	EXD	RWVD	APVD	W.A.
1	01-17-20	FOR RECORD						FCC06814

FOUR CORNERS POWER PLANT
RETURN WATER POND
ELECTRICAL DETAILS



SCALE: NONE DATE: 10/04/19

DWN	LDB	EXD	---	APPROVED	W A
CHD	DEM	RWVD	---	GENE MOE	FCC06814
				DRAWING APPROVED BY	





UNIT	DISC	TYPE	SYS	SUBSYS	NUMBER	SHEET
FC45CM	E	49	WP	AP	200485	44




WORK SAFELY TODAY

THIS DRAWING IS CONFIDENTIAL AND SHALL NOT BE USED OR REPRODUCED IN ANY PART WITHOUT WRITTEN CONSENT OF PINNACLE WEST CAPITAL CORPORATION.

M O T O R C O N T R O L C E N T E R

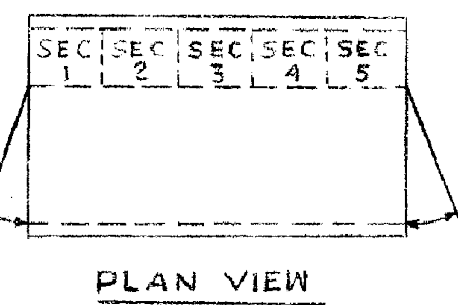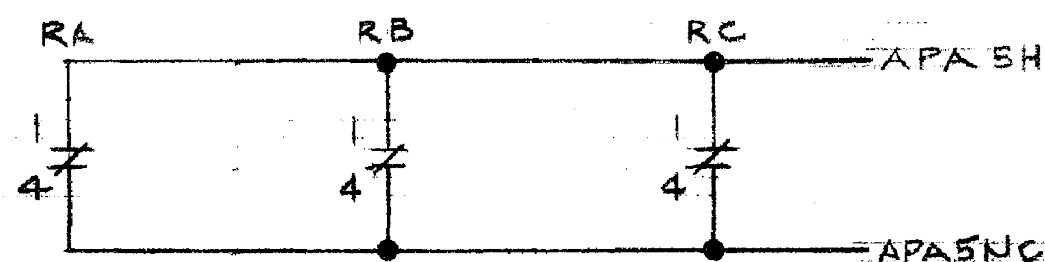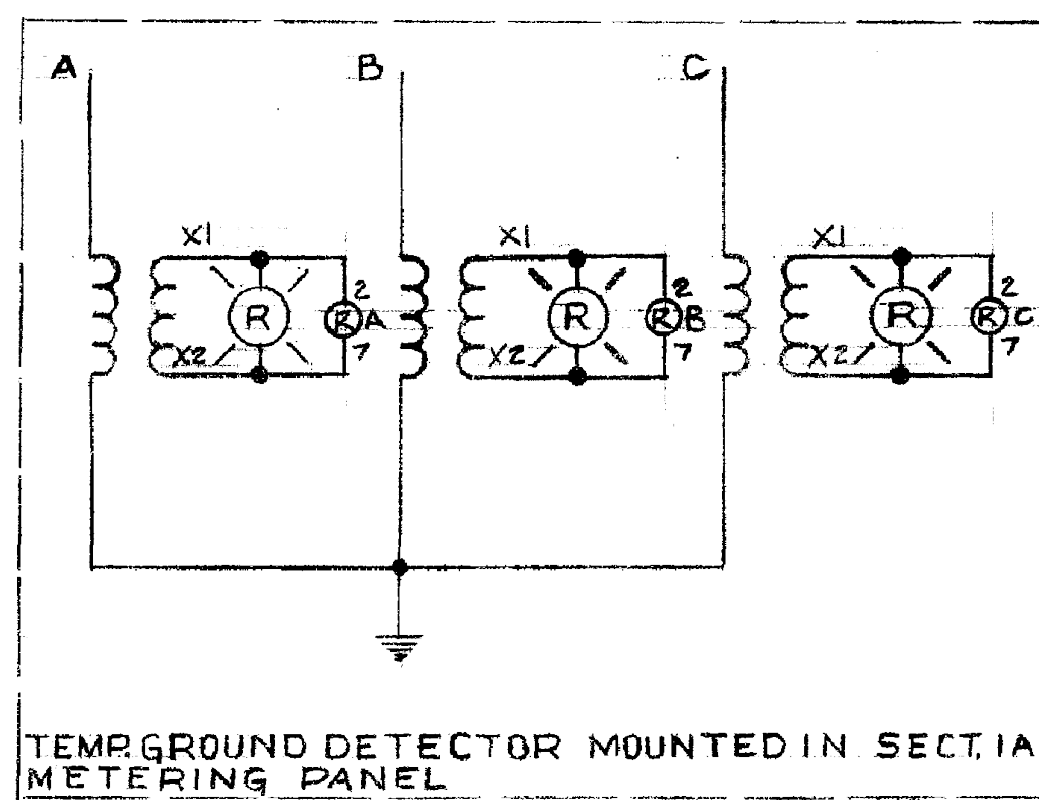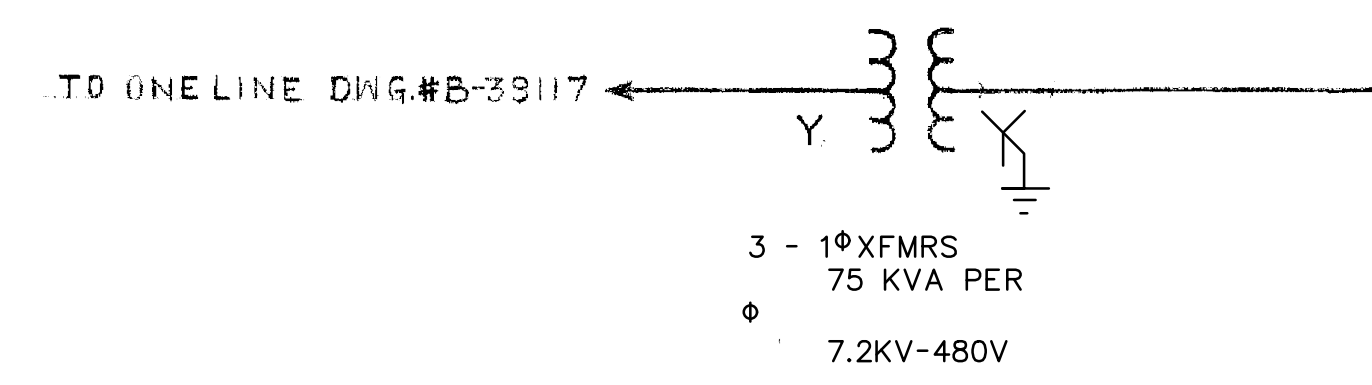


4-1/C 250 MCM AA CABLE (INCLUDING GROUND)

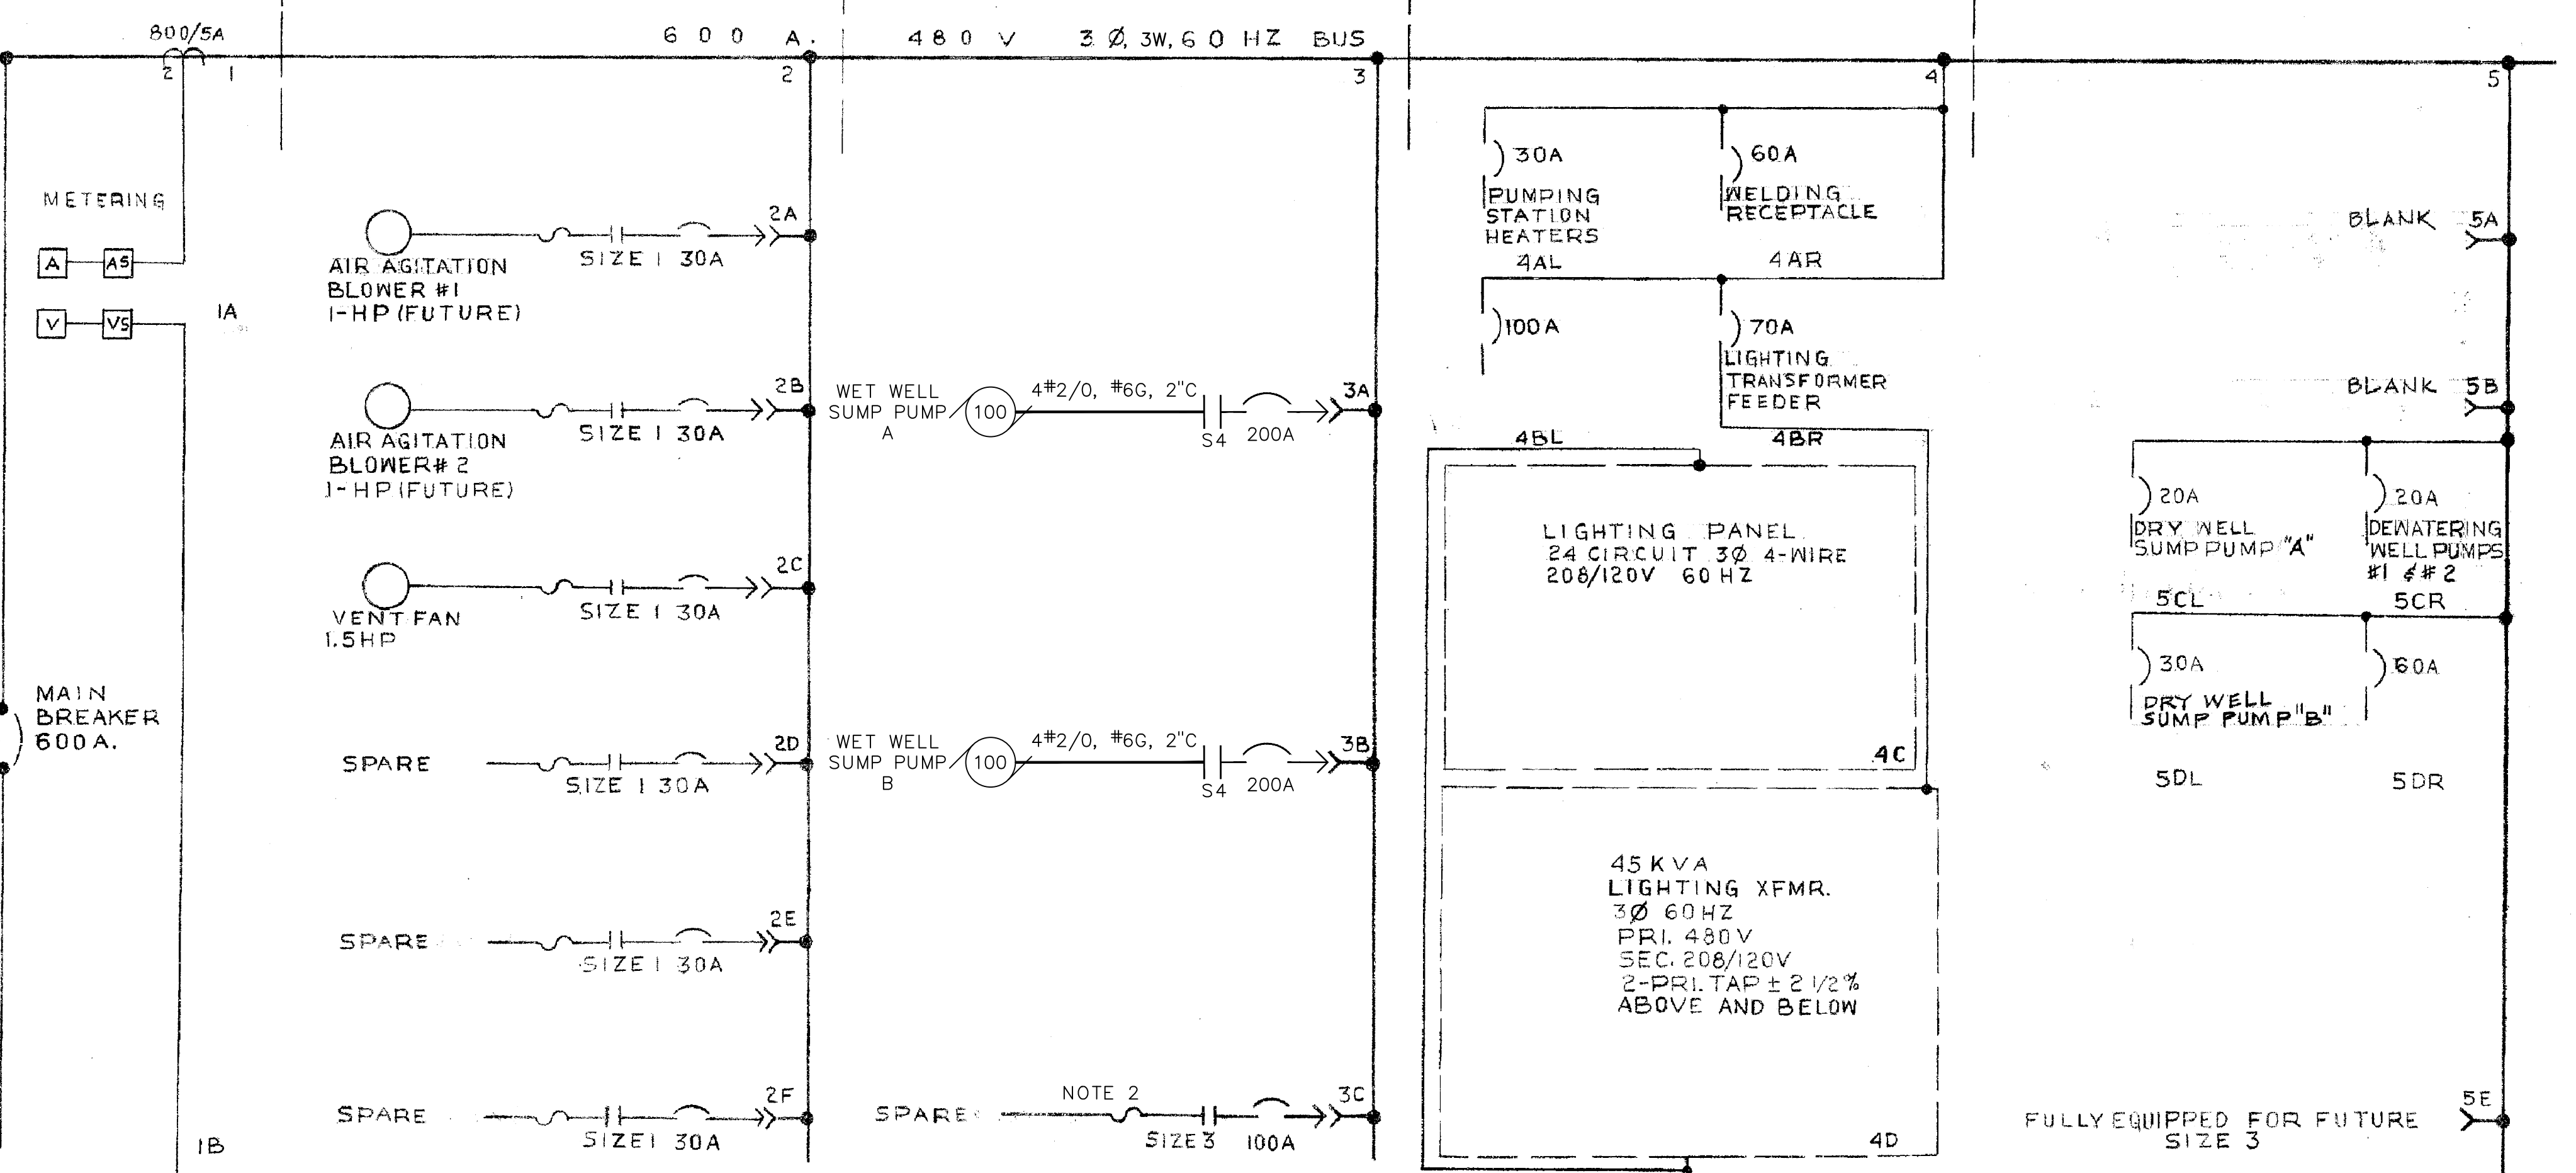

CONSTRUCTION NOTES:

- EXISTING MCC, 480V/3Ø/3W. REPLACE EXISTING WET WELL PUMP STARTERS WITH NEW UNITS FOR 100HP MOTORS. REBUILD EXISTING MCC UNIT WITH SIZE 4 STARTERS SIMILAR TO A-B BULLETIN 2113.
- SPARE STARTER CAN BE REMOVED AND TURNED OVER TO APS IF SPACE IS REQUIRED FOR NEW STARTERS.

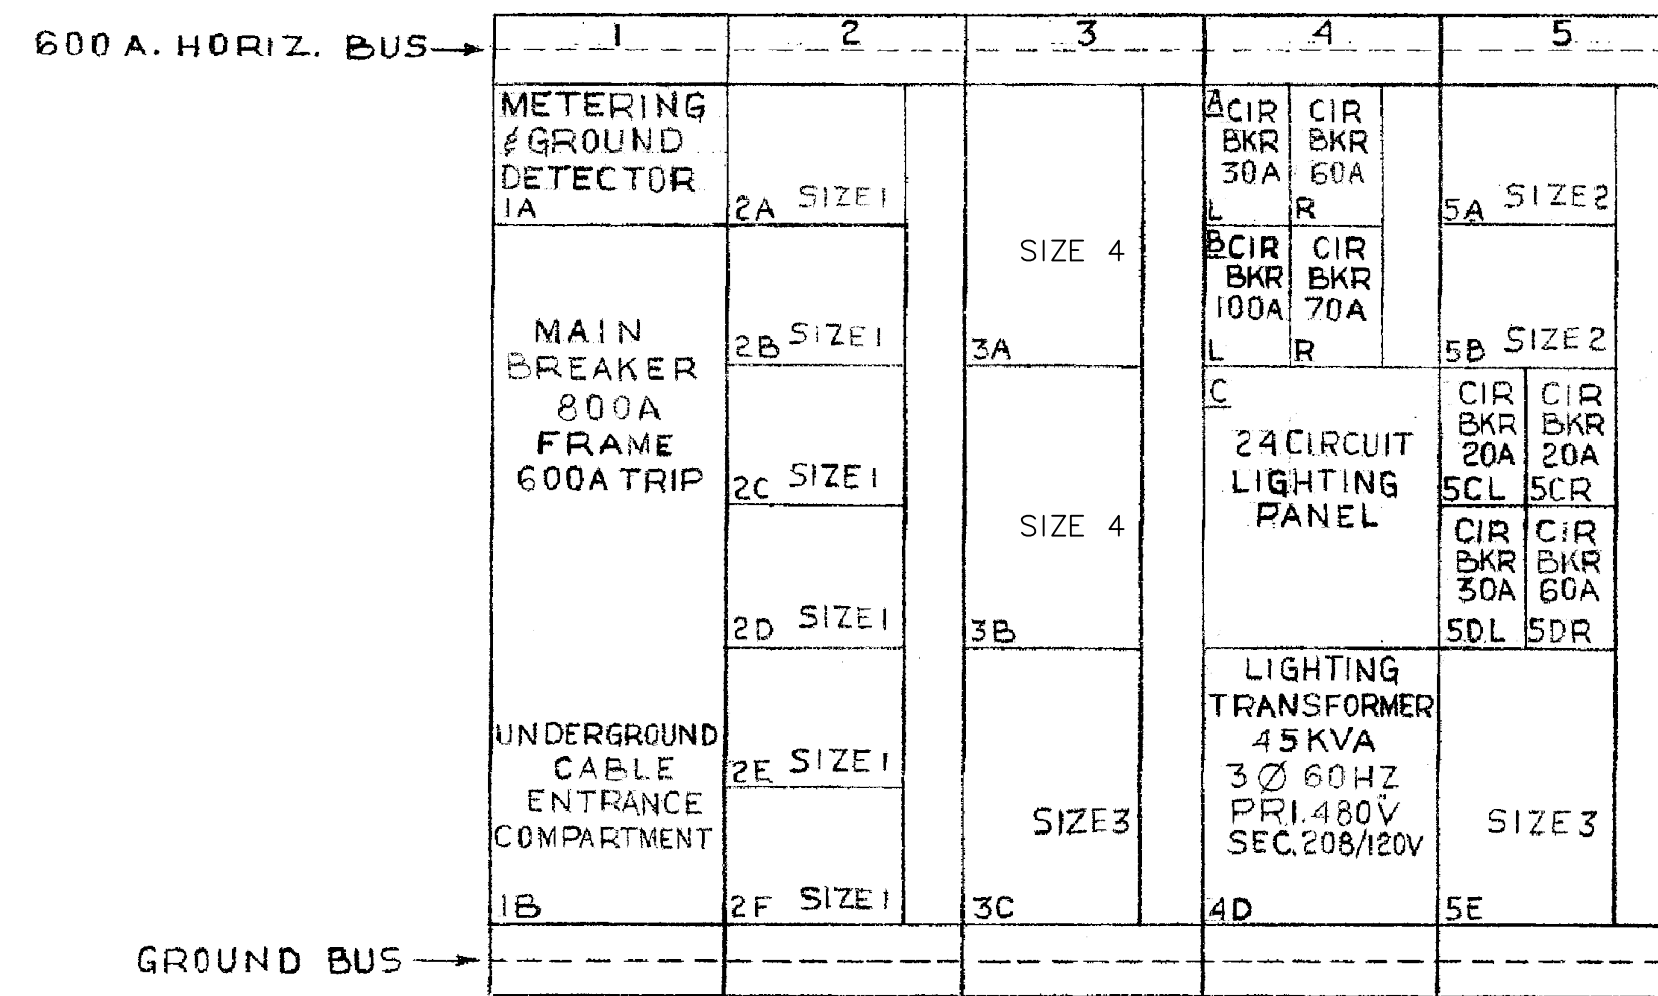

FRONT ELEVATION
480V. MOTOR CONTROL CENTER

THESE RECORD DRAWINGS DATED 01/17/20 AND TITLED "FOR RECORD" HAVE BEEN DEVELOPED FROM AS-BUILT MARKUPS AND MAY NOT REPRESENT THE FINAL PROJECT, AS CONSTRUCTED, IN EVERY DETAIL. THESE RECORD DRAWINGS HAVE BEEN PREPARED BASED ON INFORMATION SUPPLIED BY OTHERS AND THE ENGINEER HAS NOT VERIFIED THE ACCURACY OR COMPLETENESS OF THE INFORMATION.

10	01-17-20	FOR RECORD	AWF	DEM			FC008814
9	5/16/19	CHANGE TO GROUNDED Y	LDB	DEM			EDM
8	12/14/18	SERVICE MODIFY PUMP INFO	LDB	DEM			EDM
7	10/04/19	INSTALL NEW PUMPS	LDB	DEM			EDM
6	04-26-18	TITLE UPDATE	CWB				WAC FAC0406
5	12/12/18	REVIEWED PER AS BUILT					
4	11/14/18	ADDED ANNUNCIATOR LUM					
3	11/14/18	ADDED UPDATED DATA VID					
2	11/14/18	ADDED UPDATED DATA VID					
1	11/14/18	ADDED UPDA TED DATA VID					

NO.	DATE	REVISION	DWN	CHD	EXD	RWD	AFVD	W.A.
FOUR CORNERS COMMON ASH DISPOSAL EVAPORATION PONDS MCC								



SCALE: NONE DATE: 5-24-78

WORK SAFELY TODAY

DWN	VID	APPROVED	W A
CHD	WRU	XXX	99-4-107-10
EXD	PBP	UNIT	DISC
RWD	XXX	FC	E 03 ADS 39128
			SHEET 1




BILL OF MATERIALS

MOTOR CONTROL CENTER LAYOUT



Table with columns: UNIT NO., DESCRIPTION, MOTOR, UNIT DESCRIPTION, CATALOG NUMBER, WIRING DIAGRAM, NOTE. Includes items like METERING COMPARTMENT, MAIN BREAKER, AIR AGITATION BLOWER, MAIN SUMP PUMP, PUMPING STATION HEATERS, etc.

PILOT DEVICE SYMBOLS: SE START STOP, SF STOP, HCA HAND-OFF-AUTO SELECTOR, etc.

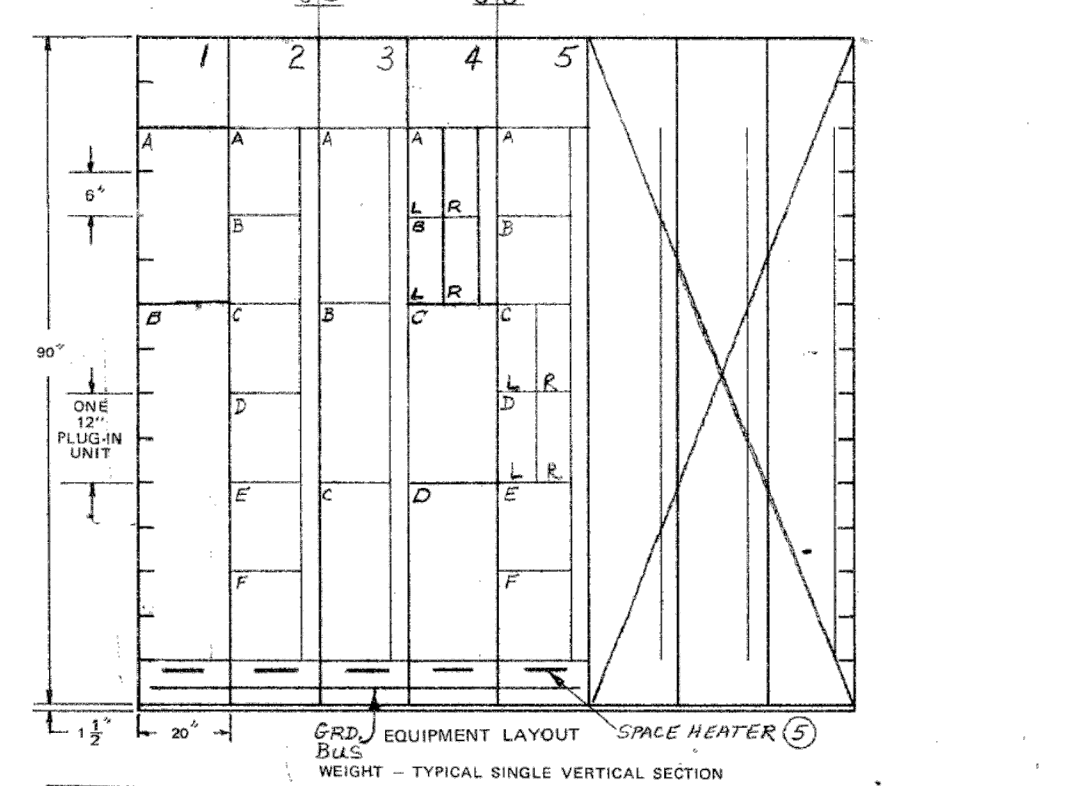

Form 6.10-8R (Supersedes Form 6.10-8Q)

VERTICAL SECTIONS

NEMA Class I, Wiring Type B, Master Terminal Block for Type C Located, NEMA Enclosure Type NEMA 3W1, Equipment Mtg. FRONT ONLY, Sliding Shutters: For Vertical Bus No, Power Supply 480 Volts 3 Phase 3 Wire 60 Hertz, Bus Amps: Main Hor. 600A, Vertical 300A, Braced For: 42,000 Sym. Standard, 65,000 Sym. Optional, 100,000 Sym. Optional, Ground Bus Ampacity 300A, Incoming Cable 1 Per Phase 300MCM Neutral, Incoming Bus Duct: Amps Type, Terminal Lugs Furnished By, Cables Terminating at Top, Pull Box Height, Main Circuit Breaker 600AMP, Fusable Switch, Fuse Type.

SPECIFICATIONS

PLUG-IN UNITS

Circuit Breakers: Magnetic Trip STARTERS (ETI) Thermal Magnetic Trip FEEDERS (ET), Fused Switch, Control Voltage: 120 V 480 V, Control Transformer: Primary Fuse Secondary Fuse, Wireway Side and Flash Barriers For Plug-In Modules: Yes No, Control Circuit Wiring: Standard Type THHN 90°C, Color Red, No. 14 AWG, Power Wiring: Standard Type THHN 90°C, Color Black, Terminal Blocks: Standard Connection Type N3, Other, Specify CONNECTRON NU-2 (RIMS TONGUE)

NOTES


- 1. ONE 120V AC GFI WALL RECEPTACLE (DUPLEX CONVENIENCE OUTLET) PROVIDED.
2. RIB TONGUE TERMINALS PROVIDED ON ALL CONTROL WIRING.
3. O.L. HEATERS PROVIDED BY OTHERS.
4. ADDL AMB. COMB. O.L.'S PROVIDED.
5. 120V AC SPACE HEATERS PROVIDED IN EACH SECTION. (REF. WD-56549-A02).
6. ONE ADJUSTABLE THERMOSTAT PROVIDED TO CONTROL THE ABOVE.
7. IN CONSTRUCTION WITH MAIN BREAKER, THIS COMPARTMENT CONTAINS 1 SWITCHBOARD TYPE AMMETER 0-800A; 1 SWITCHBOARD TYPE VOLTMETER 0-600V; 1 TYPE C77 AMMETER/VOLTMETER SWITCH EGR EACH; 2 300/5A RT.
8. TRANSFORMER TYPE PILOT LIGHTS PROVIDED.
9. PULL BOX MAY BE SHARD TERMINAL BLOCKS WITHOUT INCREASING UNIT SPACE.
10. SEPARATE BRANCH CIRCUITS SHALL BE PROVIDED FOR LIGHTS AND SPACE HEATERS. THE FOLLOWING BREAKERS PROVIDED IN PANELBOARD: 2-QP1-B015'S, 22-QP1-B020'S.

NOTES

- 1. BOTTOM PLATES PROVIDED.
2. PROVIDE A DOOR AT EACH END OF WALKWAY. DOORS TO HAVE 3 POINT LATCH AND SUITABLE STRONG DEVICE TO HOLD THE DOOR IN FULL OPEN POSITION. DOORS SHALL BE GASKETED AND PROVIDED WITH LOCKS.
3. DUST FILTERS AND FILTERED AIR PRESSURE TYPE CONSTRUCTION SHALL BE FURNISHED.
4. SCREENED AND RAFFLED VENTILATING OPENINGS SHALL BE PROVIDED AT THE TOP AND BOTTOM OF THE ENCLOSURE.
5. TWO 120V AC INTERIOR LIGHTS AND SWITCHES PROVIDED, ONE INSIDE EACH OF THE ENCLOSURE DOORS. (CONT. ABOVE)

EXCEPTIONS TO CONTRACT SPECIFICATIONS

- 2.2 OSHA GOVERNS THE INSTALLATION & USE OF OUR EQUIPMENT, NOT IT'S MANUFACTURING.
3.08 CONNECTRON NU-2 TERMINAL BLOCKS PROVIDED.
4.3 THE BOTTOM VERTICAL BUS BARRIER IS 6" FROM THE FLOOR (SEE SKETCH BELOW).
6.4 OUR STANDARD ADJUSTABLE THERMOSTAT WILL BE PROVIDED FOR CONTROL OF SPACE HEATER (IN LIEU OF DIFFERENTIAL THERMOSTAT).
9. ALL BUS CONNECTIONS WILL BE BOLTED.
9.1 UNITS ONCE INSERTED WILL BE SECURED IN PLACE VIA A SCREW & NUT MECHANISM. THEY MAY BE PADLOCKED IN THE WITHDRAWN POSITION HOWEVER POSITIVE STOPS ARE PROVIDED IN NEITHER POSITION.
15. OUR STD. XENON TYPE PILOT LIGHTS WILL BE PROVIDED.
16. NAMEPLATES, AS DESCRIBED ABOVE NAMEPLATE DATA ON THIS DWG. WILL BE PROVIDED.
18. OUR STANDARD PAINT SYSTEM (ELECTROSTATICALLY APPLIED DRY EPOXY POWDER) WILL BE UTILIZED. QUALITY FAR EXCEEDS THAT SPECIFIED.

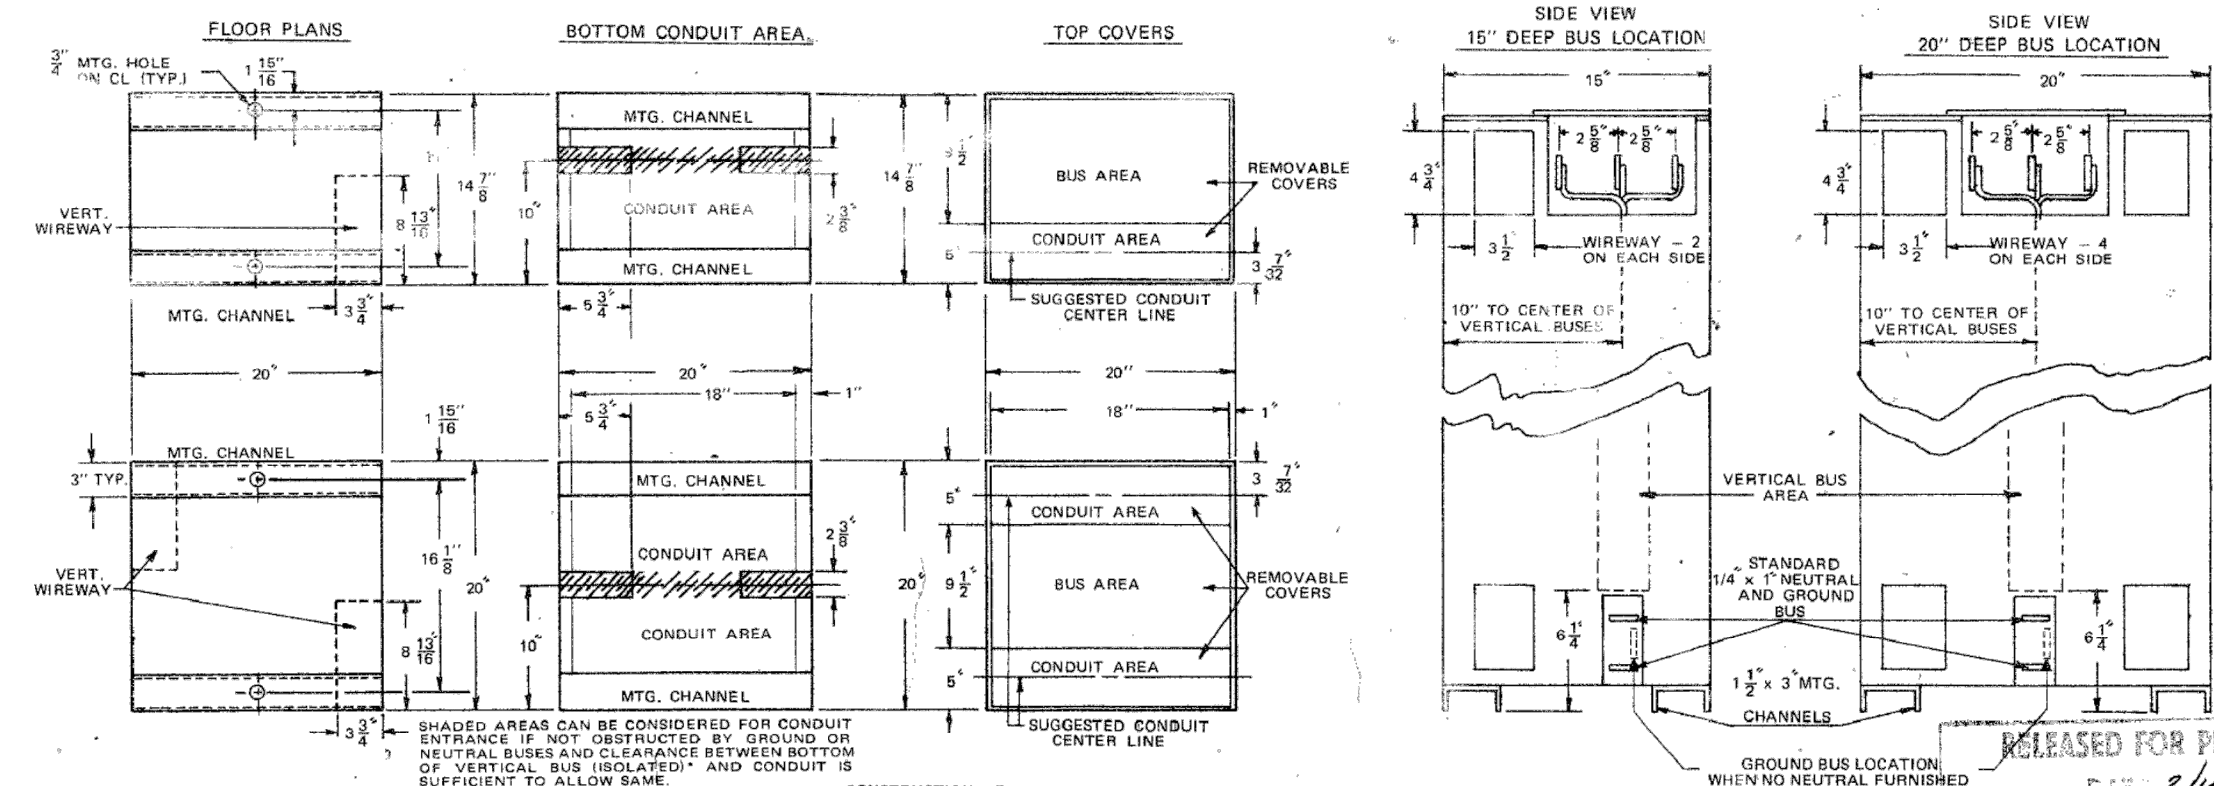

APPROVAL section with fields for DATE, TIME, and SIGNATURE. Includes 'RELEASED FOR PRODUCTION' stamp dated 2/14/77.

Table with columns: Rev. No., Date, Description, By, App'd. Includes revision history for drawing FC-76-12203.


THESE RECORD DRAWINGS DATED 01/17/20 AND TITLED 'FOR RECORD' HAVE BEEN DEVELOPED FROM AS-BUILT MARKUPS AND MAY NOT REPRESENT THE FINAL PROJECT, AS CONSTRUCTED. IN EVERY DETAIL, THESE RECORD DRAWINGS HAVE BEEN PREPARED BASED ON INFORMATION SUPPLIED BY OTHERS AND THE ENGINEER HAS NOT VERIFIED THE ACCURACY OR COMPLETENESS OF THE INFORMATION.



Revision table with columns: NO., DATE, REVISION, DWN, CHD, EXD, RWVD, APVD, W.A. Includes revisions for FOR RECORD, INSTALL NEW PUMPS, TITLE UPDATE, and ADDED SUMP PUMP 'B'.



WORK SAFELY TODAY section with fields for UNIT, DISC, TYPE, SYS, NUMBER, SHEET. Includes drawing approval and sheet information.

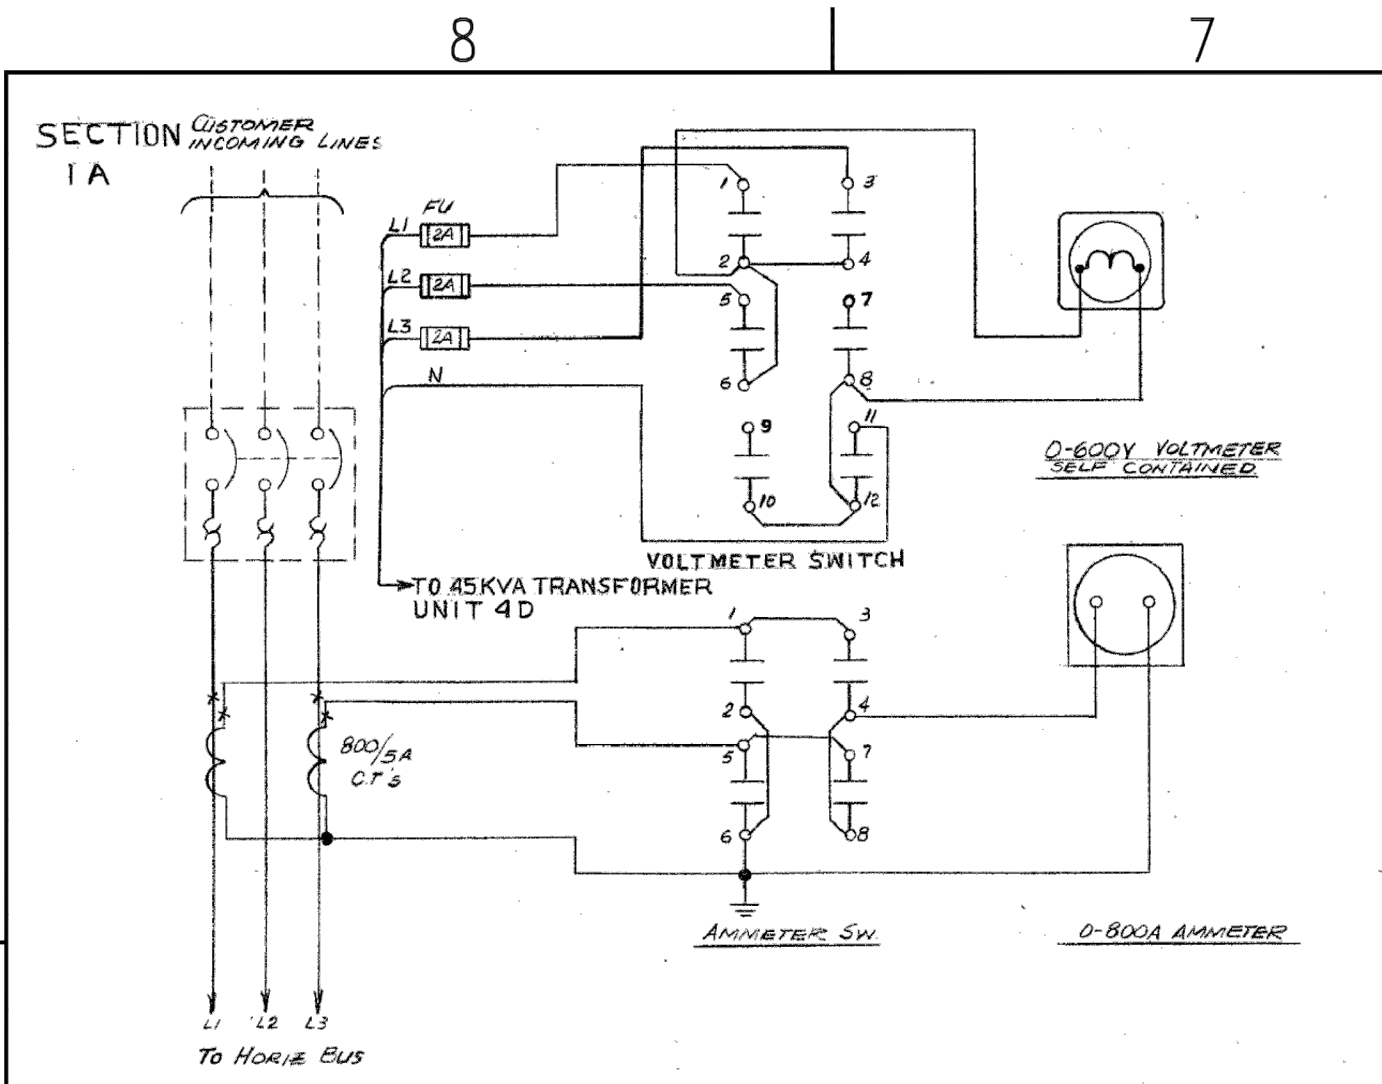

CAT. NO. C77-3001-0002-3002








MAINT'D HANDLE POS.	M	M	M	M	M	M	M
1	X	X	X	X	X	X	X
2	X	X	X	X	X	X	X
3	X	X	X	X	X	X	X

X-DENOTES CONTACTS CLOSED AT EACH HANDLE POSITION
TERMINAL CONNECTIONS SHOWN BACK OF BOARD




CAT. NO. C77-2001-2002-4002

HANDLE MAINT. POS.	INTERM.	OFF	INT.	INT.	INT.	INT.
1	X	X	X	X	X	X
2	X	X	X	X	X	X
3	X	X	X	X	X	X

X-DENOTES CONTACTS CLOSED AT EACH HANDLE POSITION
TERMINAL CONNECTIONS SHOWN BACK OF BOARD

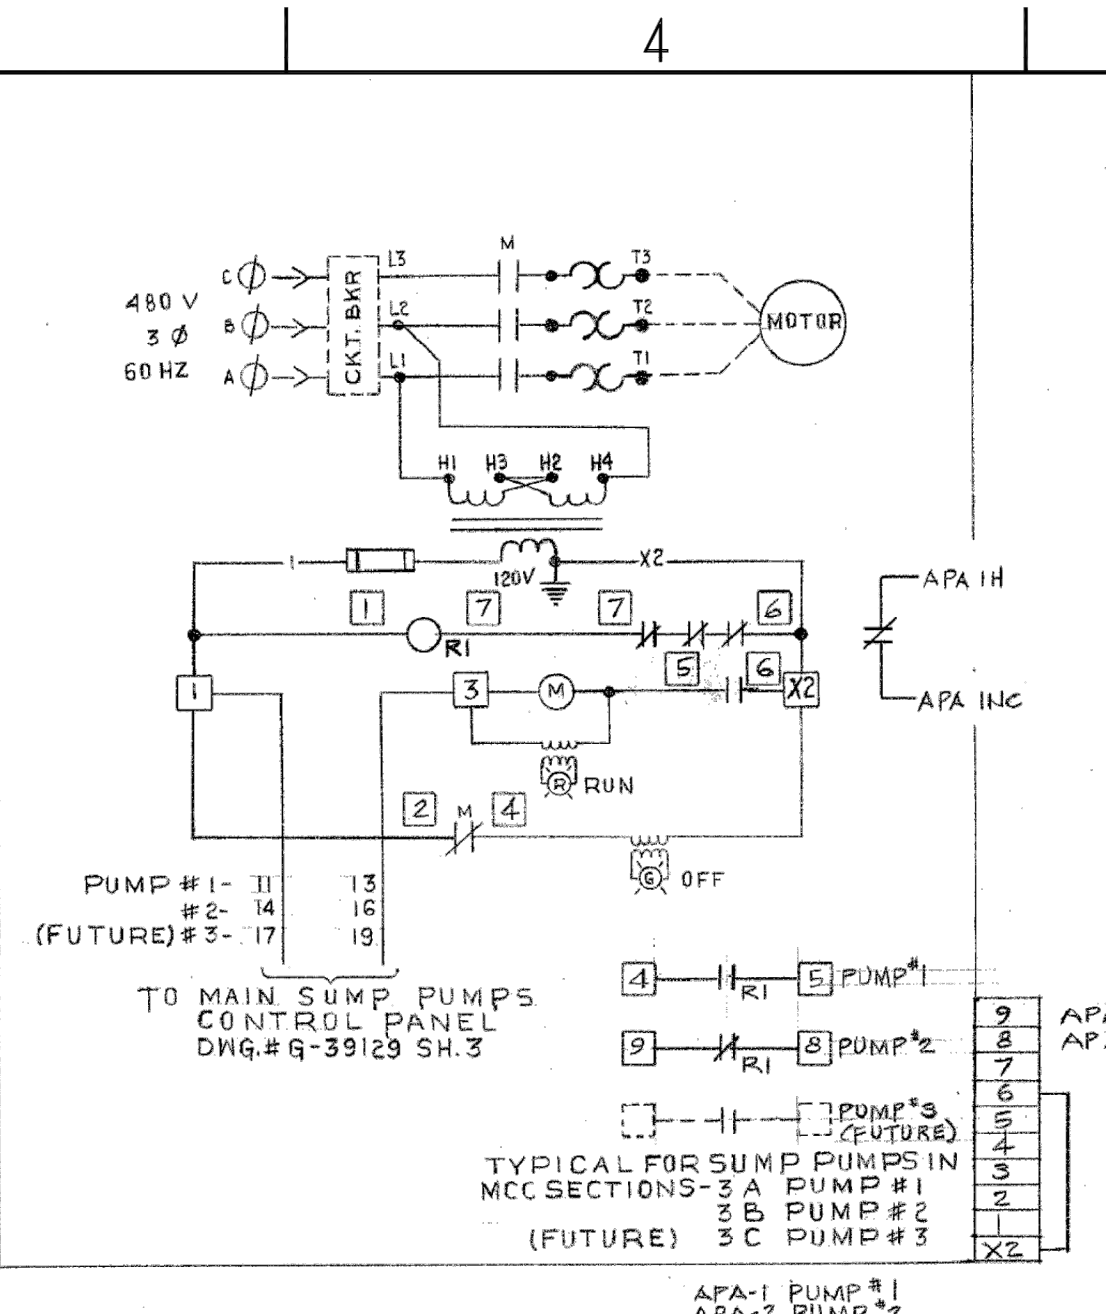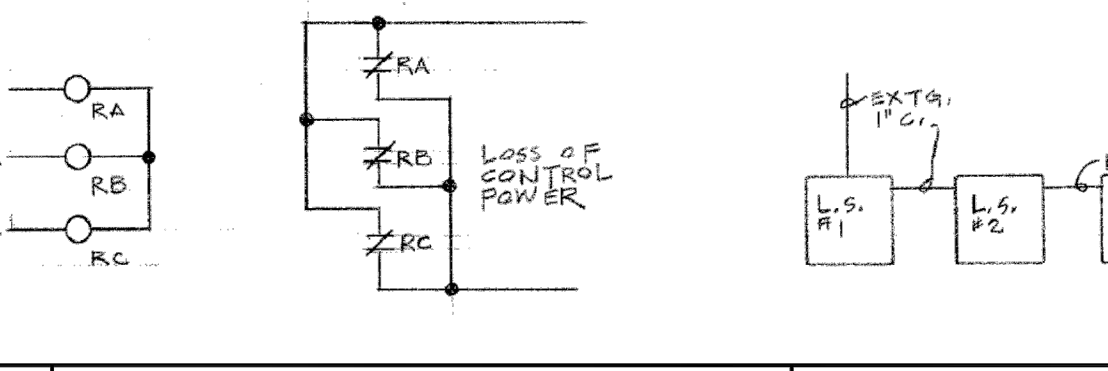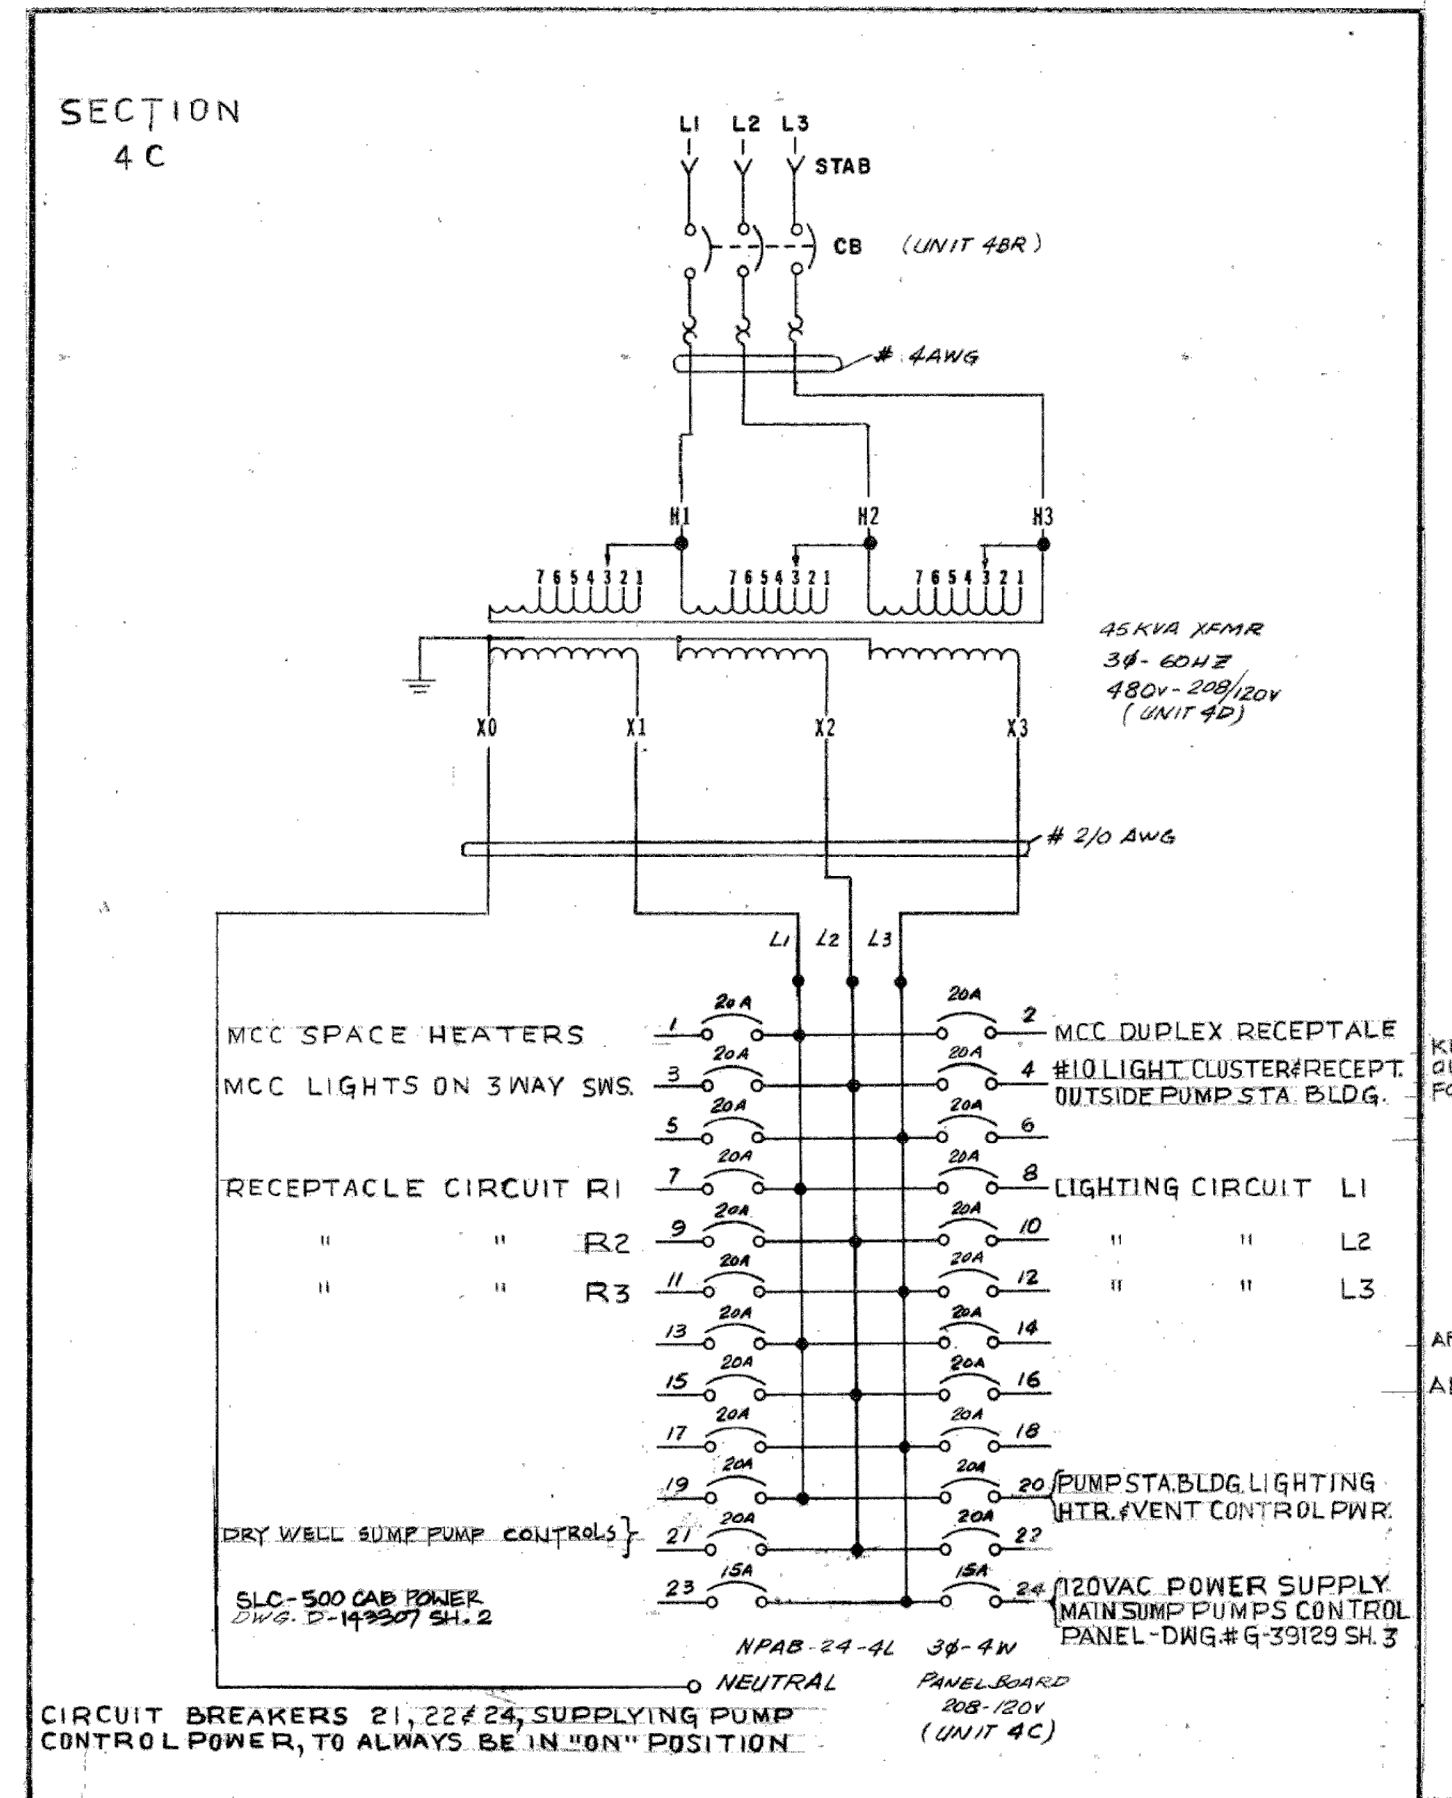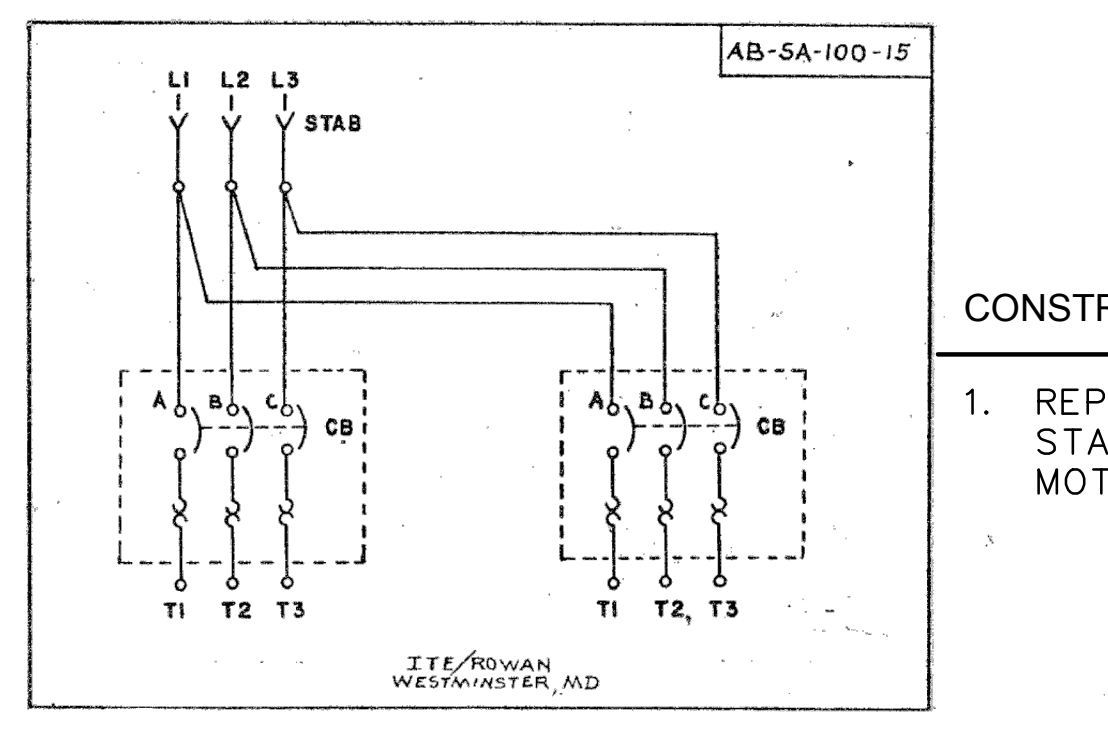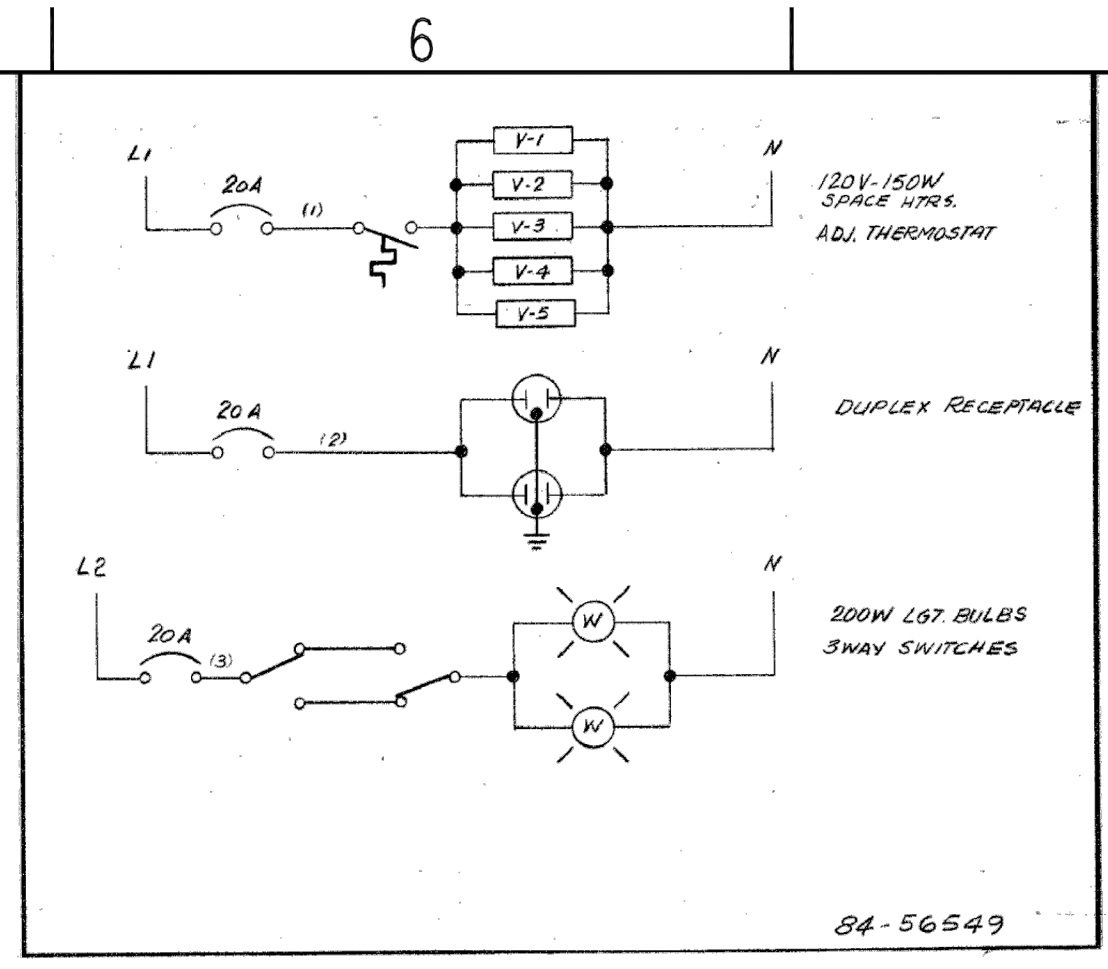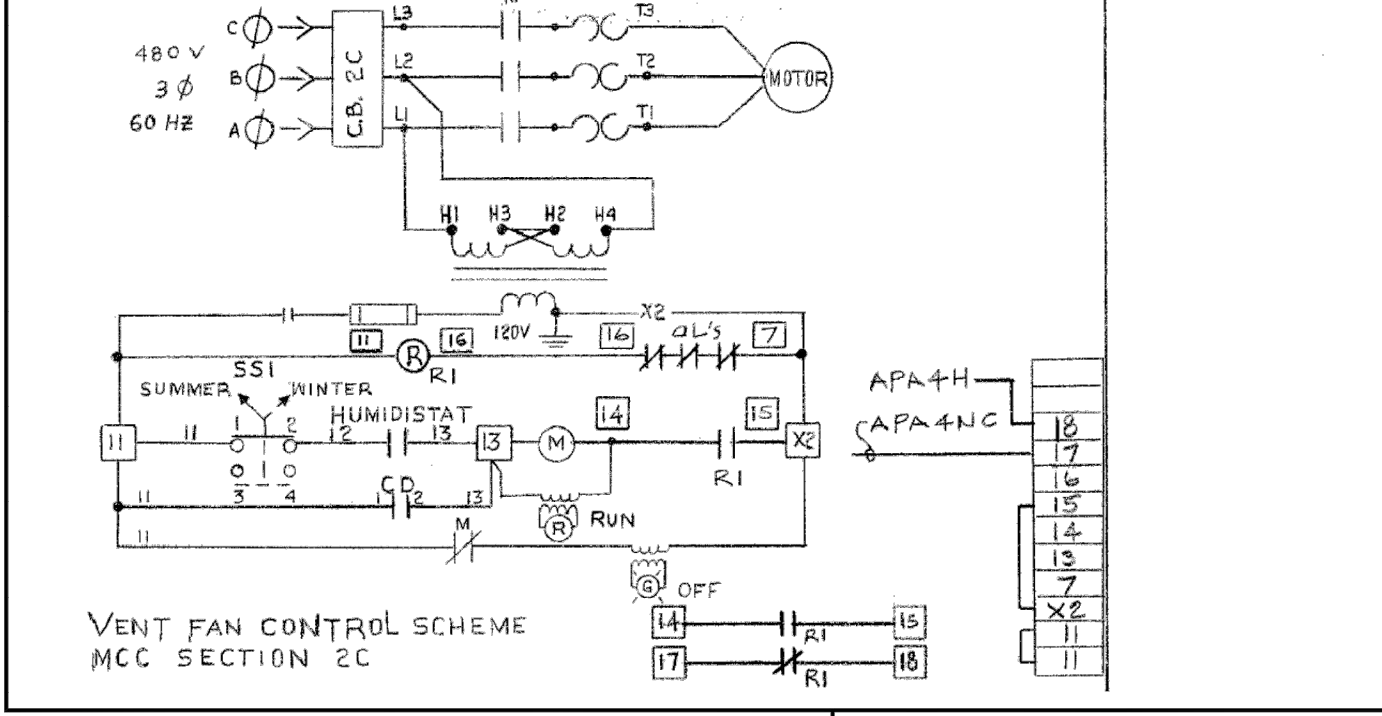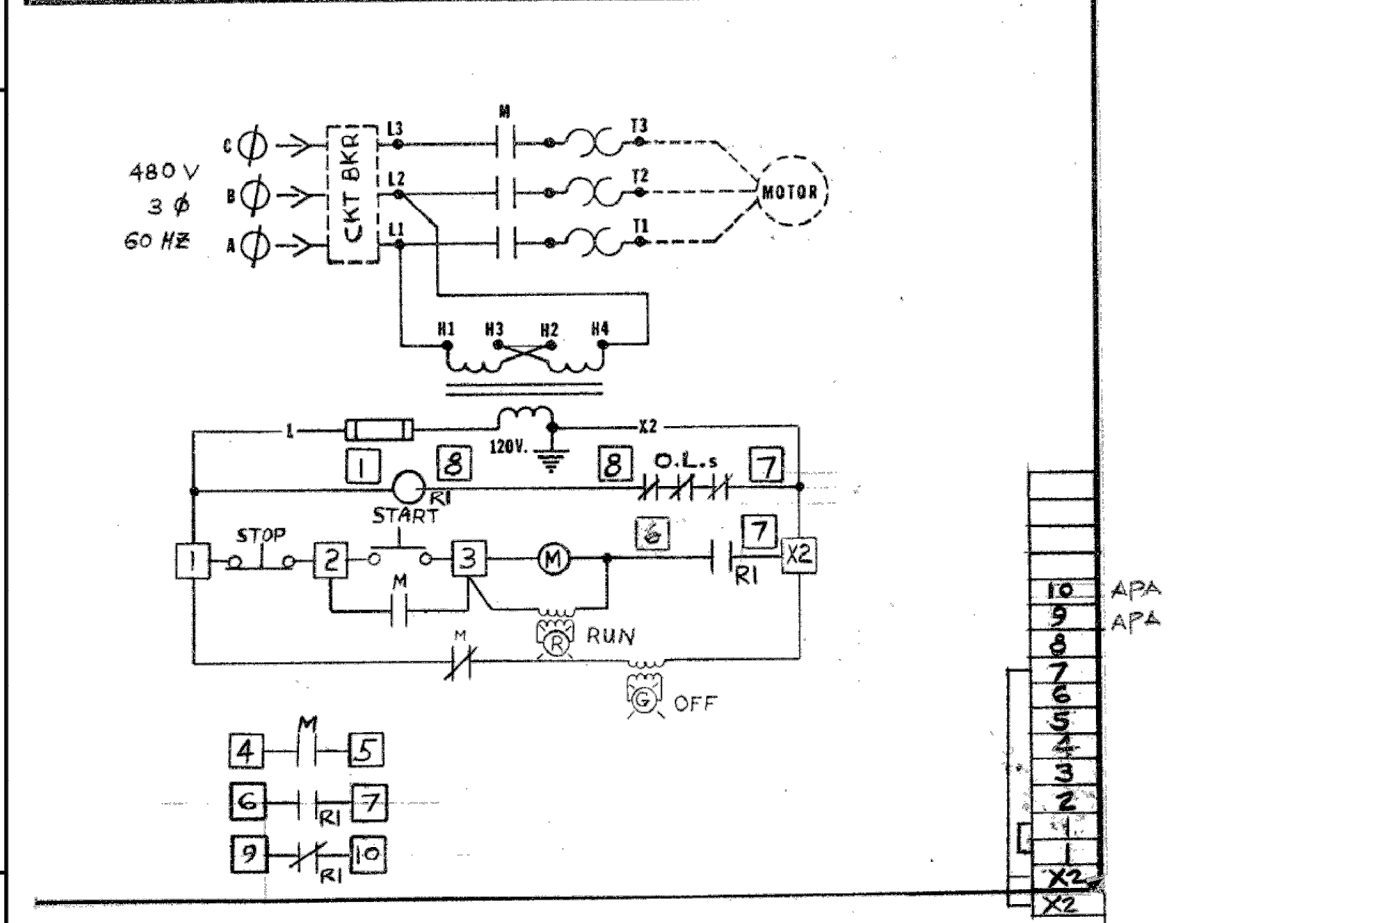

CONSTRUCTION NOTES:
1. REPLACE EXISTING WET WELL PUMP STARTERS WITH NEW UNITS FOR 100HP MOTORS. WIRE AS INDICATED IN SCHEMATIC.

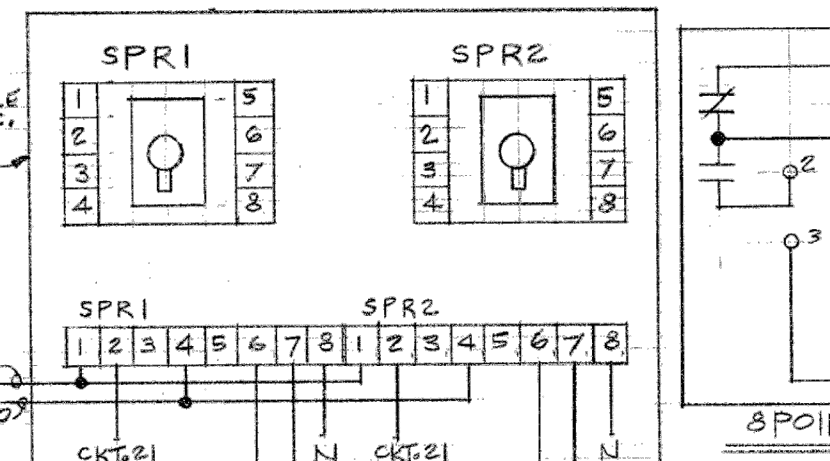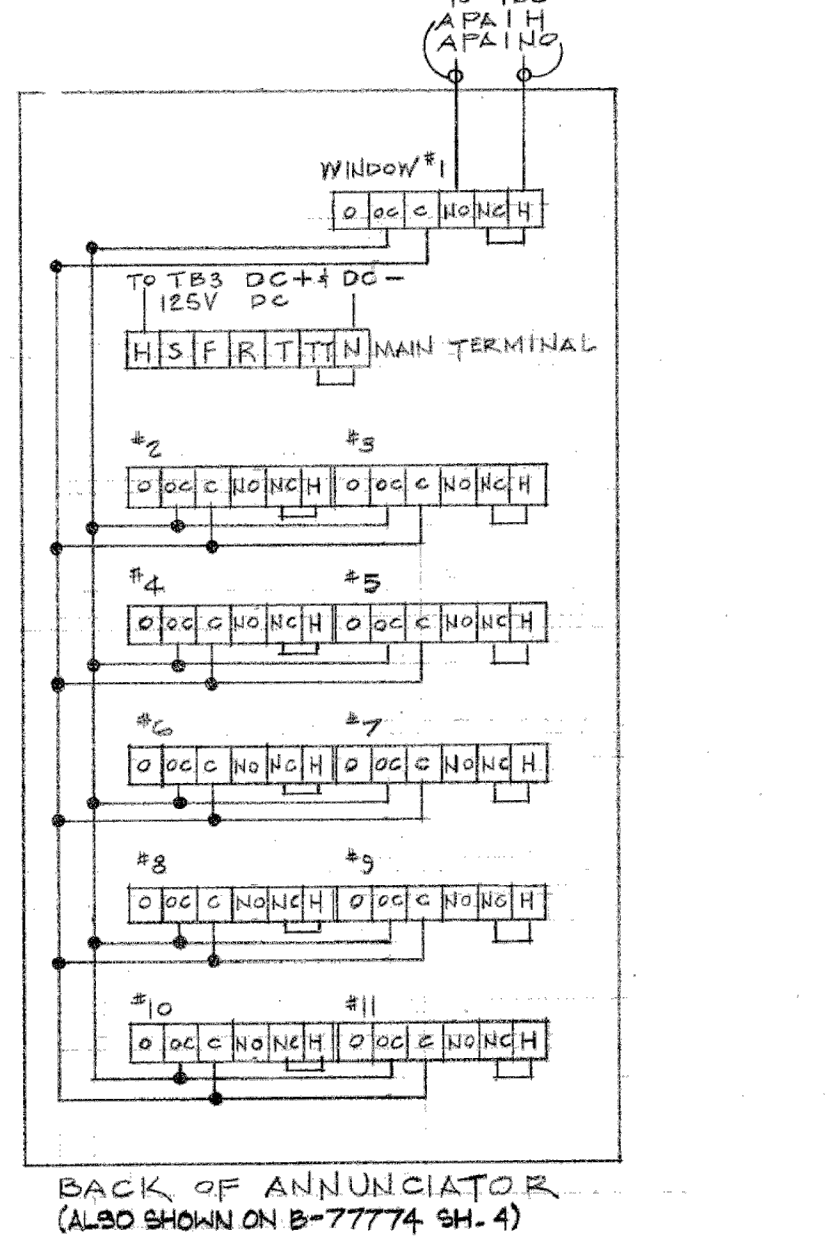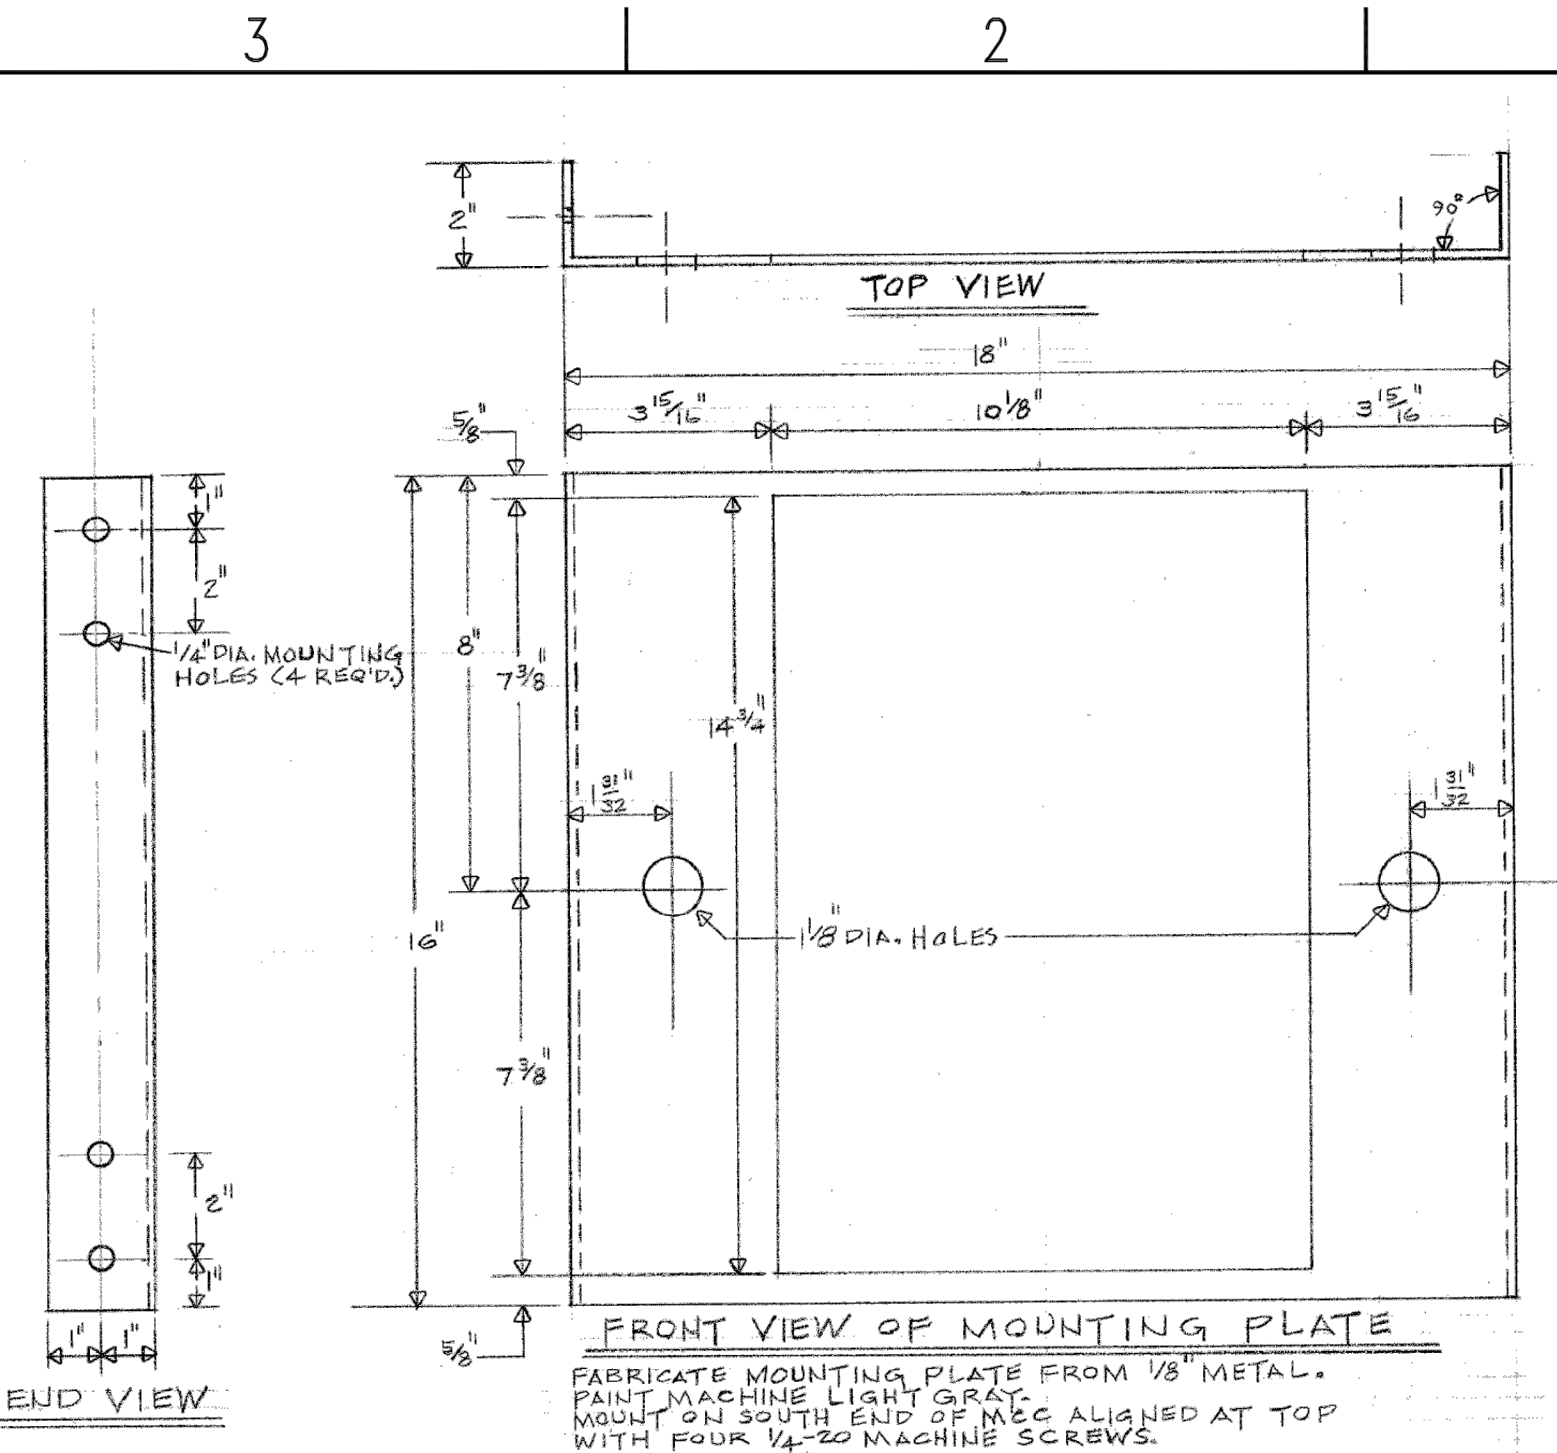

THESE RECORD DRAWINGS DATED 01/17/20 AND TITLED "FOR RECORD" HAVE BEEN DEVELOPED FROM AS-BUILT MARKUPS AND MAY NOT REPRESENT THE FINAL PROJECT, AS CONSTRUCTED, IN EVERY DETAIL. THESE RECORD DRAWINGS HAVE BEEN PREPARED BASED ON INFORMATION SUPPLIED BY OTHERS AND THE ENGINEER HAS NOT VERIFIED THE ACCURACY OR COMPLETENESS OF THE INFORMATION.

WORK SAFELY TODAY

THIS DRAWING IS CONFIDENTIAL AND SHALL NOT BE USED OR REPRODUCED IN ANY PART WITHOUT WRITTEN CONSENT OF PINNACLE WEST CAPITAL CORPORATION.

NO.	DATE	REVISION	DWN	CHD	EXD	RWD	APVD	W.A.
7	01-17-20	FOR RECORD						
6	09/04/19	INSTALL NEW PUMPS	AWP	DEM				FOO00014
5	04-27-18	TITLE UPDATE						WIC FRO00004
4	04/04/18	REPLACES 03/08/18	AWP	DEM				WIC FRO00004
3	01/17/20	FOR RECORD						WIC FRO00004
2	01/17/20	REV FOR PLO, PRT	JL	WK	AWP	DEM		WIC FRO00004
1	04/27/18	DATA UPDATE	VID					WIC FRO00004

SCALE: NONE

DATE: 03-07-77

APPROVED: W A

DRAWING APPROVED BY: W A

99-4-107-10

UNIT: FC

DISC: E

TYPE: 04

SYS: ADS

NUMBER: 39128

SHEET: 3

**WA445678
FOUR CORNERS
EXISTING PUMP
STATION UPGRADES**

APS UTILITIES KEY		
EXISTING		PROPOSED
W	WATER	W
S	SEWER	S
G	GAS	G
SD	STORM DRAIN	SD
IRR	IRRIGATION	IRR
TS	TRAFFIC SIGNAL	TS
T	TELE	T
CATV	CATV	CATV
FO	FIBER	FO
UG ELECTRIC NOMINAL TRANSMISSION (69KV)		
UG ELECTRIC NOMINAL PRIMARY (12470/7,200V)		
UG ELECTRIC NOMINAL SECONDARY/SERVICE (120/240V)		
OH ELECTRIC NOMINAL TRANSMISSION (69KV)		
OH ELECTRIC NOMINAL PRIMARY (12470/7,200V)		
OH ELECTRIC NOMINAL SECONDARY/SERVICE (120/240V)		
CONDUIT		
TRENCH RUNNING LINE		
* UNLESS OTHERWISE NOTED		

APS SYMBOLS LEGEND		
EXISTING EQUIPMENT	PROPOSED EQUIPMENT	DESCRIPTION
		- PADMOUNTED TRANSFORMER
		- SWITCHING CABINETS
		- 10 SWITCHING CABINET
		- OHUG CAPACITOR BANK
		- J-BOX / PULL BOX
		- MANHOLES
		- OH TRANSFORMER
		- OH SWITCH (KPF)
		- APS OWNED POLE
		- APS OWNED STEEL POLE
		- APS OWNED JOINT USE POLE
		- DIP (TRANSITION) POLE
		- STREET LIGHT
		- DUSK TO DAWN LIGHT

DATA MODIFIED PER FIELD CONDITIONS



GENERAL PURPOSE NOTES:

REPLACE CROSS ARM
REMOVE 3-50KVA TRANSFORMERS (480V, 3W)
INSTALL 3-75KVA TRANSFORMERS (277/480V, 3Ø, 4W)
REPLACE TRANSITION
INSTALL 2-4" CONDUIT FROM POLE TO BREAKER SECTION, RUN 2 SETS OF UA750DDV

SPEC CODES:

- | | |
|--|--|
| <p>01 REMOVE
3470.WS3PUR002W
7185.WFFF44
7482.AD(3)
5052.W2UA750DDV</p> <p>02 INSTALL
2705.UA750DDV(2)</p> | <p>INSTALL
3471.SS3PUR002W
7185.WGGG42 75,75,75KVA 12.5KV (277/480V)
7482.AD(3)
2263.B1(3)
5052.W2A750DDV</p> |
|--|--|

(INSTALL)
TOTAL WIRE DATA FOOTAGE:
SECONDARY / SERVICE / ST. LT. / D-D
6220.UA750DDV= 300'

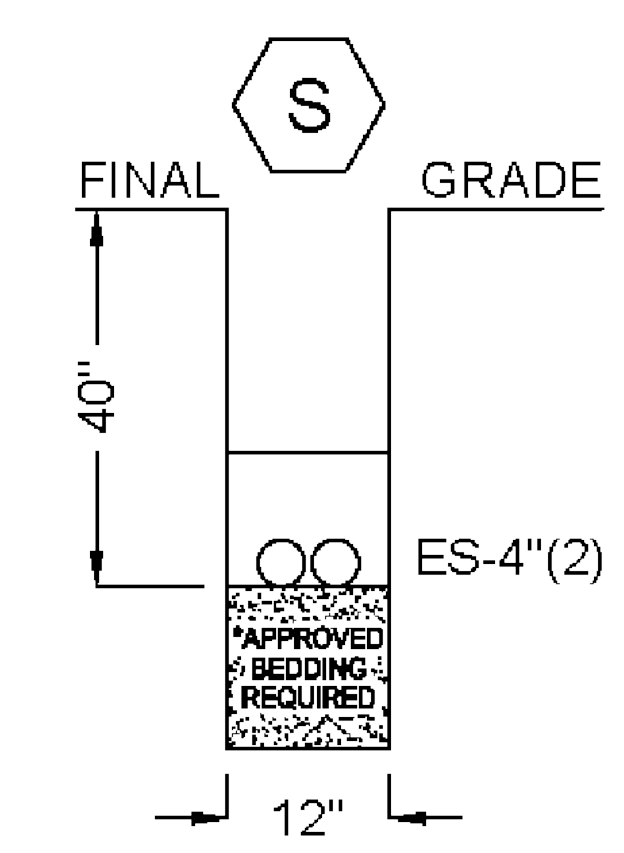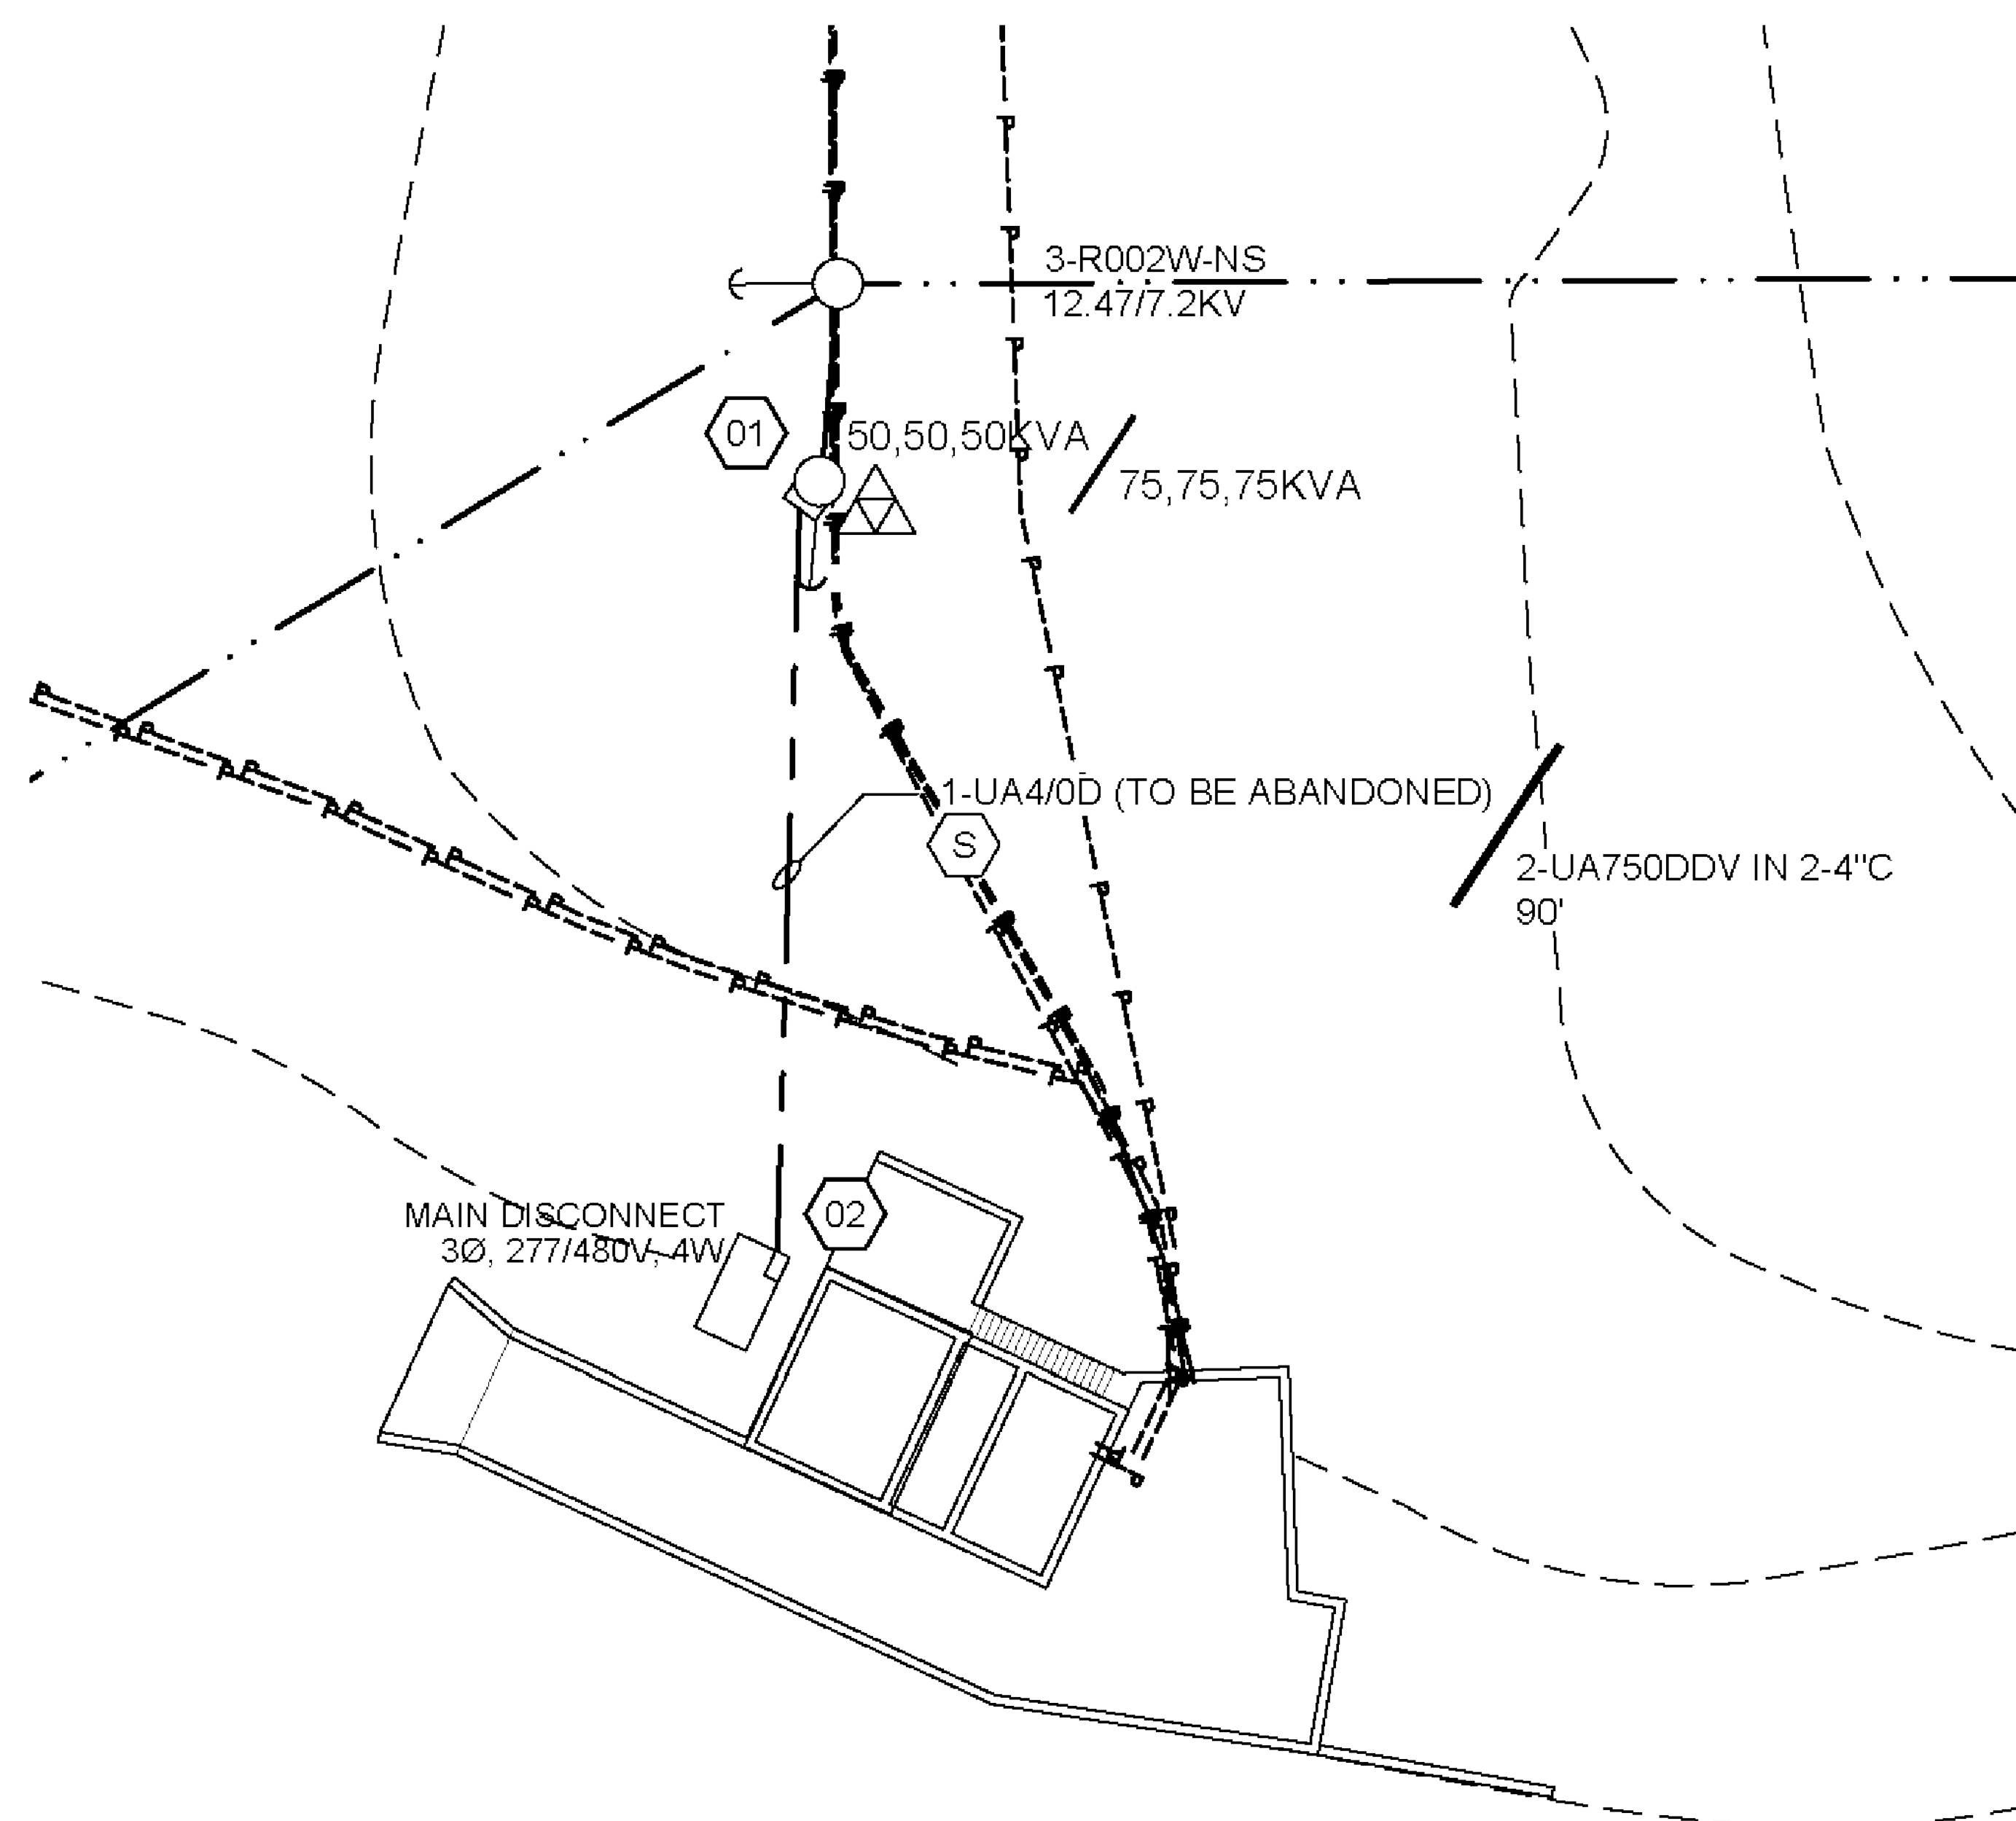

Contact Arizona 811 at least two full working days before you begin excavation

Call 811 or click Arizona811.com

CONTACT: JOE CARTER			
PHONE: 928-773-6476	PGRMOBILE: 602-818-1466		
INSPECTOR: N/A			
PHONE: N/A	PGRMOBILE: N/A		
NO.	DATE	DESCRIPTION	BY
aps		FOUR CORNERS EXISTING PUMP SITE UPGRADE	
WD#	WA445678	DATE	07/09/2018
BY:	R. FLAKE	SCALE:	1:50
FILENAME:	FOUR CORNERS PUMP STATION UPGRADE	SHEET:	1 OF 1

WA445678 FOUR CORNERS RETURN WATER POND PUMP FEEDER





CONSTRUCTION NOTES:

- 01** INSTALL
5255.W1KR002W
2640.K20(3)
8881.DQ(3)
- 02** INSTALL
7666.B364 225 KVA 12,470V (277/480V) IN-LINE
2705.UA4/ODV(4)
8881.DQ(3) (APS TO PROVIDE, CUSTOMER TO INSTALL)
8881.GQV(2) (APS TO PROVIDE, CUSTOMER TO INSTALL)
- (2 LOCATIONS) 03** INSTALL
2705.UA4/ODV(4)
8881.GQV(2) (APS TO PROVIDE, CUSTOMER TO INSTALL)
- 04** INSTALL
7666.B364 1,000 KVA 12,470V (277/480V) END-OF-LINE
2705.UA4/ODV(4)
8881.DQ(3) (APS TO PROVIDE, CUSTOMER TO INSTALL)
8881.GQV(2) (APS TO PROVIDE, CUSTOMER TO INSTALL)
- WI** INSTALL
6215.UA1/OT(3600)
6220.UA4/ODV(170)
8895.MR(3800)
8895.MM(4)

APS UTILITIES KEY		
EXISTING		PROPOSED
W	---	WATER
S	---	SEWER
G	---	GAS
SD	---	STORM DRAIN
IRR	---	IRRIGATION
TS	---	TRAFFIC SIGNAL
T	---	TELE
CATV	---	CATV
FO	---	FIBER
UG ELECTRIC NOMINAL TRANSMISSION (69KV)*		
UG ELECTRIC NOMINAL PRIMARY (12,470/7,200V)*		
UG ELECTRIC NOMINAL SECONDARY/SERVICE (120/240V)*		
OH ELECTRIC NOMINAL TRANSMISSION (69KV)*		
OH ELECTRIC NOMINAL PRIMARY (12,470/7,200V)*		
OH ELECTRIC NOMINAL SECONDARY/SERVICE (120/240V)*		
CONDUIT		
TRENCH RUNNING LINE		
* UNLESS OTHERWISE NOTED		

APS SYMBOLS LEGEND		
EXISTING EQUIPMENT	PROPOSED EQUIPMENT	DESCRIPTION
		- PADMOUNTED TRANSFORMER
		- SWITCHING CABINETS
		- 1Ø SWITCHING CABINET
		- OH/UG CAPACITOR BANK
		- J-BOX / PULL BOX
		- MANHOLES
		- OH TRANSFORMER
		- OH SWITCH (KPF)
		- APS OWNED POLE
		- APS OWNED STEEL POLE
		- APS OWNED JOINT USE POLE
		- DIP (TRANSITION) POLE
		- STREET LIGHT
		- DUSK TO DAWN LIGHT

DATA MODIFIED PER FIELD CONDITIONS

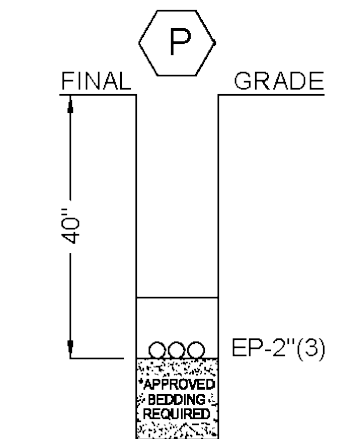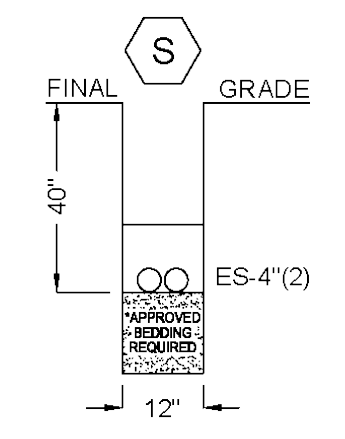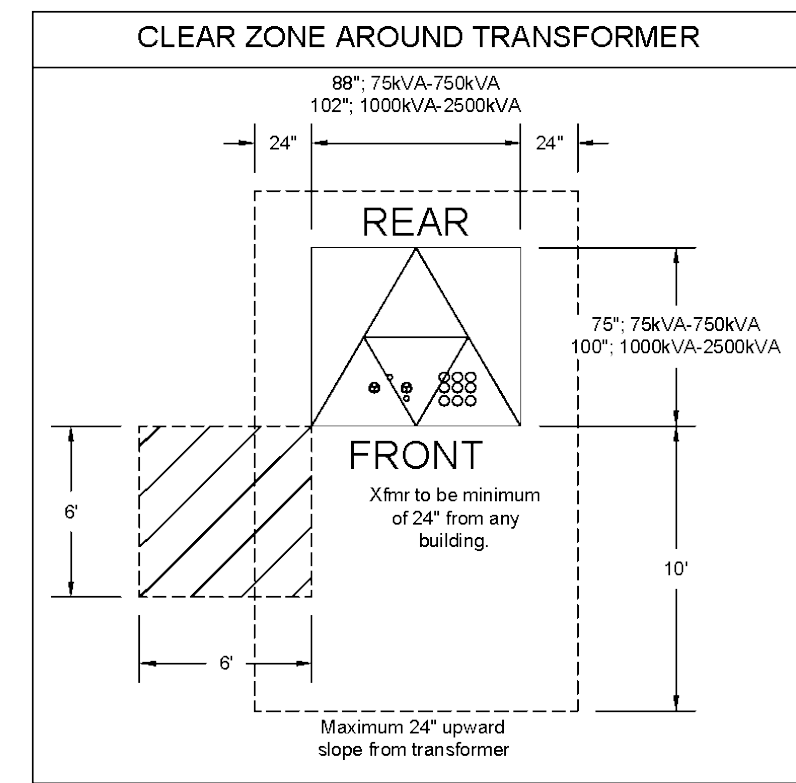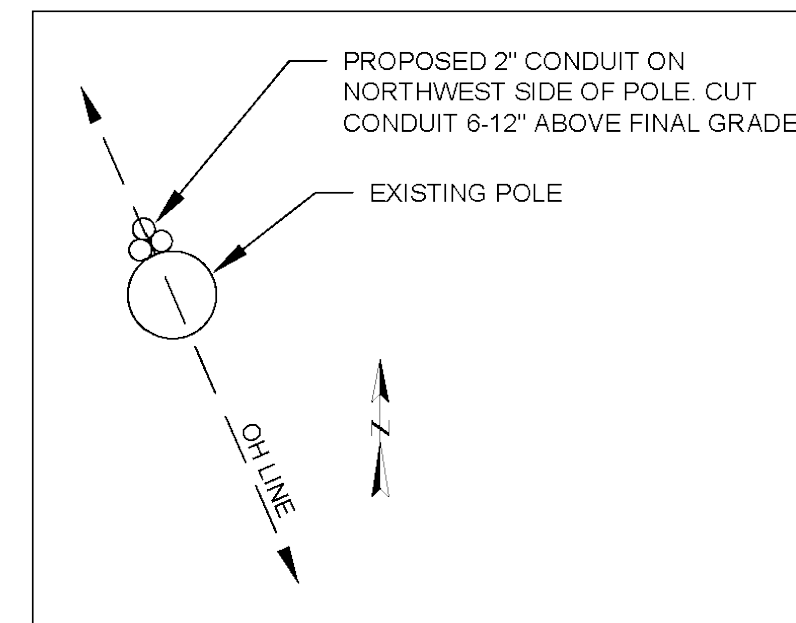


Contact Arizona 811 at least two full working days before you begin excavation

Call 811 or click Arizona811.com

CONTACT: JOE CARTER			
PHONE: 928-773-6475		PGR/MOBILE: 602-818-1456	
INSPECTOR: N/A			
PHONE: N/A		PGR/MOBILE: N/A	
1	6/6/19	REV TRENCH DETAILS	RVF
NO.	DATE	DESCRIPTION	BY
aps		FOUR CORNERS ASH POND PUMP STATION EXTENSION	
WO#:	WA445678	DATE:	07/05/2018
BY:	R. FLAKE	SCALE:	1:50
FILENAME:	FOUR CORNERS PUMP STATION PRELIM.DWG	SHEET:	1 OF 1

SERVICE SECTION SIZE (AMPS)	SERVICE VOLTAGE	QUANTITY and SIZE OF CONDUITS			PAD SIZE and CONDUIT LOCATION (inches)				
		PRIMARY	SECONDARY		A	B	C	D	L
600 - 1000	277/480	2-4"	6-2"	2-4"	75	88	40	16	26-1/2

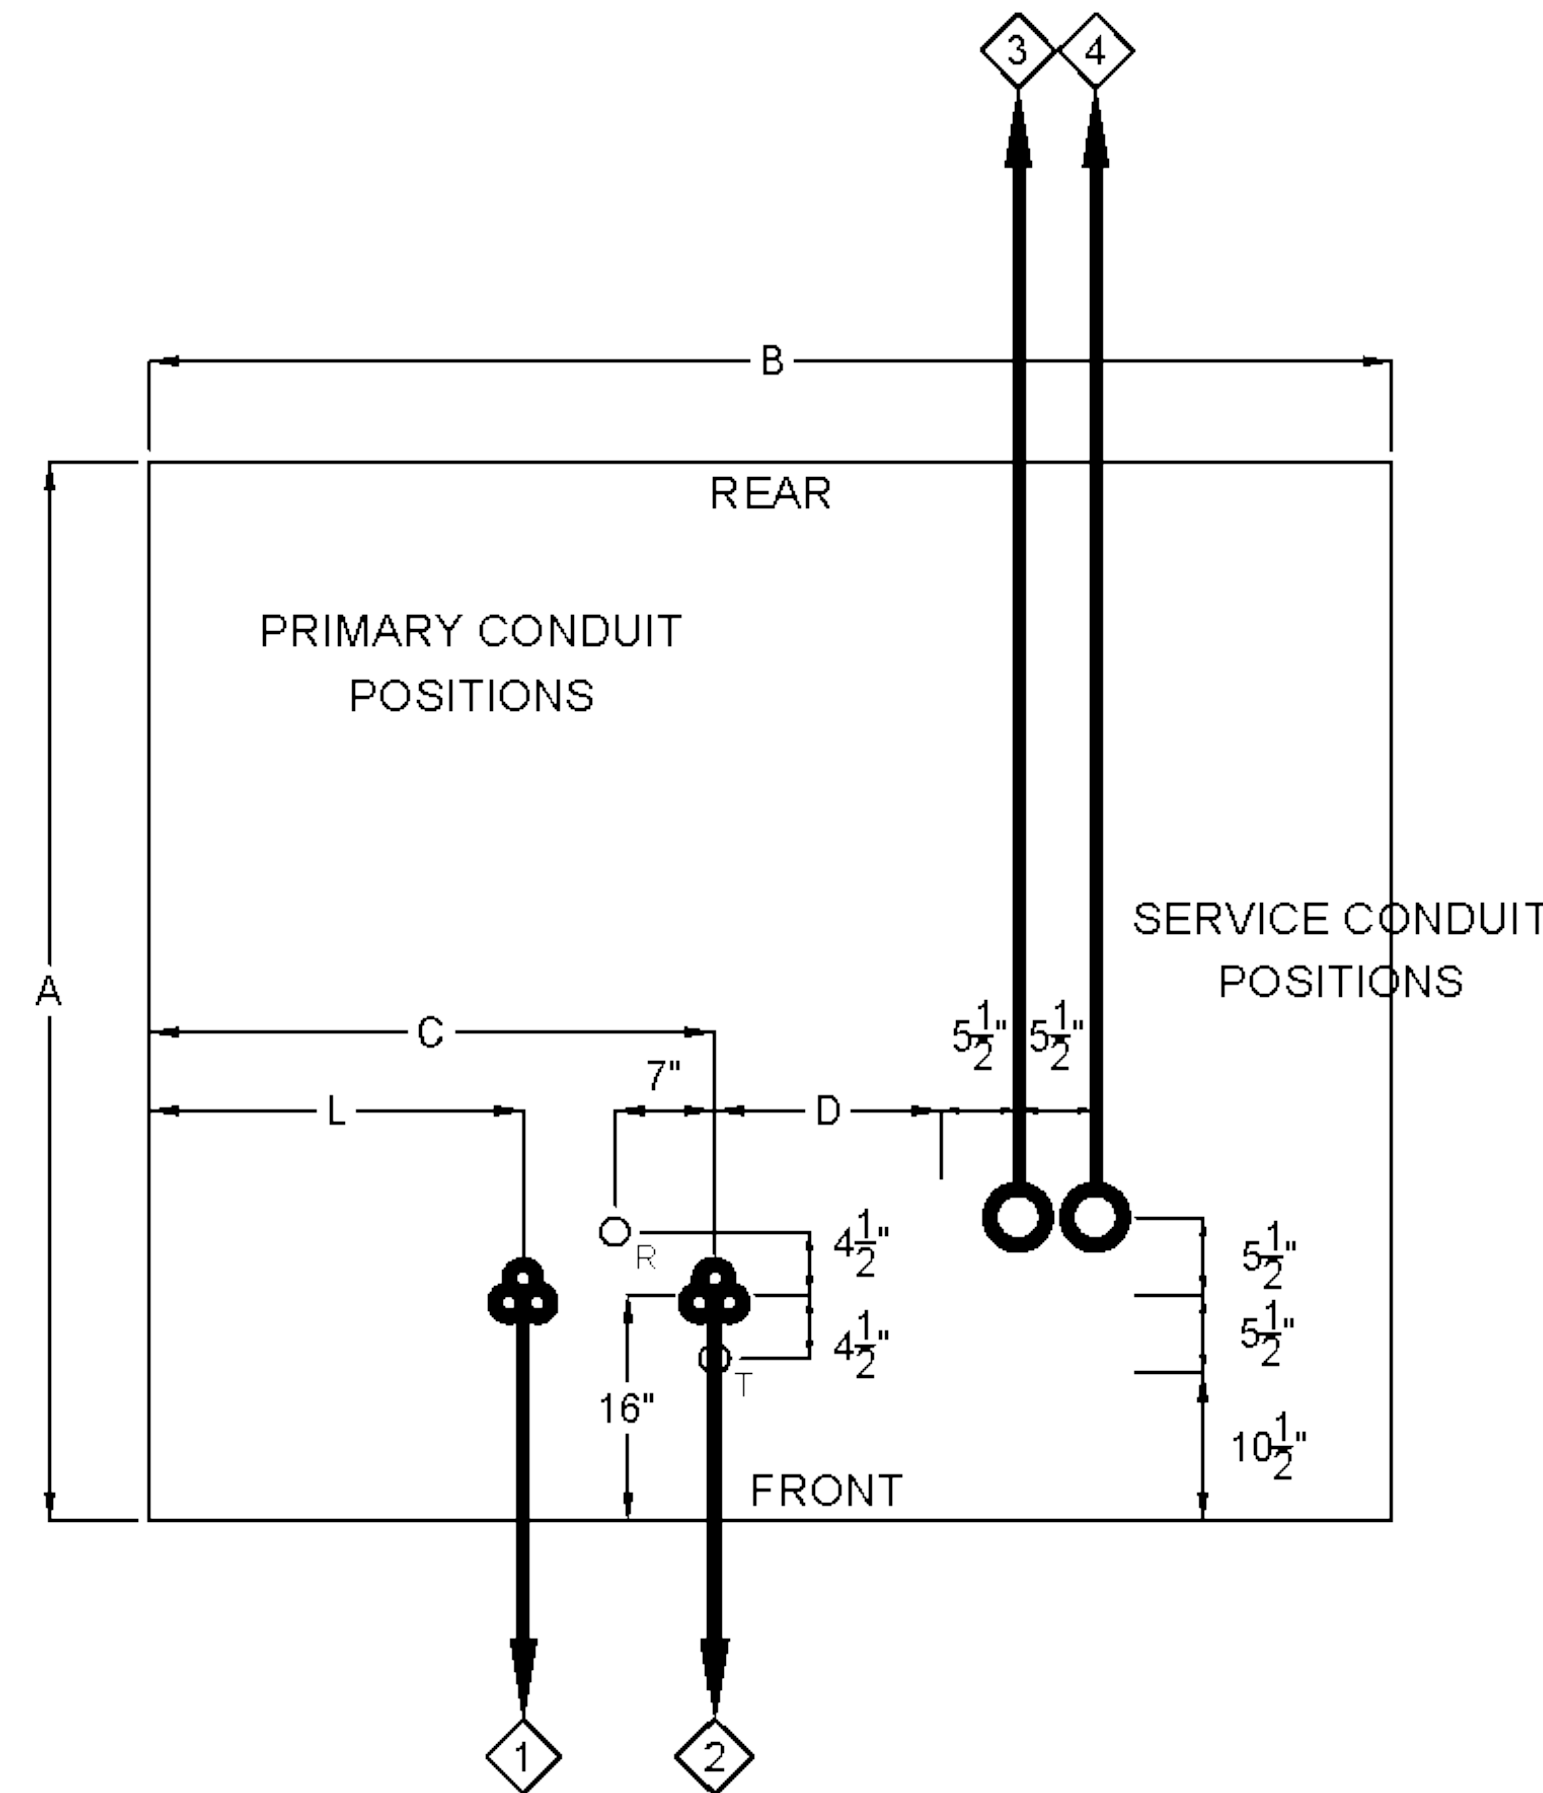

CABLE & CONDUIT NOTES:

- ① C2"(3), 90°, 36"R SWEEPS TO TRANSITION POLE 3-UA1/0T TO TRANSITION POLE
- ② C2"(3), 90°, 36"R SWEEPS TO TX2 3-UA1/0T TO TX2
- ③ C4"(1), 90°, 36"R SWEEPS TO DISCONNECT 1-UA750DDV TO DISCONNECT
- ④ C4"(1), 90°, 36"R SWEEPS TO DISCONNECT 1-UA750DDV TO DISCONNECT

GENERAL NOTES:

- 1. ALL TRANSFORMER LOCATIONS SHALL COMPLY WITH ALL CODES, ORDINANCES, AND REGULATIONS WITHIN THE STATE OF ARIZONA OR OTHERWISE SPECIFIED BY APS.
- 2. CUSTOMER TO PROVIDE ALL WORK INVOLVED WITH THE PAD AND CONDUITS.
- 3. ALL CONDUITS MUST BE INSPECTED AND APPROVED PRIOR TO BACKFILLING.
- 4. ALL CONCRETE FORMS AND CONDUITS AND REBAR (IF REQUIRED) MUST BE IN PLACE AND APPROVED PRIOR TO POURING PAD.
- 5. ANY VARIATIONS FROM THE ABOVE REQUIREMENTS MUST BE GIVEN IN WRITING AND SIGNED BY AN APS REPRESENTATIVE.
- 6. A MINIMUM 24-HOUR NOTICE IS REQUIRED FOR INSPECTIONS.
R = GROUND ROD SLEEVE, NOTE 7.
T = COMMUNICATION GROUND SLEEVE, NOTE 8.
Ⓢ = 5" SLEEVE LOCATION 18" DEEP

PAD SPECIFICATIONS:

- THE FOLLOWING MINIMUM UNOBSTRUCTED CLEARANCES FROM THE EDGE OF THE PAD ARE REQUIRED:
HORIZONTAL CLEARANCES: 2' TO THE REAR AND SIDES 10' TO THE FRONT
VERTICAL CLEARANCES: 30' ABOVE THE PAD AND HORIZONTAL CLEARANCE AREAS
REFER TO T&D STANDARDS 1278-1279 FOR ALL APPLICABLE CLEARANCE REQUIREMENTS.
- ALL BACKFILL BENEATH THE PAD SHALL BE COMPACTED TO A MINIMUM OF 90 PERCENT OF MAXIMUM DENSITY, AND SHALL NOT CONTAIN ROCKS LARGER THAN 1-1/2 INCHES IN THEIR GREATEST DIMENSION. BACKFILL MATERIAL SHALL CONTAIN ENOUGH FINES TO FILL ALL VOIDS.

ONE-SACK ABC SLURRY SHALL NOT BE INSTALLED BENEATH EQUIPMENT PADS. IF SLURRY BACKFILL IS INSTALLED BENEATH EQUIPMENT PADS, ONE OF THE FOLLOWING OPTIONS SHALL BE UTILIZED:

OPTION 1:
ONE-SACK CEMENT SAND SLURRY AS SPECIFIED IN T&D STANDARDS 8601, 19.5
OPTION 2:
FLYASH, TYPE F 250 POUNDS
WATER 50 GALLONS
FINE AGGREGATE (SAND) 3,117 POUNDS
OPTION 3:
CEMENT 52 POUNDS
FLYASH, TYPE F 240 POUNDS
WATER 55 GALLONS
FINE AGGREGATE (SAND) 2,820 POUNDS

CONCRETE MIXING TICKET MUST BE PROVIDED DESCRIBING THE MATERIAL, OTHERWISE THE MATERIAL IS UNACCEPTABLE.
- PAD TO BE MADE IN ONE CONTINUOUS POUR OF CONCRETE, 3000 PSI AT 28 DAYS, 3/8 INCH AGGREGATE, 3 TO 5-INCH SLUMP. TOP OF PAD TO BE TROWELED SMOOTH AND LEVEL. SURFACE IS TO HAVE A LIGHT BROOMED FINISH AND ALL EXPOSED EDGES ARE TO BE ROUNDED TO A 3/4-INCH RADIUS.

REFER TO THE MATERIAL SPECIFICATIONS 7990 FOR COMPLETE PAD SPECIFICATIONS.
- REINFORCING STEEL IS REQUIRED **NO**

REINFORCEMENT IS NOT REQUIRED IF PAD IS POURED-IN-PLACE IN A LOCATION UNLIKELY TO BE UNDERMINED BY DRAINAGE, ETC.
- MINIMUM REQUIRED PAD THICKNESS IS 6 INCHES.
- TOP OF PAD TO BE A MINIMUM OF 4 INCHES ABOVE SURROUNDING FINISHED GRADE.
- R--PROVISION FOR GROUND ROD--INSTALL SLEEVE THROUGH PAD, 1-INCH MINIMUM I.D., WITH NO OBSTRUCTION BENEATH. ALTERNATE SLEEVE LOCATIONS ARE ALONG AN IMAGINARY CENTER LINE BETWEEN THE PRIMARY DUCTS. LOCATION TO BE BASED ON AVOIDING CONDUIT SWEEPS WHEN DRIVING GROUND ROD.
- T--PROVISION FOR COMMUNICATIONS GROUND--INSTALL SLEEVE THROUGH PAD, 1 INCH MINIMUM I.D., WITH NO OBSTRUCTION BENEATH. LOCATION TO BE BASED ON AVOIDING CONDUIT SWEEPS.

CONDUIT SPECIFICATIONS:

- ALL SERVICE CONDUCTORS SHALL BE INSTALLED IN RIGID NON-METALLIC CONDUITS FROM TRANSFORMER TO SERVICE ENTRANCE SECTION.
- ALL PRIMARY CONDUCTORS SHALL BE INSTALLED IN RIGID NON-METALLIC CONDUITS.
- RIGID NON-METALLIC CONDUIT IS DEFINED AS PVC AND SHALL BE MARKED AS FOLLOWS:
SWEEPS - PVC SCH 40 NEMA TC-2
STRAIGHT SECTIONS - PVC DB L00 MODULUS 400,000 PSI ASTM F-512
PVC DB 120 MODULUS 400,000 PSI ASTM F-512
PVC SCH 40 NEMA TC-2
PVC SCH 80 NEMA TC-2
- ONLY GOOD FOR CONDUIT 4" OR LARGER.

APPLY PURPLE PRIMER/CLEANER ASTM F656 TO ALL PVC JOINTS PRIOR TO APPLYING A COATING OF GRAY PVC TO PVC CEMENT ASTM 02564.

FOR INSPECTION CONTACT:	
PHONE:	
INSPECTION IS REQUIRED AFTER CONDUITS ARE INSTALLED, AND BEFORE PAD IS POURED.	
INSPECTED BY:	DATE:
FINAL INSPECTION BY:	DATE:

TX1

APS CONSTRUCTION SYMBOL

SOURCE: DIP POLE

- IF STEEL SWEEPS, BENDS AND CONDUIT ARE USED; THEY SHALL BE GALVANIZED PER ANSI C80.1 AND HALF-LAPPED WITH SUITABLE 20-MIL TAPE, TO A TOTAL THICKNESS OF 40 MILS. POLYKEN #900 2" BLACK TAPE (OR EQUIVALENT) SHALL BE HALF-LAPPED OVER POLYKEN #927 BLACK PRIMER (OR EQUIVALENT).
- ALL NON-METALLIC CONDUIT SWEEPS AND ELBOWS SHALL HAVE INTERNALLY CHAMFERED ENDS.
- UNLESS OTHERWISE SPECIFIED, SWEEPS, BENDS AND CONDUITS SHALL BE 4-INCH IPS WITH MINIMUM RADIUS SWEEPS OF 36 INCHES FOR PRIMARY AND 24 INCHES FOR SERVICE. EXCEPTION: USE 36" SWEEPS FOR 750 MCM SECONDARY UNLESS OTHERWISE SPECIFIED.
- ALL SWEEPS INTO TRANSFORMER PAD SHALL EXTEND A MINIMUM OF 1 INCH AND A MAXIMUM OF 2 INCHES ABOVE THE TOP OF THE PAD UPON CABLE INSTALLATION. CONDUIT ENDS SHALL BE CAPPED OR PLUGGED, NOT GLUED. NON-EXPOSED CONDUITS STUBBED OUT FOR FUTURE EXTENSIONS SHALL BE PLUGGED.
- PRIMARY CONDUITS SHALL BE INSTALLED WITH A MINIMUM COVER OF 36 INCHES; SERVICE CONDUITS SHALL BE INSTALLED WITH A MINIMUM COVER OF 24 INCHES. UNLESS OTHERWISE SPECIFIED, DIMENSIONS GIVEN ARE FROM FINAL GRADE TO THE TOP OF THE DUCT BANK.
- WHERE SERVICE CONDUITS MUST BE INSTALLED DIRECTLY UNDER A BUILDING FOUNDATION, THE CONDUITS SHALL BE CONCRETE ENCASED AND THE TOP OF THE ENCASEMENT SHALL HAVE A MINIMUM OF 24 INCHES CLEAR SEPARATION BELOW THE STRUCTURE FOUNDATION. ENCASEMENT SHALL CONSIST OF A 3-INCH CONCRETE ENVELOPE.
- THE CUSTOMER SHALL MANDRILL ALL CONDUITS AND IS RESPONSIBLE FOR THE USABILITY OF THE CONDUIT SYSTEM AT THE TIME APS INSTALLS CONDUCTORS.
- PULL LINES SHALL BE PROVIDED BY APS AND INSTALLED BY THE CUSTOMER.
- ARROWS, SHOWN ON PAD DETAIL (LEFT), INDICATE THE DIRECTION SWEEPS AND CONDUITS ARE TO BE POSITIONED.


JOB NUMBER	DATE	DESCRIPTION	REV BY

LOCATION: LIFT STATION

	7665 THRU 7667
	3-PHASE TRANSFORMER PAD AND CONDUIT DETAIL
WO#: WA445678	DATE: 5/22/19
BY: R. FLAKE	SCALE: NTS
FILENAME: TX1.dwg	

REV 01/25/12

SERVICE SECTION SIZE (AMPS)	SERVICE VOLTAGE	QUANTITY and SIZE OF CONDUITS			PAD SIZE and CONDUIT LOCATION (inches)				
		PRIMARY	SECONDARY		A	B	C	D	L
600 - 1000	277/480	2-4"	6-2"	2-4"	75	88	40	16	26-1/2

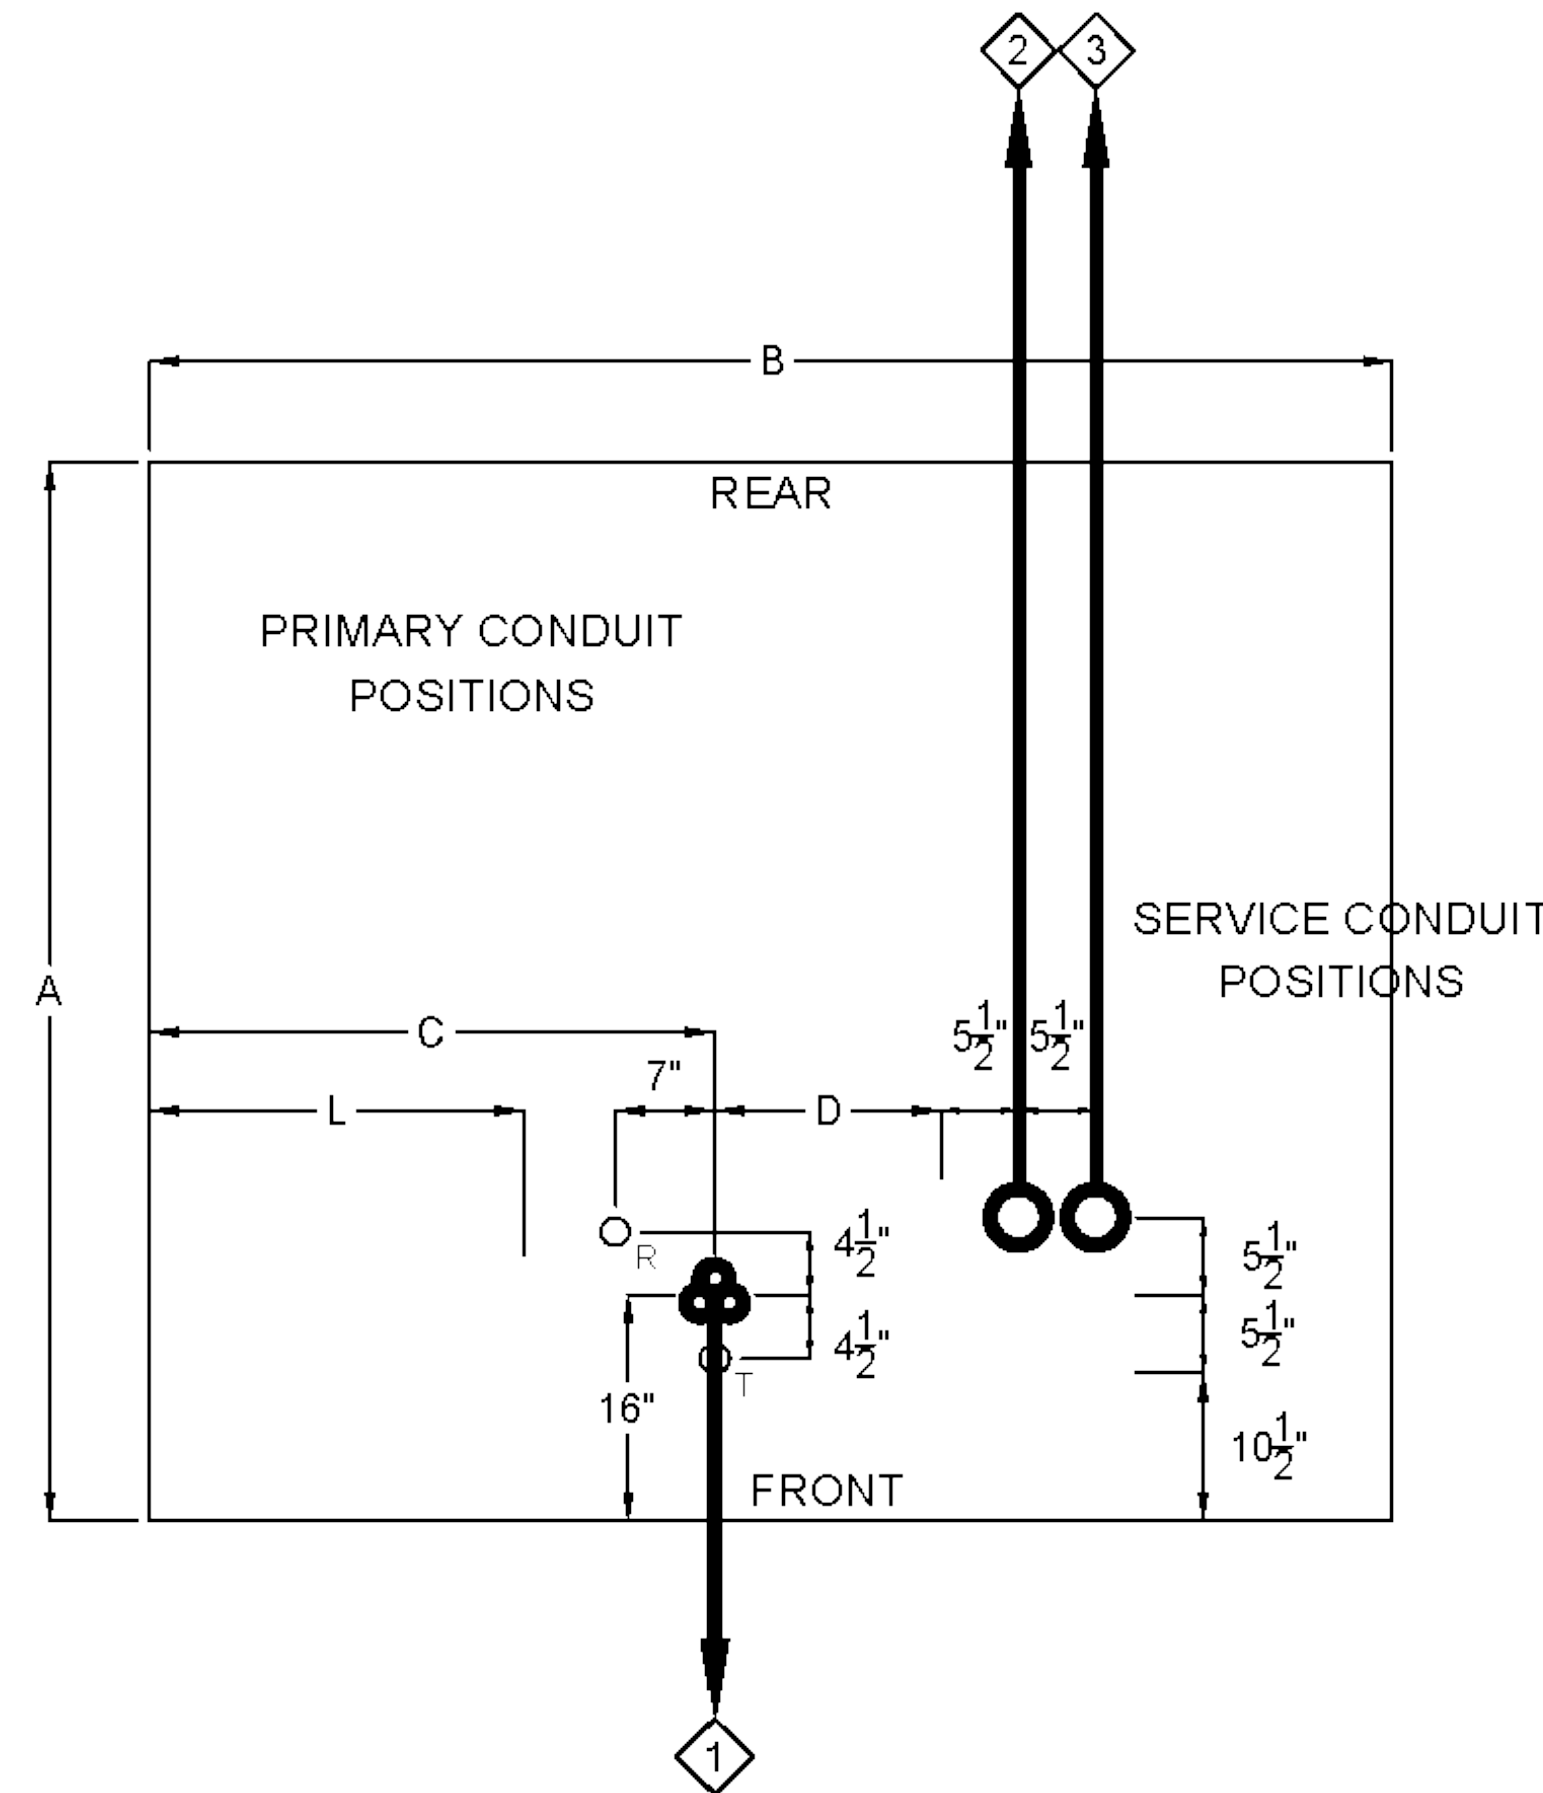

CABLE & CONDUIT NOTES:

- ① C2"(3), 90°, 36"R SWEEPS TO TX1
3-UA1/0T TO TX1
- ② C4"(1), 90°, 36"R SWEEPS TO DISCONNECT
1-UA75DDD TO DISCONNECT
- ③ C4"(1), 90°, 36"R SWEEPS TO DISCONNECT
1-UA75DDD TO DISCONNECT

GENERAL NOTES:

- 1. ALL TRANSFORMER LOCATIONS SHALL COMPLY WITH ALL CODES, ORDINANCES, AND REGULATIONS WITHIN THE STATE OF ARIZONA OR OTHERWISE SPECIFIED BY APS.
- 2. CUSTOMER TO PROVIDE ALL WORK INVOLVED WITH THE PAD AND CONDUITS.
- 3. ALL CONDUITS MUST BE INSPECTED AND APPROVED PRIOR TO BACKFILLING.
- 4. ALL CONCRETE FORMS AND CONDUITS AND REBAR (IF REQUIRED) MUST BE IN PLACE AND APPROVED PRIOR TO POURING PAD.
- 5. ANY VARIATIONS FROM THE ABOVE REQUIREMENTS MUST BE GIVEN IN WRITING AND SIGNED BY AN APS REPRESENTATIVE.
- 6. A MINIMUM 24-HOUR NOTICE IS REQUIRED FOR INSPECTIONS.
R = GROUND ROD SLEEVE, NOTE 7.
T = COMMUNICATION GROUND SLEEVE, NOTE 8.
Ⓢ = 5" SLEEVE LOCATION 18" DEEP

PAD SPECIFICATIONS:

1. THE FOLLOWING MINIMUM UNOBSTRUCTED CLEARANCES FROM THE EDGE OF THE PAD ARE REQUIRED:
HORIZONTAL CLEARANCES: 2' TO THE REAR AND SIDES 10' TO THE FRONT
VERTICAL CLEARANCES: 30' ABOVE THE PAD AND HORIZONTAL CLEARANCE AREAS
REFER TO T&D STANDARDS 1278-1279 FOR ALL APPLICABLE CLEARANCE REQUIREMENTS.
2. ALL BACKFILL BENEATH THE PAD SHALL BE COMPACTED TO A MINIMUM OF 90 PERCENT OF MAXIMUM DENSITY, AND SHALL NOT CONTAIN ROCKS LARGER THAN 1-1/2 INCHES IN THEIR GREATEST DIMENSION. BACKFILL MATERIAL SHALL CONTAIN ENOUGH FINES TO FILL ALL VOIDS.

ONE-SACK ABC SLURRY SHALL NOT BE INSTALLED BENEATH EQUIPMENT PADS. IF SLURRY BACKFILL IS INSTALLED BENEATH EQUIPMENT PADS, ONE OF THE FOLLOWING OPTIONS SHALL BE UTILIZED:

OPTION 1:
ONE-SACK CEMENT SAND SLURRY AS SPECIFIED IN T&D STANDARDS 8601, 19.5
OPTION 2:
FLYASH, TYPE F 250 POUNDS
WATER 50 GALLONS
FINE AGGREGATE (SAND) 3,117 POUNDS
OPTION 3:
CEMENT 52 POUNDS
FLYASH, TYPE F 240 POUNDS
WATER 55 GALLONS
FINE AGGREGATE (SAND) 2,820 POUNDS

CONCRETE MIXING TICKET MUST BE PROVIDED DESCRIBING THE MATERIAL, OTHERWISE THE MATERIAL IS UNACCEPTABLE.
3. PAD TO BE MADE IN ONE CONTINUOUS POUR OF CONCRETE, 3000 PSI AT 28 DAYS, 3/8 INCH AGGREGATE, 3 TO 5-INCH SLUMP. TOP OF PAD TO BE TROWELED SMOOTH AND LEVEL. SURFACE IS TO HAVE A LIGHT BROOMED FINISH AND ALL EXPOSED EDGES ARE TO BE ROUNDED TO A 3/4-INCH RADIUS.

REFER TO THE MATERIAL SPECIFICATIONS 7990 FOR COMPLETE PAD SPECIFICATIONS.
4. REINFORCING STEEL IS REQUIRED **NO**

REINFORCEMENT IS NOT REQUIRED IF PAD IS POURED-IN-PLACE IN A LOCATION UNLIKELY TO BE UNDERMINED BY DRAINAGE, ETC.
5. MINIMUM REQUIRED PAD THICKNESS IS 6 INCHES.
6. TOP OF PAD TO BE A MINIMUM OF 4 INCHES ABOVE SURROUNDING FINISHED GRADE.
7. R--PROVISION FOR GROUND ROD--INSTALL SLEEVE THROUGH PAD, 1-INCH MINIMUM I.D., WITH NO OBSTRUCTION BENEATH. ALTERNATE SLEEVE LOCATIONS ARE ALONG AN IMAGINARY CENTER LINE BETWEEN THE PRIMARY DUCTS. LOCATION TO BE BASED ON AVOIDING CONDUIT SWEEPS WHEN DRIVING GROUND ROD.
8. T--PROVISION FOR COMMUNICATIONS GROUND--INSTALL SLEEVE THROUGH PAD, 1 INCH MINIMUM I.D., WITH NO OBSTRUCTION BENEATH. LOCATION TO BE BASED ON AVOIDING CONDUIT SWEEPS.

CONDUIT SPECIFICATIONS:

1. ALL SERVICE CONDUCTORS SHALL BE INSTALLED IN RIGID NON-METALLIC CONDUITS FROM TRANSFORMER TO SERVICE ENTRANCE SECTION.
2. ALL PRIMARY CONDUCTORS SHALL BE INSTALLED IN RIGID NON-METALLIC CONDUITS.
3. RIGID NON-METALLIC CONDUIT IS DEFINED AS PVC AND SHALL BE MARKED AS FOLLOWS:
SWEEPS - PVC SCH 40 NEMA TC-2
STRAIGHT SECTIONS - PVC DB L00 MODULUS 400,000 PSI ASTM F-512
PVC DB 120 MODULUS 400,000 PSI ASTM F-512
PVC SCH 40 NEMA TC-2
PVC SCH 80 NEMA TC-2
4. ONLY GOOD FOR CONDUIT 4" OR LARGER.

APPLY PURPLE PRIMER/CLEANER ASTM F656 TO ALL PVC JOINTS PRIOR TO APPLYING A COATING OF GRAY PVC TO PVC CEMENT ASTM 02564.

FOR INSPECTION CONTACT:	
PHONE:	
INSPECTION IS REQUIRED AFTER CONDUITS ARE INSTALLED, AND BEFORE PAD IS POURED.	
INSPECTED BY:	DATE:
FINAL INSPECTION BY:	DATE:

TX2

APS CONSTRUCTION SYMBOL

SOURCE: DIP POLE

5. IF STEEL SWEEPS, BENDS AND CONDUIT ARE USED; THEY SHALL BE GALVANIZED PER ANSI C80.1 AND HALF-LAPPED WITH SUITABLE 20-MIL TAPE, TO A TOTAL THICKNESS OF 40 MILS. POLYKEN #900 2" BLACK TAPE (OR EQUIVALENT) SHALL BE HALF-LAPPED OVER POLYKEN #927 BLACK PRIMER (OR EQUIVALENT).
6. ALL NON-METALLIC CONDUIT SWEEPS AND ELBOWS SHALL HAVE INTERNALLY CHAMFERED ENDS.
7. UNLESS OTHERWISE SPECIFIED, SWEEPS, BENDS AND CONDUITS SHALL BE 4-INCH IPS WITH MINIMUM RADIUS SWEEPS OF 36 INCHES FOR PRIMARY AND 24 INCHES FOR SERVICE. EXCEPTION: USE 36" SWEEPS FOR 750 MCM SECONDARY UNLESS OTHERWISE SPECIFIED.
8. ALL SWEEPS INTO TRANSFORMER PAD SHALL EXTEND A MINIMUM OF 1 INCH AND A MAXIMUM OF 2 INCHES ABOVE THE TOP OF THE PAD UPON CABLE INSTALLATION. CONDUIT ENDS SHALL BE CAPPED OR PLUGGED, NOT GLUED. NON-EXPOSED CONDUITS STUBBED OUT FOR FUTURE EXTENSIONS SHALL BE PLUGGED.
9. PRIMARY CONDUITS SHALL BE INSTALLED WITH A MINIMUM COVER OF 36 INCHES; SERVICE CONDUITS SHALL BE INSTALLED WITH A MINIMUM COVER OF 24 INCHES. UNLESS OTHERWISE SPECIFIED, DIMENSIONS GIVEN ARE FROM FINAL GRADE TO THE TOP OF THE DUCT BANK.
10. WHERE SERVICE CONDUITS MUST BE INSTALLED DIRECTLY UNDER A BUILDING FOUNDATION, THE CONDUITS SHALL BE CONCRETE ENCASED AND THE TOP OF THE ENCASEMENT SHALL HAVE A MINIMUM OF 24 INCHES CLEAR SEPARATION BELOW THE STRUCTURE FOUNDATION. ENCASEMENT SHALL CONSIST OF A 3-INCH CONCRETE ENVELOPE.
11. THE CUSTOMER SHALL MANDRILL ALL CONDUITS AND IS RESPONSIBLE FOR THE USABILITY OF THE CONDUIT SYSTEM AT THE TIME APS INSTALLS CONDUCTORS.
12. PULL LINES SHALL BE PROVIDED BY APS AND INSTALLED BY THE CUSTOMER.
13. ARROWS, SHOWN ON PAD DETAIL (LEFT), INDICATE THE DIRECTION SWEEPS AND CONDUITS ARE TO BE POSITIONED.

JOB NUMBER	DATE	DESCRIPTION	REV BY

LOCATION: RETURN WATER POND

	7665 THRU 7667
	3-PHASE TRANSFORMER PAD AND CONDUIT DETAIL
WO#: WA445678	DATE: 5/22/19
BY: R. FLAKE	SCALE: NTS
FILENAME: TX2.dwg	

REV 01/25/12

Appendix B. Wetlands Map


**Four Corners Power Plant
and Navajo Mine Energy Project**

ENVIRONMENTAL SETTING
& CONSEQUENCES

Figure 4.5-7

Jurisdictional Waters of the US
in the Vicinity of the FCPP
Proposed Ash Disposal Facility

RWP
(approximate scale and location)

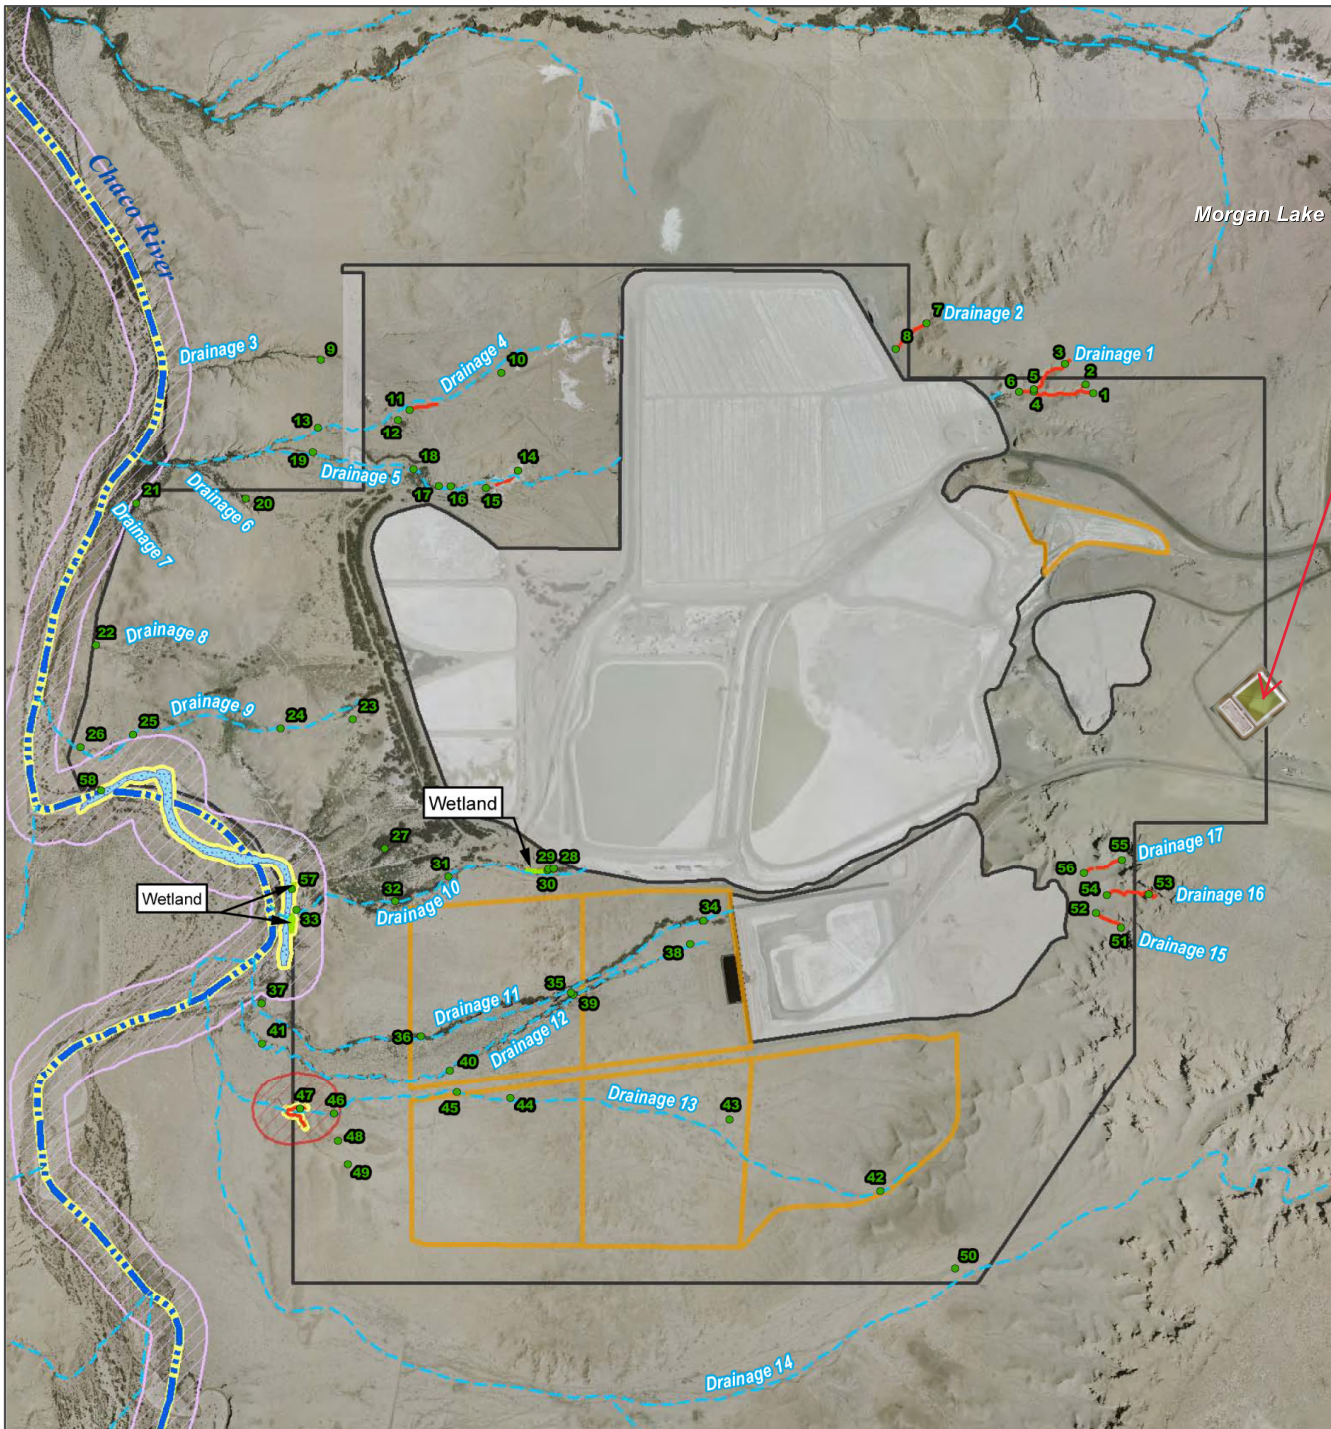

- GPS Survey Point (#) 
- Wetland 
- Chaco River OHWM 
- Ephemeral 
- Intermittent 
- Ordinary High Water Mark Observed* 
- Jurisdictional (highlighted) 
- Waters of the U.S. Delineation Boundary 
- Existing Fly Ash Disposal Facilities 
- Proposed Fly Ash Facility 
- Chaco River Avoidance Area 
- Avoidance Area 

*Observed Ordinary High Water Mark without jurisdiction is considered isolated.

Appendix C. Unified Hazard Tool Summary

Unified Hazard Tool



- Please do not use this tool to obtain ground motion parameter values for the design code reference documents covered by the [U.S. Seismic Design Maps web tools](#) (e.g., the International Building Code and the ASCE 7 or 41 Standard). The values returned by the two applications are not identical.

^ Input

Edition

Spectral Period

Latitude

Decimal degrees

Time Horizon



Return period in years

Longitude

Decimal degrees, negative values for western long...

Site Class

^ Hazard Curve

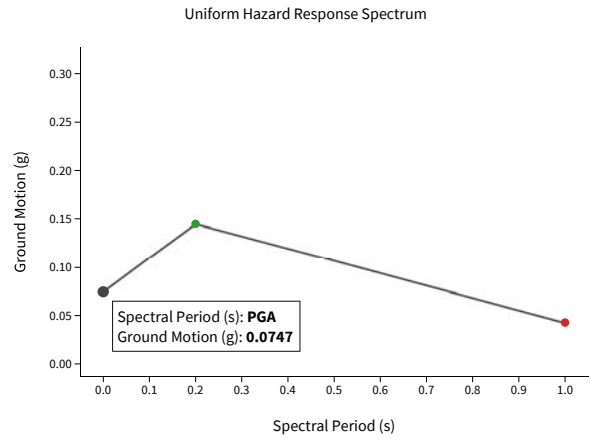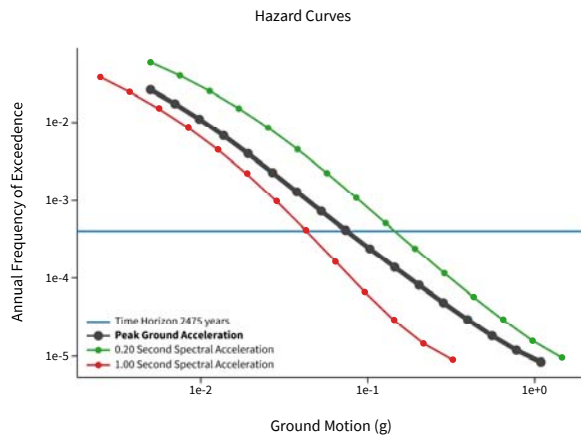

[View Raw Data](#)